

EXCHANGE RETAIL

AT HOMEPLACE PRATTVILLE, ALABAMA

PERMIT SET 10.11.2019

GMC

AS-BUILT


2660 East Chase Lane, Suite 200
Montgomery, AL 36117
T 334.271.3200
GMCNETWORK.COM

ISSUE	DATE
75% REVIEW	04/18/19
95% REVIEW	05/20/19
PERMIT SET	10/11/19
DESIGNED BY:	GMC
DRAWN BY:	GMC
CHECKED BY:	GMC

THE EXCHANGE AT HOMEPLACE

PRATTVILLE, AL

GMC PROJECT#AMGM180037

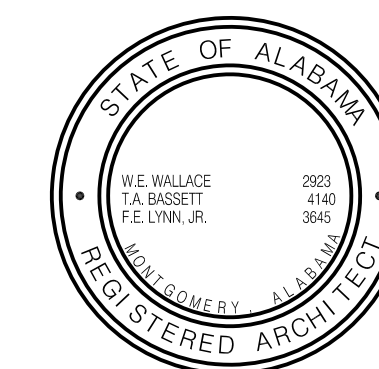

TITLE SHEET
INDEX TO DRAWINGS

T1.01
sheet of

INDEX TO DRAWINGS

SHEET NO.	SHEET TITLE	DATE	SHEET NO.	SHEET TITLE	DATE
GENERAL					
T1.01	TITLE SHEET / INDEX TO DRAWINGS	10.11.19	A5.02	EXTERIOR ELEVATIONS	10.11.19
LS.01	LIFE SAFETY PLAN	10.11.19	A5.03	EXTERIOR ELEVATIONS	10.11.19
			A5.04	EXTERIOR ELEVATIONS	10.11.19
CIVIL					
01	PROJECT INFORMATION	09.23.19	A6.01	PAVING PLAN	10.11.19
02	OVERALL PLAN	08.27.19	A7.01	WALL SECTIONS	10.11.19
03	SITE AND DEMO PLAN	09.23.19	A7.02	WALL SECTIONS	10.11.19
04	GRADING PLAN	09.23.19	A7.03	WALL SECTIONS	10.11.19
05	UTILITY PLAN	09.23.19	A7.04	WALL SECTIONS	10.11.19
06	STORM SEWER DETAILS	08.27.19	A7.05	WALL SECTIONS	10.11.19
07	SANITARY SEWER DETAILS	08.27.19	A7.06	WALL SECTIONS	10.11.19
08	WATER DETAILS	08.27.19	A7.07	WALL SECTIONS	10.11.19
09	EROSION CONTROL PLAN	08.27.19	A7.08	WALL SECTIONS	10.11.19
10	EROSION CONTROL DETAILS	08.27.19			
11	EROSION CONTROL DETAILS	08.27.19	PLUMBING		
			P0.1	LEGEND, GENERAL NOTES AND SPECS	10.11.19
			P2.1	FLOOR PLAN - SANITARY & GAS	10.11.19
			P2.2	FLOOR PLAN - DOMESTIC	10.11.19
			P3.1	SCHEDULES, NOTES & FLOOR PLAN - SANITARY	10.11.19
			P3.2	FLOOR PLAN - DOMESTIC	10.11.19
STRUCTURAL					
S0.1	GENERAL NOTES & TYPICAL SECTIONS	10.11.19			
S0.2	GENERAL NOTES & TYPICAL SECTIONS	10.11.19			
S1.1	PART A FOUNDATION PLAN	10.11.19			
S1.2	PART B FOUNDATION PLAN	10.11.19			
S1.3	PART A ROOF FRAMING PLAN	10.11.19	MECHANICAL		
S1.4	PART B ROOF FRAMING PLAN	10.11.19	M0.1	SCHEDULES, SPECS AND DETAILS	10.11.19
S1.5	TOWER FRAMING PLAN	10.11.19	M2.1	FLOOR PLAN	10.11.19
S2.1	TRUSS DIAGRAMS	10.11.19	M3.0	SCHEDULES AND SPECIFICATIONS	10.11.19
S3.1	SECTIONS	10.11.19	M3.1	DETAILS AND FLOOR PLAN	10.11.19
S3.2	SECTIONS	10.11.19			
S3.3	SECTIONS	10.11.19	ELECTRICAL		
			E0.1	GENERAL NOTES AND LEGEND	10.11.19
			E1.1	OVERALL BUILDING PLAN - POWER & LIGHTING	10.11.19
			E1.2	TENANT PLAN - POWER AND LIGHTING	10.11.19
			E2.1	ELECTRICAL RISER DIAGRAM - BLDG. A	10.11.19
			E2.2	ELECTRICAL RISER DIAGRAM - BLDG. B	10.11.19
			E3.1	ELECTRICAL PANEL SCHEDULES	10.11.19
ARCHITECTURE					
A2.00	FLOOR PLAN COMPOSITE	10.11.19			
A2.01	FLOOR PLAN - PART A	10.11.19			
A2.02	FLOOR PLAN - PART B	10.11.19			
A2.03	SCHEDULES	10.11.19			
A2.04	TENANT SPACE A3	10.11.19			
A4.01	ROOF PLAN	10.11.19	FIRE PROTECTION		
A5.01	EXTERIOR ELEVATIONS	10.11.19	FP2.1	FIRE PROTECTION - DETAILS & NOTES	
			FP2.2	FIRE PROTECTION - FLOOR PLAN	

GOODWYN MILLS & CAWOOD, INC.
ARCHITECTURE

2660 EASTCHASE LANE
SUITE 200
MONTGOMERY, ALABAMA 36117

RICK WENDLING
334.271.3200 EXT 225
Rick.wendling@gmcnetwork.com

CHAMBLISS ENGINEERING
CIVIL ENGINEERING

356 HIGHWAY 82 WEST
PRATTVILLE, ALABAMA 36067

CLYDE CHAMBLISS
334.491-2323
chamblissengineering.com

WEATHERFORD & ASSOCIATES, INC.
STRUCTURAL ENGINEERING

8150 OLD FEDERAL ROAD
MONTGOMERY, ALABAMA 36117


DANNY RAINES
334.277.9550
danny@waeng.com

PURSUIT ENGINEERING, INC.
**MECHANICAL ENGINEERING
FIRE PROTECTION
ELECTRICAL ENGINEERING**

1199 S. DONAHUE DRIVE
AUBURN, ALABAMA 36832

CHASE PAYNE
334.246.1369
chase@pursuitengineering.com

JEFF HIRES
334.246.1369
jeff@pursuitengineering.com

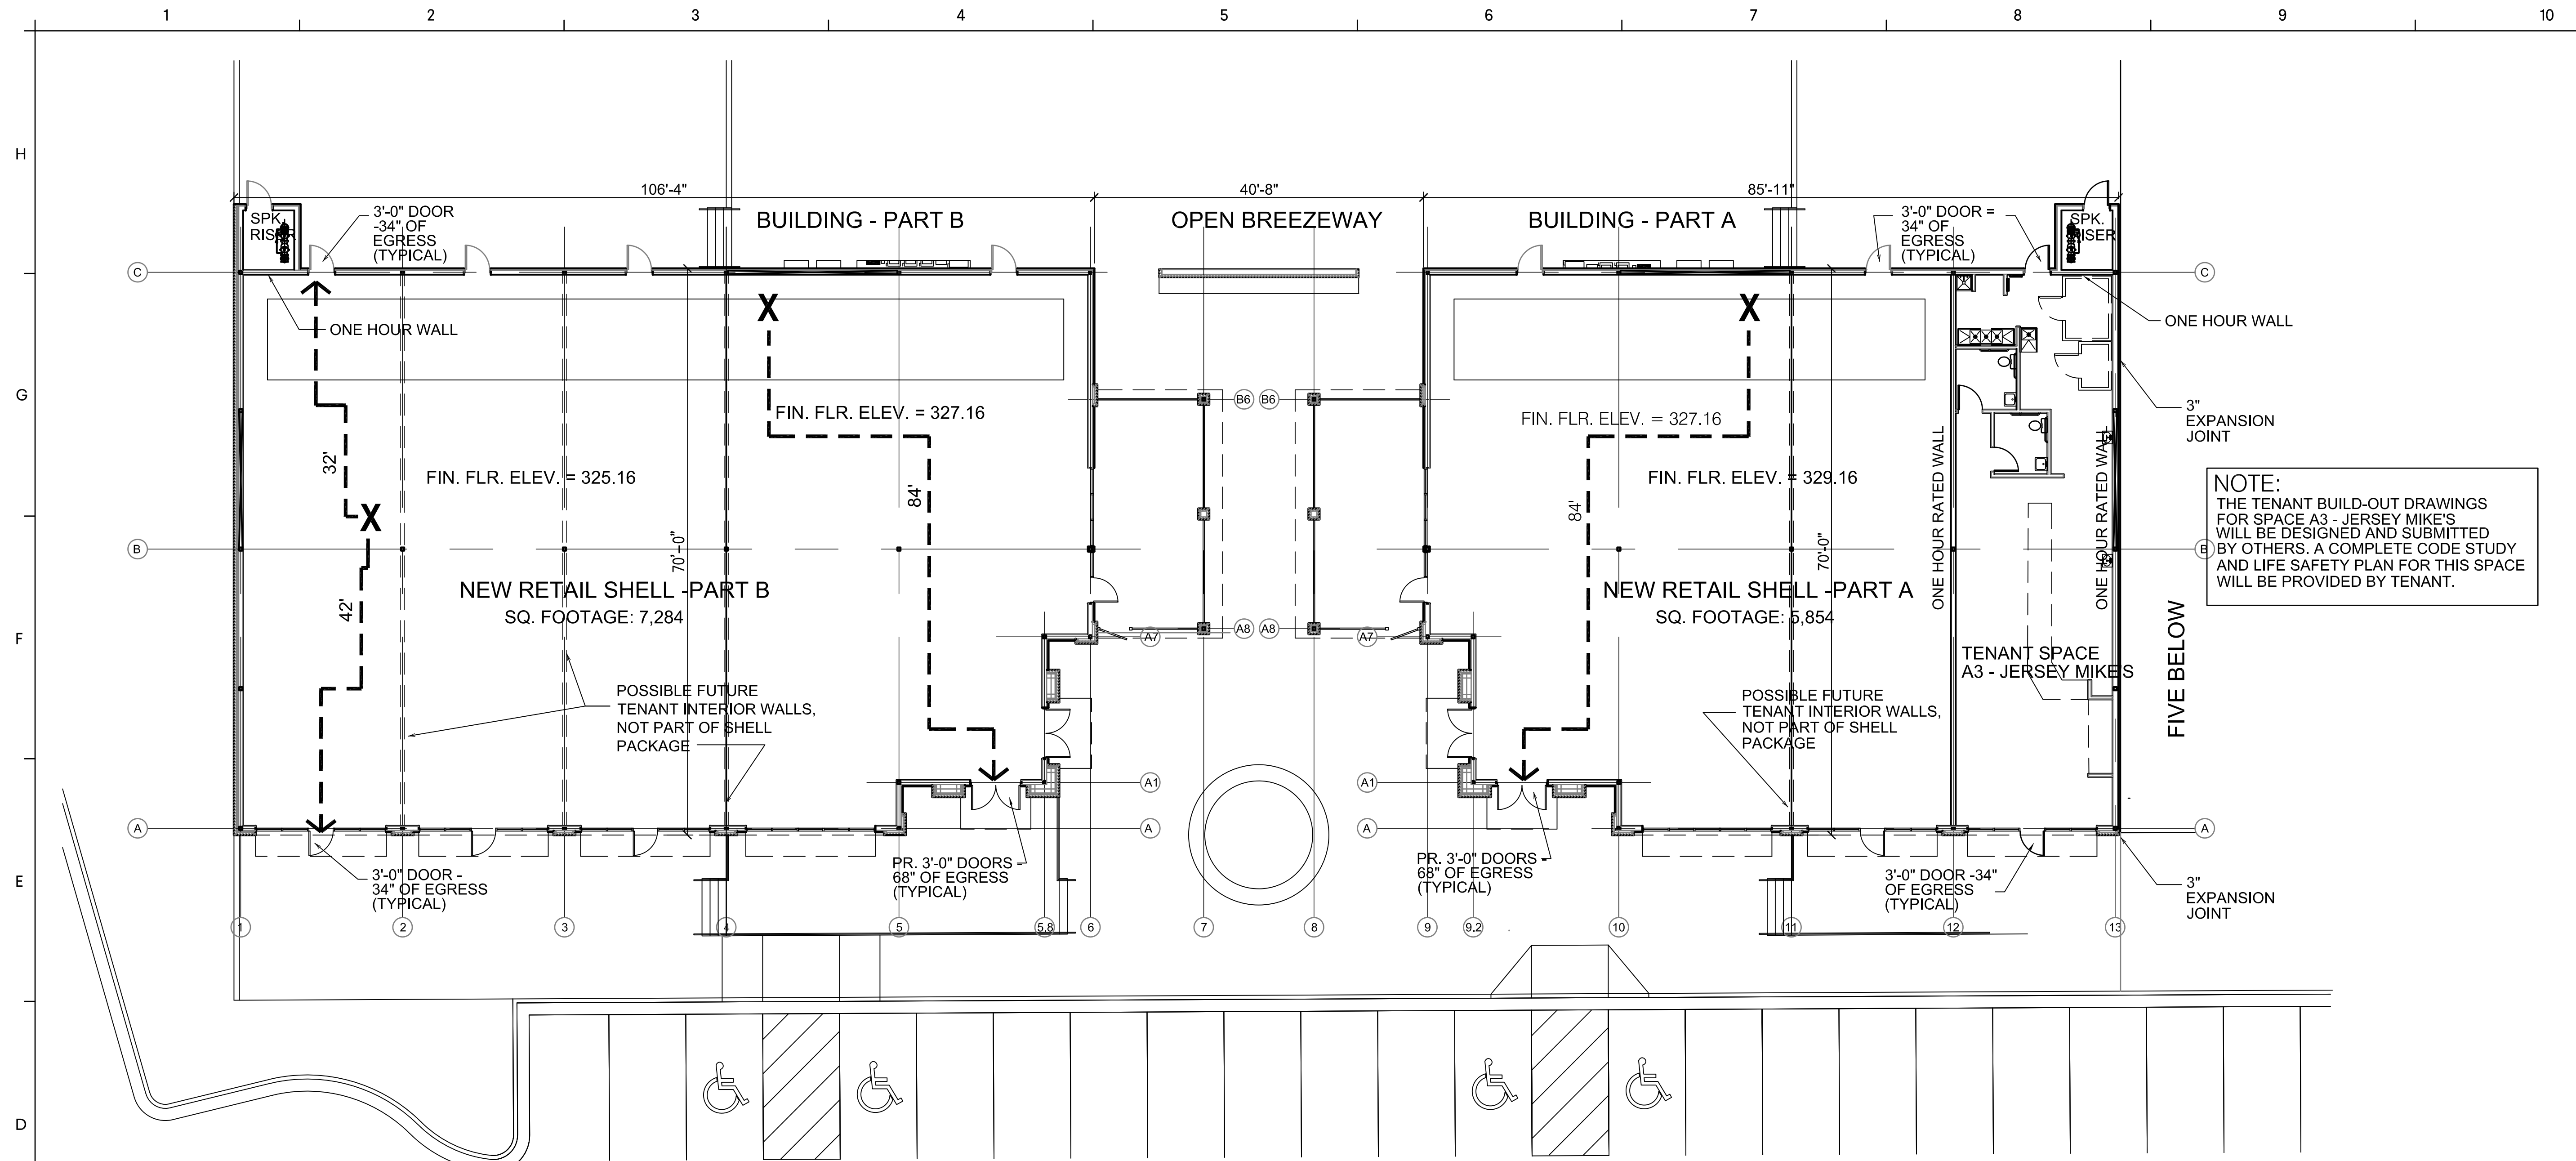

1 LIFE SAFETY PLAN
 LS.01 SCALE: 3/32" = 1'-0"

NOTE: SINCE THIS IS A SHELL ONLY BUILDING WITHOUT ANY TENANT LAYOUTS, THE TRAVEL DISTANCE EXAMPLES SHOWN ARE ONLY TO ENSURE PLAN REVIEWER THAT THERE SHOULD BE NO FUTURE TRAVEL COMPLIANCE ISSUES. ALL FUTURE TENANT BUILD-OUT SUBMITTALS WILL BE RESPONSIBLE FOR COMPLIANCE IN THEIR OWN SPACE.

CODE ANALYSIS

JURISDICTION
 CITY OF PRATTVILLE
 101 WEST MAIN STREET
 PLANNING AND DEVELOPMENT
 PRATTVILLE, ALABAMA

APPLICABLE CODES
 2015 INTERNATIONAL BUILDING CODE
 2015 ALABAMA COMMERCIAL ENERGY CODE
 2015 INTERNATIONAL PLUMBING CODE
 2015 INTERNATIONAL MECHANICAL CODE
 2015 INTERNATIONAL FUEL GAS CODE
 2015 INTERNATIONAL PROPERTY MAINTENANCE CODE
 2014 NATIONAL ELECTRICAL CODE NFPA 70

PROJECT SUMMARY
 THIS SUBMITTAL IS THE LANDLORD'S SHELL PACKAGE AND CONSISTS OF TENANT SPACE TO BE IDENTIFIED AS FUTURE NEW RETAIL. HOWEVER, THERE WILL BE ONE TENANT SPACE DESIGNATED AS A3 WHICH WILL INCLUDE MORE THAN JUST THE SHELL. IT WILL INCLUDE TOILETS, CEILING AND STUB IN PLUMBING. THE REMAINDER OF ITS BUILD-OUT WILL BE DESIGNED AND SUBMITTED BY THE TENANT.
 THIS IS TWO SEPARATE BUILDINGS TOTALING 13,138 SF SHELL ONLY BUILDINGS. NO INTERIOR WALLS OR PLUMBING FIXTURES UNDER THIS SCOPE. ALL INTERIOR WALLS, CEILINGS, FIXTURES, ETC. ARE TO BE SUBMITTED SEPARATELY UPON TENANT BUILDOUT OTHER THAN NOTED ABOVE.

OCCUPANCY: (303.3) (309)
 ASSEMBLY GROUP A2 - (PROPOSED FUTURE RESTAURANT TENANTS)
 MERCANTILE GROUP M - (PROPOSED FUTURE RETAIL TENANTS)
CONSTRUCTION TYPE: (601)
 TYPE II B UNPROTECTED, FULLY SPRINKLERED



FIRE PROTECTION: (700)
 FUTURE TENANT DEMISING WALLS TO BE ONE HOUR RATED TO DECK

GENERAL BUILDING HEIGHTS AND AREAS: (507.4)
 MERCANTILE SPRINKLERED, 1 STORY BUILDING WITH AN AUTOMATIC SPRINKLER SYSTEM IN ACCORDANCE WITH SECTION 903.3.1.1 IS NOT LIMITED.

GENERAL AREA MODIFICATIONS: (506)
 NOT REQUIRED

MAXIMUM TRAVEL DISTANCE TO EXIT: (1017.2)
 WITH AUTOMATIC SPRINKLER SYSTEM - 250'

PLUMBING FIXTURES:
 THE INTERIOR PACKAGE BEING SUBMITTED BY OTHERS WILL INCLUDE THE NECESSARY CODES INCLUDING THE PLUMBING FIXTURE COUNTS AS REQUIRED.

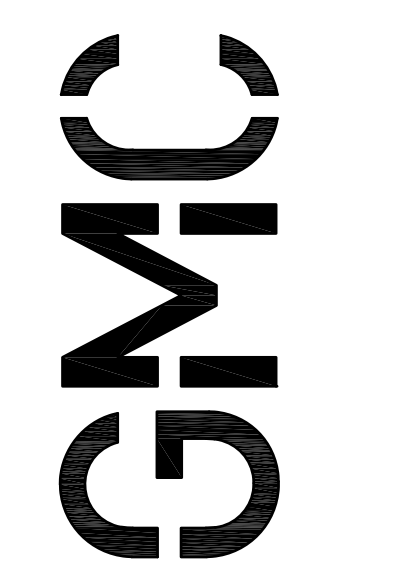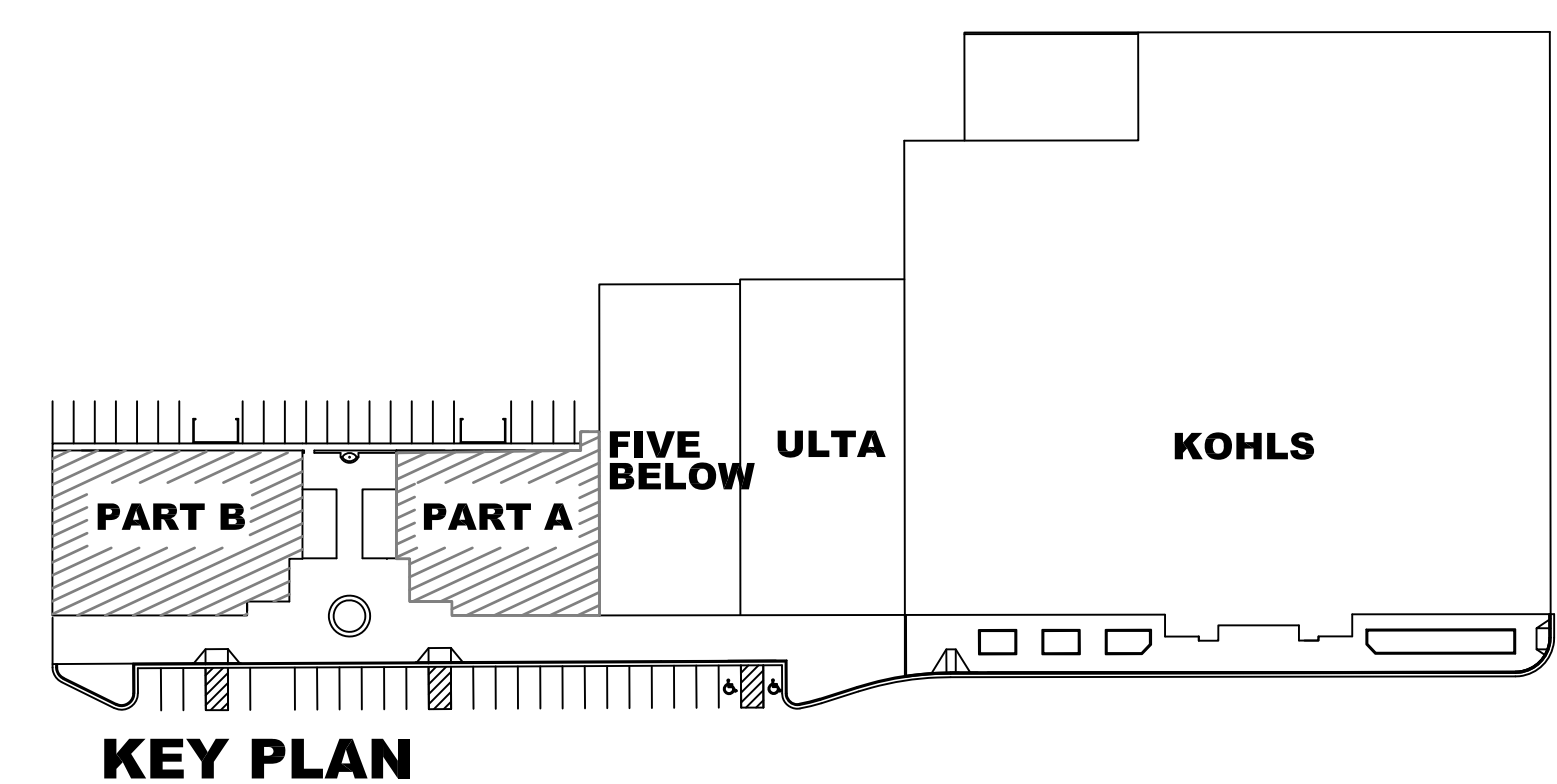


AS-BUILT

2660 East Chase Lane, Suite 200
 Montgomery, AL 36117
 T 334.271.3200
 GMCNETWORK.COM

ISSUE	DATE
75% REVIEW	04/18/19
95% REVIEW	05/30/19
PERMIT SET	10/17/19
DESIGNED BY:	GMC
DRAWN BY:	GMC
CHECKED BY:	GMC

THE EXCHANGE AT HOMEPLACE
 PRATTVILLE, AL
 GMC PROJECT #AMGM180037

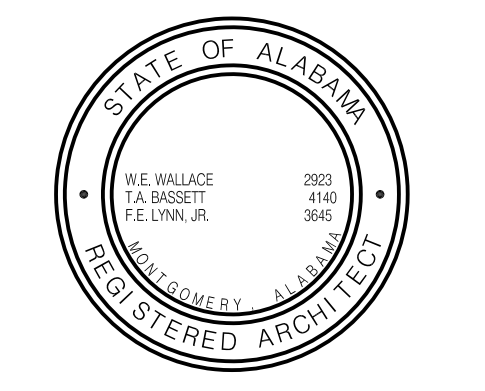


LIFE SAFETY PLAN

LS.01
 Sheet of


THE SHOPS AT

THE EXCHANGE AT HOMEPLACE


September, 2019

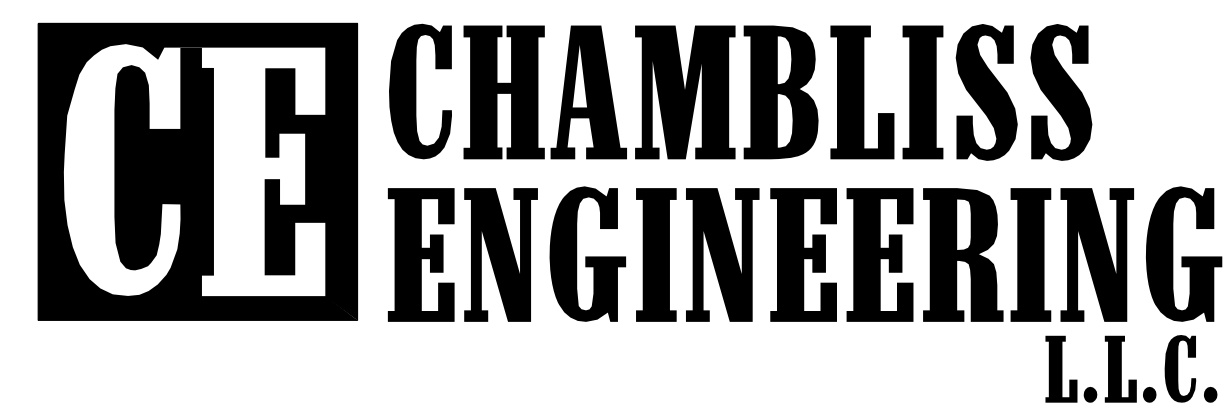

PRATTVILLE, ALABAMA

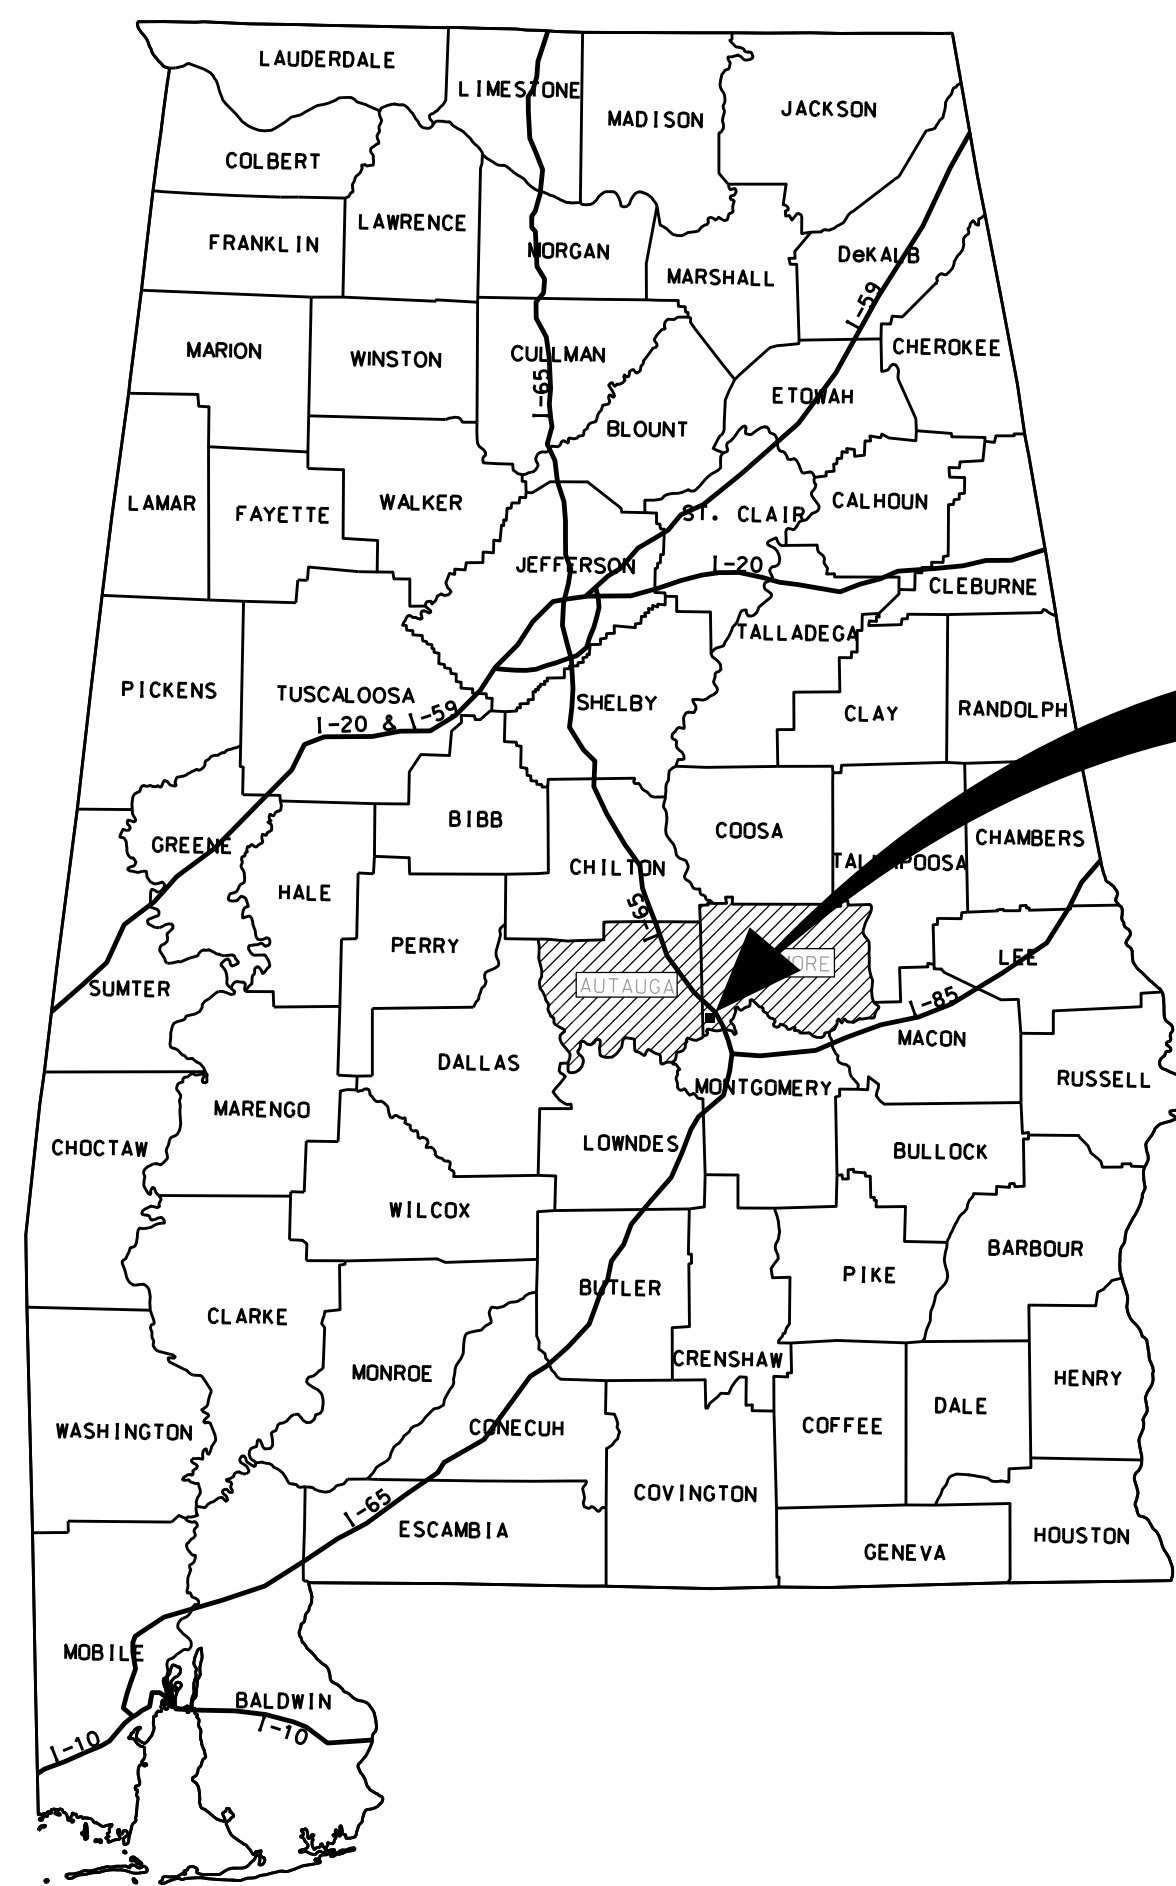

PROJECT LOCATION

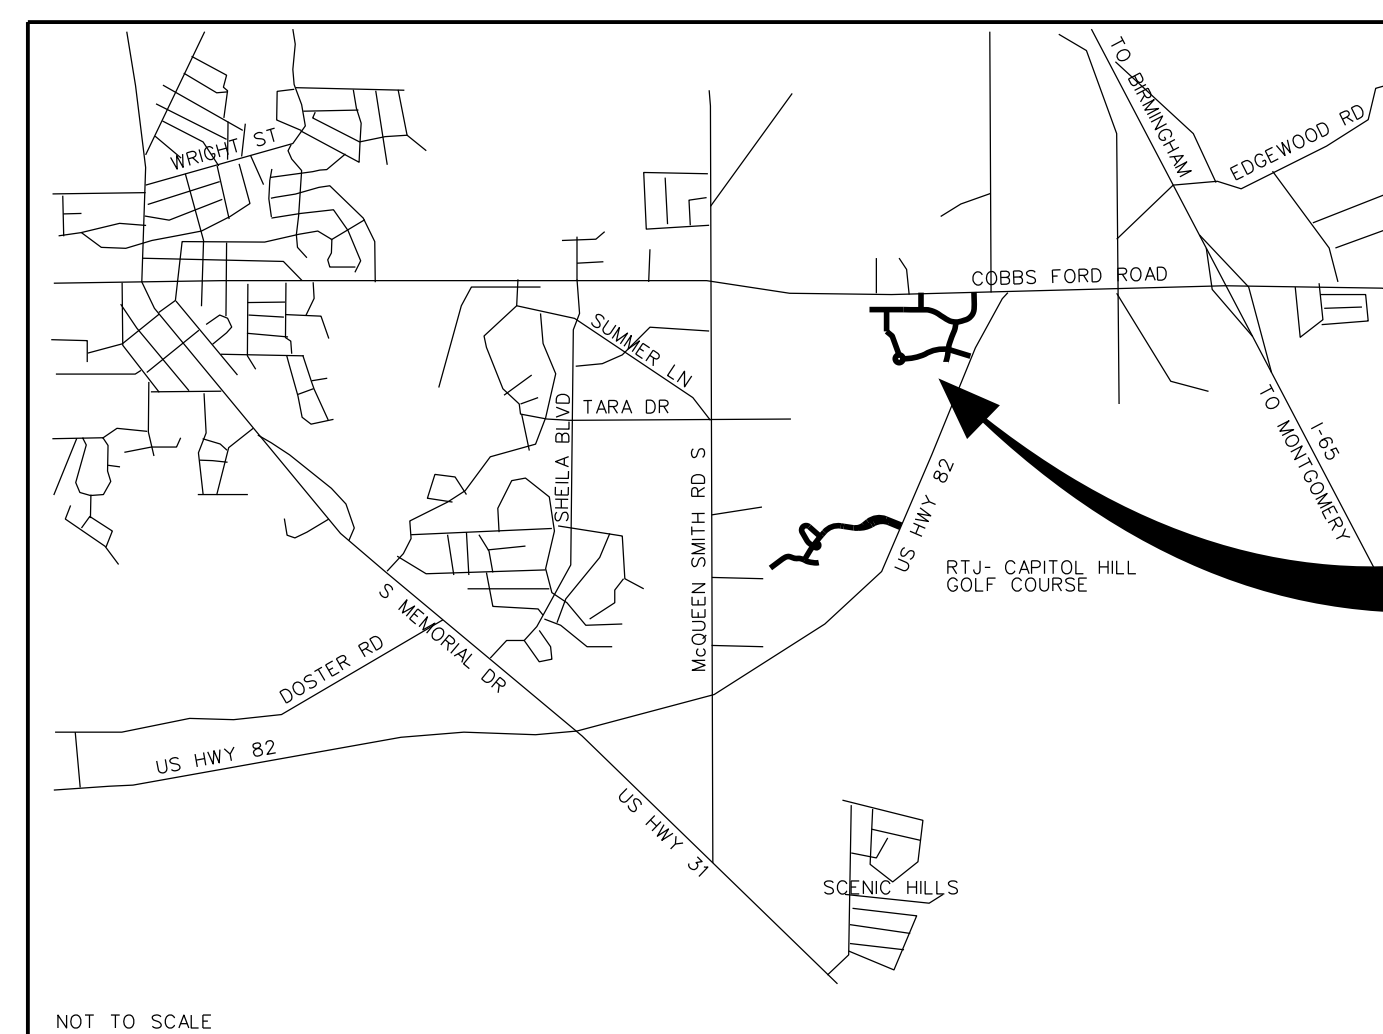

PROJECT LOCATION

SHEET INDEX

SHEET NUMBER	SHEET TITLE	REVISION
01	PROJECT INFORMATION	REVISED 9/23/19
02	OVERALL PLAN	
03	SITE PLAN	REVISED 9/23/19
04	GRADING PLAN	REVISED 9/23/19
05	UTILITY PLAN	REVISED 9/23/19
06	STORM DETAILS	
07	SEWER DETAILS	
08	WATER DETAILS	
09	EROSION CONTROL PLAN	
10	EROSION CONTROL DETAILS	
11	EROSION CONTROL DETAILS	



Permit Set



AS-BUILT

THE SHOPS AT
The Exchange at HomePlace
Prattville, Alabama

DATE	9/23/2019
PROJECT NO.	019-19-116
DESIGNED	CLC
DRAWN	CCJ
APPROVED	CLC
SCALE	NONE
SHEET TITLE	PROJECT INFORMATION
SHEET NO.	01

Notes:

- 1) Construction staging shall be limited to the vacant area west of the proposed retail space.
- 2) Disruption of the shopping center access drives and common access drives is not allowed.
- 3) A minimum of one-way access of the delivery common access drive is required at all times.
- 4) Receiving activities may not block the delivery common access drive.

BENCH MARK:
FOUND CAPPED IRON PIN
NORTHING= 17642.35
EASTING= 15129.39
ELEV.= 332.09

TO COBBS FORD ROAD

LANDSCAPING (BY OTHERS)

	REQUIRED	PROPOSED
PERIMETER	40,742 SF	56,398 SF
FOUNDATION	4,852 SF	4,904 SF
INTERIOR	16,257 SF	16,531 SF

PARKING

	REQUIRED	PROPOSED
OVERALL (5 PER 1000)	644	724
KOHL'S (4.5 PER 1000)	290	290




**CHAMBLISS
ENGINEERING**

356 Highway 82 West
Prattville, AL 36067
(334) 491-2323

AS-BUILT

THE SHOPS AT
The Exchange at HomePlace

Prattville, Alabama

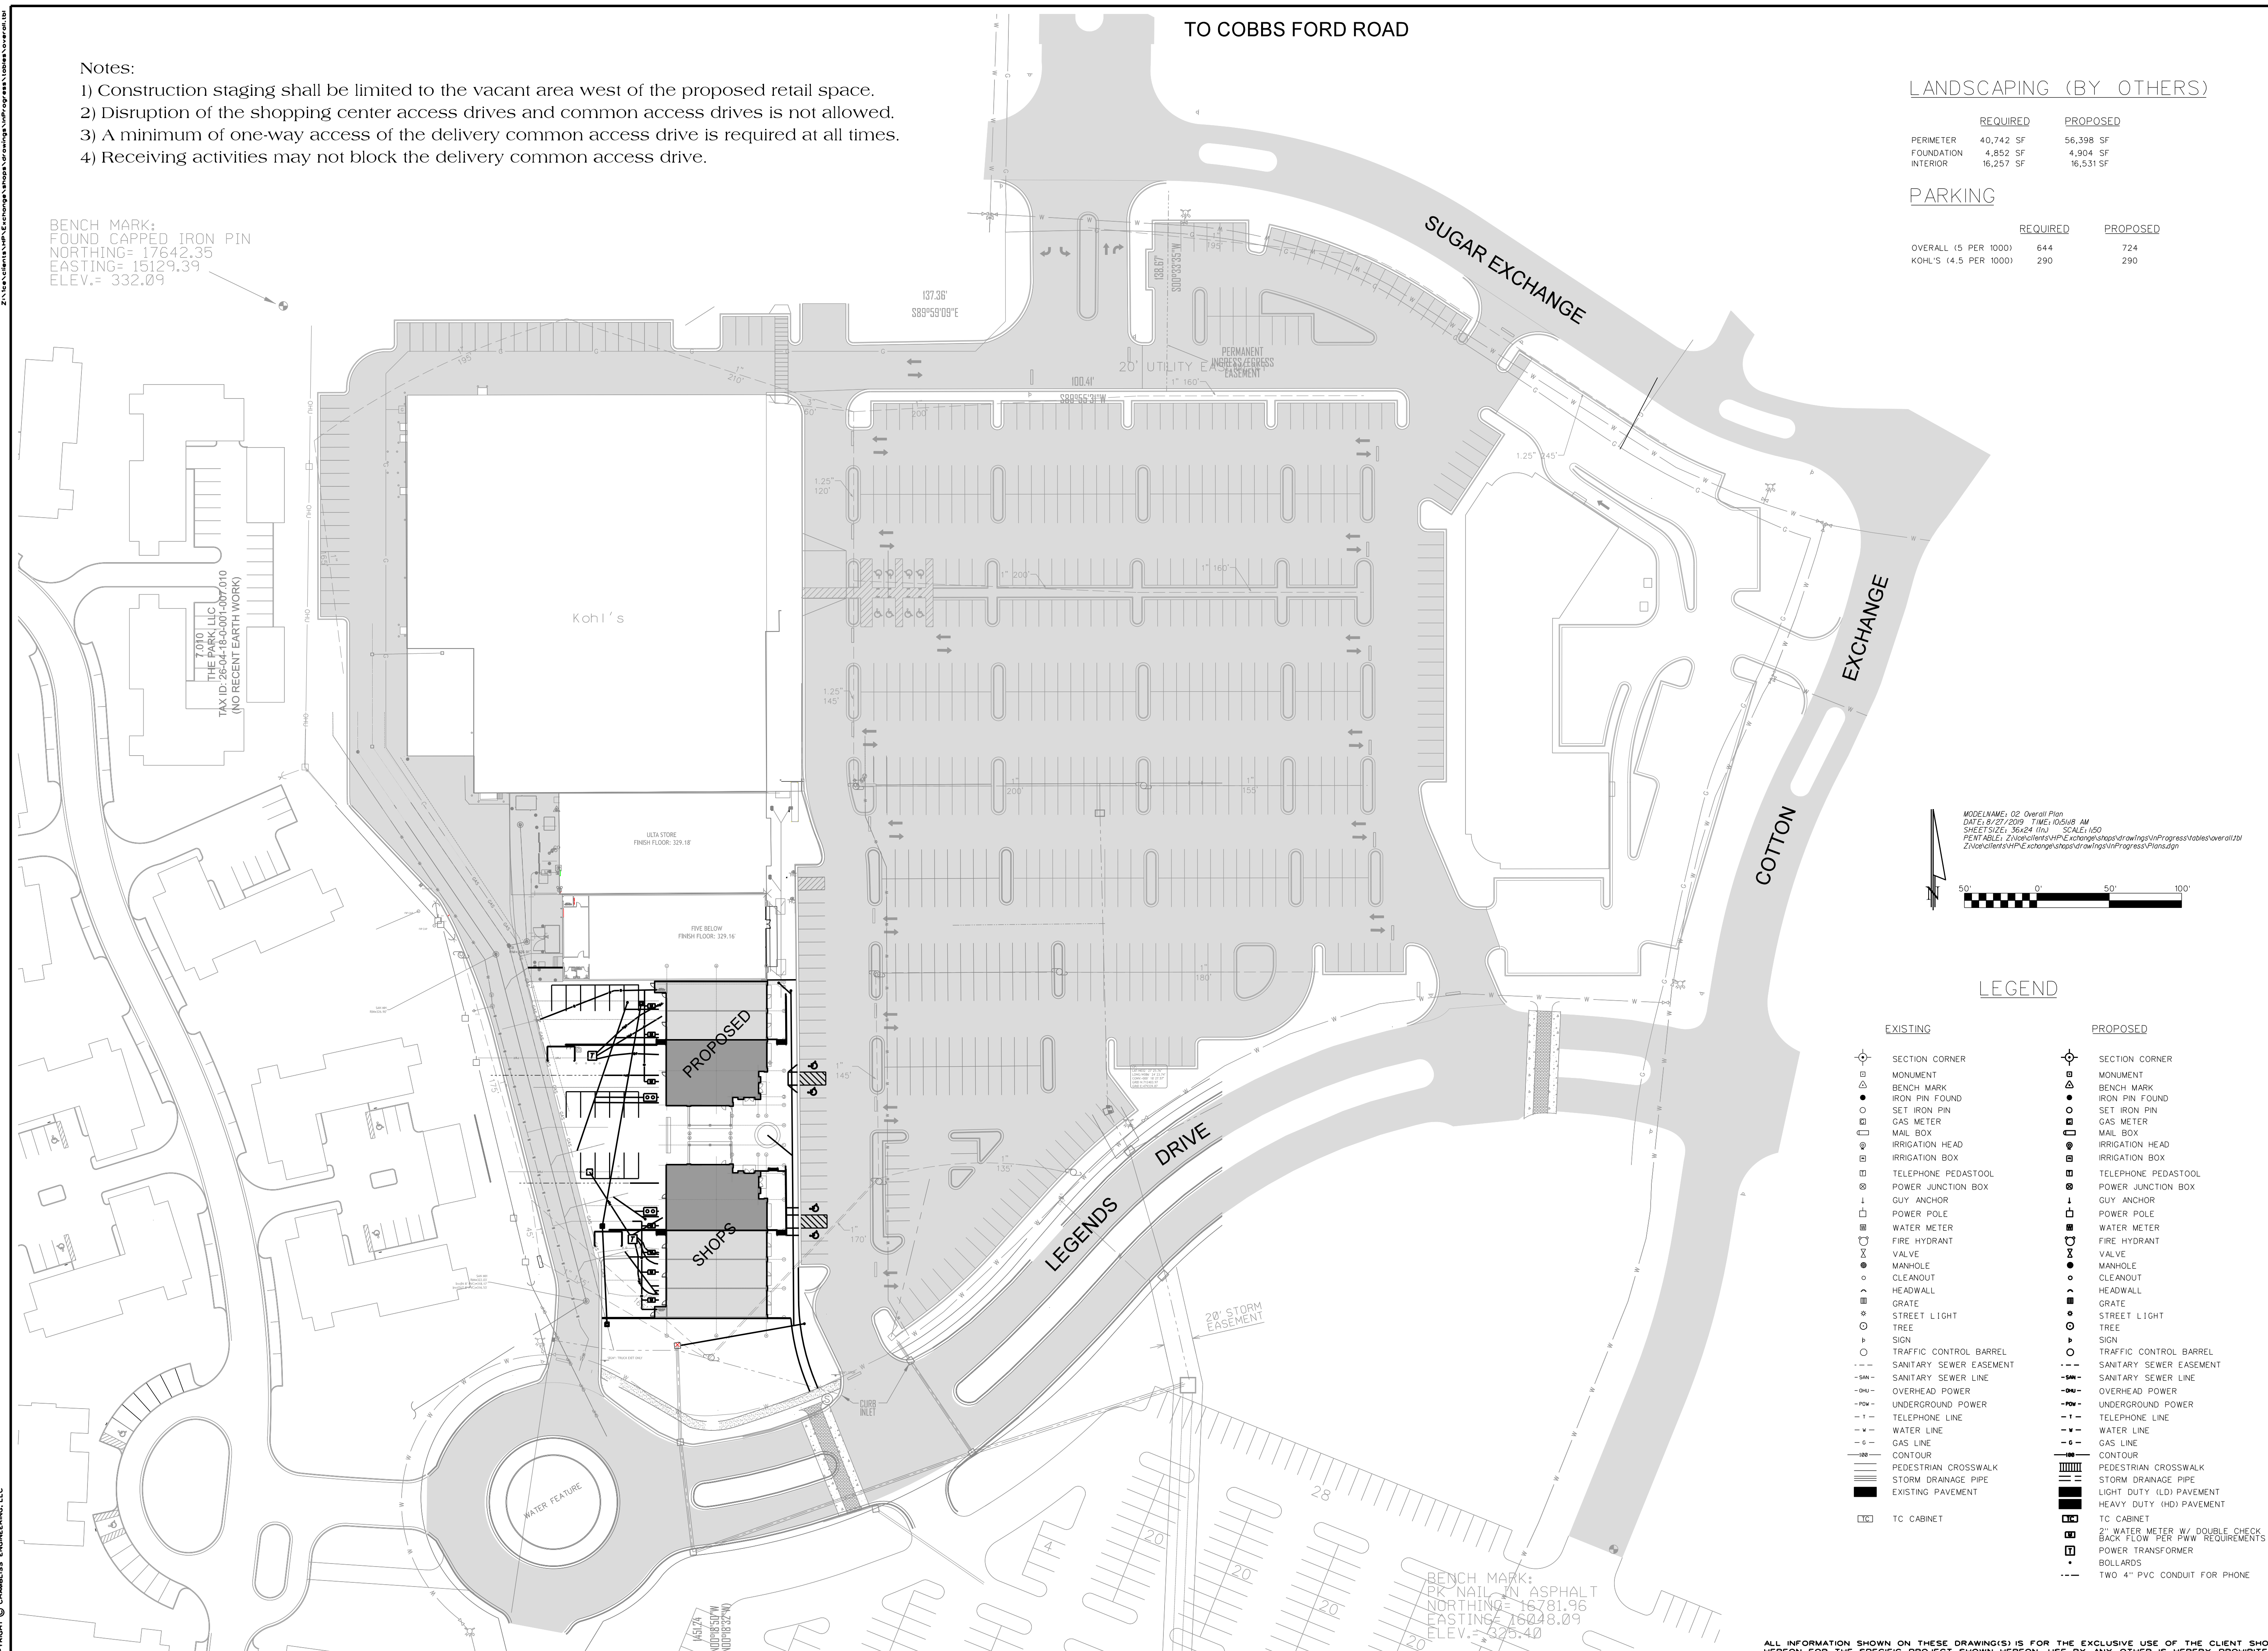

MODELNAME: 02 Overall Plan
DATE: 8/27/2019 TIME: 10:58 AM
SHEET SIZE: 36x24 (in.) SCALE: 1/8"=1'-0"
PLOTTABLE: 2:\Projects\1919-116_The Exchange Shops\Drawings\Progress\1919-116_Overall.dwg
2:\Projects\1919-116_The Exchange Shops\Drawings\Progress\1919-116.dwg




LEGEND

EXISTING	PROPOSED
SECTION CORNER	SECTION CORNER
MONUMENT	MONUMENT
BENCH MARK	BENCH MARK
IRON PIN FOUND	IRON PIN FOUND
SET IRON PIN	SET IRON PIN
GAS METER	GAS METER
MAIL BOX	MAIL BOX
IRRIGATION HEAD	IRRIGATION HEAD
IRRIGATION BOX	IRRIGATION BOX
TELEPHONE PEDASTOOL	TELEPHONE PEDASTOOL
POWER JUNCTION BOX	POWER JUNCTION BOX
GUY ANCHOR	GUY ANCHOR
POWER POLE	POWER POLE
WATER METER	WATER METER
FIRE HYDRANT	FIRE HYDRANT
VALVE	VALVE
MANHOLE	MANHOLE
CLEANOUT	CLEANOUT
HEADWALL	HEADWALL
GRATE	GRATE
STREET LIGHT	STREET LIGHT
TREE	TREE
SIGN	SIGN
TRAFFIC CONTROL BARREL	TRAFFIC CONTROL BARREL
SANITARY SEWER EASEMENT	SANITARY SEWER EASEMENT
SANITARY SEWER LINE	SANITARY SEWER LINE
OVERHEAD POWER	OVERHEAD POWER
UNDERGROUND POWER	UNDERGROUND POWER
TELEPHONE LINE	TELEPHONE LINE
WATER LINE	WATER LINE
GAS LINE	GAS LINE
CONTOUR	CONTOUR
PEDESTRIAN CROSSWALK	PEDESTRIAN CROSSWALK
STORM DRAINAGE PIPE	STORM DRAINAGE PIPE
EXISTING PAVEMENT	LIGHT DUTY (LD) PAVEMENT
	HEAVY DUTY (HD) PAVEMENT
	TC CABINET
	2" WATER METER W/ DOUBLE CHECK BACK FLOW PER PW REQUIREMENTS
	POWER TRANSFORMER
	BOLLARDS
	TWO 4" PVC CONDUIT FOR PHONE

DATE	8/27/2019
PROJECT NO.	019-19-116
DESIGNED	CLC
DRAWN	CCJ
APPROVED	CLC
SCALE	1"=50'
SHEET TITLE	OVERALL PLAN
SHEET NO.	02

OVERALL
PLAN

02

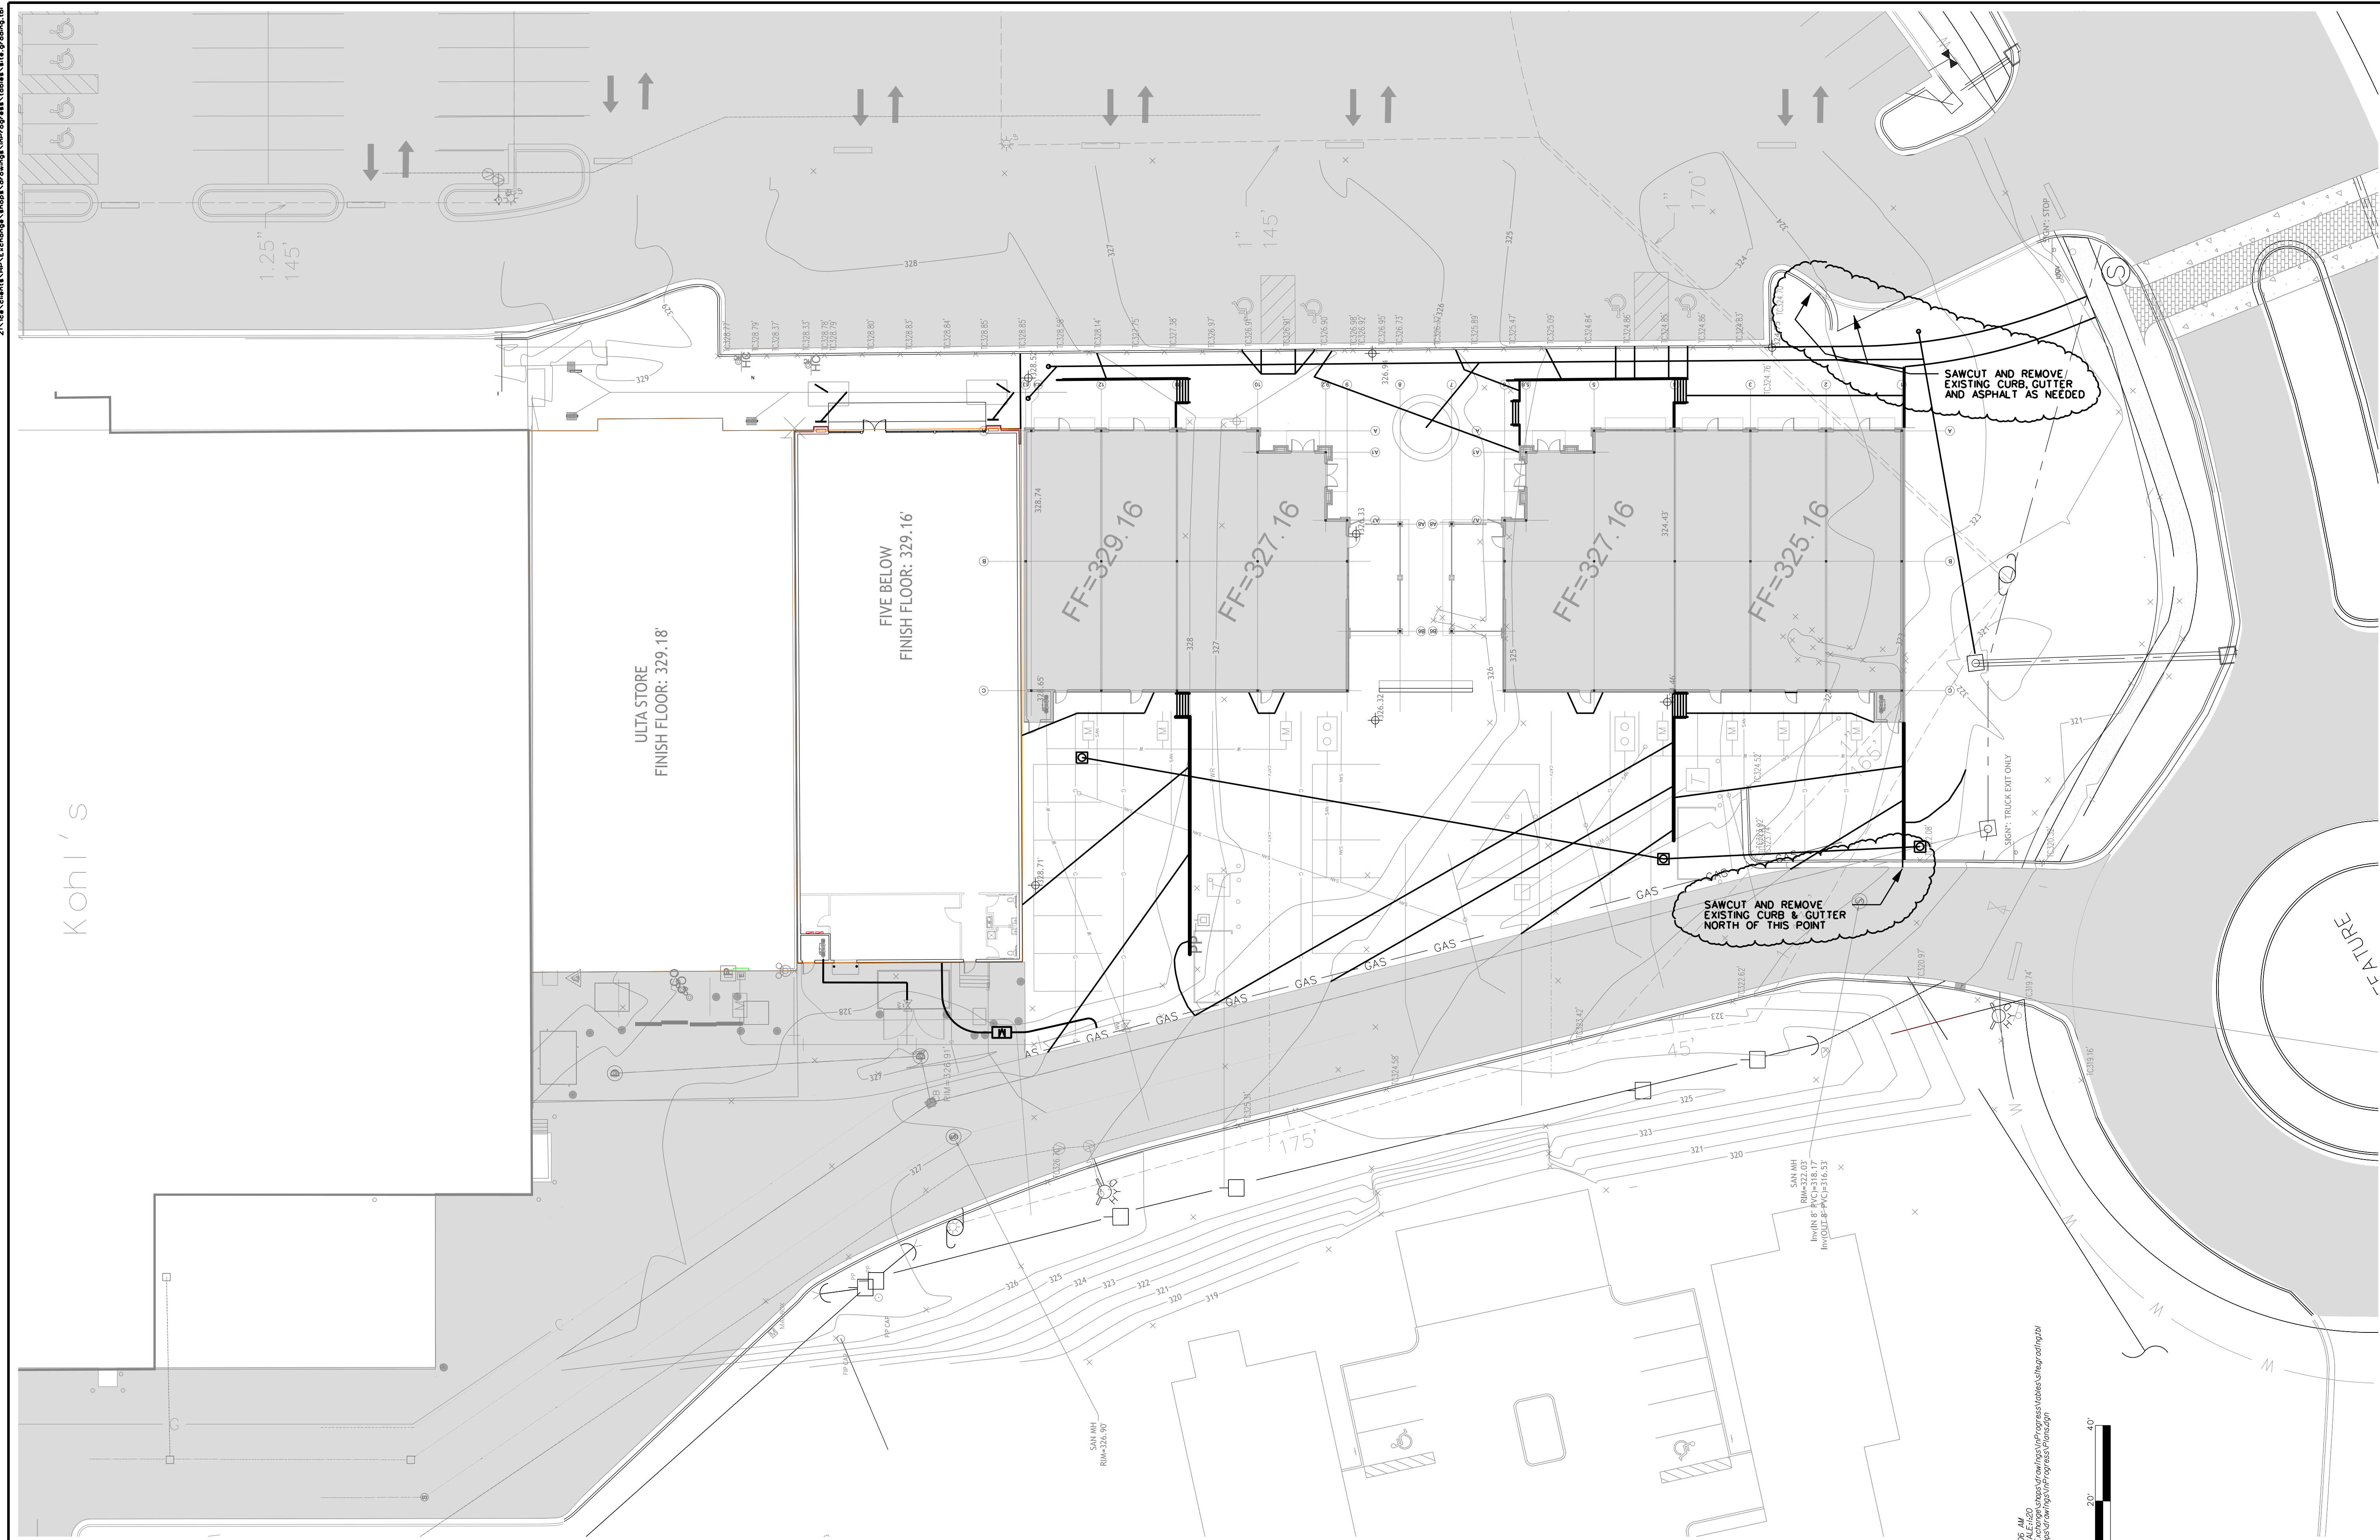

CONTRACTOR TO POT HOLE EXISTING UTILITIES AT PROJECT COMMENCEMENT AND COORDINATE SEWER AND STORM GRADES WITH THE ENGINEER. SEQUENCE OF WORK SHALL BE AS FOLLOWS UNLESS APPROVED OTHERWISE BY THE ENGINEER: POT HOLE EXISTING UTILITIES, FOUNDATIONS, SLABS, COMPLETE UTILITIES, CONCRETE PAVING IN REAR, BUILDING SHELLS, CONCRETE PAVING IN FRONT, BUILDING COMPLETION, PROVIDE 6" FIBERMESH 4,000 PSI CONCRETE SLAB W/ 6"x6" WWF FROM BACK OF BUILDING TO EXISTING ASPHALT AND ENTIRE WIDTH OF BUILDINGS. CONTRACTOR TO OBTAIN A NPDES CONSTRUCTION STORMWATER PERMIT FROM PROJECT COMMENCEMENT UNTIL STABILIZATION PER ADEM REGULATIONS. CONTRACTOR TO PROVIDE CONSTRUCTION STAKING.

MODEL NAME: 03 Site Plan
SHEET SIZE: 36x24 (in) SCALE: AS SHOWN
DATE: 9/23/2019 TIME: 8:40:06 AM
Z:\Projects\1919\1919-116\1919-116.dwg



THE SHOPS AT
The Exchange at HomePlace
Prattville, Alabama

DATE	9/23/2019
PROJECT NO.	019-19-116
DESIGNED	CLC
DRAWN	CCJ
APPROVED	CLC
SCALE	NOTED
SHEET TITLE	

SITE AND DEMO PLAN

110
3/23/2019
9:23:20 AM
Z:\Projects\2019\09-19-116\Drawings\Grading\Grading.dwg
CHAMBLISS ENGINEERING, LLC
9/23/2019 9:23:20 AM
Z:\Projects\2019\09-19-116\Drawings\Grading\Grading.dwg
CHAMBLISS ENGINEERING, LLC

CONCRETE PAVING SHALL BE FLUSH WITH FINISHED FLOOR AT DOORS AND 0.1' BELOW FINISHED FLOOR ELSEWHERE. WALL CONSTRUCTION SHALL BE DESIGNED TO PREVENT BLOWING RAIN FROM FLOWING UNDER THE WALL. IF NOT, CONCRETE PAVING SHALL BE 0.5' BELOW FINISHED FLOOR EXCEPT AT DOORS AND ADJUST GRADES ACCORDINGLY. CONCRETE PAVING SHALL SLOPE AWAY FROM BUILDING. THE +/- 7' OF SIDEWALK ADJACENT TO THE EXISTING CURB ON THE EAST SIDE OF THE BUILDING SHALL BE SLOPED 1% TOWARD THE CURB. CONTRACTOR SHALL SET STRINGLINES FOR EACH SLAB AND REVIEW IN THE FIELD WITH THE ENGINEER BEFORE POURING ANY CONCRETE.

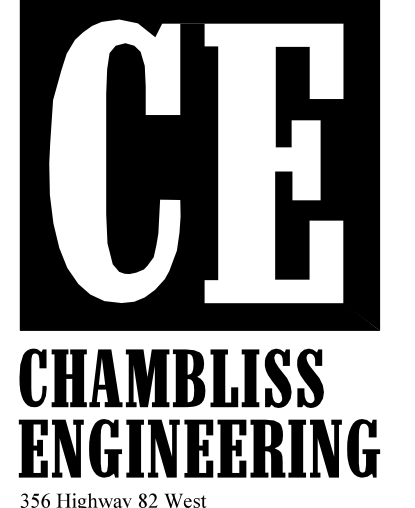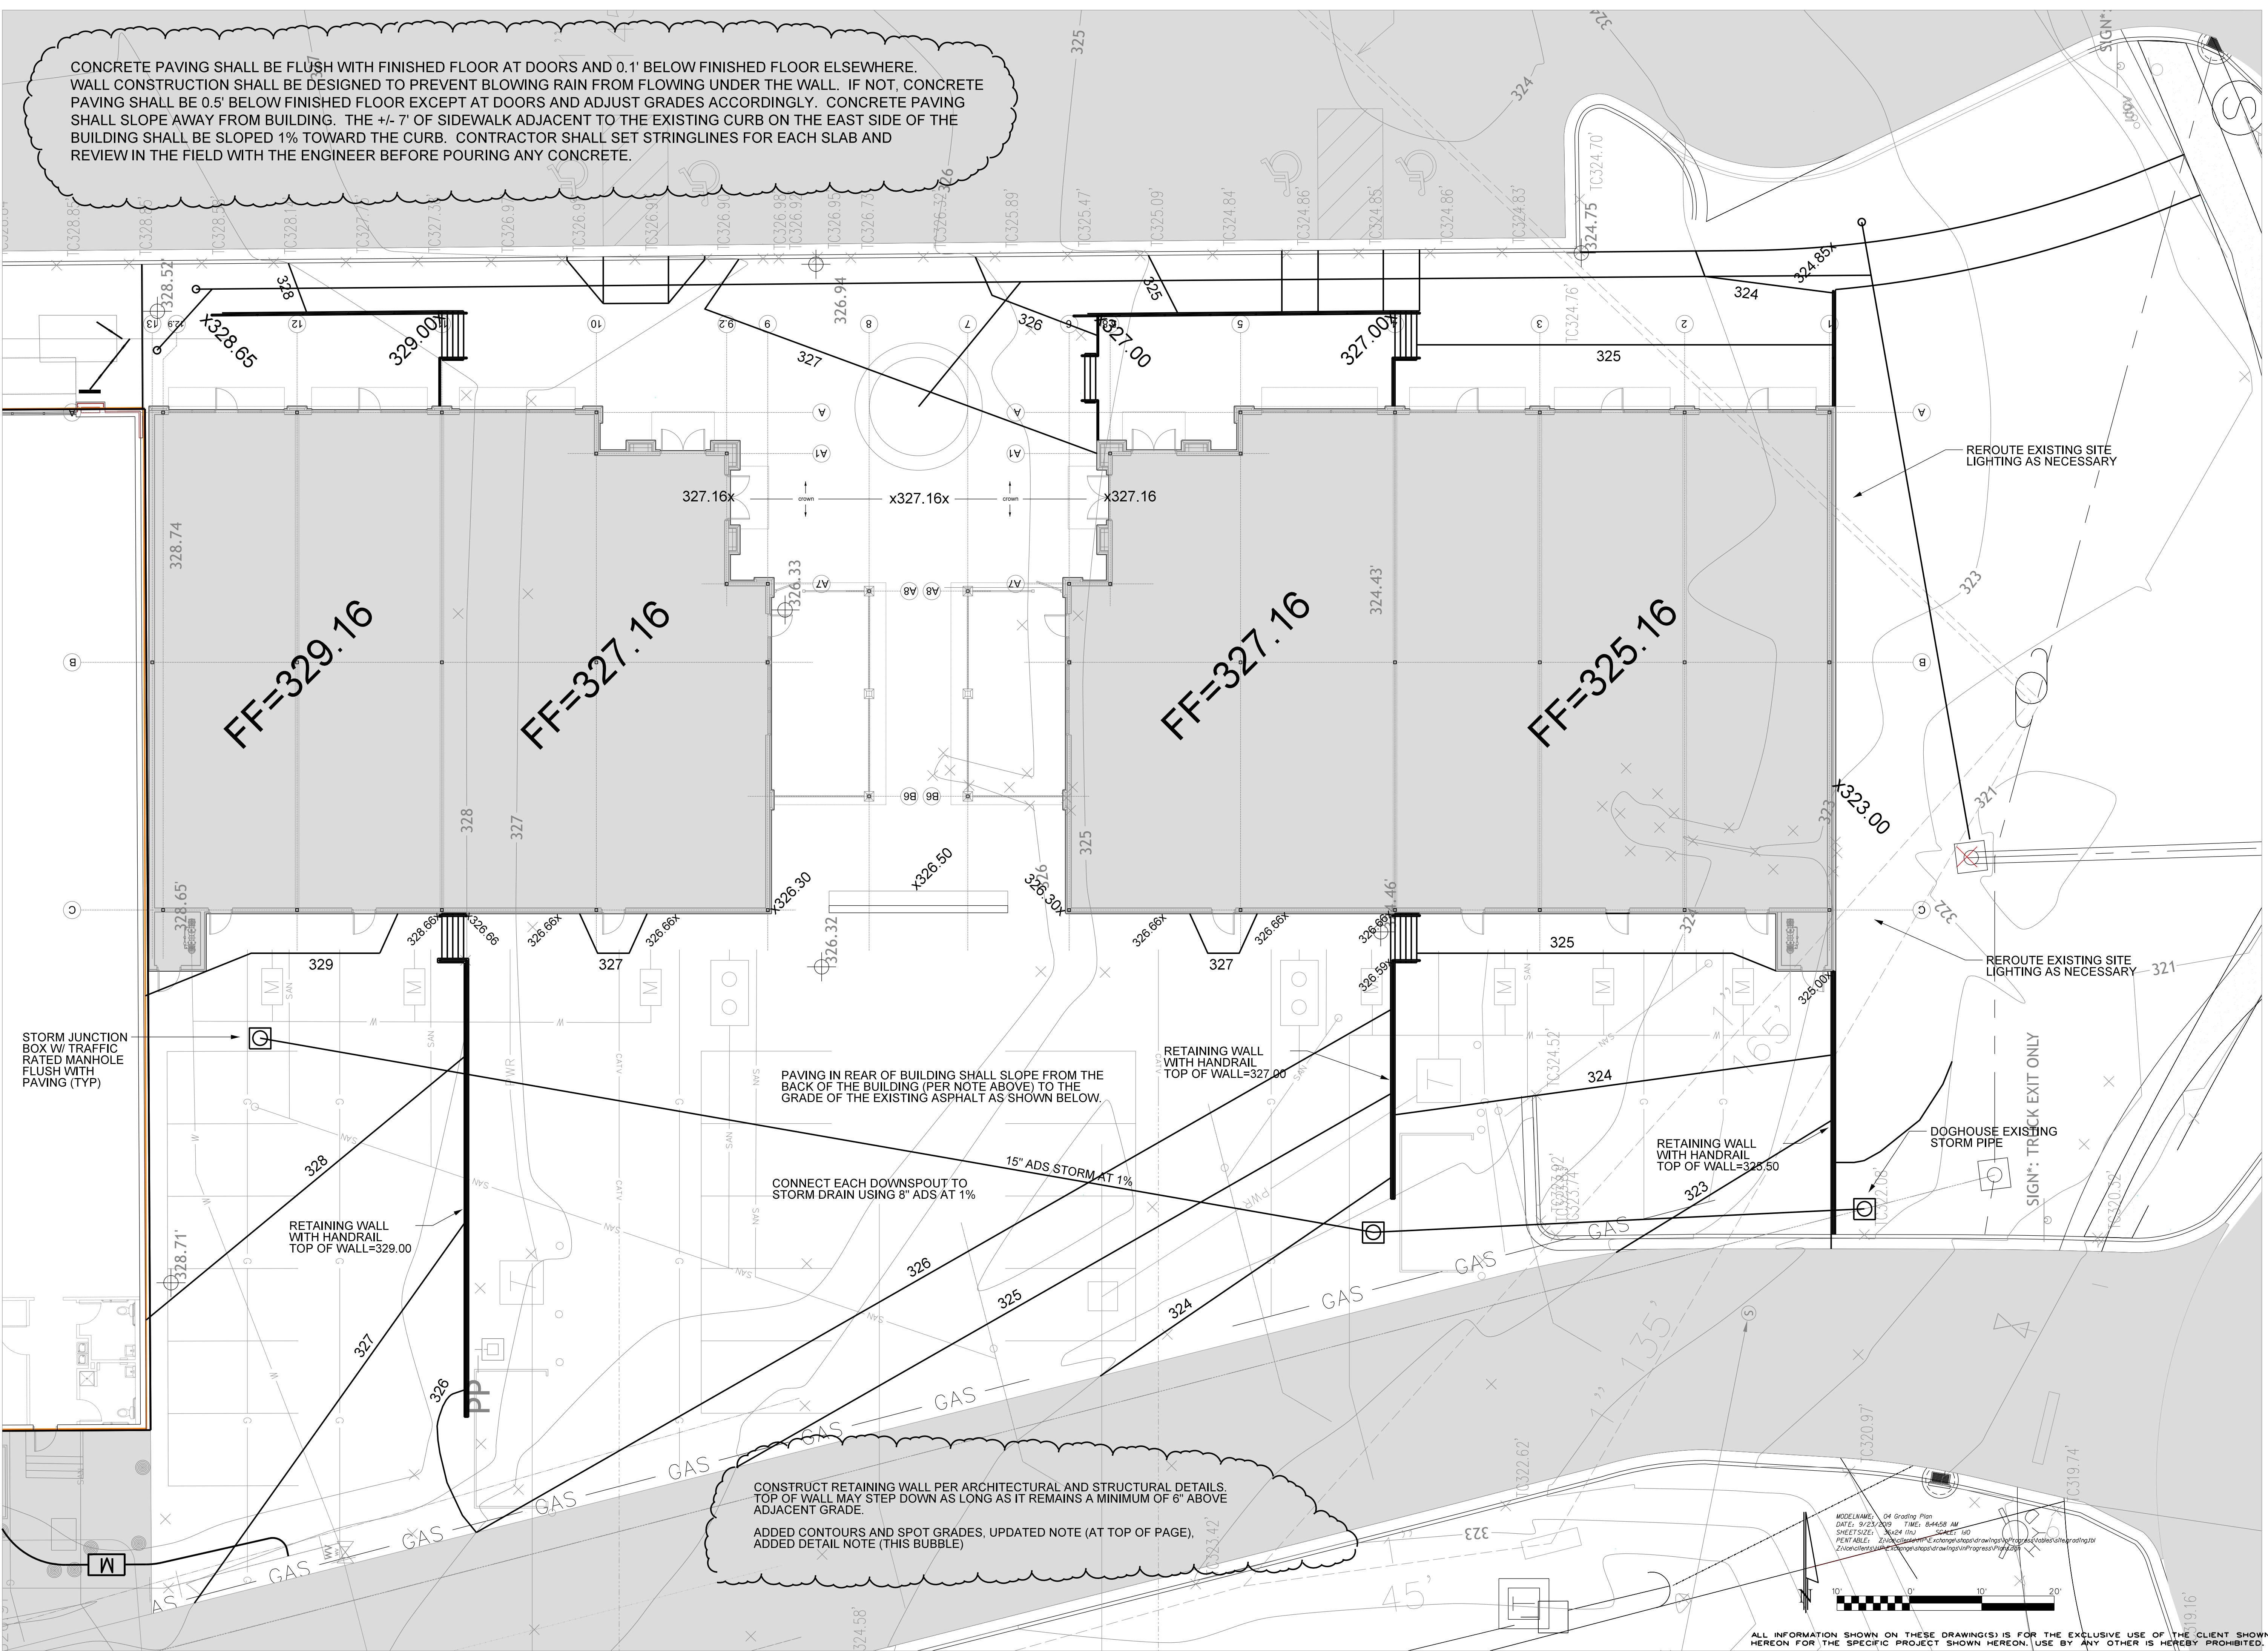

AS-BUILT

THE SHOPS AT


The Exchange at HomePlace

Prattville, Alabama

DATE	9/23/2019
PROJECT NO.	019-19-116
DESIGNED	CLC
DRAWN	CCJ
APPROVED	CLC
SCALE	NOTED
SHEET TITLE	GRADING PLAN
SHEET NO.	04
OF	11

9/23/2019 8:58:30 AM 21: New Utility Work - Shop's at HomePlace - 356 Highway 82 West Prattville, AL 36067
 110 36x24 (in.) 0 Utility Plan
 21: New Utility Work - Shop's at HomePlace - 356 Highway 82 West Prattville, AL 36067
 COPYRIGHT © CHAMBLISS ENGINEERING, LLC

GREASE INTERCEPTORS SHALL BE 1,500 GALLON TRAFFIC RATED AASHTO HS20, MANUFACTURED IN ACCORDANCE WITH ASTM C890, ACI 318 AND ASTM C161B. CONCRETE SHALL BE 5,000 PSI AND REINFORCING STEEL SHALL BE GRADE 60.
 SEWER LATERALS SHALL BE 4" PVC CLASS 200 OR SCHEDULE 40 UNLESS NOTED OTHERWISE.
 WATER MAIN SHALL BE 8" DUCTILE IRON AND INSTALLED PER PRATTVILLE WATER WORKS AND ADEM STANDARDS.
 WATER SERVICES SHALL BE 1" FOR THE FIVE SMALL SPACES AND 2" FOR THE TWO LARGE SPACES. SERVICE LINES SHALL BE SOLID STRAND, TYPE K COPPER. METERS SHALL BE OBTAINED FROM PRATTVILLE WATER WORKS BOARD.
 EXTEND ALL UTILITIES TO BUILDING IN COORDINATION WITH MECHANICAL PLANS.

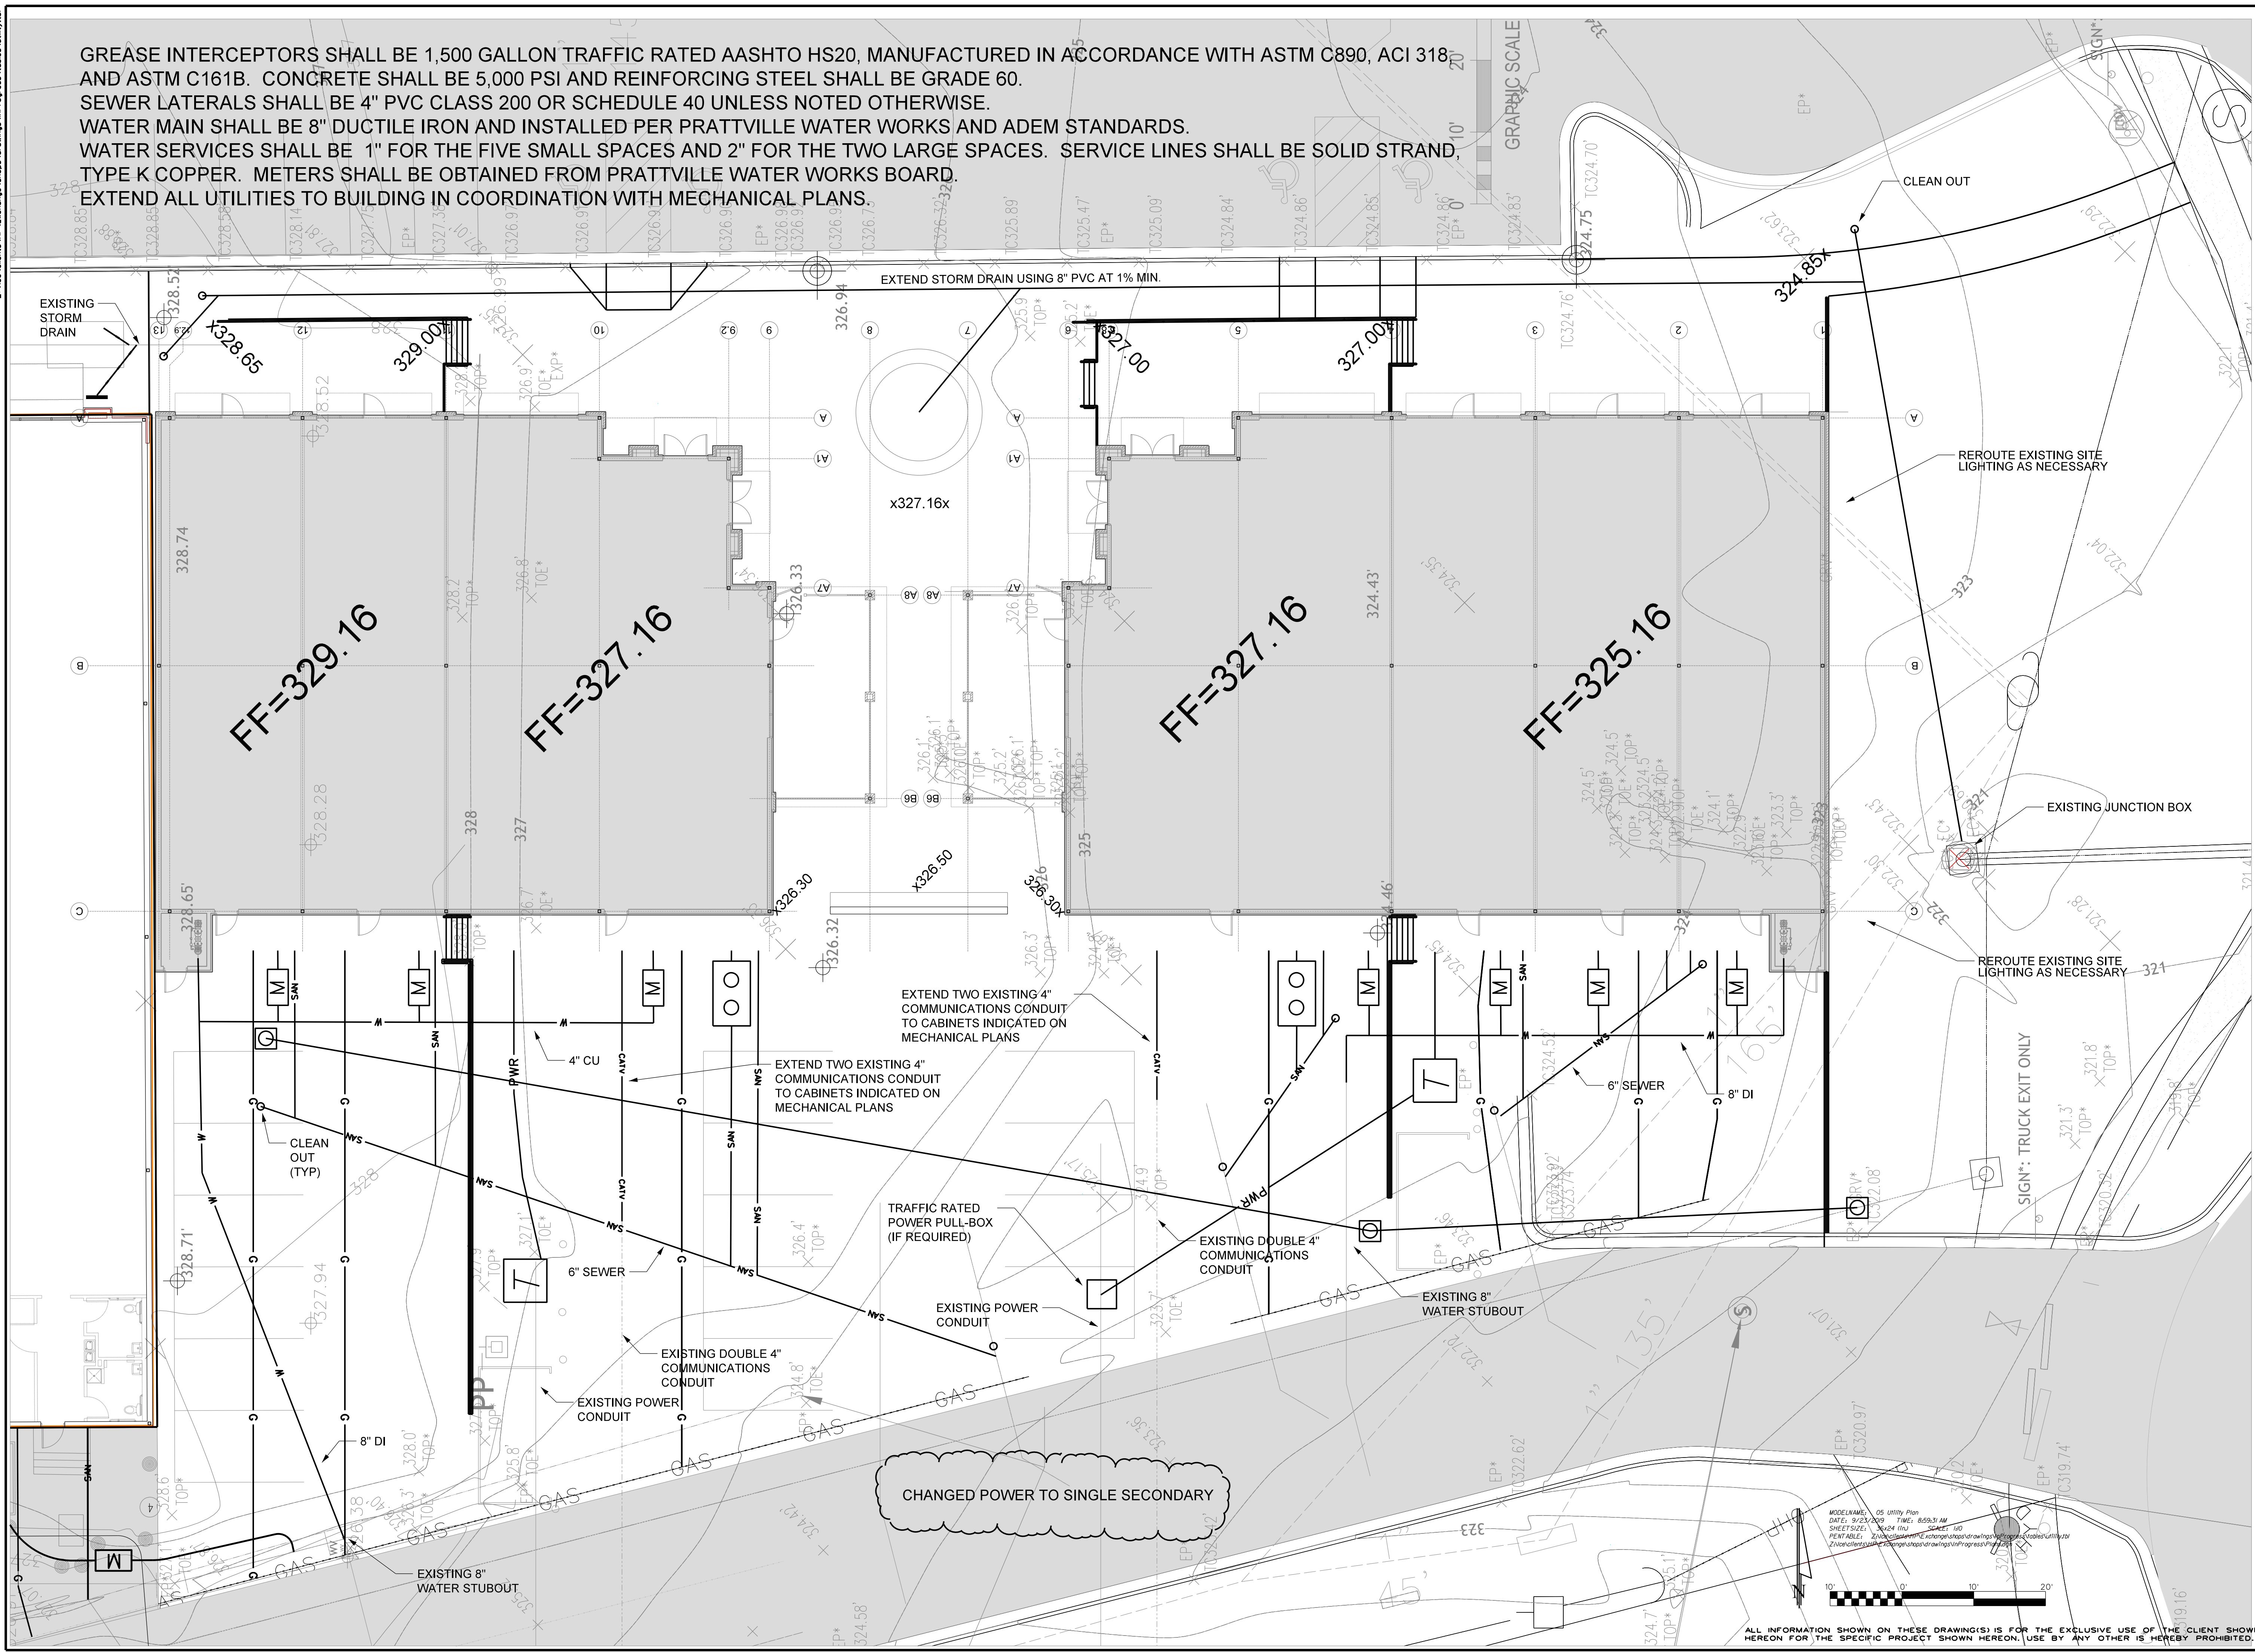


DATE	9/23/2019
PROJECT NO.	019-19-116
DESIGNED	CLC
DRAWN	CCJ
APPROVED	CLC
SCALE	NOTED
SHEET TITLE	

UTILITY PLAN

SHEET NO.

05

ALL INFORMATION SHOWN ON THESE DRAWING(S) IS FOR THE EXCLUSIVE USE OF THE CLIENT SHOWN HEREON FOR THE SPECIFIC PROJECT SHOWN HEREON. USE BY ANY OTHER IS HEREBY PROHIBITED.

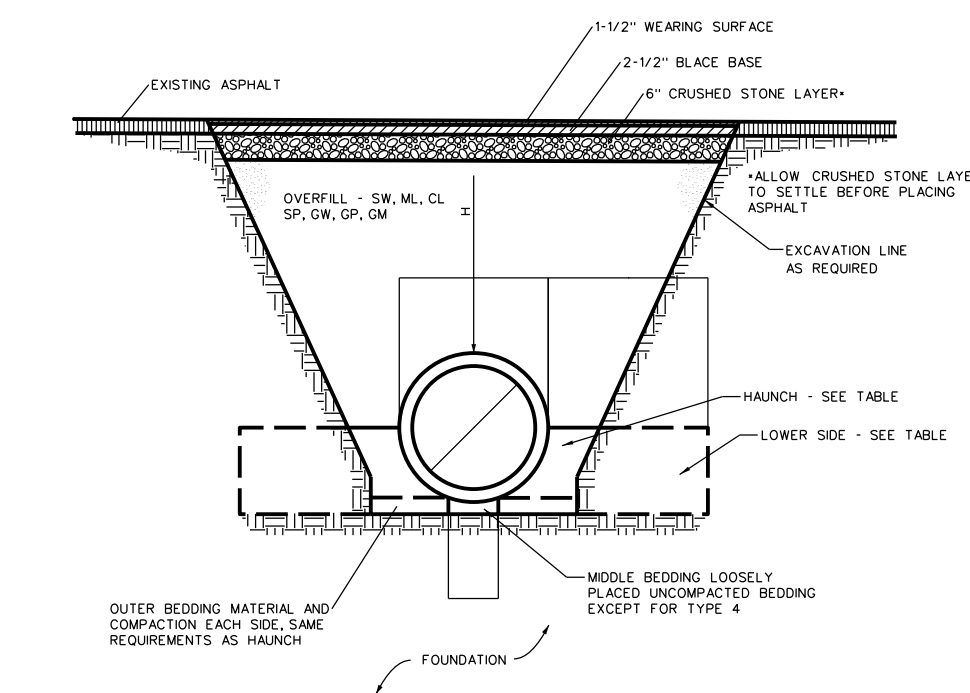


STANDARD TRENCH UNDER PAVEMENT


STANDARD TRENCH INSTALLATION

INSTALLATION TYPE	BEDDING THICKNESS	HARNESS AND OUTER BEDDING	LOWER SIDE
TYPE 1	Du/24 MINIMUM, NOT LESS THAN 3/4" (19mm) IF ROCK FOUNDATION, USE Du/12 MINIMUM, NOT LESS THAN 6x (150mm).	901 SW	902 SW, 903 SW, 904 SW, 905 SW, 906 SW
TYPE 2	Du/24 MINIMUM, NOT LESS THAN 3/4" (19mm) IF ROCK FOUNDATION, USE Du/12 MINIMUM, NOT LESS THAN 6x (150mm).	901 SW OR 901 ML	851 SW, 901 ML, 902 ML, 903 ML, 904 ML, 905 ML
TYPE 3	Du/24 MINIMUM, NOT LESS THAN 3/4" (19mm) IF ROCK FOUNDATION, USE Du/12 MINIMUM, NOT LESS THAN 6x (150mm).	851 SW, 901 ML, 901 SW, 901 CL	851 SW, 901 ML, 902 ML, 903 ML, 904 ML, 905 ML
TYPE 4	NO BEDDING REQUIRED, EXCEPT IF ROCK FOUNDATION, USE Du/12 MIN. NOT LESS THAN 6x (150mm).	NO COMPACTION REQUIRED, EXCEPT IF CL, USE 851 CL.	851 SW, 901 ML, 902 ML, 903 ML, 904 ML, 905 ML


NOTES:
1. FOR TRENCH WALLS THAT ARE WITHIN 8" OF VERTICAL, THE COMPACTION OR FINENESS OF THE SOIL IN THE TRENCH WALLS AND LOW SIDE ZONE NEED NOT BE CONSIDERED.
2. FOR TRENCH WALLS WITH GREATER THAN 8" SLOPES THAT CONSIST OF EMBANKMENT, THE LOWER SIDE SHALL BE COMPACTION TO AT LEAST THE SAME COMPACTION AS SPECIFIED FOR THE SOIL IN THE BACKFILL ZONE.

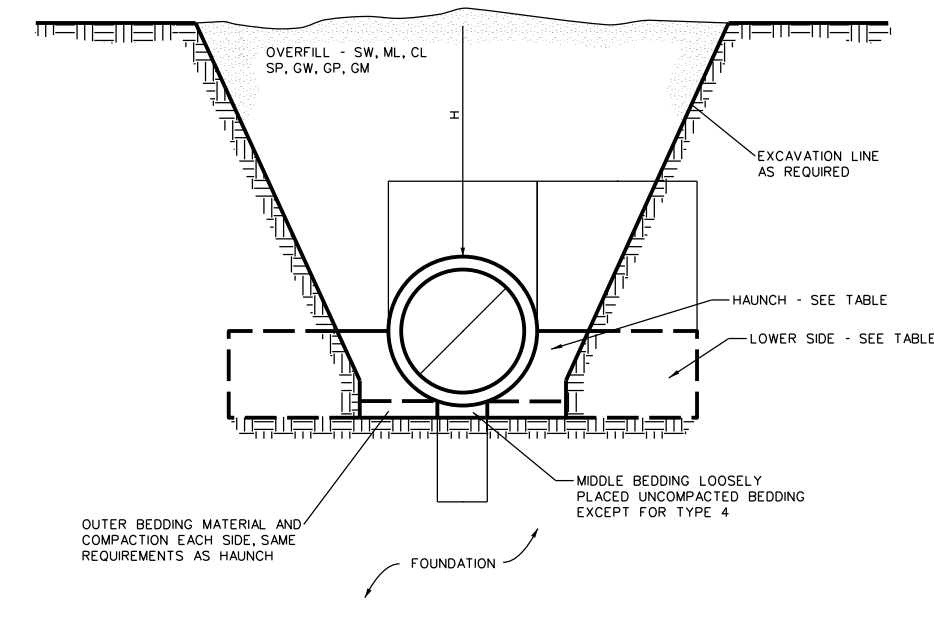


TYPICAL CONCRETE PIPE INSTALLATION
N. T. S.

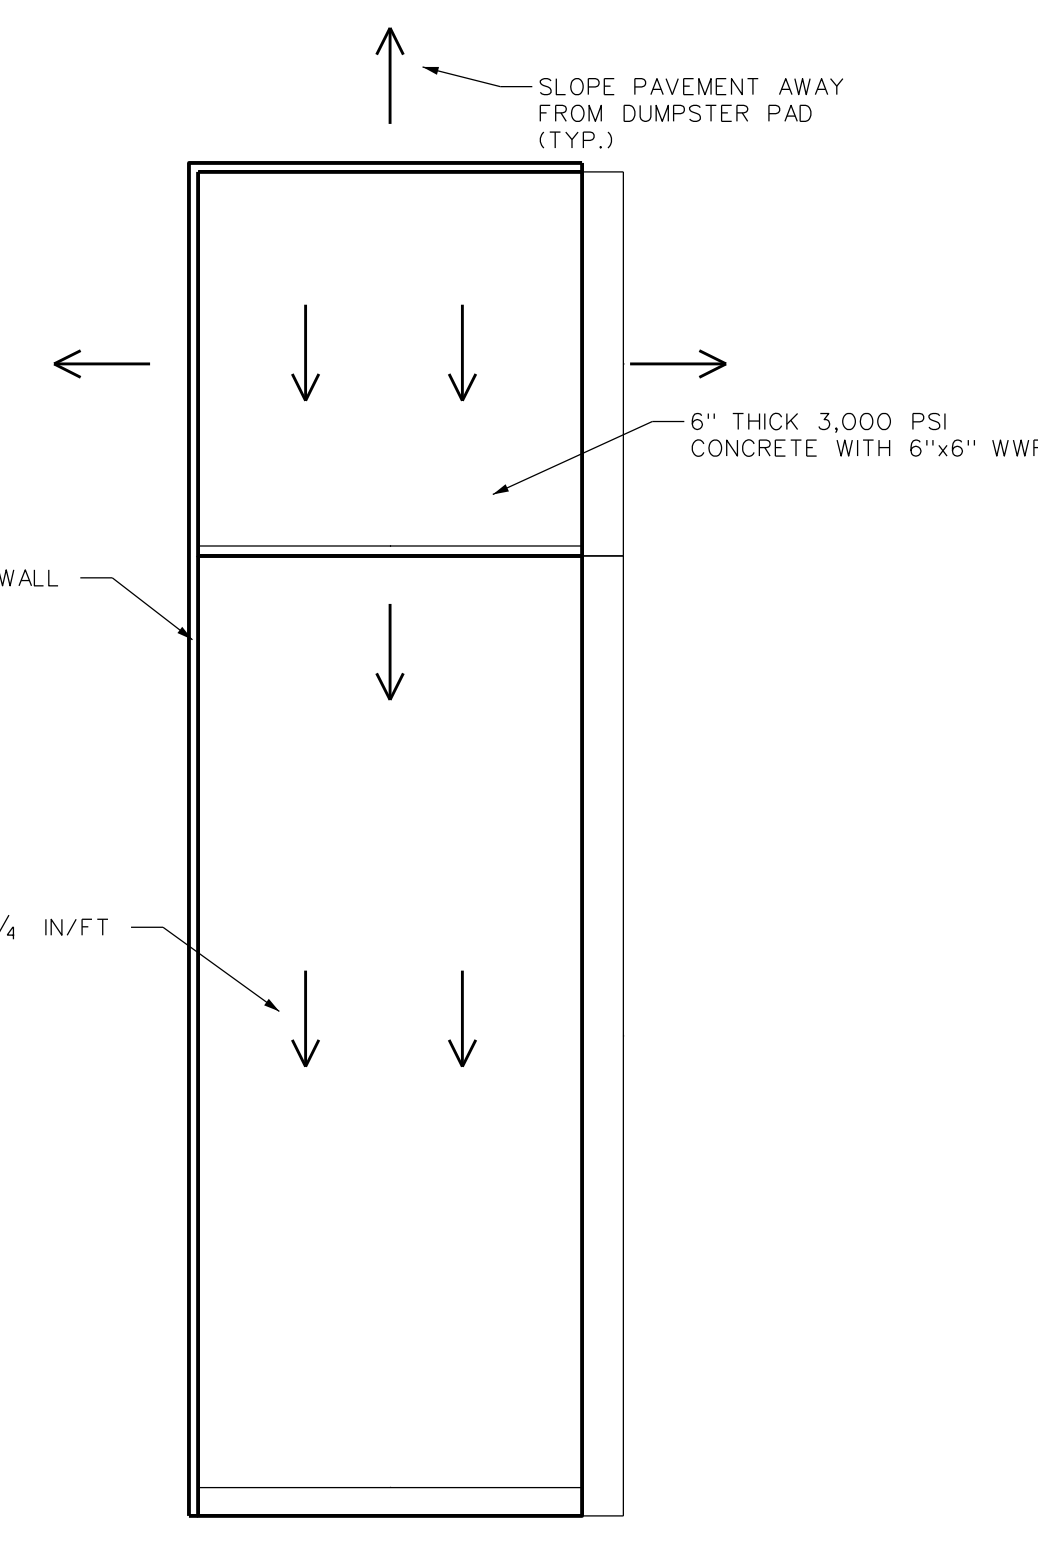

DUMPSTER PAD
N. T. S.

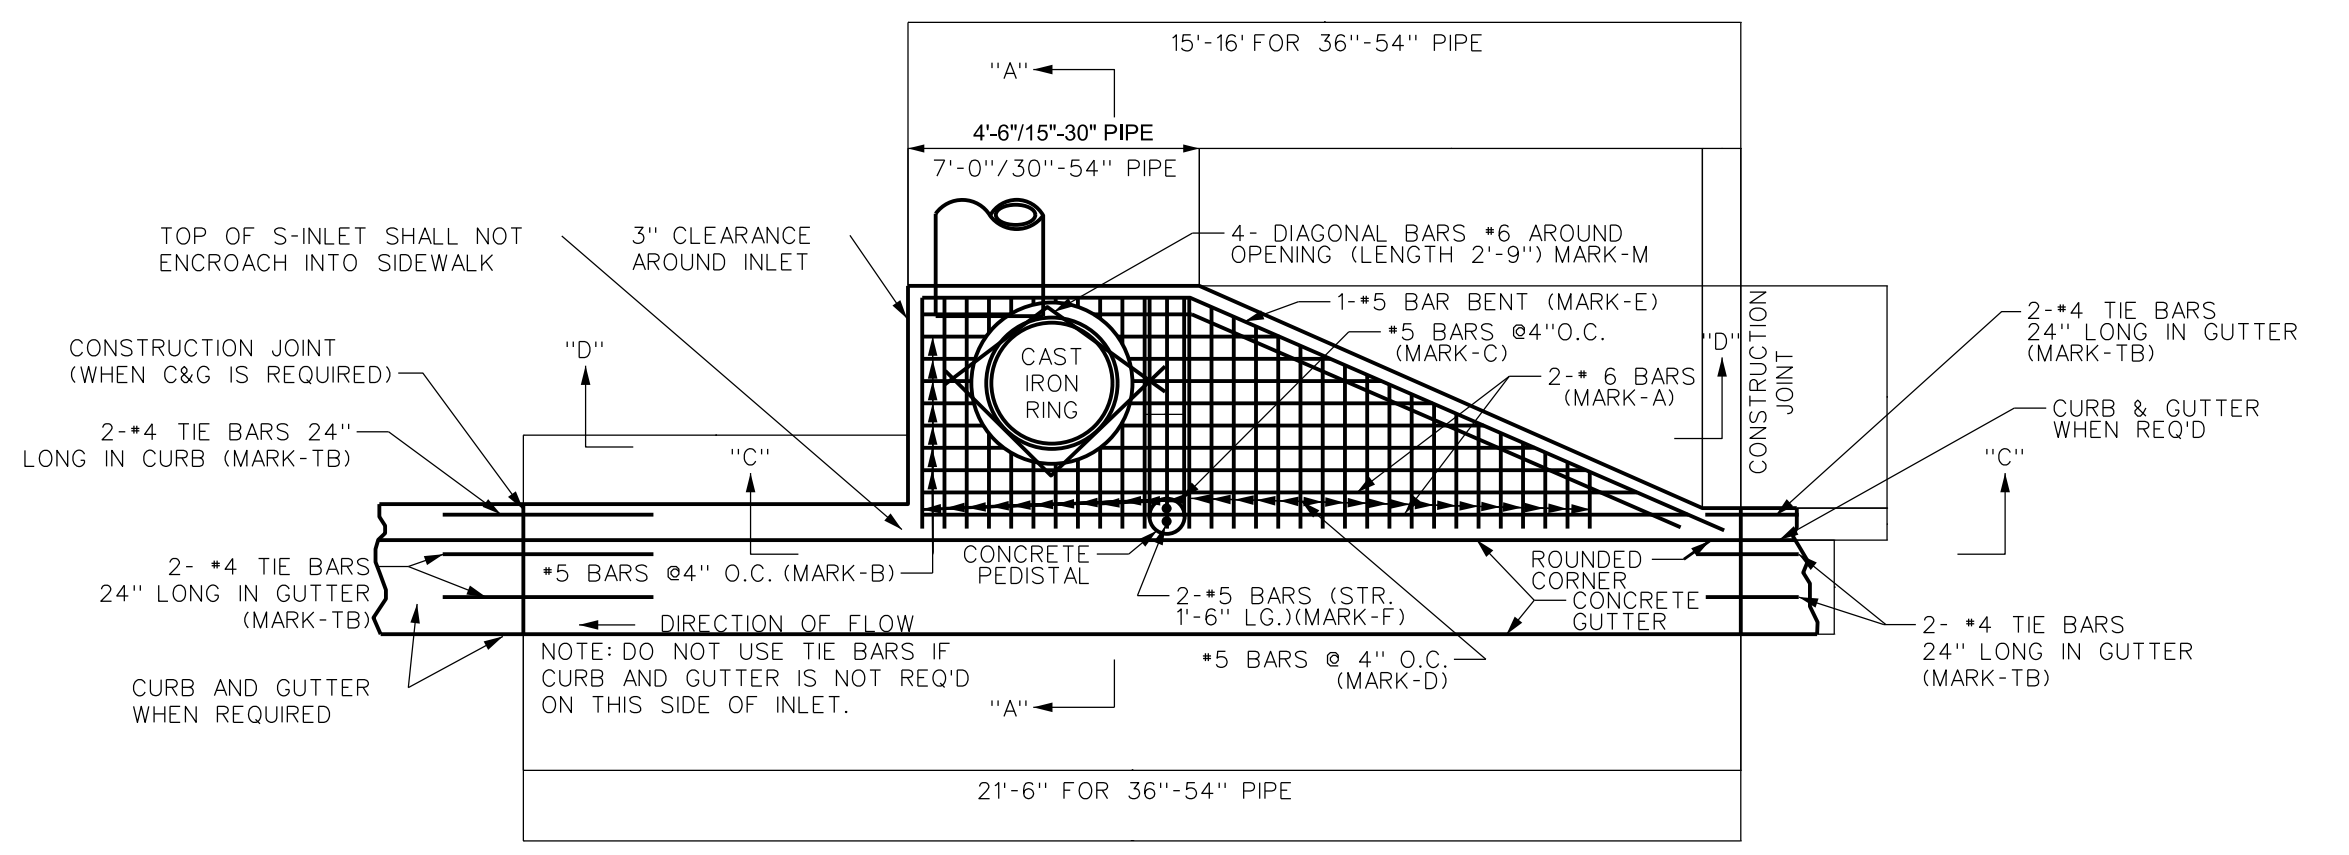


S-INLET PLAN VIEW
N. T. S.

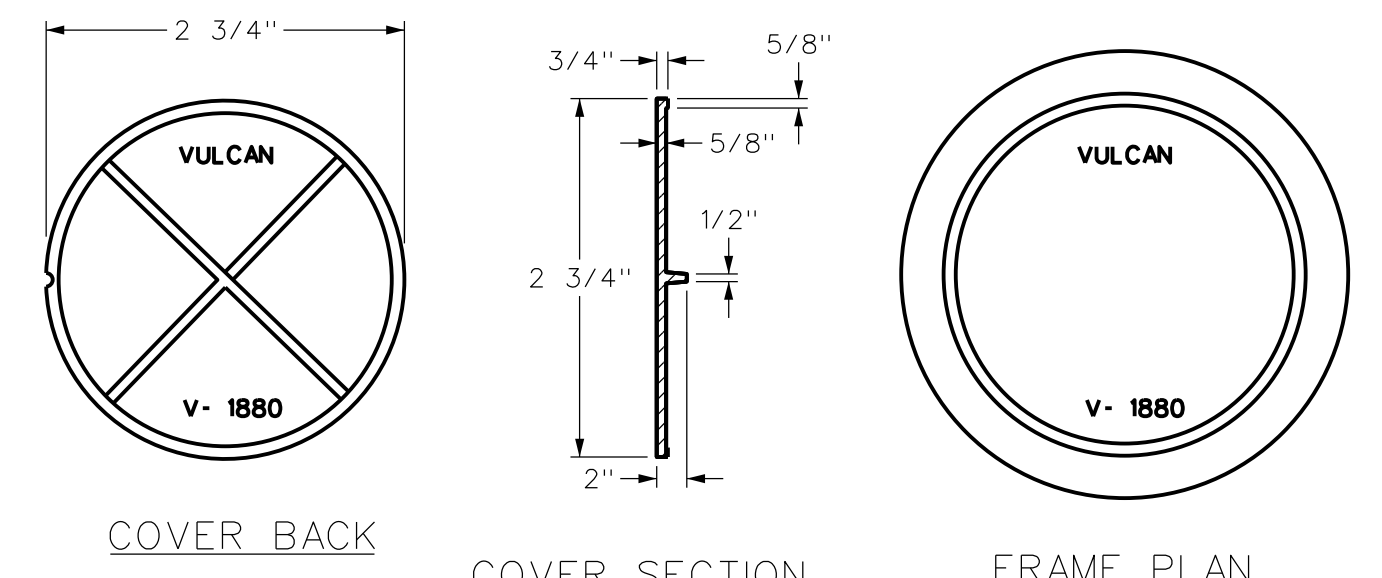


COVER BACK
COVER SECTION
FRAME PLAN

NOTE:
COVER CAN BE MARKED AS REQUIRED. SPECIFY NUMBER OF VENT HOLES WHEN REQUIRED.

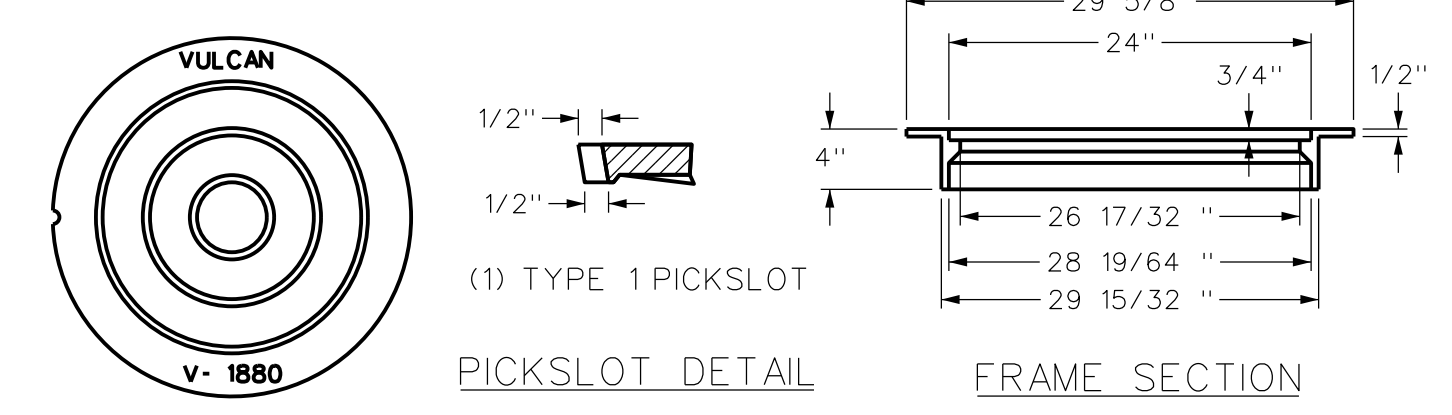

COVER FACE
PICKSLLOT DETAIL
FRAME SECTION

LIGHT DUTY (NON-TRAFFIC) MANHOLE FRAME & COVER
N. T. S.

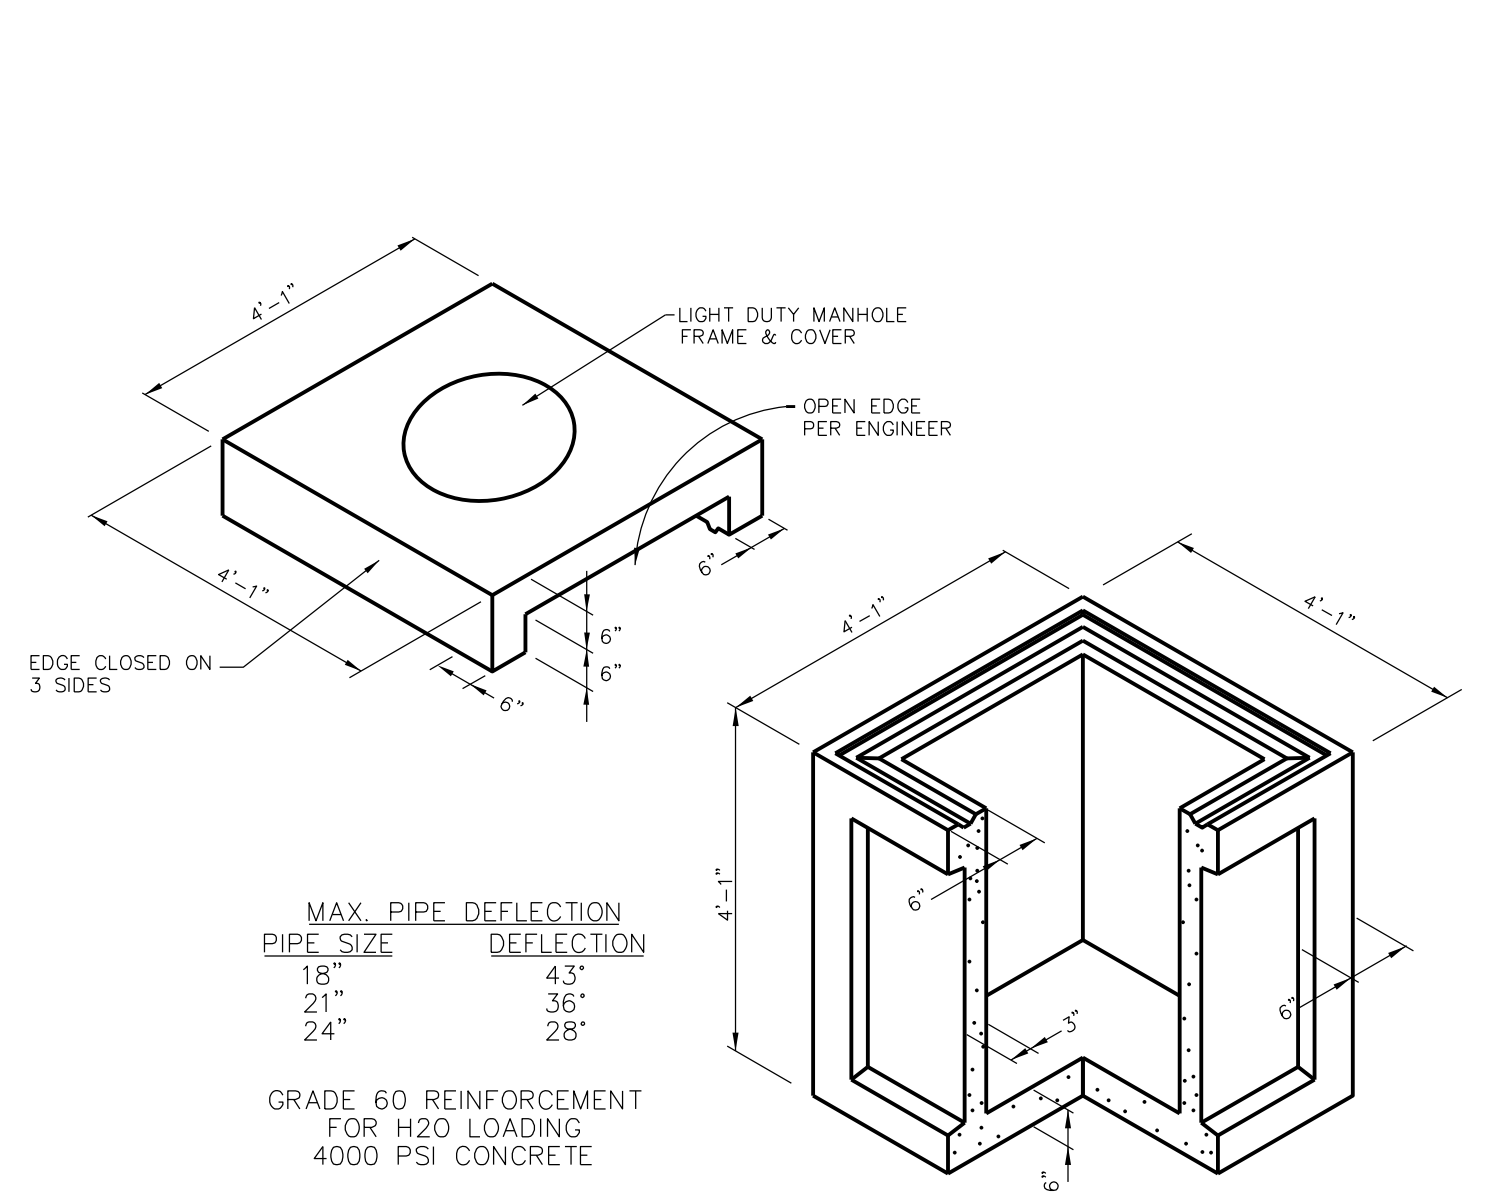

JUNCTION BOX WITH AREA INLET TOP
N. T. S.

MAX. PIPE DEFLECTION	PIPE SIZE	DEFLECTION
18"	18"	4.3"
21"	21"	3.6"
24"	24"	2.8"


GRADE 60 REINFORCEMENT FOR H2O LOADING
4000 PSI CONCRETE

UTILITY TRENCHING AND BACKFILL REQUIREMENTS:


1. ALL INSTALLATION SHALL BE IN ACCORDANCE WITH LOCAL REQUIREMENTS, SPECIFIC UTILITY COMPANY REQUIREMENTS, OSHA AND GOOD CONSTRUCTION PRACTICE.
2. CLEAN COURSE SAND, WELL GRADED GRAVEL OR WELL CRUSHED ROCK SHALL BE USED AS TRENCH BEDDING. THE TRENCH SHALL BE FILLED WITH THIS MATERIAL UP TO THE SPRING LINE OF THE PIPE. PLACED IN 6" MAXIMUM LIFTS AND COMPACTED TO 95% MAXIMUM DENSITY ASTM D-1557. THE REMAINDER OF THE TRENCH SHALL BE BACKFILLED WITH SPECIFIC BACKFILL MATERIAL. REFER TO SOILS REPORT.

GENERAL NOTES:


1. WHERE DIRECTION OF FLOW IS FROM EACH END OF INLET, SIDE WING OPENINGS (AS SHOWN ON THIS SIDE ONLY ON THIS DRAWING) SHALL BE CONSTRUCTED AT EACH END OF INLET, FOR EACH INLET SO CONSTRUCTED. PAYMENT WILL BE MADE UNDER ITEM INLETS TYPE-S (TWO WINGS). WHERE ONE WING ONLY IS CONSTRUCTED PAYMENT WILL BE MADE UNDER ITEM INLETS TYPE-S (ONE WING).
2. 2" MINIMUM WEEP HOLES SHALL BE CONSTRUCTED IN INLETS AS DIRECTED BY THE ENGINEER TO FACILITATE SUBGRADE DRAINAGE.
3. TO ACCOMMODATE SKEWED PIPE OR FIT OTHER CONDITIONS, IT MAY BE NECESSARY TO INCREASE ONE OR BOTH PLAN VIEW DIMENSIONS OF INLET BOX AND COVER SLAB. NO ADDITIONAL COMPENSATION WILL BE ALLOWED FOR CORRESPONDING INCREASE IN MATERIALS AND OTHER COSTS WHERE CHANGES IN DIMENSION ARE REQUIRED.
4. INLET WITH BOX SIZED FOR 15"-30" PIPE SHALL BE DESIGNATED AS TYPE S3. FOR 36"-54" PIPE AS TYPE S4.

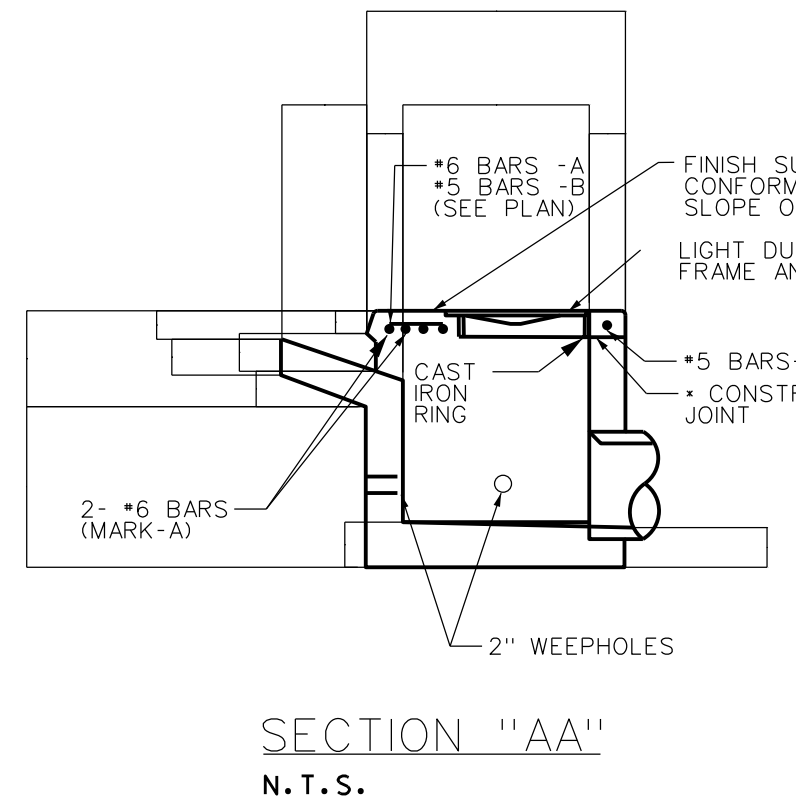

SECTION "AA"
N. T. S.

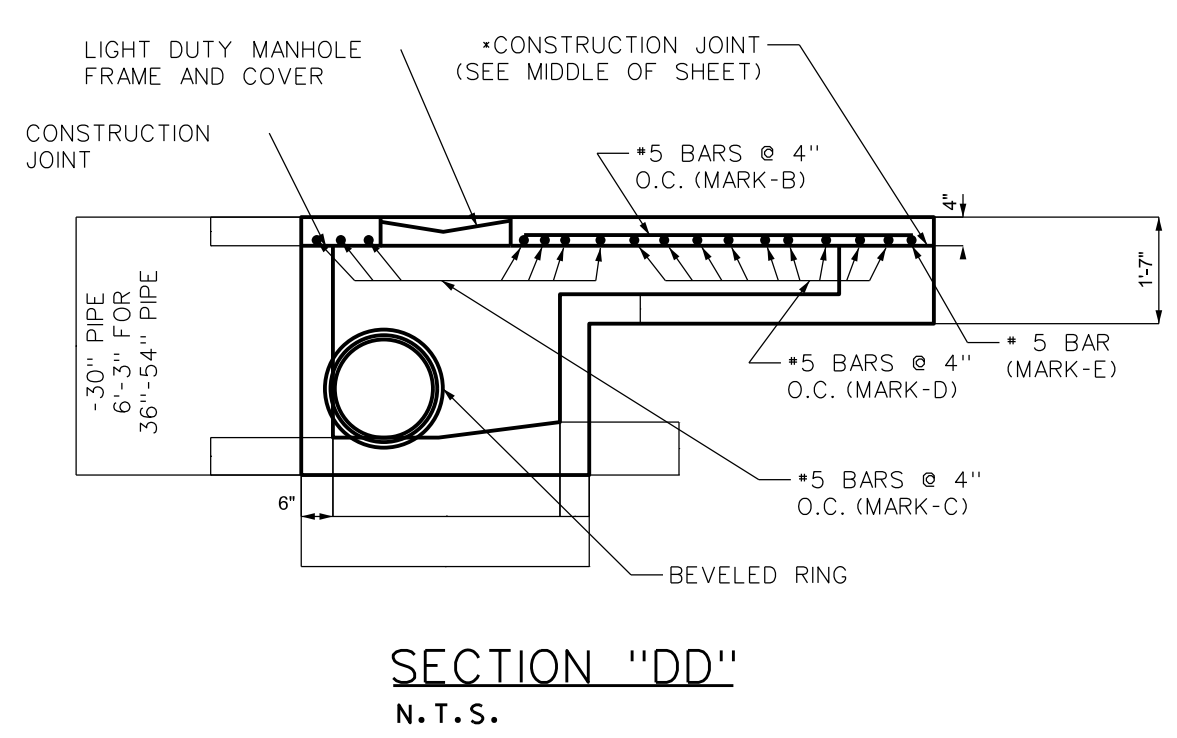


SECTION "DD"
N. T. S.

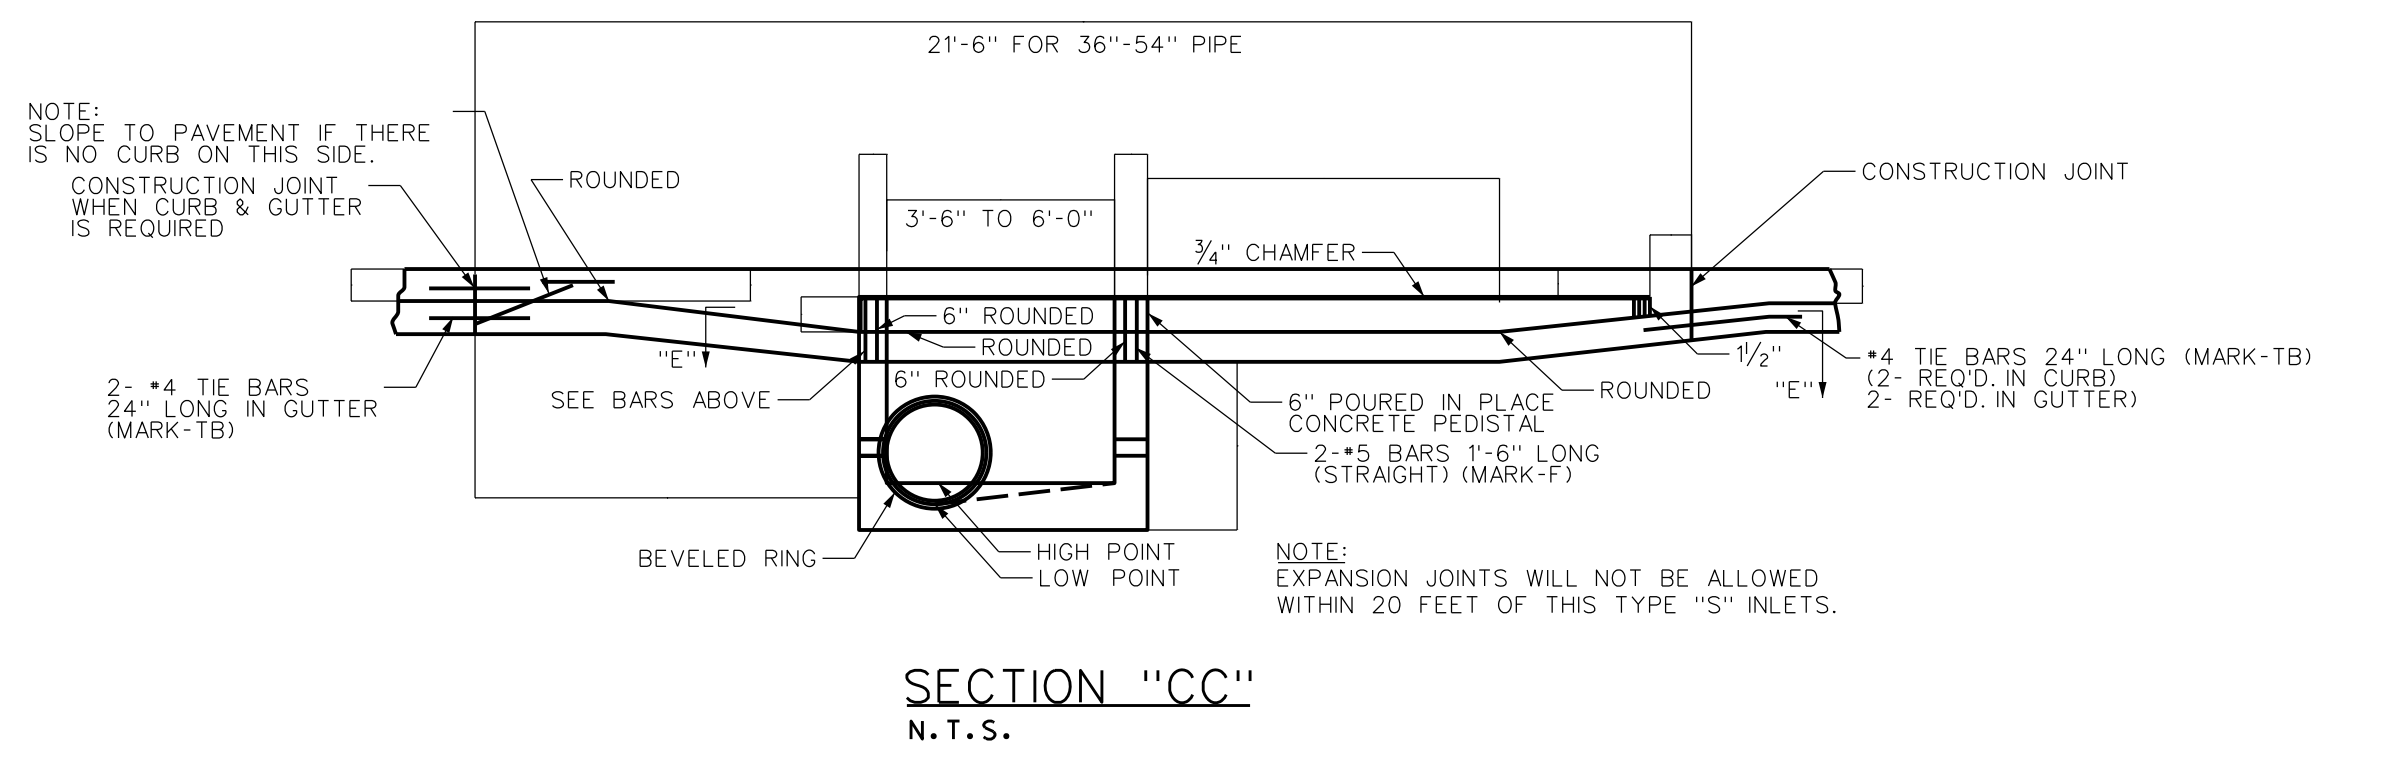


SECTION "CC"
N. T. S.

PIPE CONNECTIONS:
PIPE MAY CONNECT WITH INLETS FROM ANY DIRECTION AND AS MANY CONNECTIONS MAY BE MADE AS NECESSARY.

NOTE TO CONTRACTOR:
CONCRETE PEDESTAL SHALL BE POURED IN PLACE. ROUND FORM MAY BE CONSTRUCTED OF METAL, PLASTIC OR OTHER APPROVED SUITABLE MATERIAL. A 6" DIAMETER PIPE SHALL BE FILLED WITH CONCRETE WILL NOT BE APPROVED.

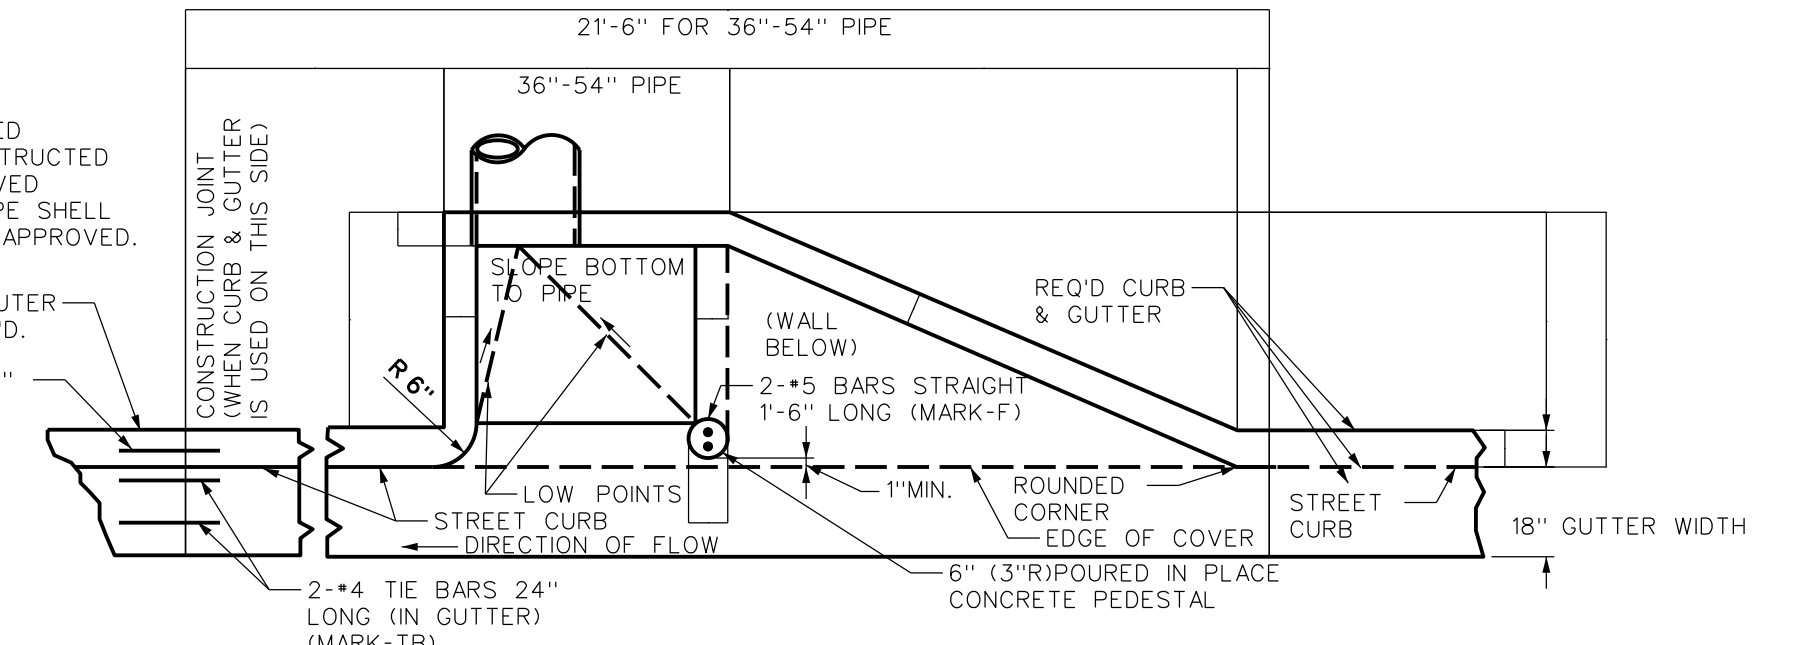

SECTION "EE"
N. T. S.

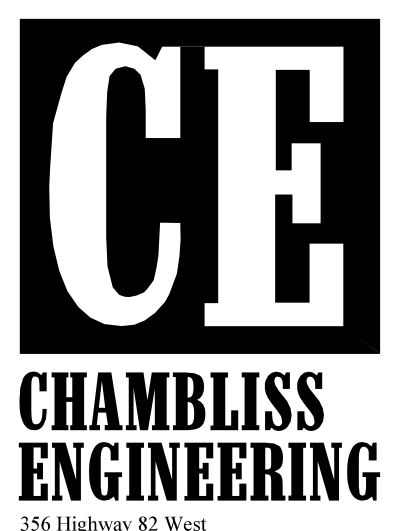

AS-BUILT


THE SHOPS AT
The Exchange at HomePlace
Prattville, Alabama

DATE	8/27/2019
PROJECT NO.	019-19-116
DESIGNED	CLC
DRAWN	CCJ
APPROVED	CLC
SCALE	NONE
SHEET TITLE	

STORM SEWER DETAILS


SHEET NO.

06

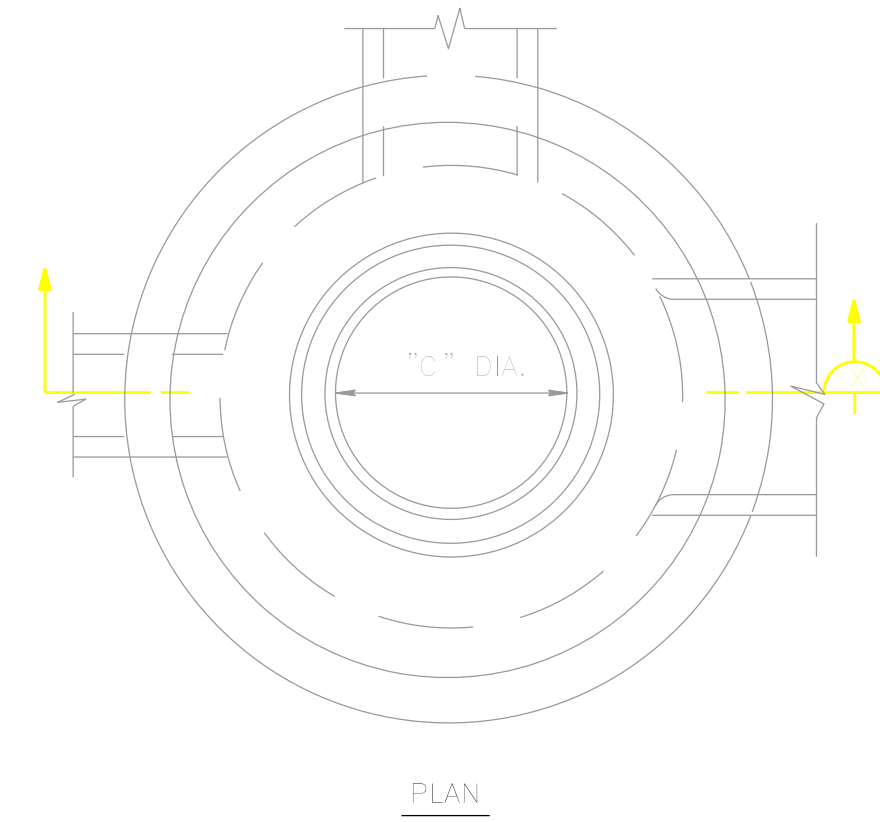


PLAN


TYPICAL PRECAST CONCENTRIC MANHOLE DETAIL
N.T.S.

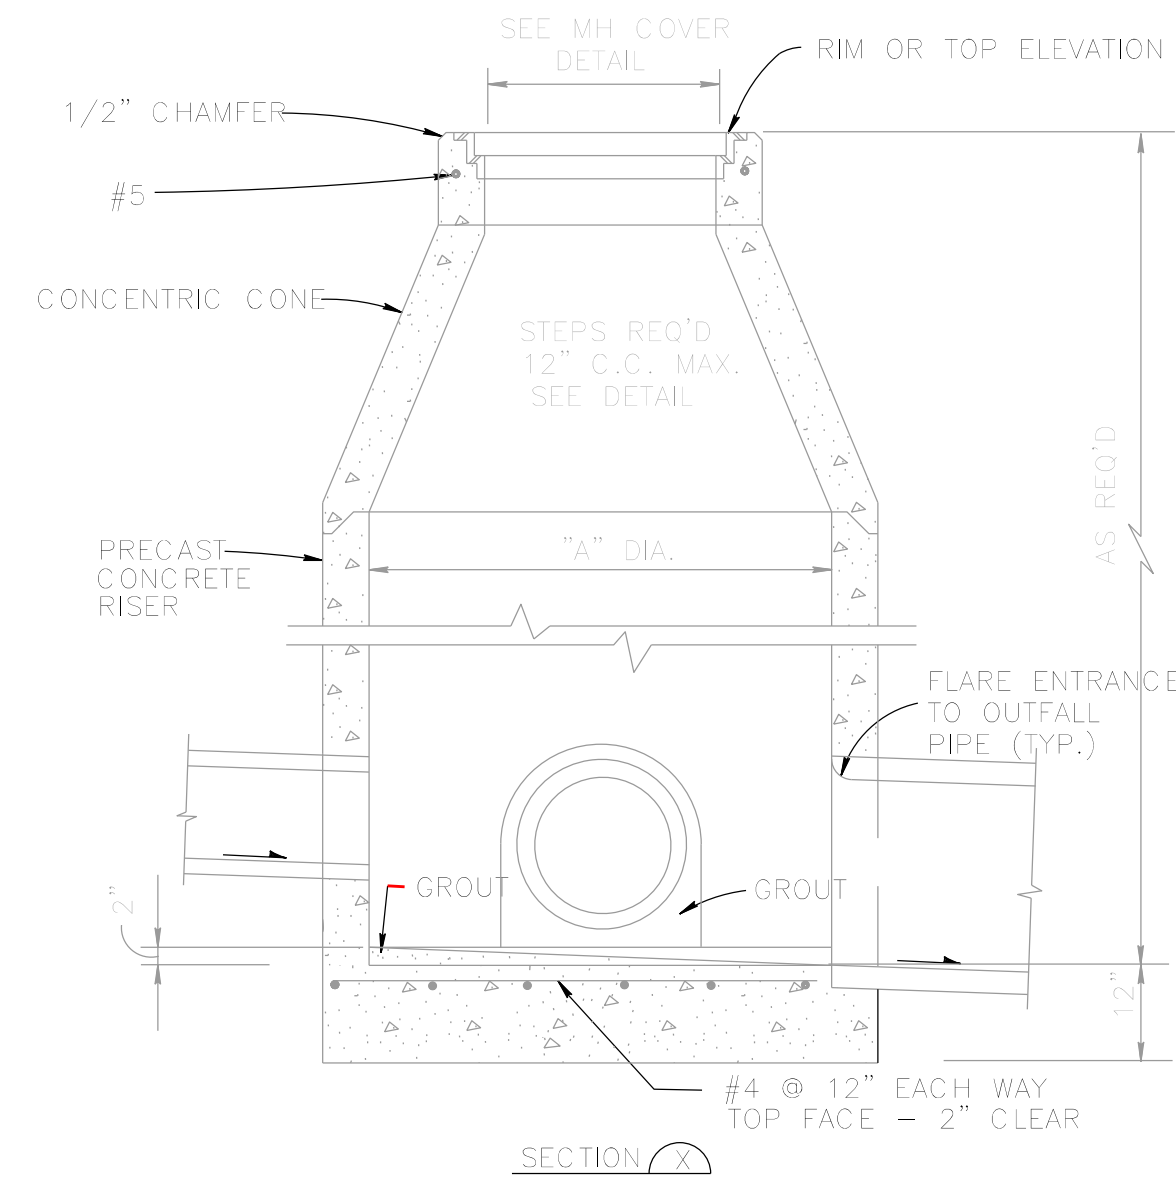


SECTION X

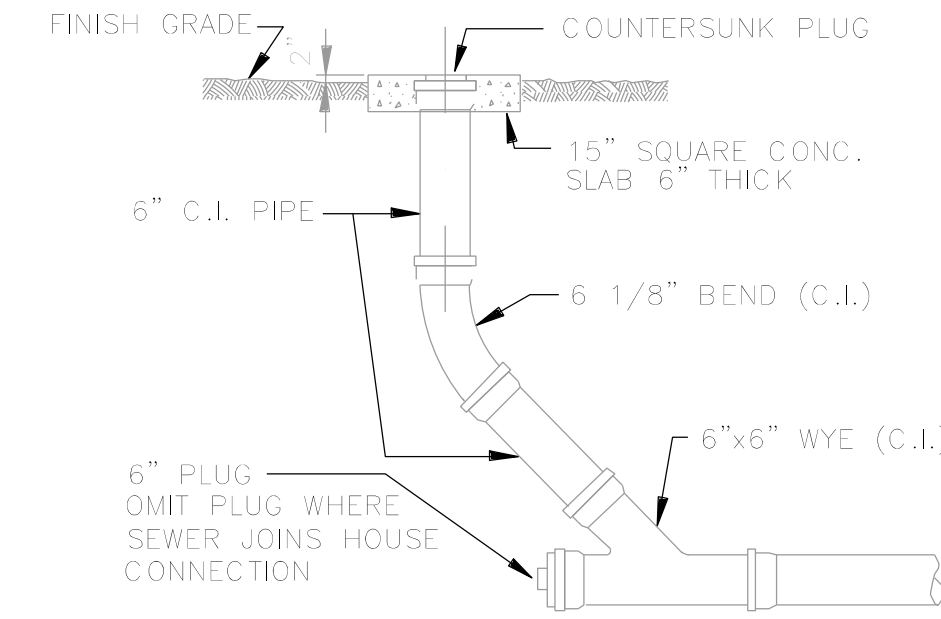


CLEANOUT TO GRADE
N.T.S.

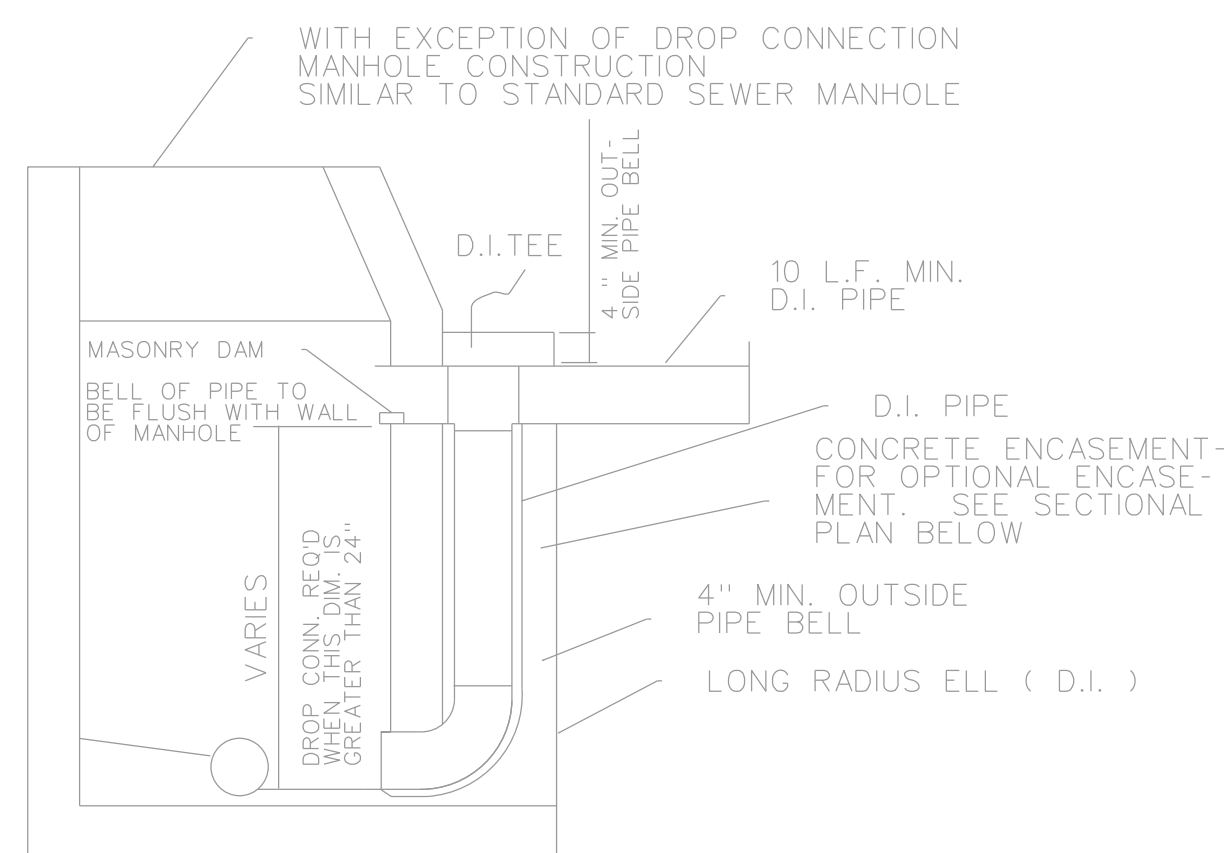

DETAIL OF DROP CONNECTION AT MANHOLE
N.T.S.

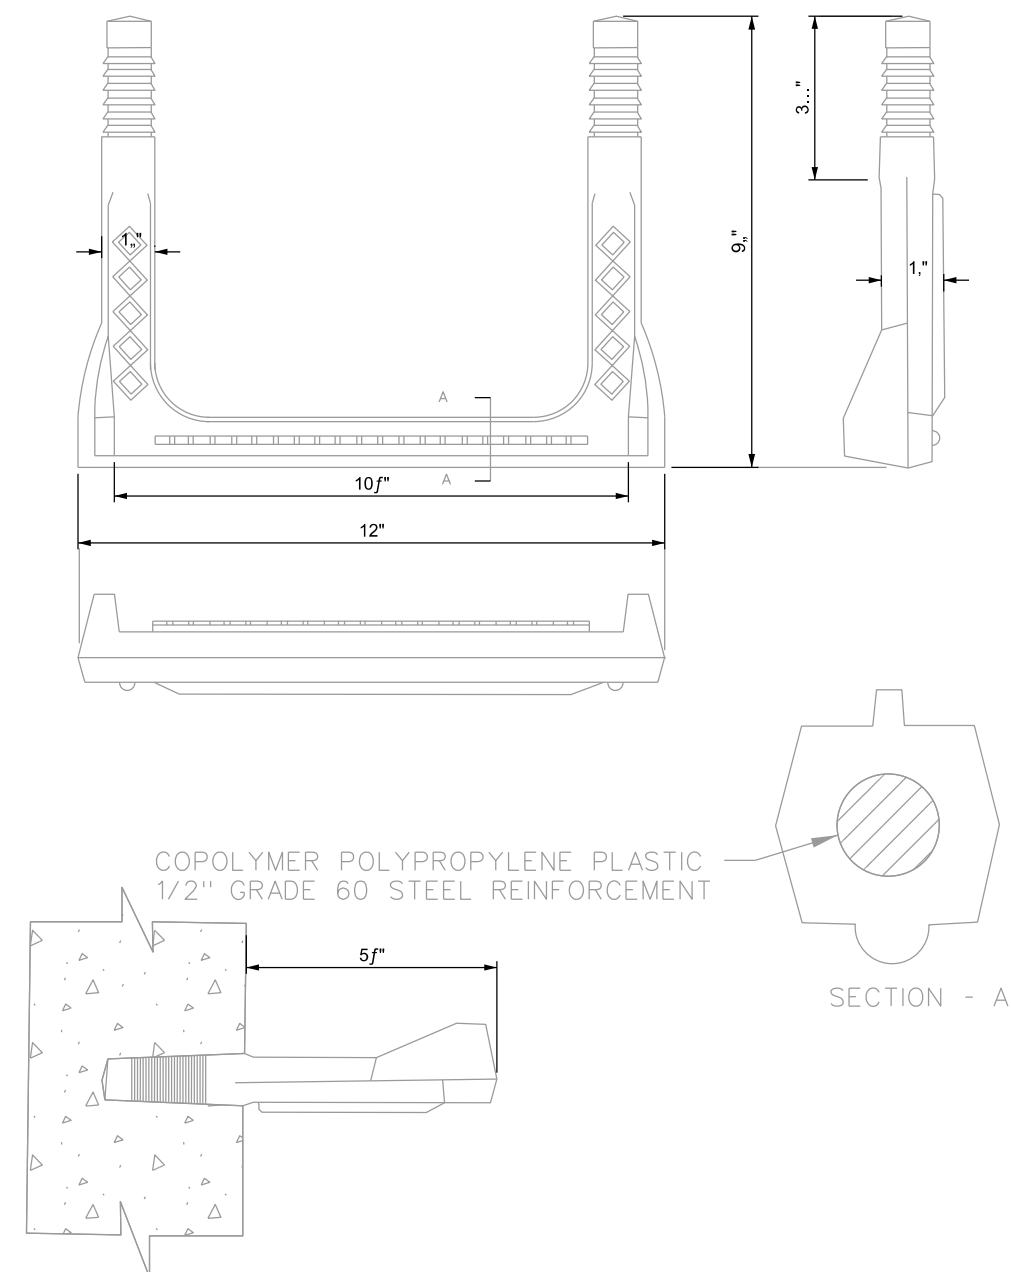

TYPICAL MANHOLE STEP
N.T.S.

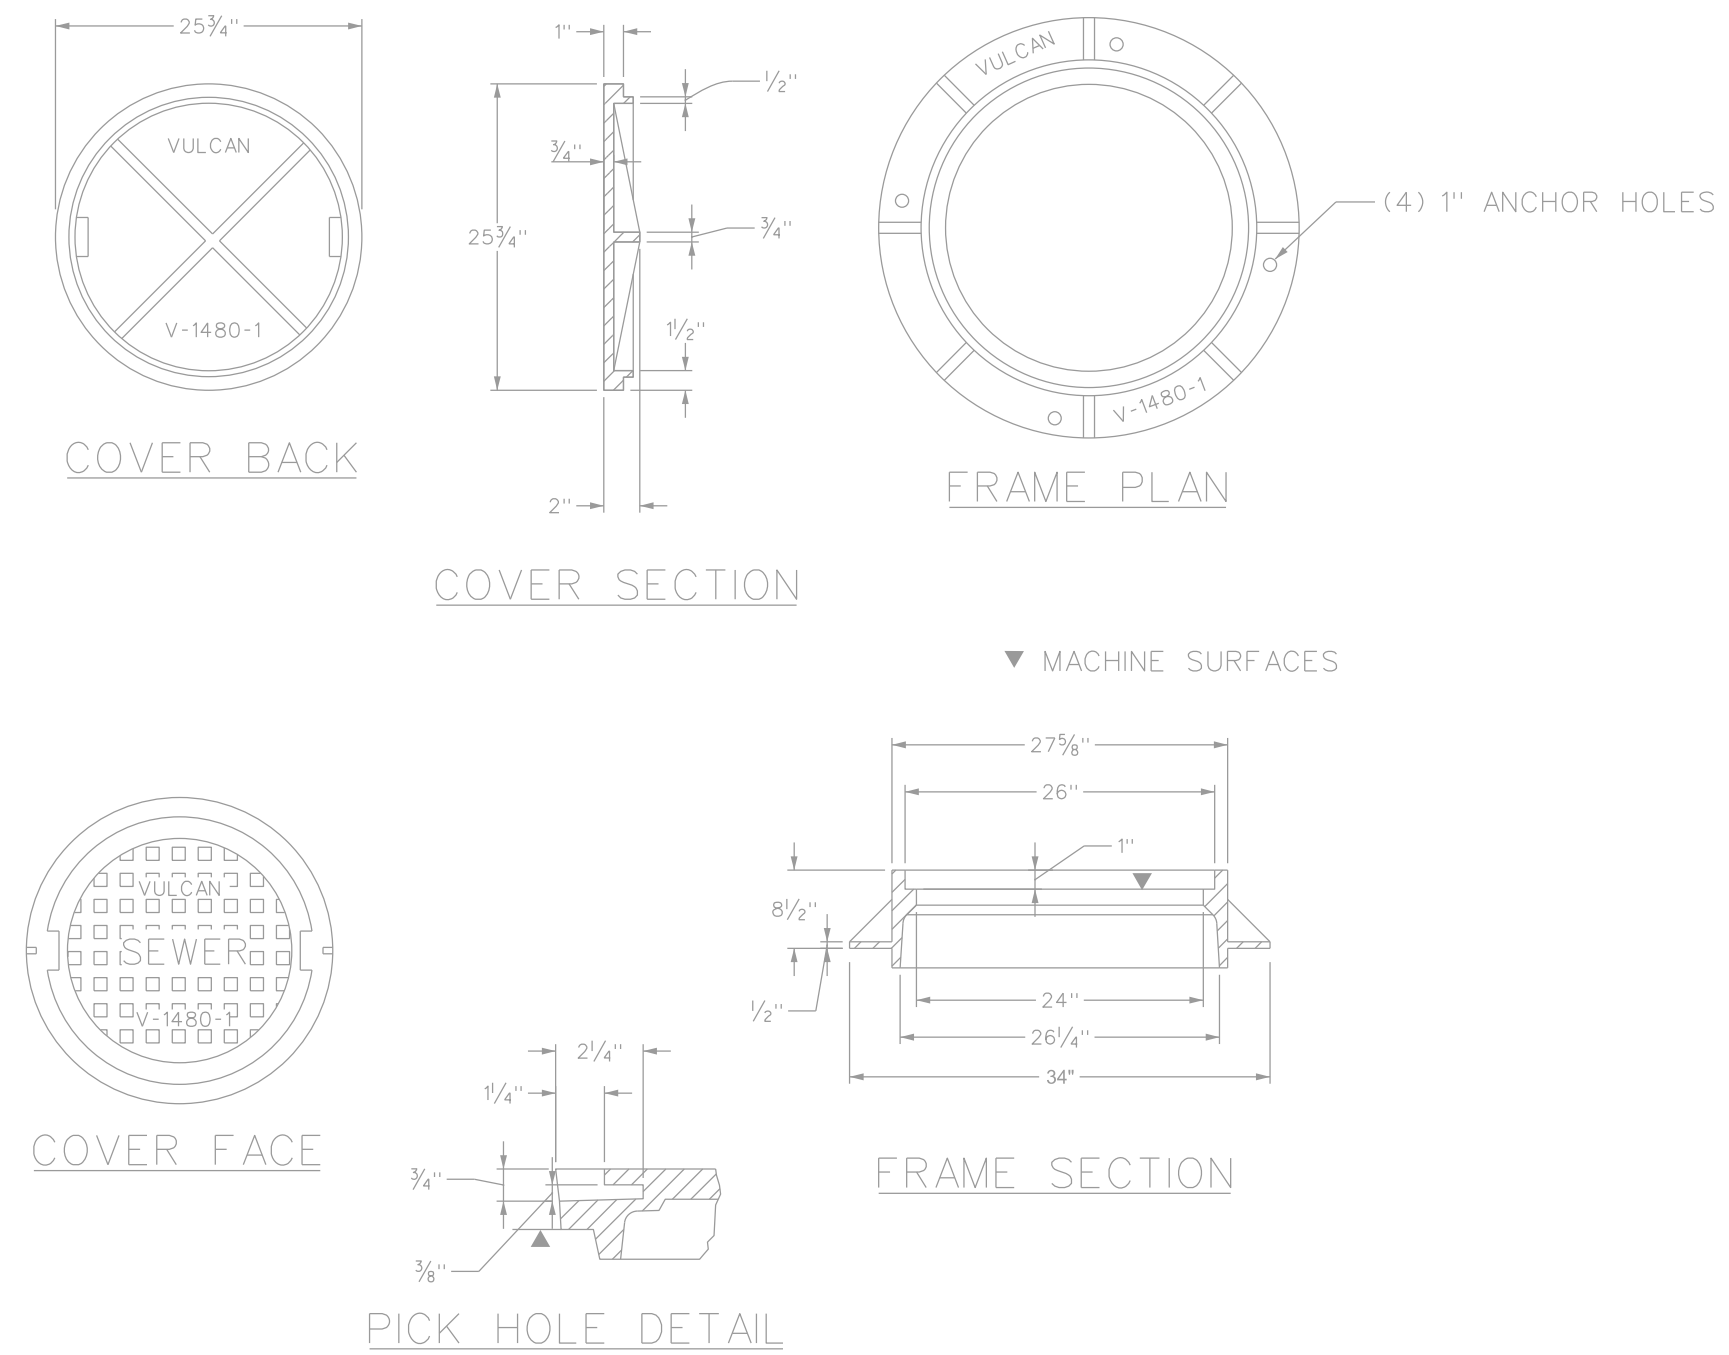

HEAVY DUTY MANHOLE FRAME & COVER
N.T.S.

NOTES: BACKFILL SANITARY SEWER MAINS AND LATERALS WITH SAND TO 1' ABOVE THE PIPES. PROVIDE AND INSTALL A RAINSTOPPER (OR APPROVED EQUAL) HDPE INFLOW COVER FOR ALL SANITARY SEWER MANHOLES.

DATE	8/27/2019
------	-----------

PROJECT NO.	019-19-116
-------------	------------

DESIGNED	CLC
----------	-----

DRAWN	CCJ
-------	-----


APPROVED	CLC
----------	-----

SCALE	NONE
-------	------


SHEET TITLE	
-------------	--

SANITARY SEWER
DETAILS


SHEET NO.	
-----------	--

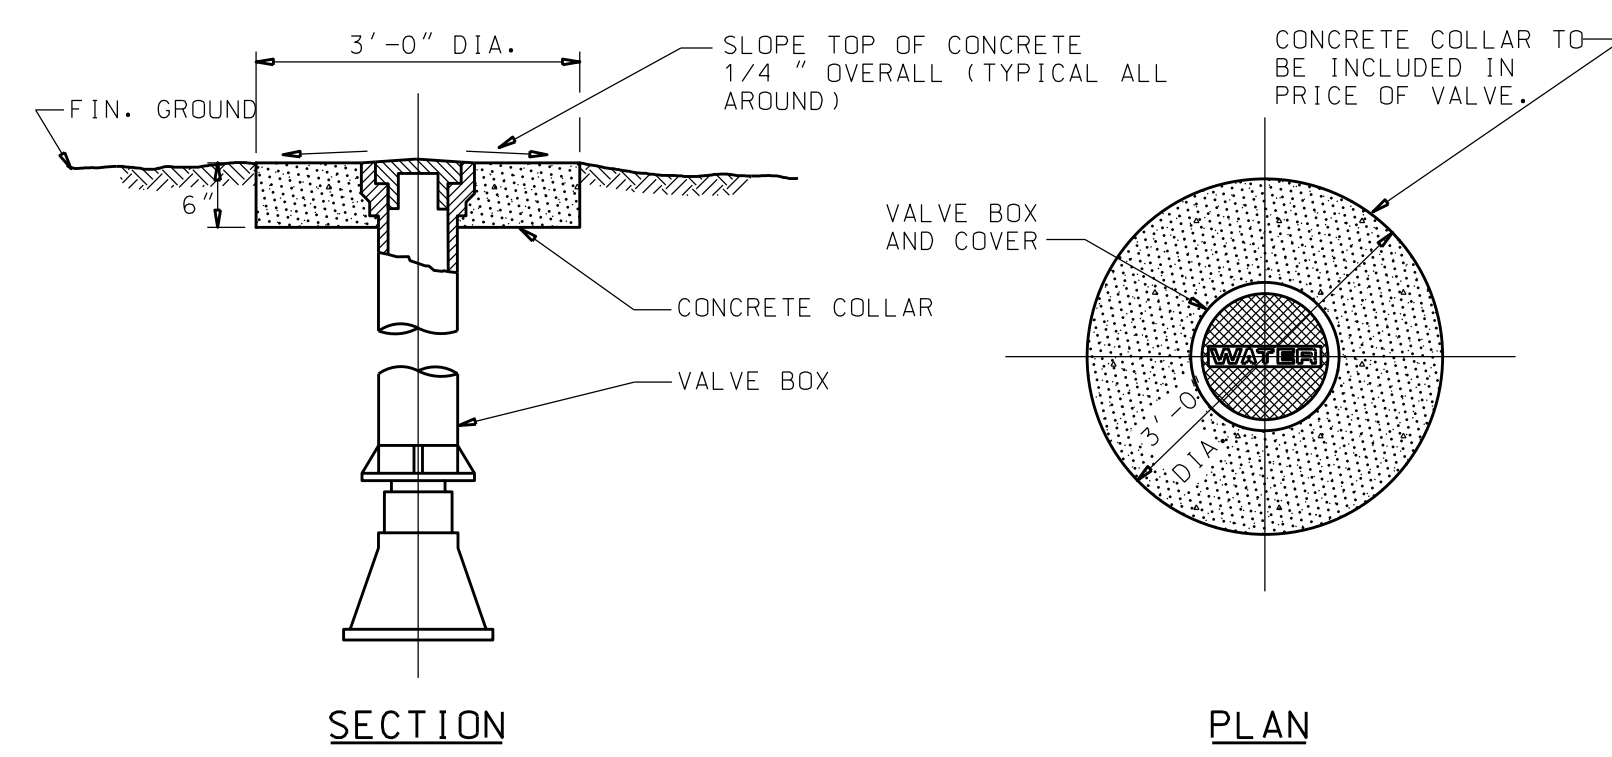


VALVE BOX COLLAR DETAIL
N.T.S.

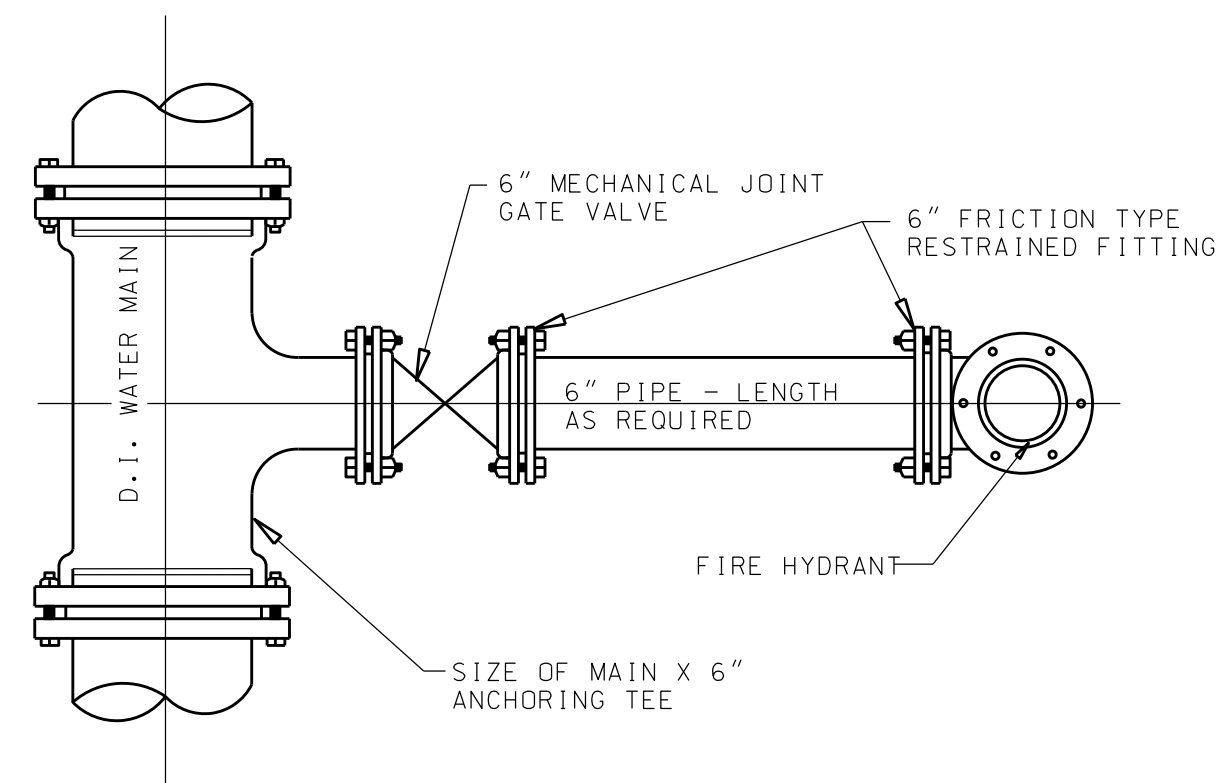


FIRE HYDRANT CONNECTION TO WATER MAIN (TYPICAL)
N.T.S.

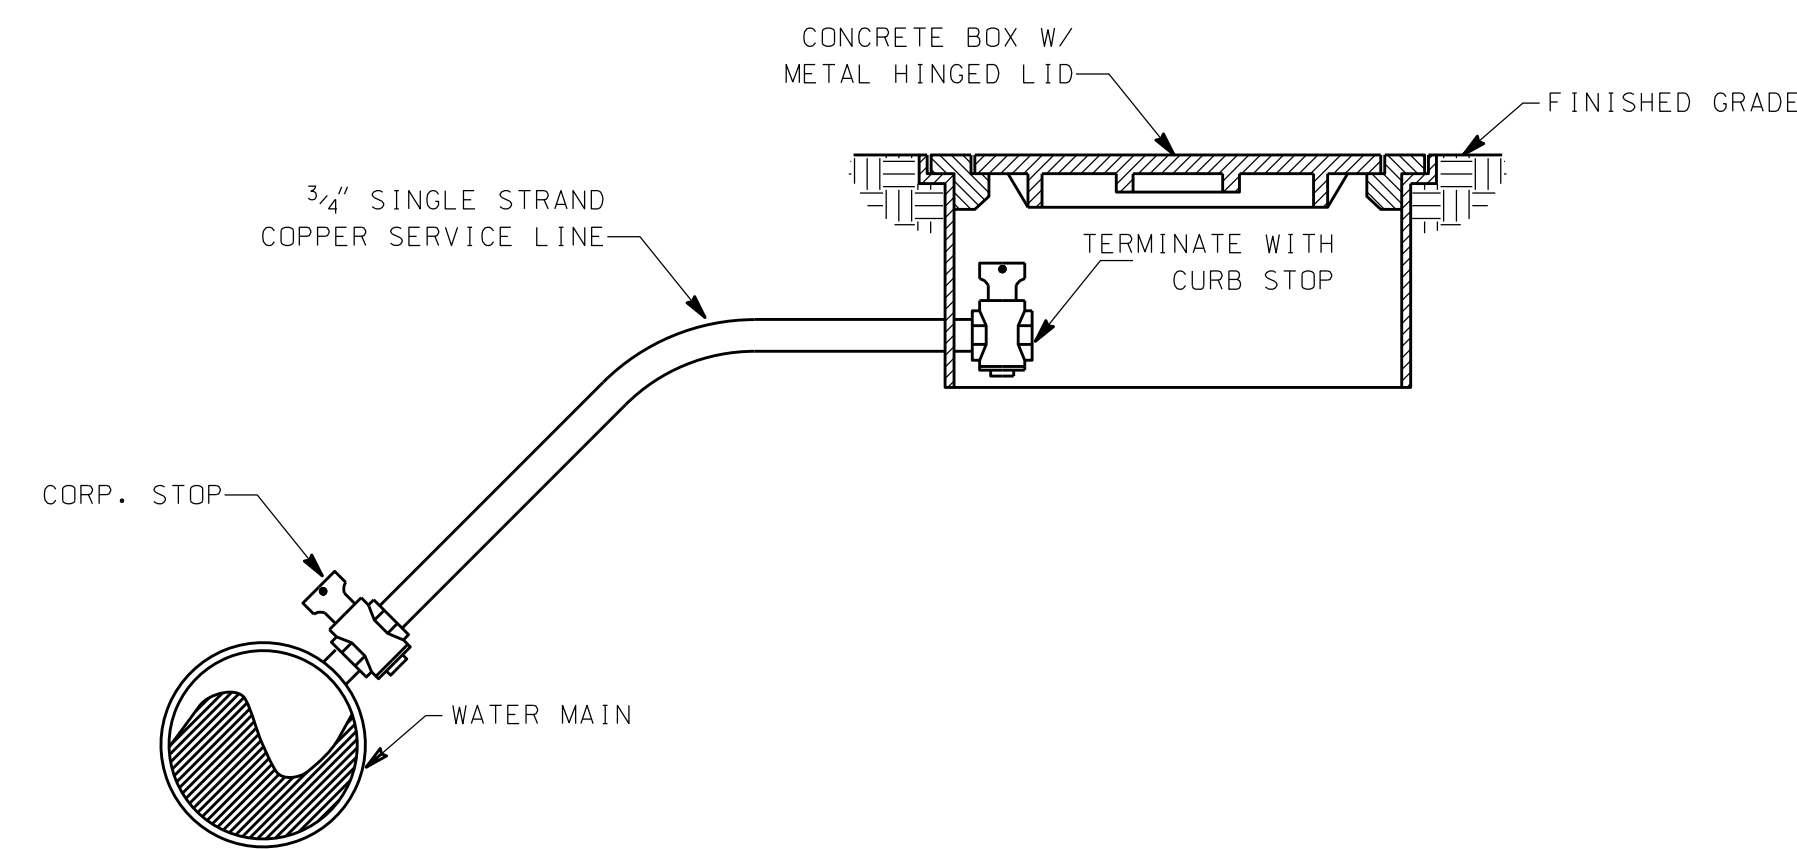

TYPICAL 3/4" WATER SERVICE
N.T.S.

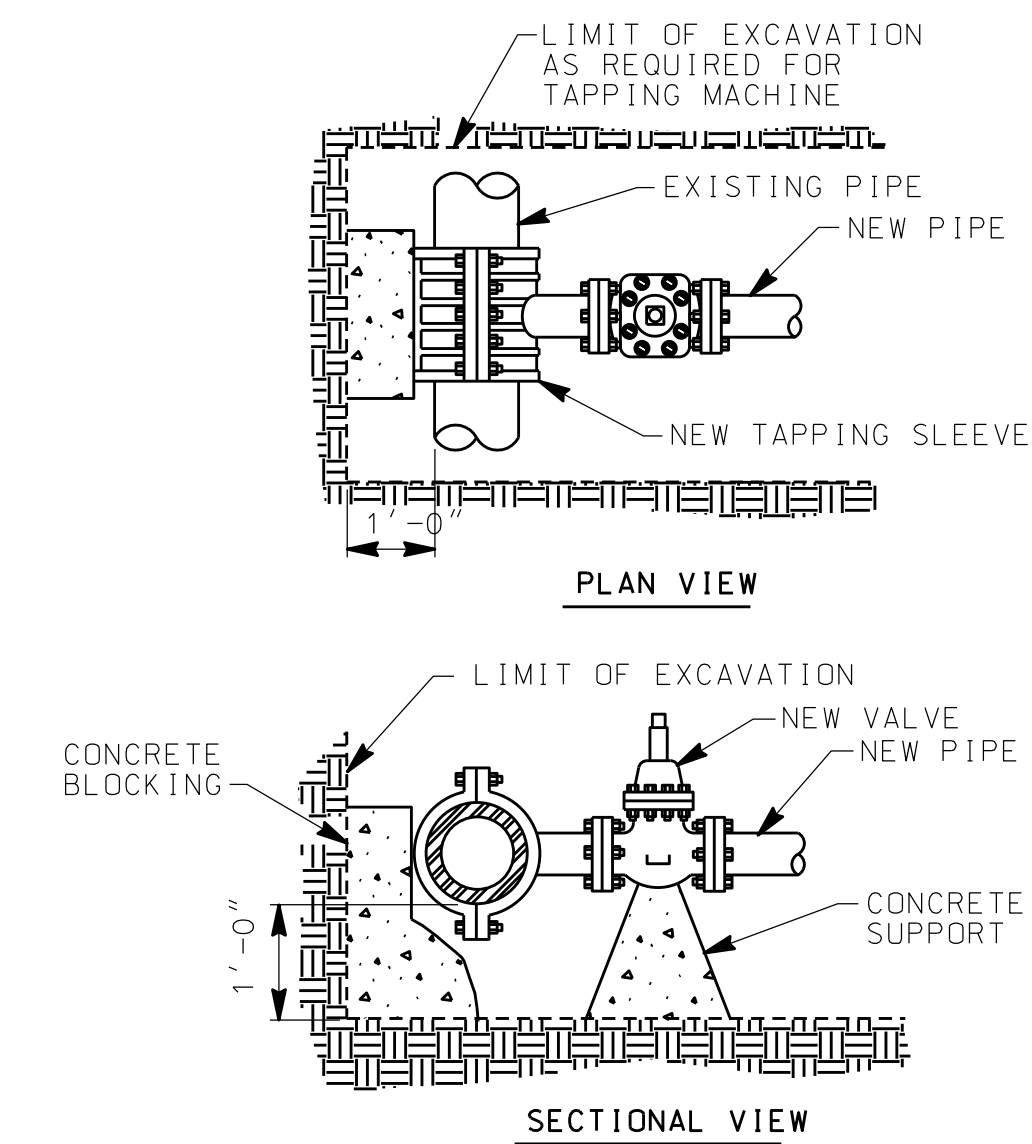


TAPPING SLEEVE AND VALVE INSTALLATION DETAIL
N.T.S.

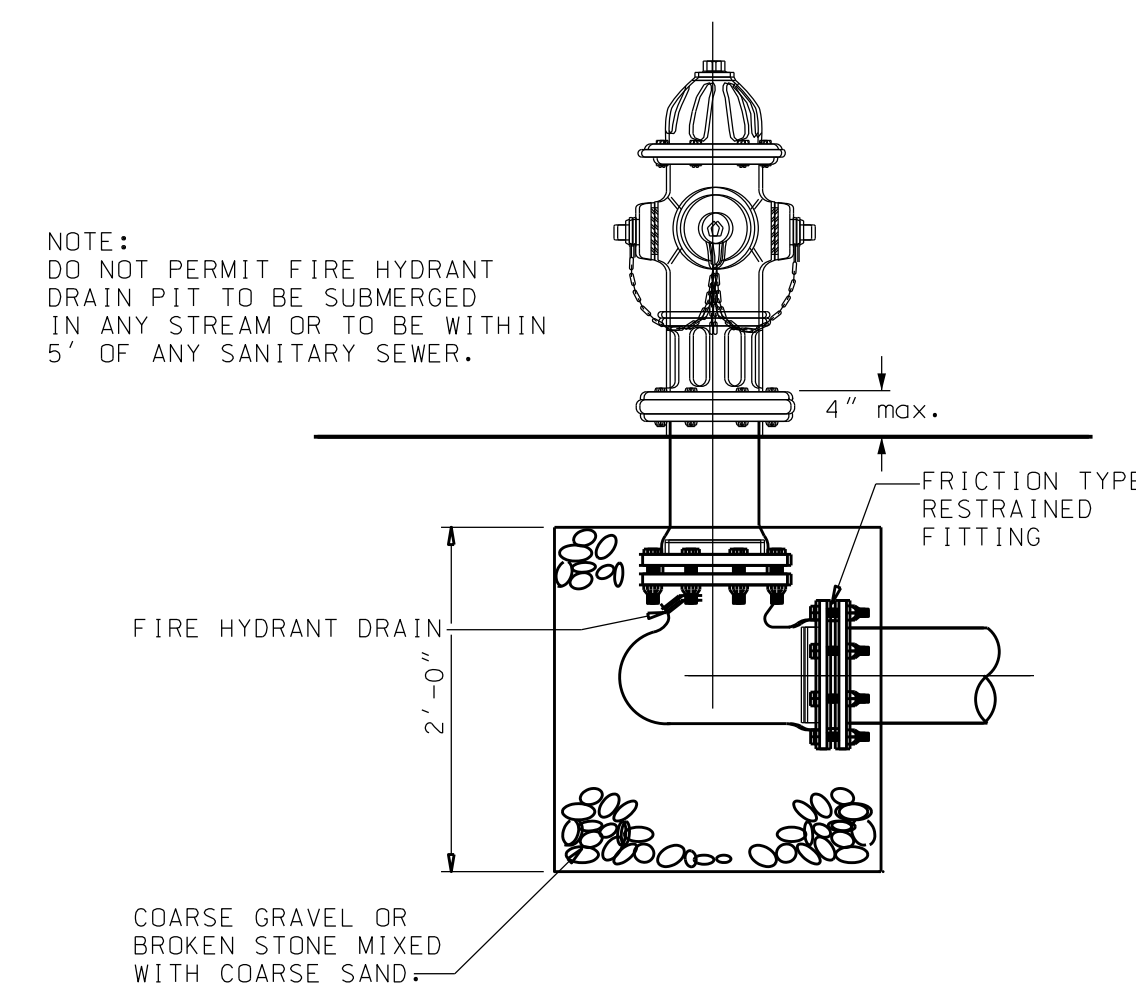


TYPICAL FIRE HYDRANT DRAIN PIT
N.T.S.


TYPICAL THRUST BLOCKS			
MINIMUM THRUST BLOCK AREA SQ. FT. L (FT.) X H (FT.)			
INSIDE DIA. PIPE LINE IN INCHES	90° BENDS	TEES, DEAD ENDS, OR 45° BENDS	22 1/2° BENDS
6"	3.0	2.2	1.0
8"	5.5	4.0	1.5
10"	8.5	6.0	2.5
12"	12.0	9.0	3.5
16"	22.0	16.0	6.0
18"	27.0	20.0	8.0
20"	34.0	24.0	10.0
24"	48.0	34.0	14.0
30"	75.0	53.0	21.0

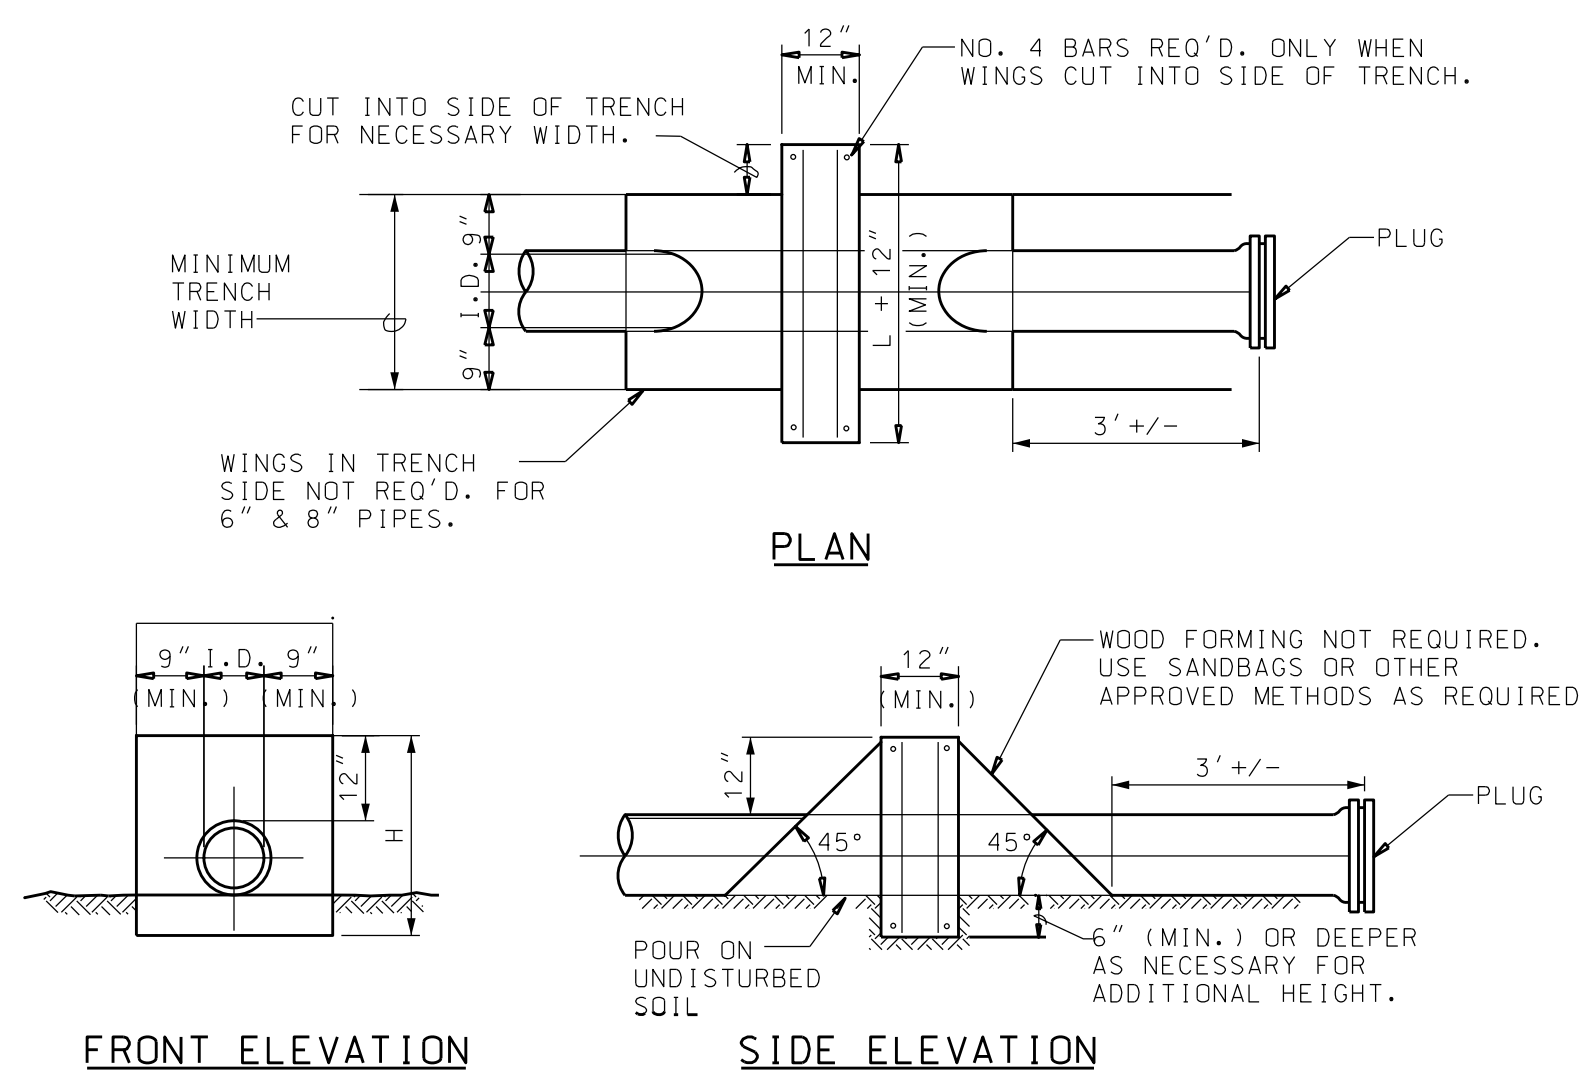

CONCRETE CROSS ANCHOR BLOCK DETAILS
N.T.S.

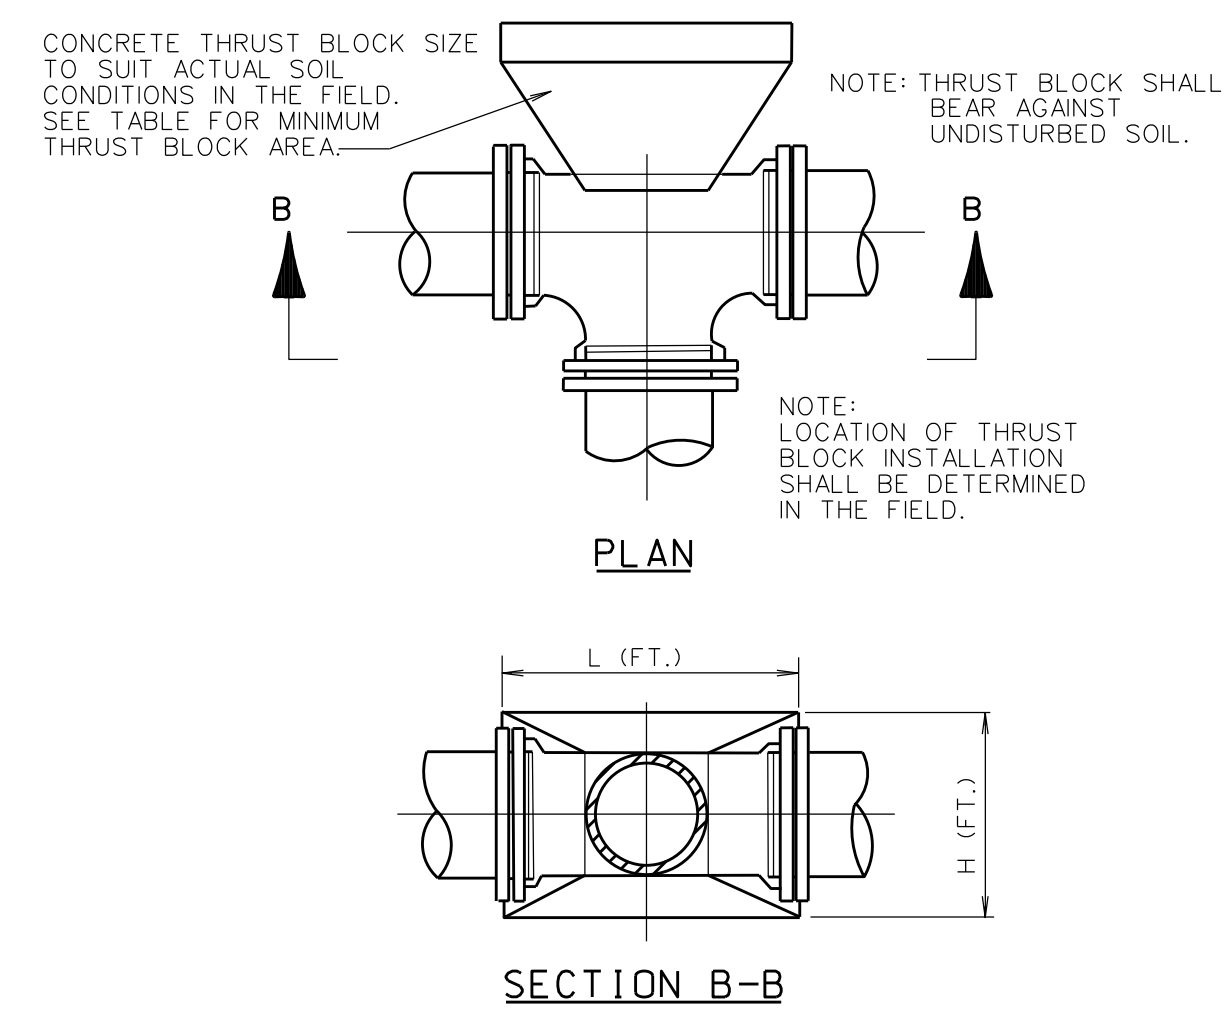

TYPICAL THRUST BLOCK DETAIL FOR TEES
N.T.S.

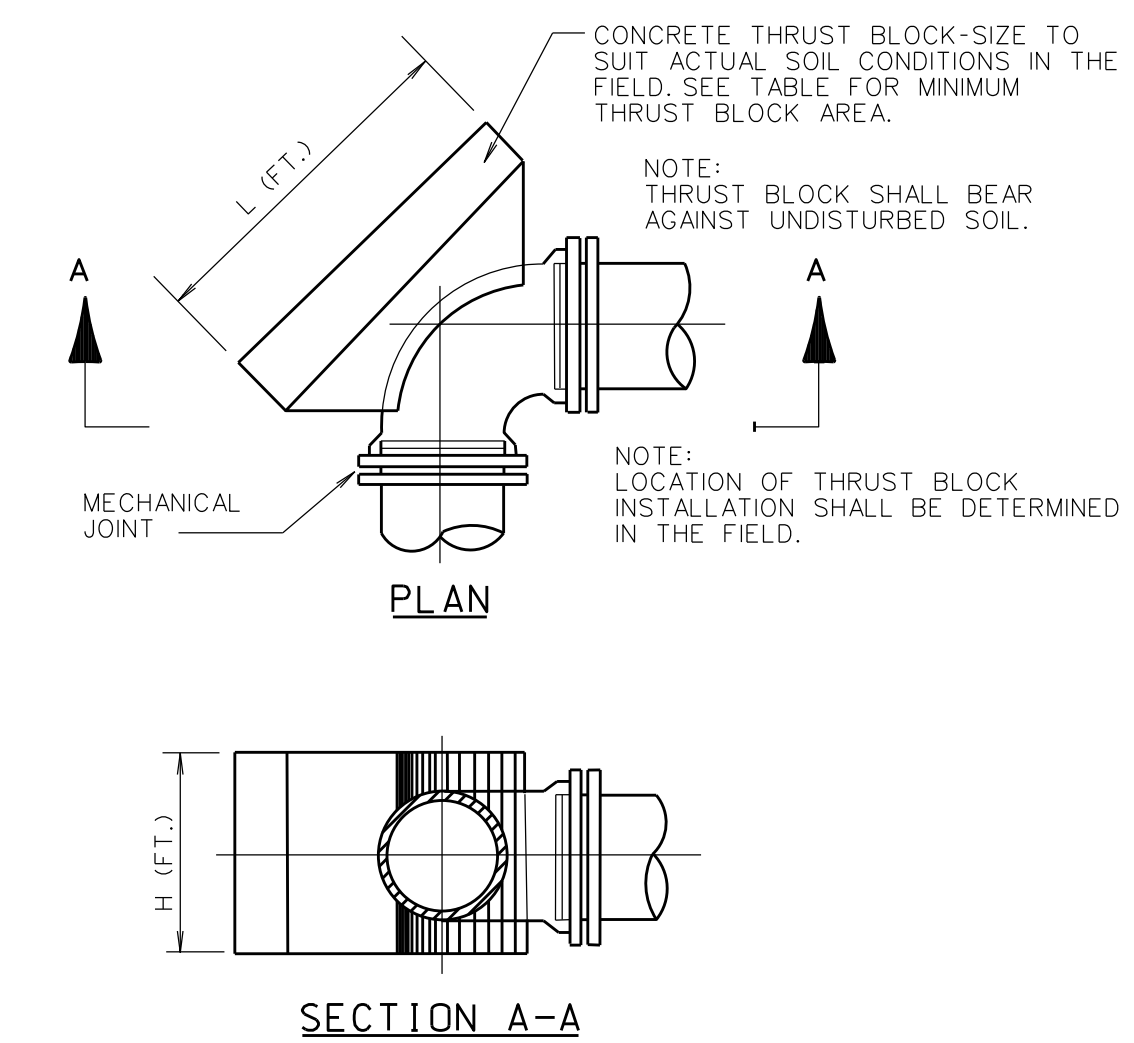

TYPICAL THRUST BLOCK DETAIL FOR BENDS
N.T.S.

DATE 8/27/2019

PROJECT NO. 019-19-116

DESIGNED CLC

DRAWN CCJ

APPROVED CLC



SCALE NONE

SHEET TITLE


WATER
DETAILS

SHEET NO.


08

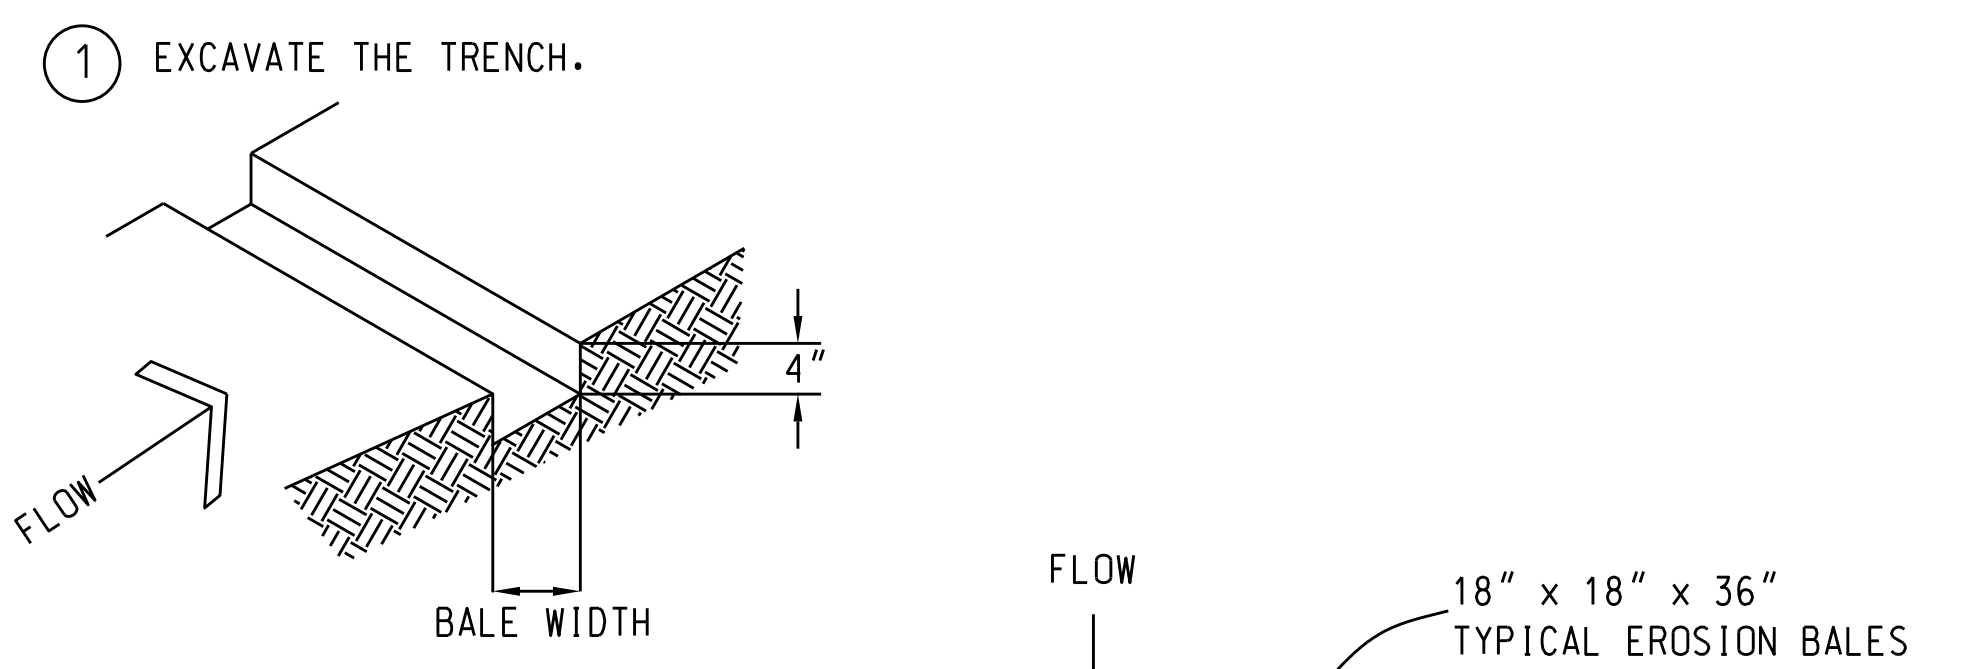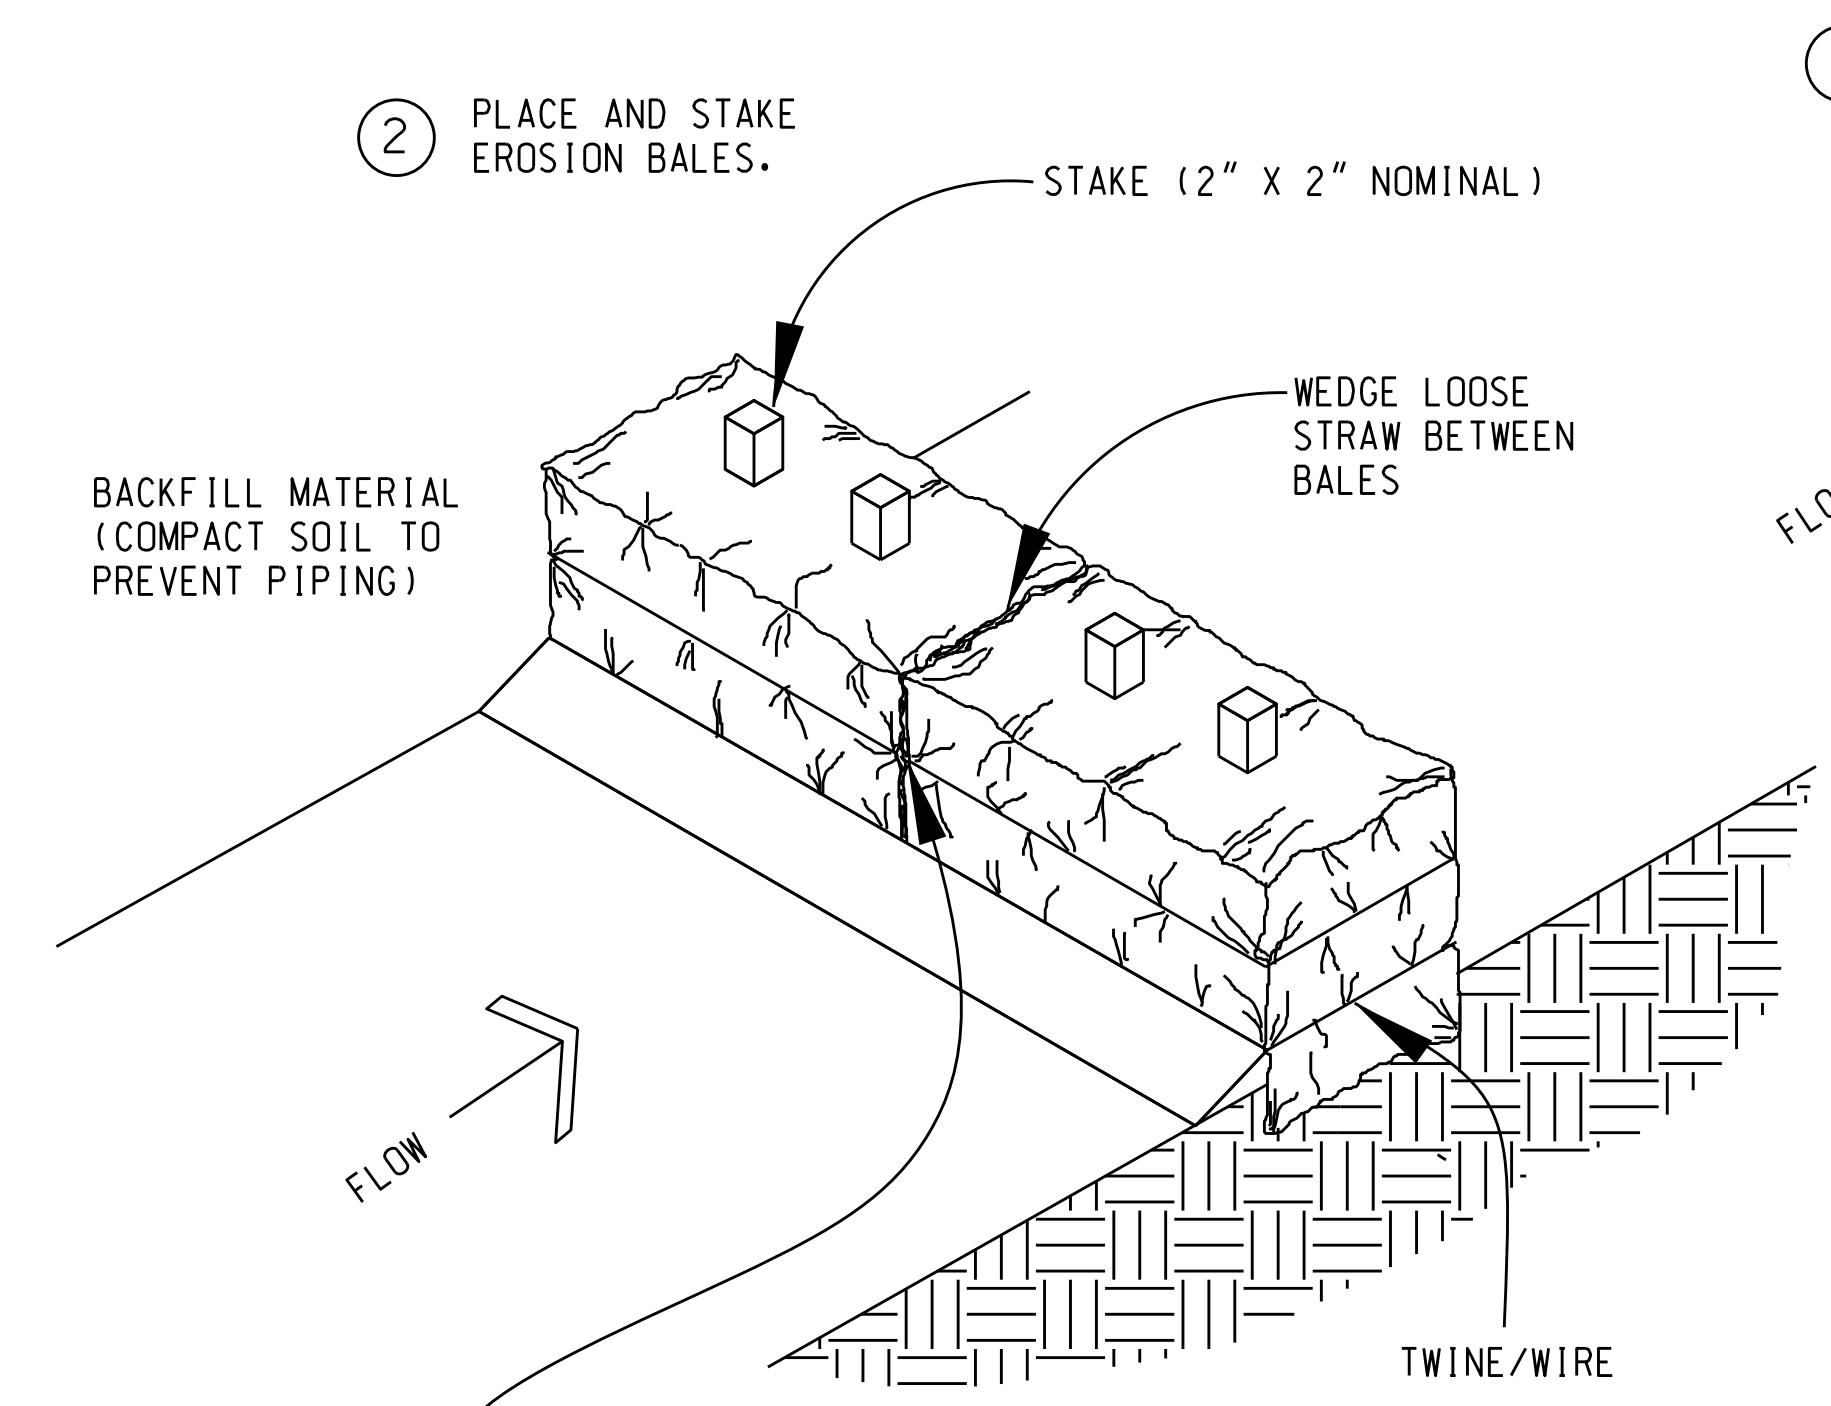


① BURY UPSLOPE END OF BLANKET IN A TRENCH 6" DEEP BY 6" WIDE.

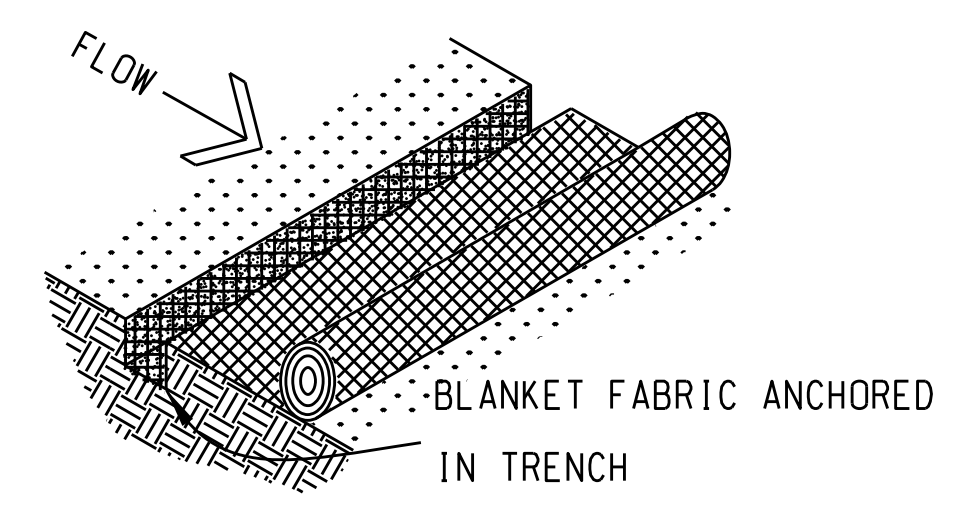


② USE A 4" OVERLAP WHEREVER TWO WIDTHS OF BLANKET ARE APPLIED SIDE BY SIDE. STAPLE PATTERN: MINIMUM 3 PER SQUARE YARD.

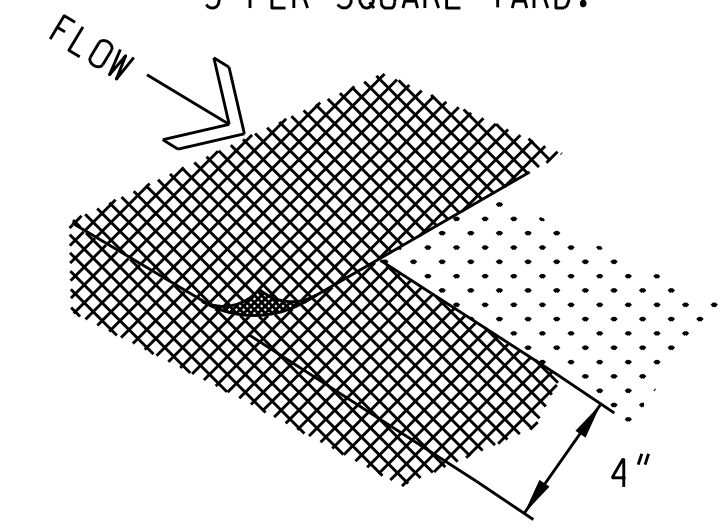



③ USE A 6" OVERLAP WHEREVER ONE ROLL OF BLANKET ENDS AND ANOTHER BEGINS.

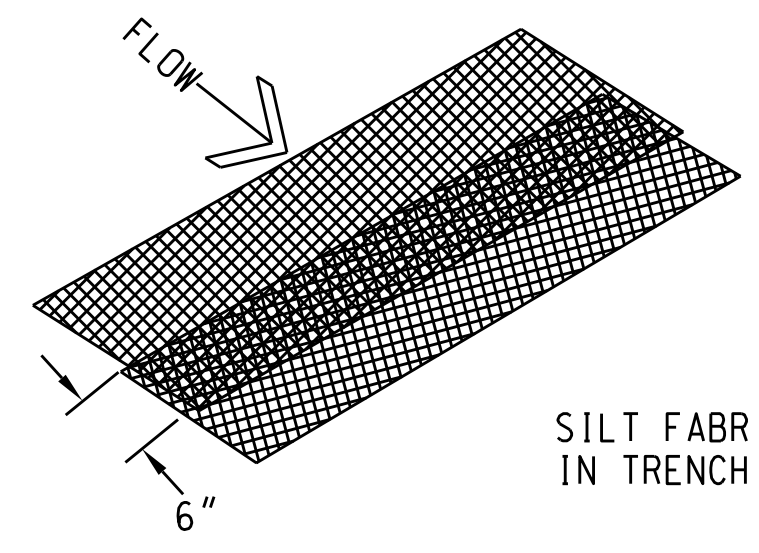



④ CHECK SLOTS SHOULD BE MADE EVERY 18'. INSERT A FOLD OF THE BLANKET INTO A TRENCH 6" WIDE BY 6" DEEP AND TAMP FIRMLY. LAY THE BLANKET SMOOTHLY ON THE SURFACE OF THE SOIL; DO NOT STRETCH THE BLANKET, AND DO NOT ALLOW WRINKLES. INSTALL STAPLE 20" ON CENTER IN TRENCH.

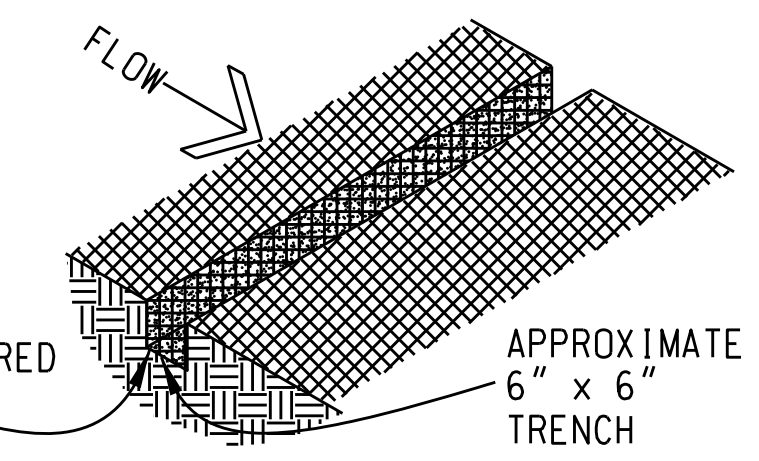


③ BALES MUST BE TIGHTLY ABUTTING WITH NO GAPS

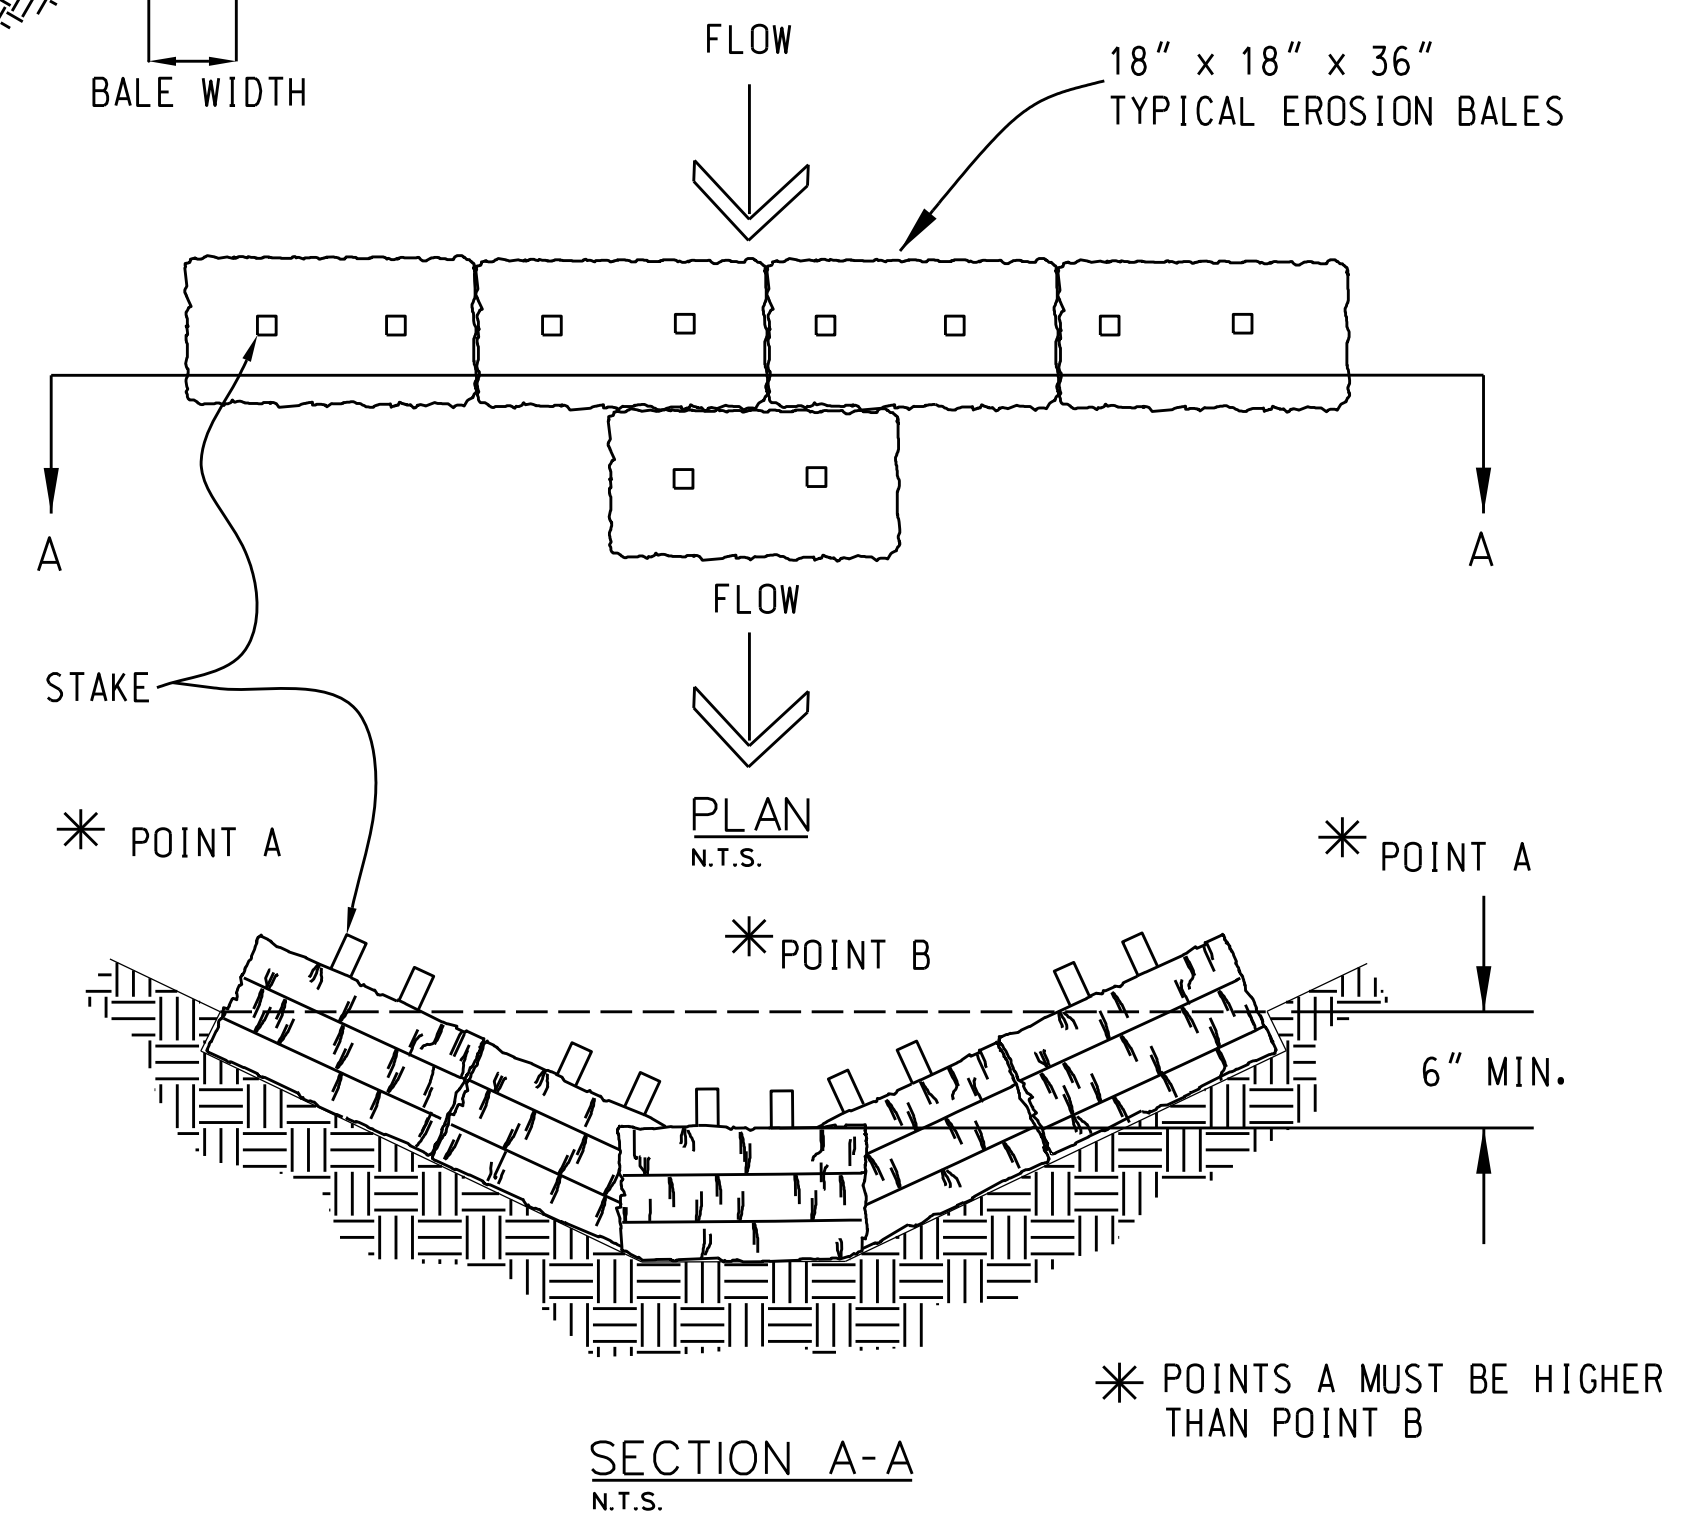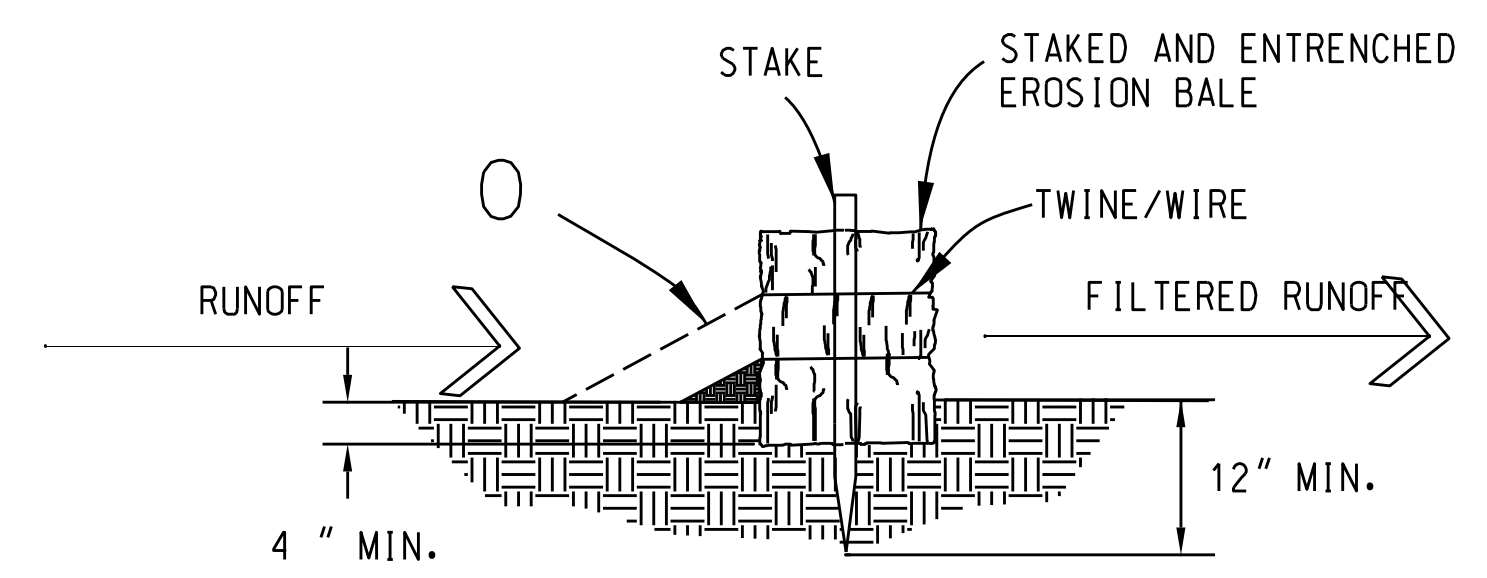


EROSION BALES TRENCHING AND STAKING (TYP)
N.T.S.

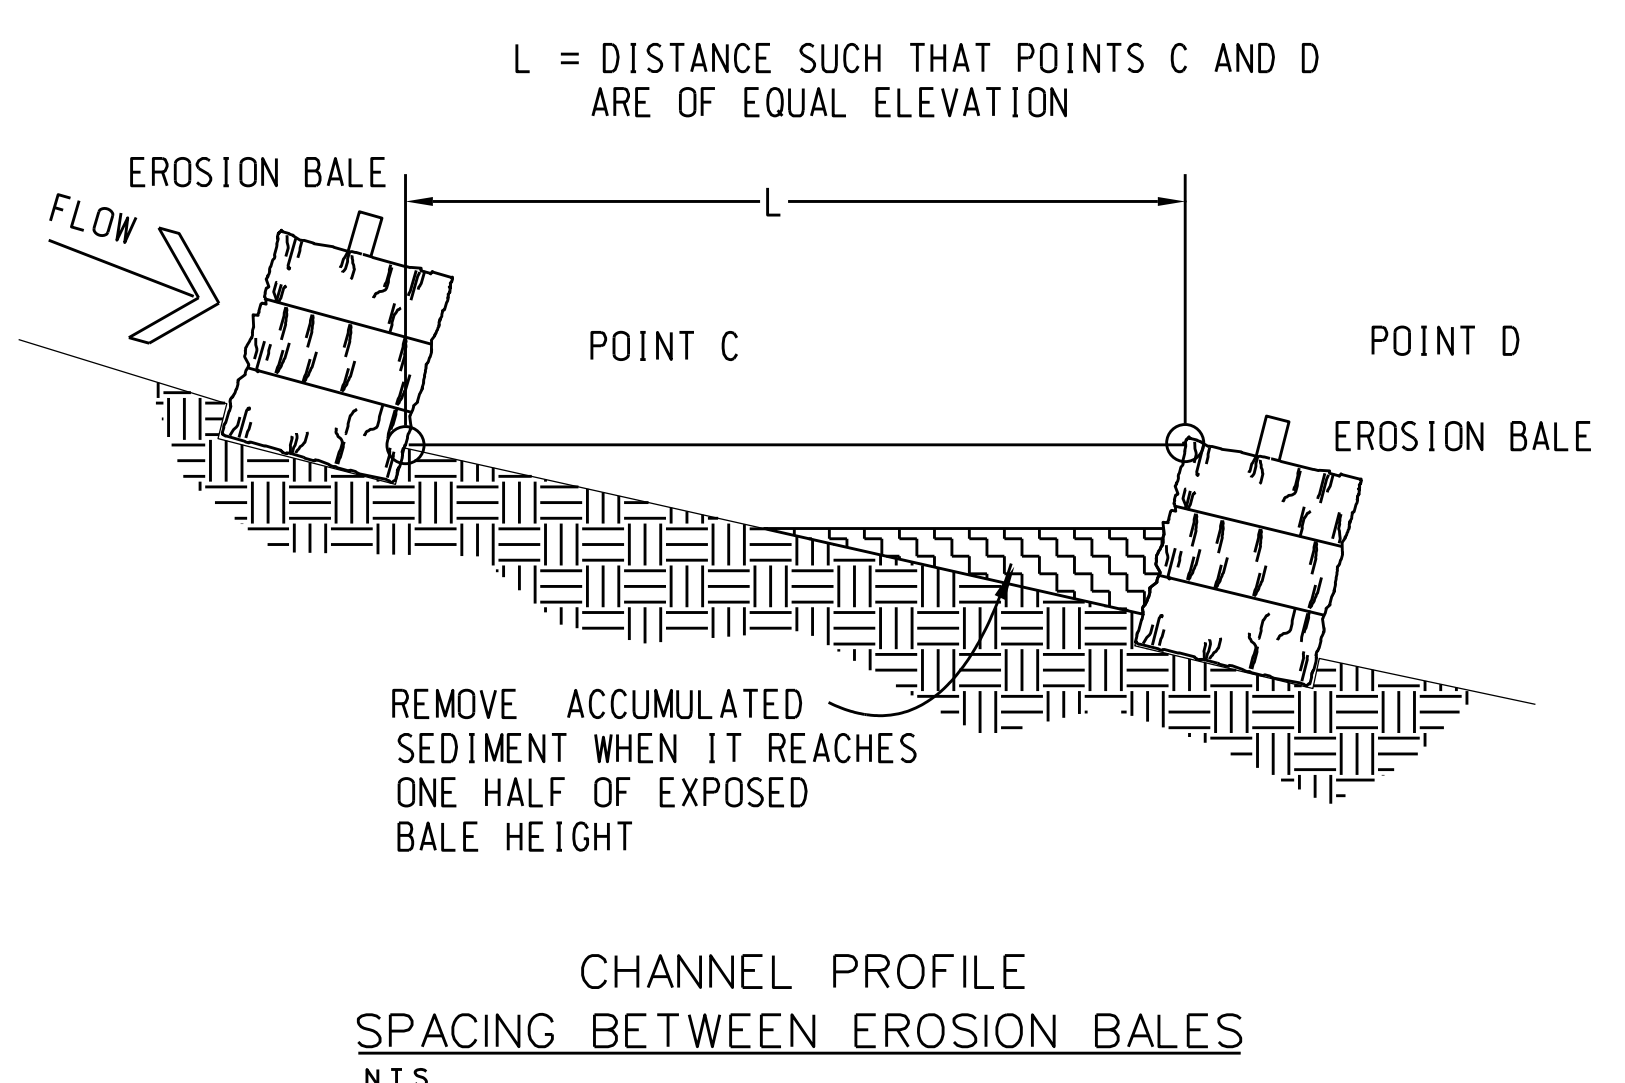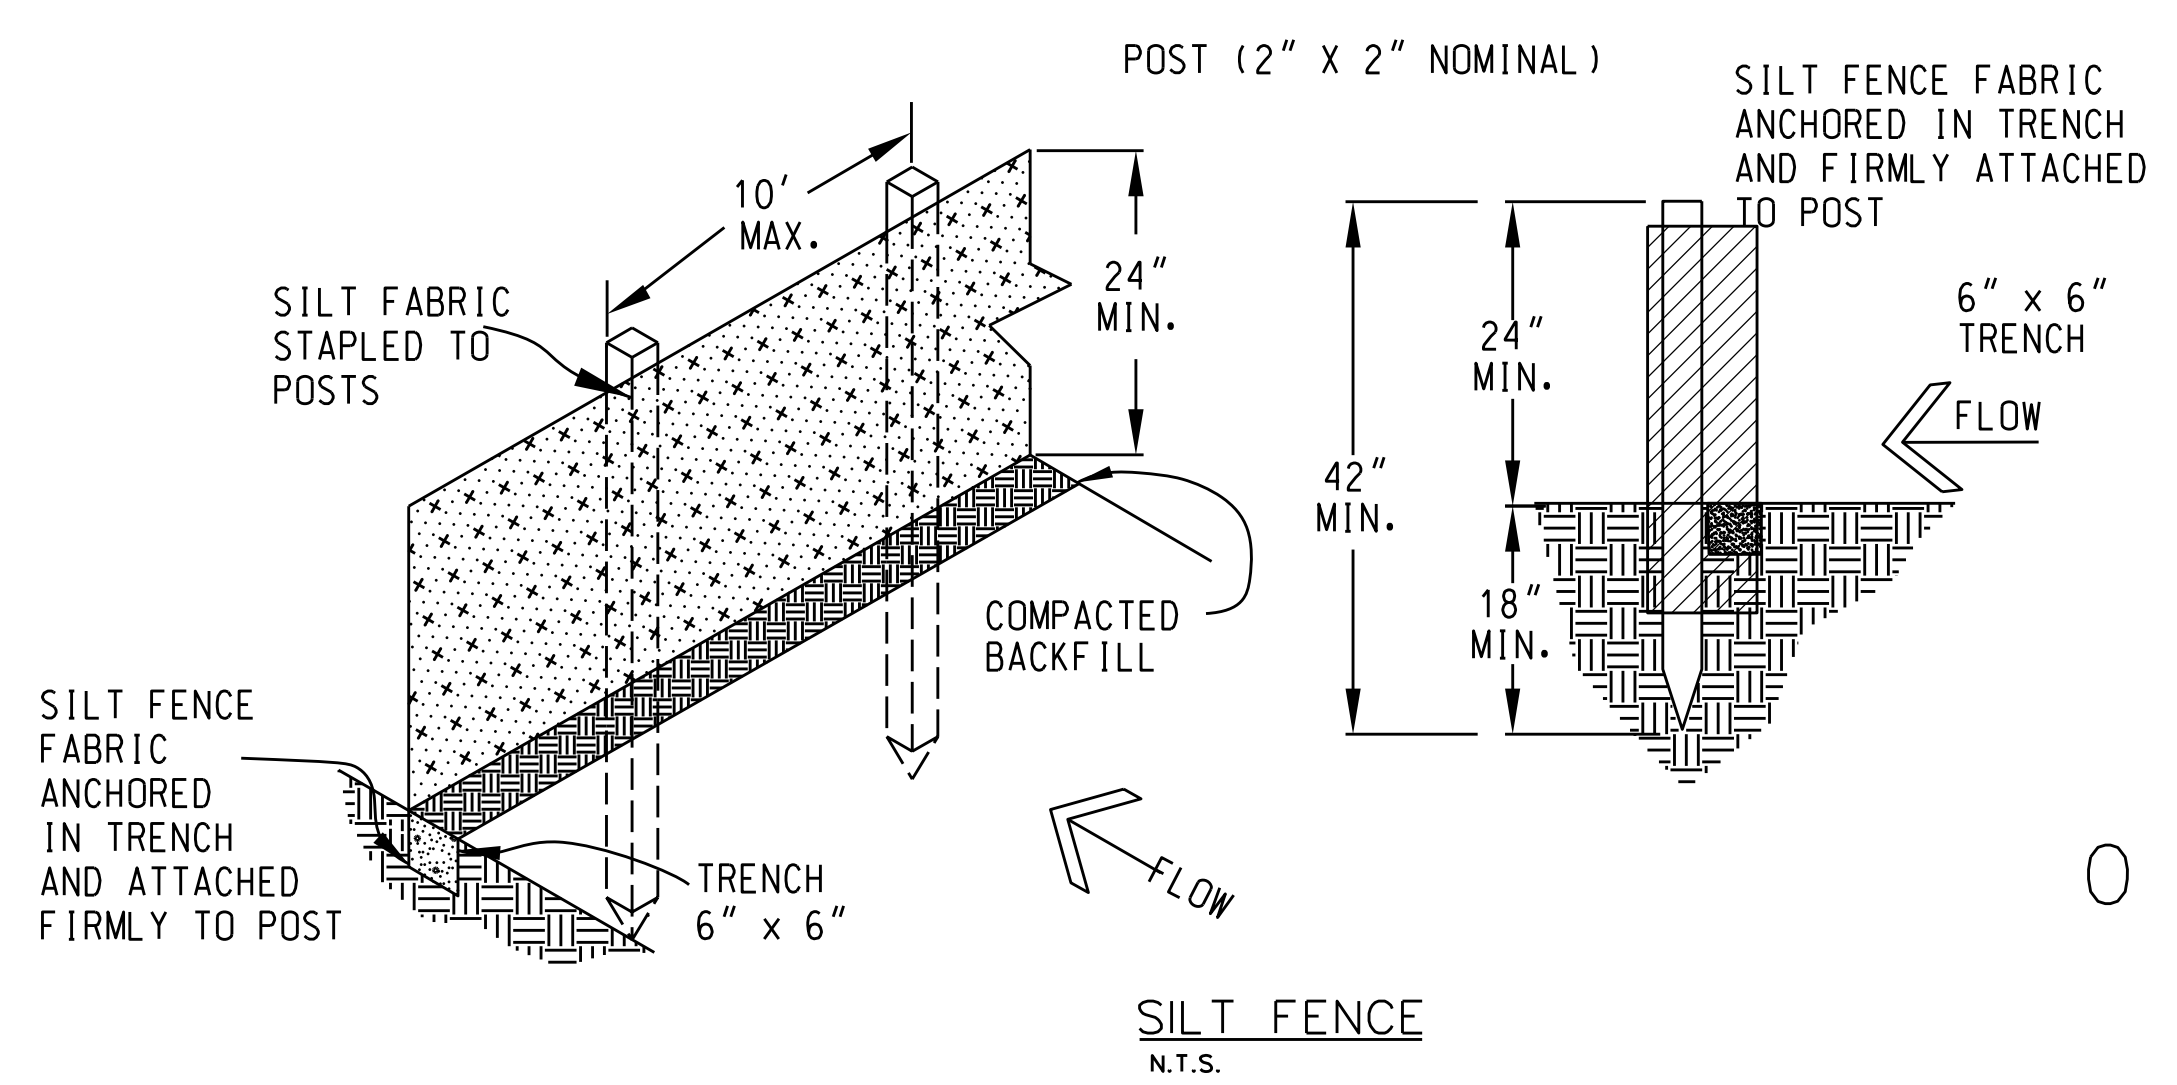

○ SEDIMENT REMOVAL SHALL BE PERFORMED CONTINUOUSLY FOR PROPER FUNCTION.

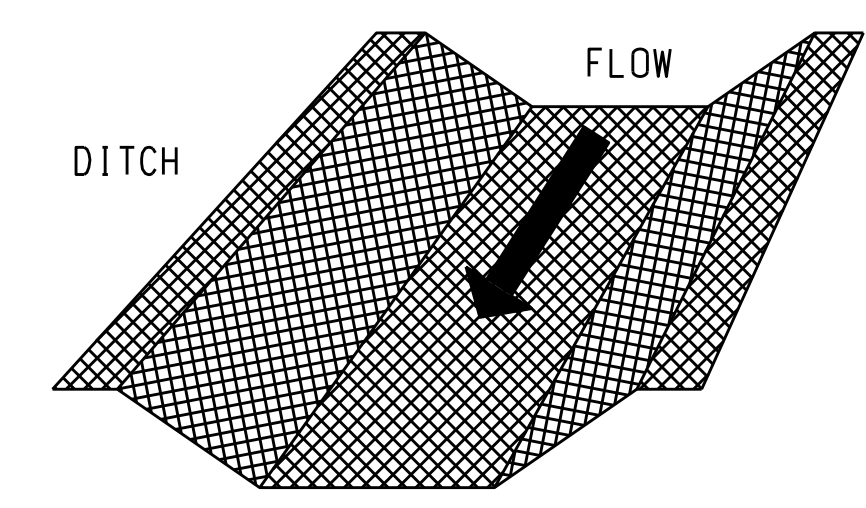

PLACE BLANKET PARALLEL TO THE DIRECTION OF FLOW. DO NOT JOIN STRIPS IN THE CENTER OF THE DITCH. USE CHECK SLOTS AS REQUIRED.

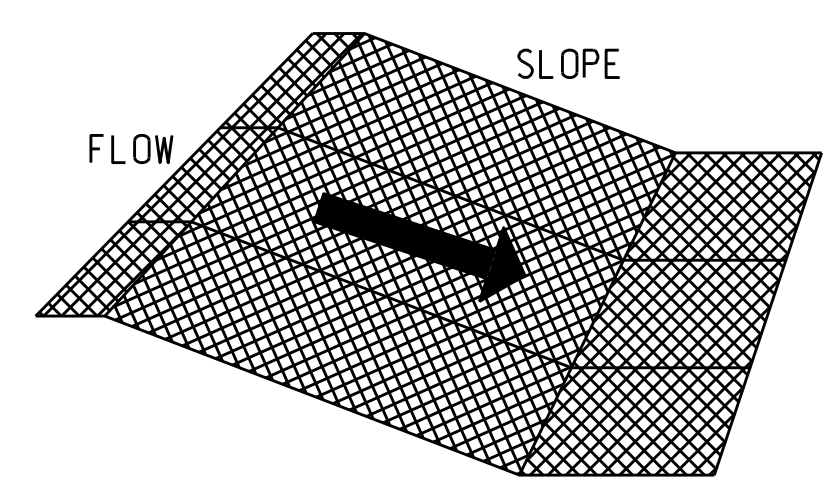

LEVEL AREA BEFORE TERMINATING THE INSTALLATION.

EROSION CONTROL NETTING
(SOIL RETENTION BLANKETS)
N.T.S.


SEE SPECIFICATIONS OR PLANS FOR MORE DETAIL

NOTE: EROSION CONTROL NETTING, SILT FENCING, AND HAY BALES ARE TO BE PLACED AS DIRECTED BY THE ENGINEER.

NOTE: EROSION CONTROL NETTING, SILT FENCING, AND HAY BALES ARE TO BE PLACED AS DIRECTED BY THE ENGINEER.

DATE	8/27/2019
PROJECT NO.	019-19-116
DESIGNED	CLC
DRAWN	CCJ
APPROVED	CLC
SCALE	NONE
SHEET TITLE	EROSION CONTROL DETAILS

SHEET NO.

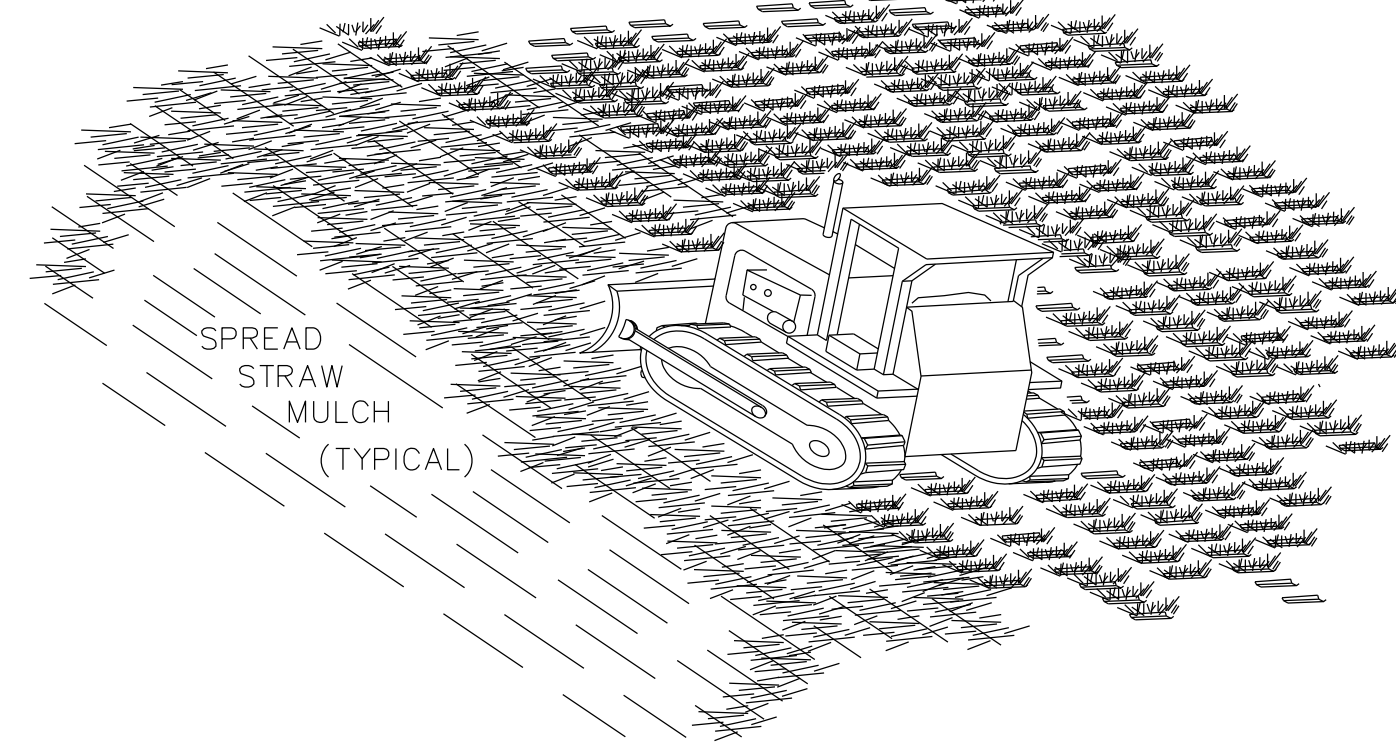


*TRACKING WITH MACHINERY ON SANDY SOIL PROVIDES ROUGHENING WITHOUT UNDUE COMPACTION.

NOTES:

1. ROUGHEN SLOPE WITH BULLDOZER
2. BROADCAST SEED AND FERTILIZER.
3. SPREAD STRAW MULCH 3" THICK. (2 1/2 TONS PER ACRE)
4. PUNCH STRAW MULCH INTO SLOPE BY RUNNING BULLDOZER UP AND DOWN SLOPE.

STRAW ANCHORING
N.T.S.


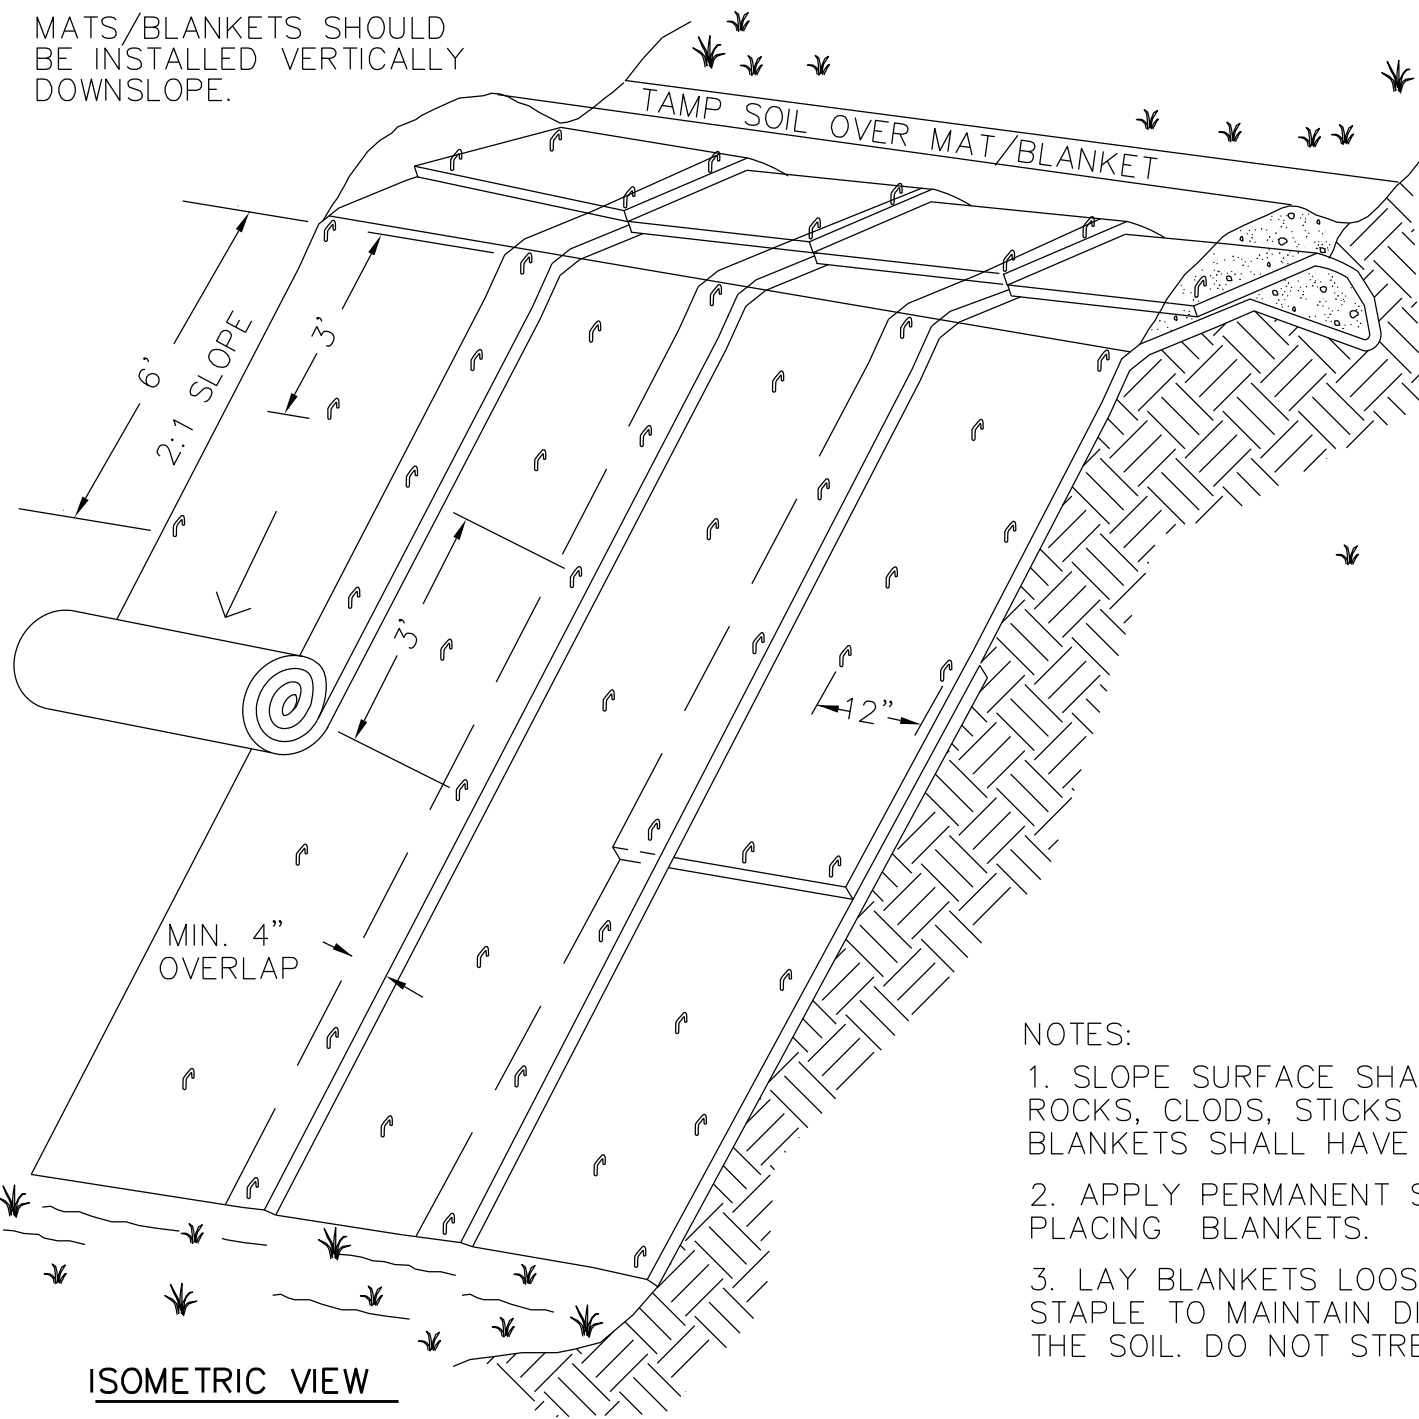


ISOMETRIC VIEW
TYPICAL SLOPE
SOIL STABILIZATION

NOTES:

1. SLOPE SURFACE SHALL BE FREE OF ROCKS, CLODS, STICKS AND GRASS. MATS/BLANKETS SHALL HAVE GOOD SOIL CONTACT.
2. APPLY PERMANENT SEEDING BEFORE PLACING BLANKETS.
3. LAY BLANKETS LOOSELY AND STAKE OR STAPLE TO MAINTAIN DIRECT CONTACT WITH THE SOIL. DO NOT STRETCH.

EROSION BLANKETS & TURF REINFORCEMENT MATS SLOPE INSTALLATION
N.T.S.

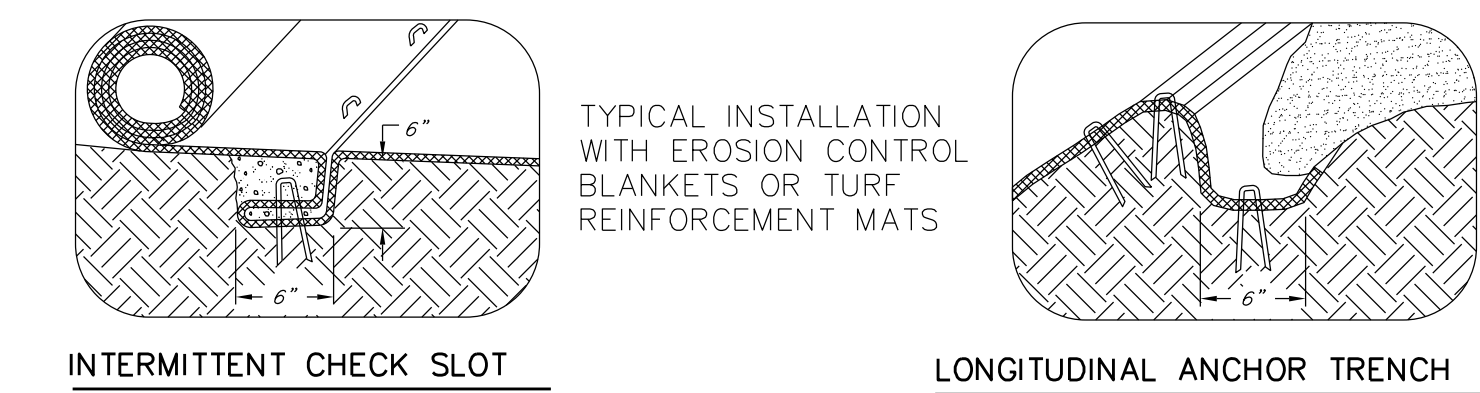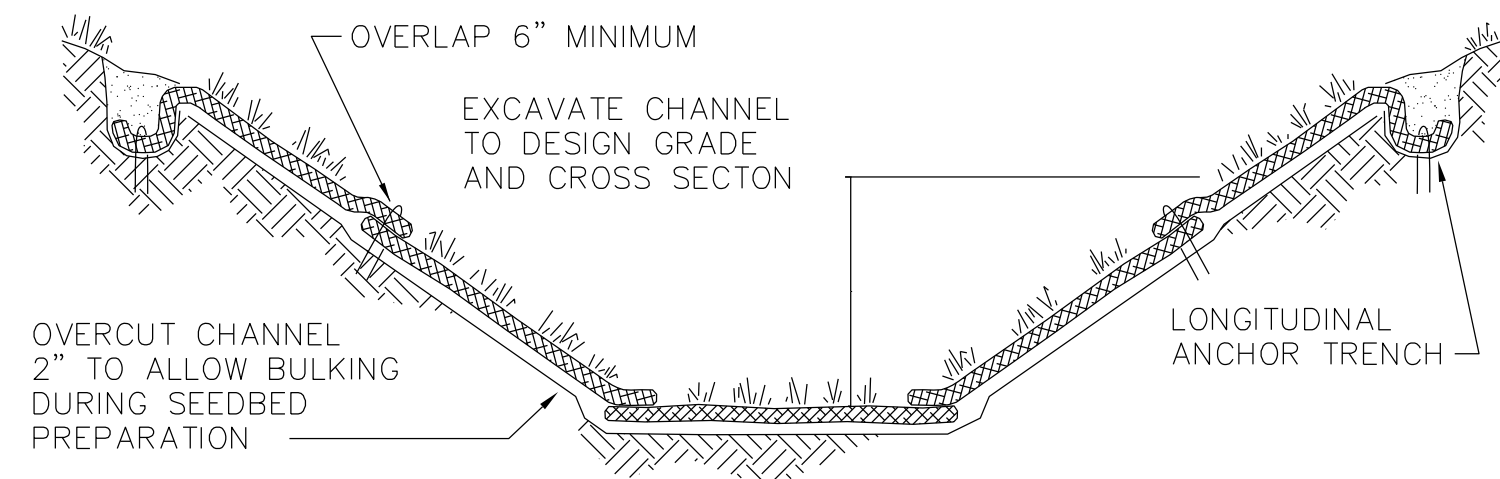

INTERMITTENT CHECK SLOT



LONGITUDINAL ANCHOR TRENCH

SHINGLE-LAP SPLICED ENDS OR BEGIN NEW ROLL IN AN INTERMITTENT CHECK SLOT

PREPARE SOIL AND APPLY SEED BEFORE INSTALLING BLANKETS, MATS OR OTHER TEMPORARY CHANNEL LINER SYSTEM

- NOTES:**
1. DESIGN VELOCITIES EXCEEDING 2 FT/SEC REQUIRE TEMPORARY BLANKETS, MATS OR SIMILAR LINERS TO PROTECT SEED AND SOIL UNTIL VEGETATION BECOMES ESTABLISHED.
 2. GRASS-LINED CHANNELS WITH DESIGN VELOCITIES EXCEEDING 6 FT/SEC SHOULD INCLUDE TURF REINFORCEMENT MATS.

GRASS-LINED CHANNEL TYPICAL INSTALLATION
N.T.S.

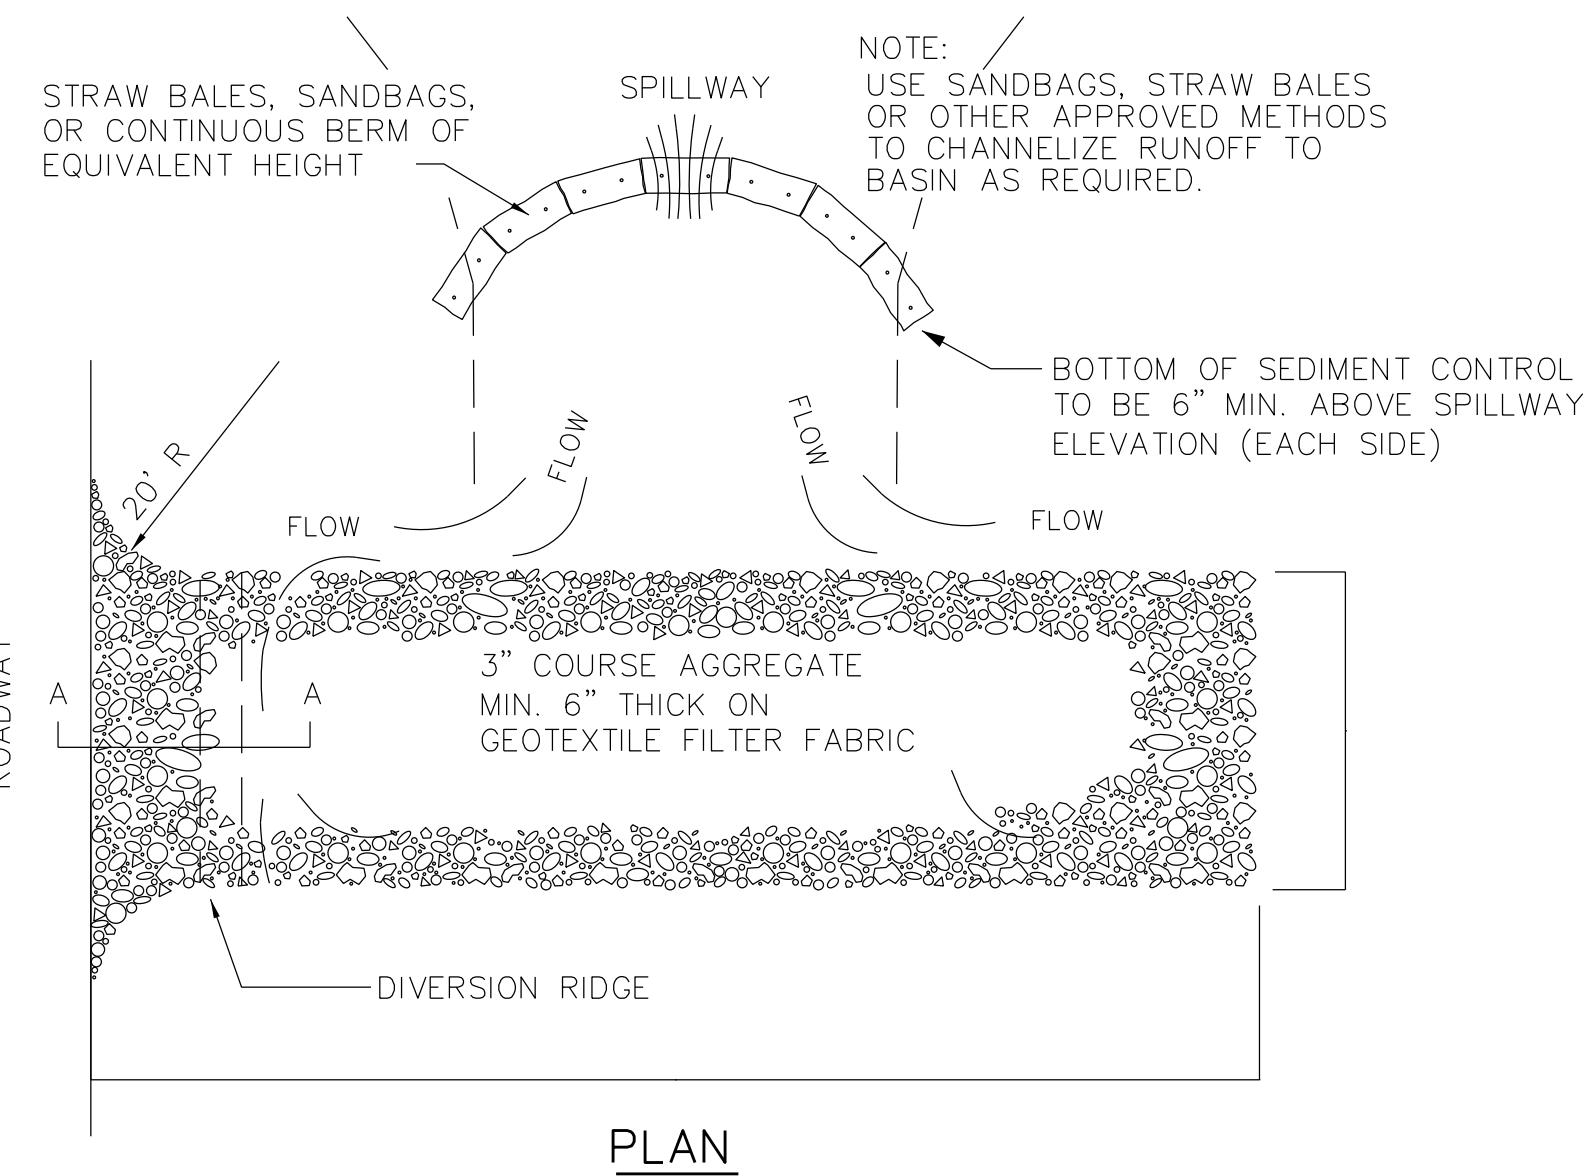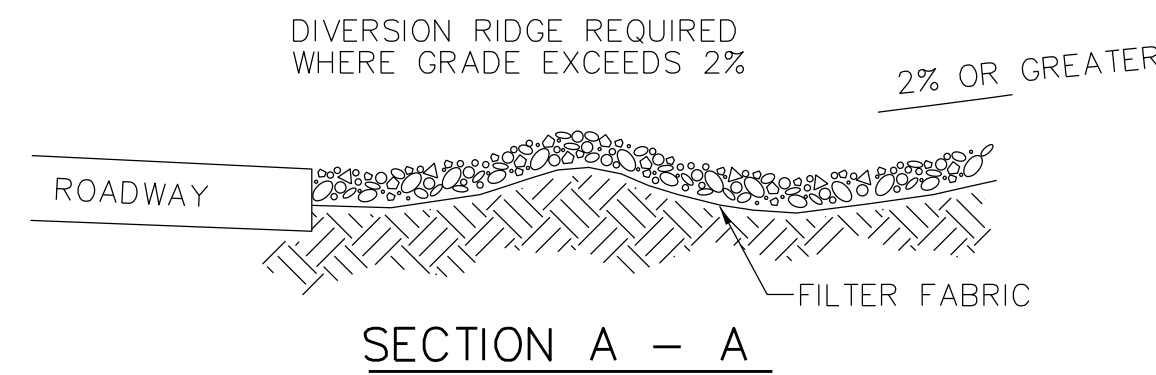

NOTE:
THE ENTRANCE SHALL BE MAINTAINED IN A CONDITION THAT WILL PREVENT TRACKING OR FLOWING OF SEDIMENT ONTO PUBLIC RIGHT-OF-WAYS. THIS MAY REQUIRE TOP DRESSING, REPAIR AND/OR CLEAN OUT OF ANY MEASURES USED TO TRAP SEDIMENT.

TEMPORARY GRAVEL CONSTRUCTION ENTRANCE/EXIT
N.T.S.

DATE 8/27/2019

PROJECT NO. 019-19-116

DESIGNED CLC

DRAWN CCJ

APPROVED CLC

SCALE NONE

SHEET TITLE

EROSION CONTROL DETAILS


SHEET NO.

11





GENERAL NOTES

- 1. GEOTECHNICAL INFORMATION
1.1. A GEOTECHNICAL SUB-SURFACE INVESTIGATION HAS NOT BEEN PERFORMED FOR THIS PROJECT. FOUNDATION DESIGN IS BASED ON SUSPECTED SUB-SURFACE CONDITIONS TYPICAL FOR THE AREA.
2. FOUNDATIONS:
2.1. THE "CONTROLLED AREA" SHALL EXTEND BENEATH AND 5 FEET BEYOND THE BUILDING AREA. THE "CONTROLLED AREA" SHALL BE COMPLETELY STRIPPED AND ALL SURFACE VEGETATION, ORGANIC FILL OR TOPSOIL, DEBRIS AND ANY OTHER...
3. CONCRETE:
3.1. CONCRETE SHALL CONFORM TO THE BUILDING CODE REQUIREMENT FOR REINFORCED CONCRETE (ACI 318).
3.2. CONCRETE SHALL HAVE THE FOLLOWING COMPRESSIVE STRENGTH (fc) AT 28 DAYS BASED UPON ITS USE:
3.2.1. FOOTINGS, SLABS ON GRADE - 3000 PSI (MIN.)
3.3. REINFORCING STEEL SHALL CONFORM TO ASTM A 615, GRADE 60.
3.4. WELDED WIRE FABRIC (W.W.F.) SHALL CONFORM TO ASTM A 185.
3.4.1. SLABS ON GRADE SHALL BE REINFORCED AS INDICATED ON PLANS W.W.F. PLACED AT 1/3 SLAB THICKNESS FROM TOP.
3.5. CAST IN PLACE ANCHOR RODS SHALL CONFORM TO ASTM F 1554 GR. 36.
3.6. MINIMUM CONCRETE COVER, (UNLESS OTHERWISE NOTED ON DRAWINGS) FOR REINFORCING SHALL BE:
3.6.1. CAST AGAINST AND EXPOSED TO EARTH - 3 IN.
3.6.2. EXPOSED TO EARTH OR WEATHER - 2 IN.
3.7. LAP ALL CONTINUOUS REINFORCEMENT 30 BAR DIAMETER MINIMUM, UNLESS NOTED OTHERWISE.
3.8. AT EXTERIOR BUILDING CORNERS FOOTINGS, PROVIDE 3'-0" X 3'-0" CORNER BARS, SAME SIZE AND NUMBER AS DETAILED HORIZONTAL BARS.
3.9. DOWEL ALL FOOTINGS WHERE THEY ABUT WITH SAME REINFORCEMENT AS DETAILED HORIZONTALLY AND WITH 2'-0" MINIMUM LAP.
3.10. CAST IN PLACE CONCRETE WALLS ARE UNSTABLE AND REQUIRE TEMPORARY CONSTRUCTION BRACING UNTIL INSTALLATION OF PERMANENT CONNECTION. TEMPORARY CONSTRUCTION BRACING IS THE SOLE RESPONSIBILITY OF THE CONTRACTOR
3.11. SUBMITTALS
3.11.1. CONCRETE MIX DESIGNS
3.11.1.1. SUBMITTALS SHALL BE IN ACCORDANCE WITH ACI 301 AND ACI 318 (LATEST EDITIONS) PRIOR TO COMMENCEMENT OF CONCRETE WORK.
3.11.1.2. SUBMITTAL SHALL BE REVIEWED AND APPROVED BY THE ARCHITECT AND ENGINEER OF RECORD PRIOR TO SCHEDULING CONCRETE DELIVERY TO JOB SITE.
3.11.2. REINFORCEMENT SUBMITTALS
3.11.2.1. SUBMITTALS SHALL BE IN ACCORDANCE WITH ACI 315 (LATEST EDITION) AND SHOW, AT MINIMUM, ALL SIZES, DIMENSIONS, LOCATIONS OF ALL REINFORCEMENT AND EMBEDMENTS.
3.11.2.2. SUBMITTAL SHALL BE REVIEWED AND APPROVED BY THE ENGINEER OF RECORD PRIOR TO FABRICATING REINFORCEMENT.
4. MASONRY:
4.1. CONCRETE MASONRY UNITS SHALL BE HOLLOW LOADBEARING CONFORMING TO ASTM C 90 ALL LOCATIONS. MORTAR SHALL BE GRADE S FOR BELOW GROUND LEVEL AND EITHER TYPE N OR TYPE S FOR ABOVE GROUND CONFORMING TO ASTM C-270.
4.2. HORIZONTAL JOINT REINFORCING SHALL BE TRUSS TYPE FABRICATED WITH SINGLE PAIR 9 GAGE SIDE RODS AND 9 GAGE CONTINUOUS DIAGONAL CROSSRODS SPACED NOT MORE THAN 16" O.C. REINFORCEMENT SHALL BE FOR TOTAL WIDTH OF SINGLE AND MULTIPLE WIDTH UNIT WALLS.
4.3. FILLED CELLS INDICATED ON PLAN SHALL BE FILLED WITH 2000 PSI GROUT IN LIFTS OF 48" HIGH. TERMINATE LIFT 1-1/2" BELOW BED JOINT TO CREATE SHEAR KEY TO NEXT LIFT. LAP REINFORCING 30 DIAMETERS AT EACH LIFT.
4.4. MASONRY WALLS ARE UNSTABLE AND REQUIRE TEMPORARY CONSTRUCTION BRACING UNTIL INSTALLATION OF PERMANENT CONNECTION. TEMPORARY CONSTRUCTION BRACING IS THE SOLE RESPONSIBILITY OF THE CONTRACTOR.
4.5. MASONRY CONTROL JOINTS (M.C.J.) SHALL BE REQUIRED WITH SPACING SHOWN ON ARCHITECTURAL PLAN, MAXIMUM SPACING OF 25' OR 3 TIMES WALL HEIGHT ALONG WALL LENGTH AND 12'-0" MAX FROM WALL CORNERS. CONSTRUCT AS SHOWN ON MASONRY CONTROL JOINT DETAIL ON STRUCTURAL DRAWINGS.
5. STRUCTURAL STEEL
5.1. STRUCTURAL W-SECTION SHAPES SHALL CONFORM TO ASTM A992.
5.2. STRUCTURAL RECTANGULAR HSS SHALL CONFORM TO ASTM A500 GR. C.
5.3. STRUCTURAL ROUND HSS SHALL CONFORM TO ASTM A500 GR. C.
5.4. STRUCTURAL AND MISCELLANEOUS STEEL ITEMS SHALL CONFORM TO ASTM A36.
5.5. STRUCTURAL BOLTS SHALL BE ASTM A-325X WITH NUTS AND WASHERS.
5.6. DETAIL, FABRICATION, AND ERECTION OF ALL STRUCTURAL STEEL SHALL BE IN ACCORDANCE WITH LATEST AISC STANDARDS AND SPECIFICATIONS.
5.7. ALL WELDING SHALL BE IN ACCORDANCE WITH AWS D1.1 (LATEST EDITION)
5.8. ELECTRODES SHALL BE E70XX.
5.9. UNLESS OTHERWISE NOTED OR DETAILED, ALL SHEAR CONNECTIONS SHALL BE DESIGNED USING THE APPROPRIATE DATA FROM PART 10 - DESIGN OF SIMPLE SHEAR CONNECTIONS FROM THE AISC MANUAL OF STEEL CONSTRUCTION, LATEST EDITION. DESIGN END REACTION IS 60% OF TOTAL ALLOWABLE LOAD (60% x Wc) FROM THE ALLOWABLE LOAD OF BEAM TABLE FROM PART 9 - DESIGN OF CONNECTING ELEMENTS" OF THE AISC MANUAL OF STEEL CONSTRUCTION, LATEST EDITION.
6. STEEL JOISTS AND JOIST GIRDERS
6.1. STEEL JOIST MANUFACTURER SHALL BE A CURRENT MEMBER OF THE STEEL JOIST INSTITUTE (SJI)
6.2. STEEL JOISTS AND JOIST GIRDERS SHALL CONFORM TO THE SPECIFICATIONS AND REQUIREMENTS OF THE LATEST EDITION OF THE SJI STANDARD SPECIFICATIONS FOR OPEN WEB STEEL (K SERIES) AND JOIST GIRDERS.
6.3. JOIST BRIDGING SHALL BE FURNISHED AND INSTALLED TO MEET THE DESIGN AND SPACING REQUIREMENTS OF THE SJI STANDARD SPECIFICATIONS FOR OPEN WEB STEEL JOISTS. UP/LIFT BRIDGING AS REQUIRED SHALL BE PROVIDED BY THE JOIST MANUFACTURER AND CLEARLY SHOWN ON THE ERECTION DRAWINGS. BRIDGING AND BRIDGING ANCHORS SHALL BE COMPLETELY INSTALLED BEFORE CONSTRUCTION LOADS ARE PLACED ON THE JOISTS.
6.4. PRIOR TO FABRICATION, SUBMIT SHOP AND LAY-OUT DRAWINGS IN SUFFICIENT DETAIL TO DEFINE THE LOCATION OF THE JOISTS, BRIDGING, EMBEDS, OPENINGS, HEADERS AND OTHER ACCESSORIES FOR REVIEW BY THE ENGINEER OF RECORD.
7. STEEL DECK:
7.1. ROOF DECK
7.1.1. STEEL ROOF DECK
7.1.1.1. MAIN ROOF - 22 GAUGE, TYPE "B" (WIDE RIB) CORRUGATED DECK
7.1.1.1.1. PROPERTIES:
7.1.1.1.1.1. NOMINAL DEPTH = 1 1/2 IN
7.1.1.1.1.2. I = 0.183 IN^4/FT WIDTH
7.1.1.1.1.3. S = 0.192 IN^3/FT WIDTH
7.1.1.1.1.4. ALLOWABLE DESIGN STRESS = 33,000 PSI
7.1.1.2. COVERED PORCH - 22 GAUGE, TYPE "N" CORRUGATED DECK
7.1.1.2.1. PROPERTIES:
7.1.1.2.1.1. NOMINAL DEPTH = 3 IN
7.1.1.2.1.2. I = 0.659 IN^4/FT WIDTH
7.1.1.2.1.3. S = 0.382 IN^3/FT WIDTH
7.1.1.2.1.4. ALLOWABLE DESIGN STRESS = 33,000 PSI
7.1.2. THE ROOF DECK SHALL BE INSTALLED AND ANCHORED TO THE SUPPORTING STRUCTURE IN ACCORDANCE WITH MANUFACTURER'S STANDARDS AND/OR AS INDICATED IN FASTENING PATTERN SCHEDULE ON THESE DRAWINGS (WHICHEVER IS MORE STRINGENT).

- 8. PRE-ENGINEERED METAL ROOF TRUSSES
8.1. ALL PREFABRICATED METAL TRUSSES SHALL BE DESIGNED, FABRICATED AND ERECTED IN STRICT ACCORDANCE WITH THE APPLICABLE CODES AND SPECIFICATIONS TO SUPPORT ALL LIVE LOADS, DEAD LOADS, AND CONCENTRATED LOADS. LATERAL BRACING (DIAGONAL AND LATERAL BRIDGING), BOTH TEMPORARY AND PERMANENT, SHALL BE DESIGNED, PROVIDED AND NOTED ON ERECTION DRAWINGS BY THE MANUFACTURER. TEMPORARY BRACING SHALL REMAIN UNTIL PERMANENT BRACING AND THE ROOF DECK ARE COMPLETELY INSTALLED.
8.2. PROVIDE EAVE BRACING DETAILS, ETC. AS REQUIRED TO INSURE PLUMB, LEVEL STRUCTURAL BASE FOR EAVE TRIM AND CORNICE. NO TWISTING OR WARPING OF TRUSS ENDS WILL BE ACCEPTED PRIOR TO INSTALLATION OF CORNICE AND TRIM.
8.3. ALL TRUSSES SHALL BE DESIGNED AND ANCHORED TO WITHSTAND THE NOTED WIND LOADS. THE ROOF TRUSSES SHALL BE DESIGNED AND ANCHORED FOR THE FOLLOWING LOADS:
8.3.1. TOP CHORD LIVE LOAD - 20 PSF
8.3.2. TOP CHORD DEAD LOAD - 10 PSF
8.3.3. BOTTOM CHORD LIVE LOAD - 0 (EXCEPT WHERE SO INDICATED ON PLANS)
8.3.4. BOTTOM CHORD DEAD LOAD - 10 PSF
8.3.5. ROOF WIND PRESSURE - PER IBC 2015
8.3.6. WIND UPLIFT - PER IBC 2015
8.4. VERIFY ALL DIMENSIONS AND DETAILS SHOWN. NOTIFY ARCHITECT/ENGINEER OF ANY REQUIRED MODIFICATIONS.
8.5. SUBMIT DESIGN DRAWINGS AND CALCULATIONS BEARING THE REGISTERED PROFESSIONAL ENGINEER'S SEAL OF THE DESIGN ENGINEER.
9. COLD-FORM METAL FRAMING
9.1. CFMF SHALL BE DESIGNED ACCORDING TO THE AMERICAN IRON AND STEEL INSTITUTE (AISI) S100 (LATEST EDITION).
9.2. ALL STRUCTURAL LOADBEARING MEMBERS SHALL BE FORMED FROM CORROSION RESISTANT STEEL CORRESPONDING TO THE REQUIREMENTS OF ASTM A446, WITH A MINIMUM YIELD STRENGTH Fy = 40 KSI FOR S STUDS GRADE A, 33 KSI FOR T TRACK. ALL STRUCTURAL MEMBERS SHALL BE ZINC COATED MEETING REQUIREMENTS FOR ASTM A525.
9.3. MEMBERS SHALL BE INSTALLED LEVEL AND TRUE IN A WORKMANLIKE MANNER. INSTALL STRAPPING AND ACCESSORIES AS DETAILED AND AS REQUIRED FOR PROPER INSTALLATION.
9.4. THE PHYSICAL AND STRUCTURAL PROPERTIES LISTED BY THE MANUFACTURER SHALL BE CONSIDERED THE MINIMUM PERMITTED FOR ALL FRAMING MEMBERS.
10. DESIGN LOADS:
10.1. LIVE LOADS:
10.1.1. ROOF - 20 PSF (REDUCIBLE)
10.2. DEAD LOADS
10.2.1. ROOF - 20 PSF
10.3. WIND LOAD:
10.3.1. DESIGN CODE - ASCE 7-10
10.3.2. DESIGN ANALYSIS PROCEDURE
10.3.2.1. MAIN WIND FORCE RESISTING SYSTEM - DIRECTIONAL PROCEDURE
10.3.3. DESIGN WIND SPEED (ULT. 3 SEC GUST) - 116 MPH
10.3.4. OCCUPANCY CATEGORY - II
10.3.5. WIND EXPOSURE CATEGORY - B
10.3.6. INTERNAL PRESSURE COEFFICIENTS - +/- 0.18
11. APPLICABLE CODES
11.1. INTERNATIONAL BUILDING CODE 2015
11.2. AMERICAN CONCRETE INSTITUTE
11.3. CONCRETE REINFORCING STEEL INSTITUTE
11.4. AMERICAN INSTITUTE OF STEEL CONSTRUCTION
11.5. AMERICAN IRON AND STEEL INSTITUTE
11.6. AMERICAN SOCIETY OF TESTING AND MATERIALS
11.7. AMERICAN WELDING SOCIETY
11.8. AMERICAN PLYWOOD ASSOCIATION

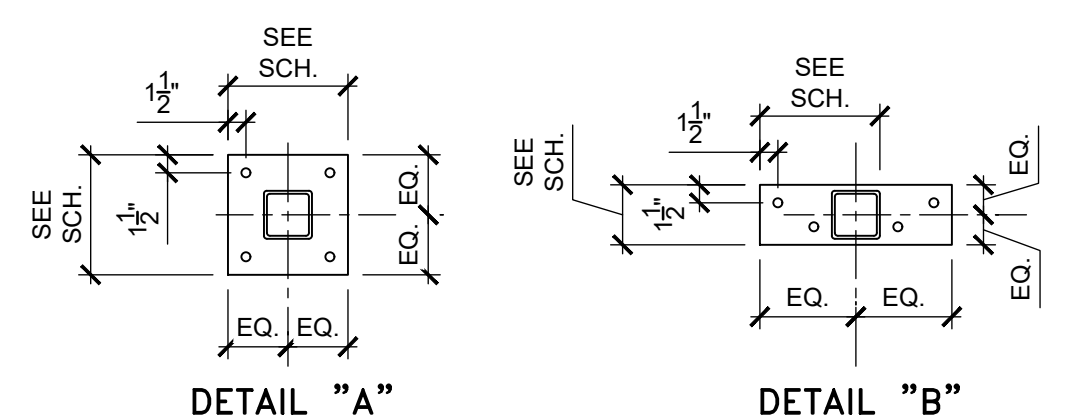

BASE PLATE SCHEDULE table with columns: COLUMN SIZE, SIZE, DETAIL, ANCHOR RODS. Includes rows for HSS 4x4 and HSS 4x4 STUB.

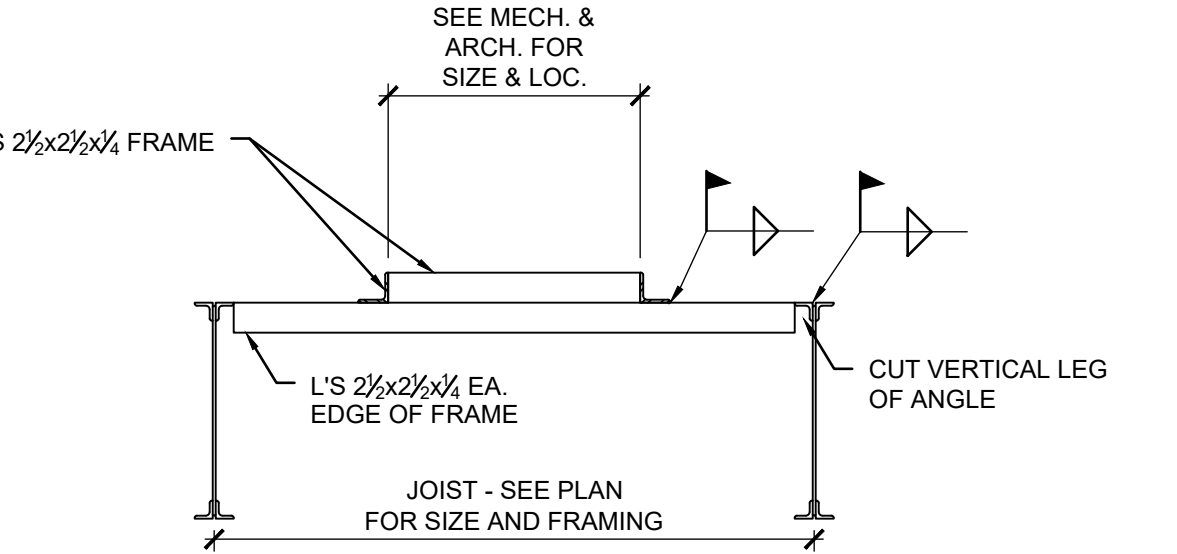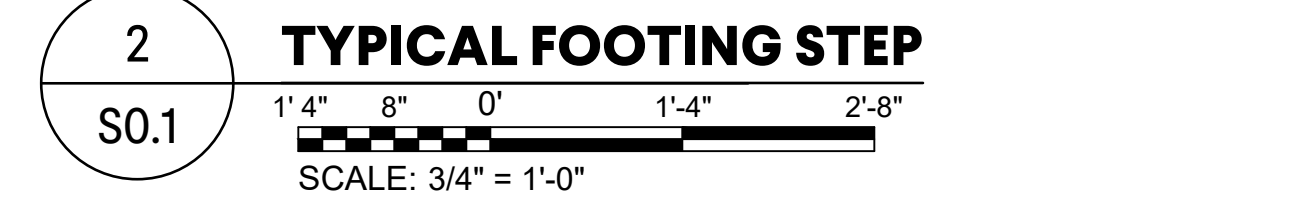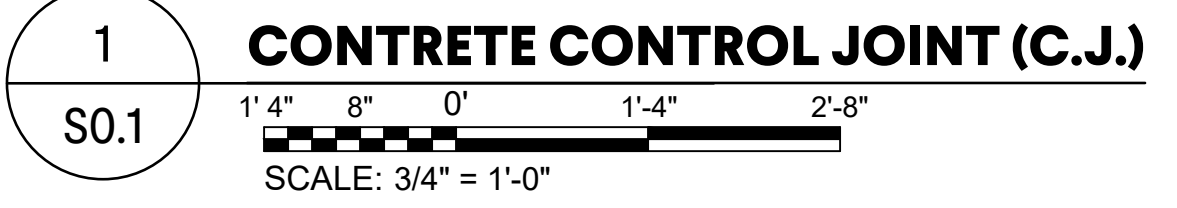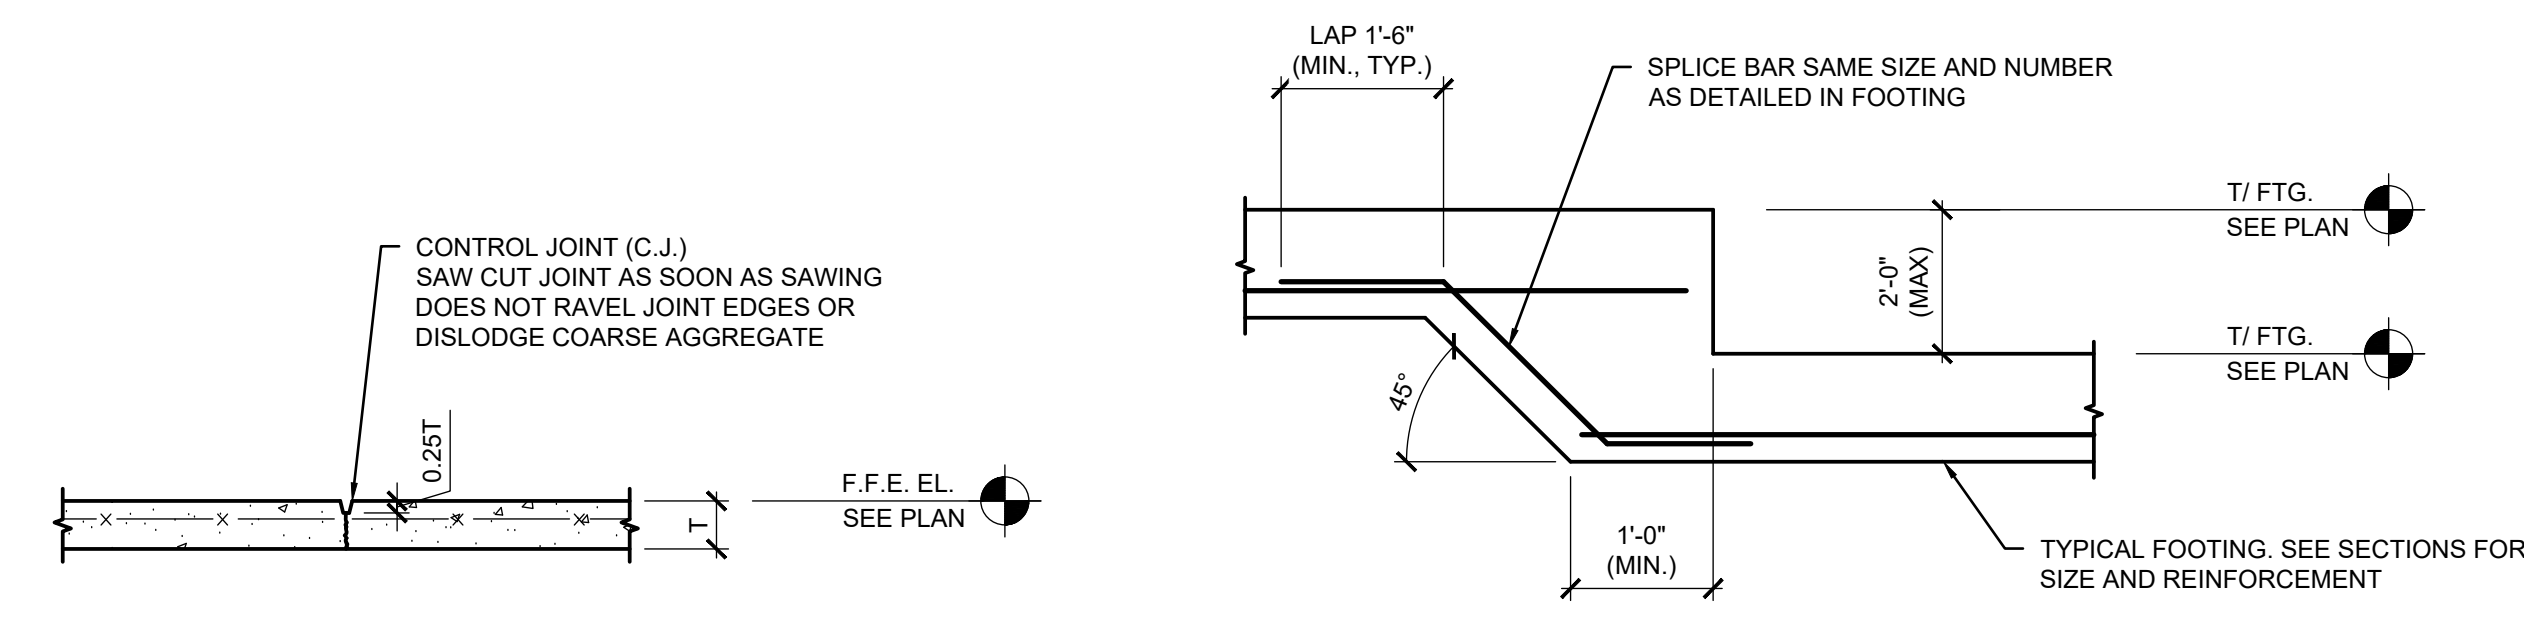

SPREAD FOOTING SCHEDULE table with columns: MARK, SIZE, REIN. EA. WAY. Includes rows SF-2 through SF-12.

HEADER SCHEDULE table with columns: MAX. OPENING, HEADER, TRACK, DETAIL. Includes rows for 6'-4\"/>


LINTEL SCHEDULE table with columns: MAX. OPENING, LITEL, ORIENTATION. Includes row for 6'-4\"/>

- NOTES:
1. BEAR LOOSE ANGLES 8" MIN. EA. END.
2. WHERE OPENINGS OCCUR AND LINTELS ARE NOT CALLED-OUT ON PLANS, SELECT LINTELS FROM ABOVE SCHEDULE USING MAXIMUM OPENING AS CRITERIA.

GMC AS-BUILT

ISSUE DATE table with columns: ISSUE DATE, REVIEW, PERMIT. Includes rows for 04/23/2019, 05/02/2019, 10/17/2019.

EXCHANGE AT HOMEPLACE PRATTVILLE, AL
GMC PROJECT#AMGM180037

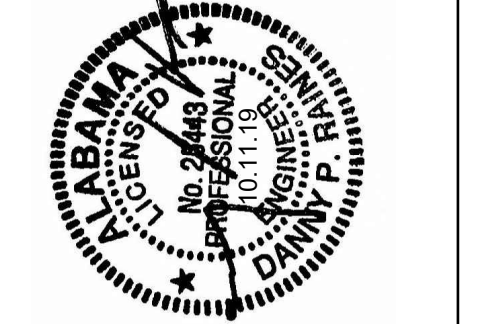


8150 OLD FEDERAL ROAD
MONTGOMERY, AL 36117
334.277.9550


GENERAL NOTES AND TYPICAL SECTIONS S0.1

WIND DESIGN LOADS FOR COMPONENTS AND CLADDING			
ZONE	EFFECTIVE WIND AREA (SQ. FT.)	3 SEC. ULTIMATE GUST PRESSURE (PSF)	
		+(INWARD) ¹	-(OUTWARD) ²
ZONE 1 ³ (TYPICAL ROOF)	10	+16	-24.2
	25	+16	-23.4
	50	+16	-22.8
ZONE 2 ⁴ (ROOF EDGES)	10	+22.1	-40.6
	25	+20.8	-34.9
	50	+19.9	-30.6
ZONE 3 ⁵ (ROOF CORNERS)	10	+22.1	-40.6
	25	+20.8	-34.9
	50	+19.9	-30.6
100	+18.9	-26.2	


- NOTES:
 1. + POSITIVE PRESSURE ACTING TOWARDS THE BUILDING SURFACE
 2. - NEGATIVE PRESSURE, ACTING AWAY FROM THE BUILDING SURFACE
 3. ZONE 1 - TYPICAL ROOF SURFACE EXCLUDING EXTERIOR
 4. ZONE 2 - ROOF SURFACE WITHIN 6'-10" OF EXTERIOR EDGES
 5. ZONE 3 - ROOF SURFACE WITHIN 6'-10" OF ROOF CORNERS

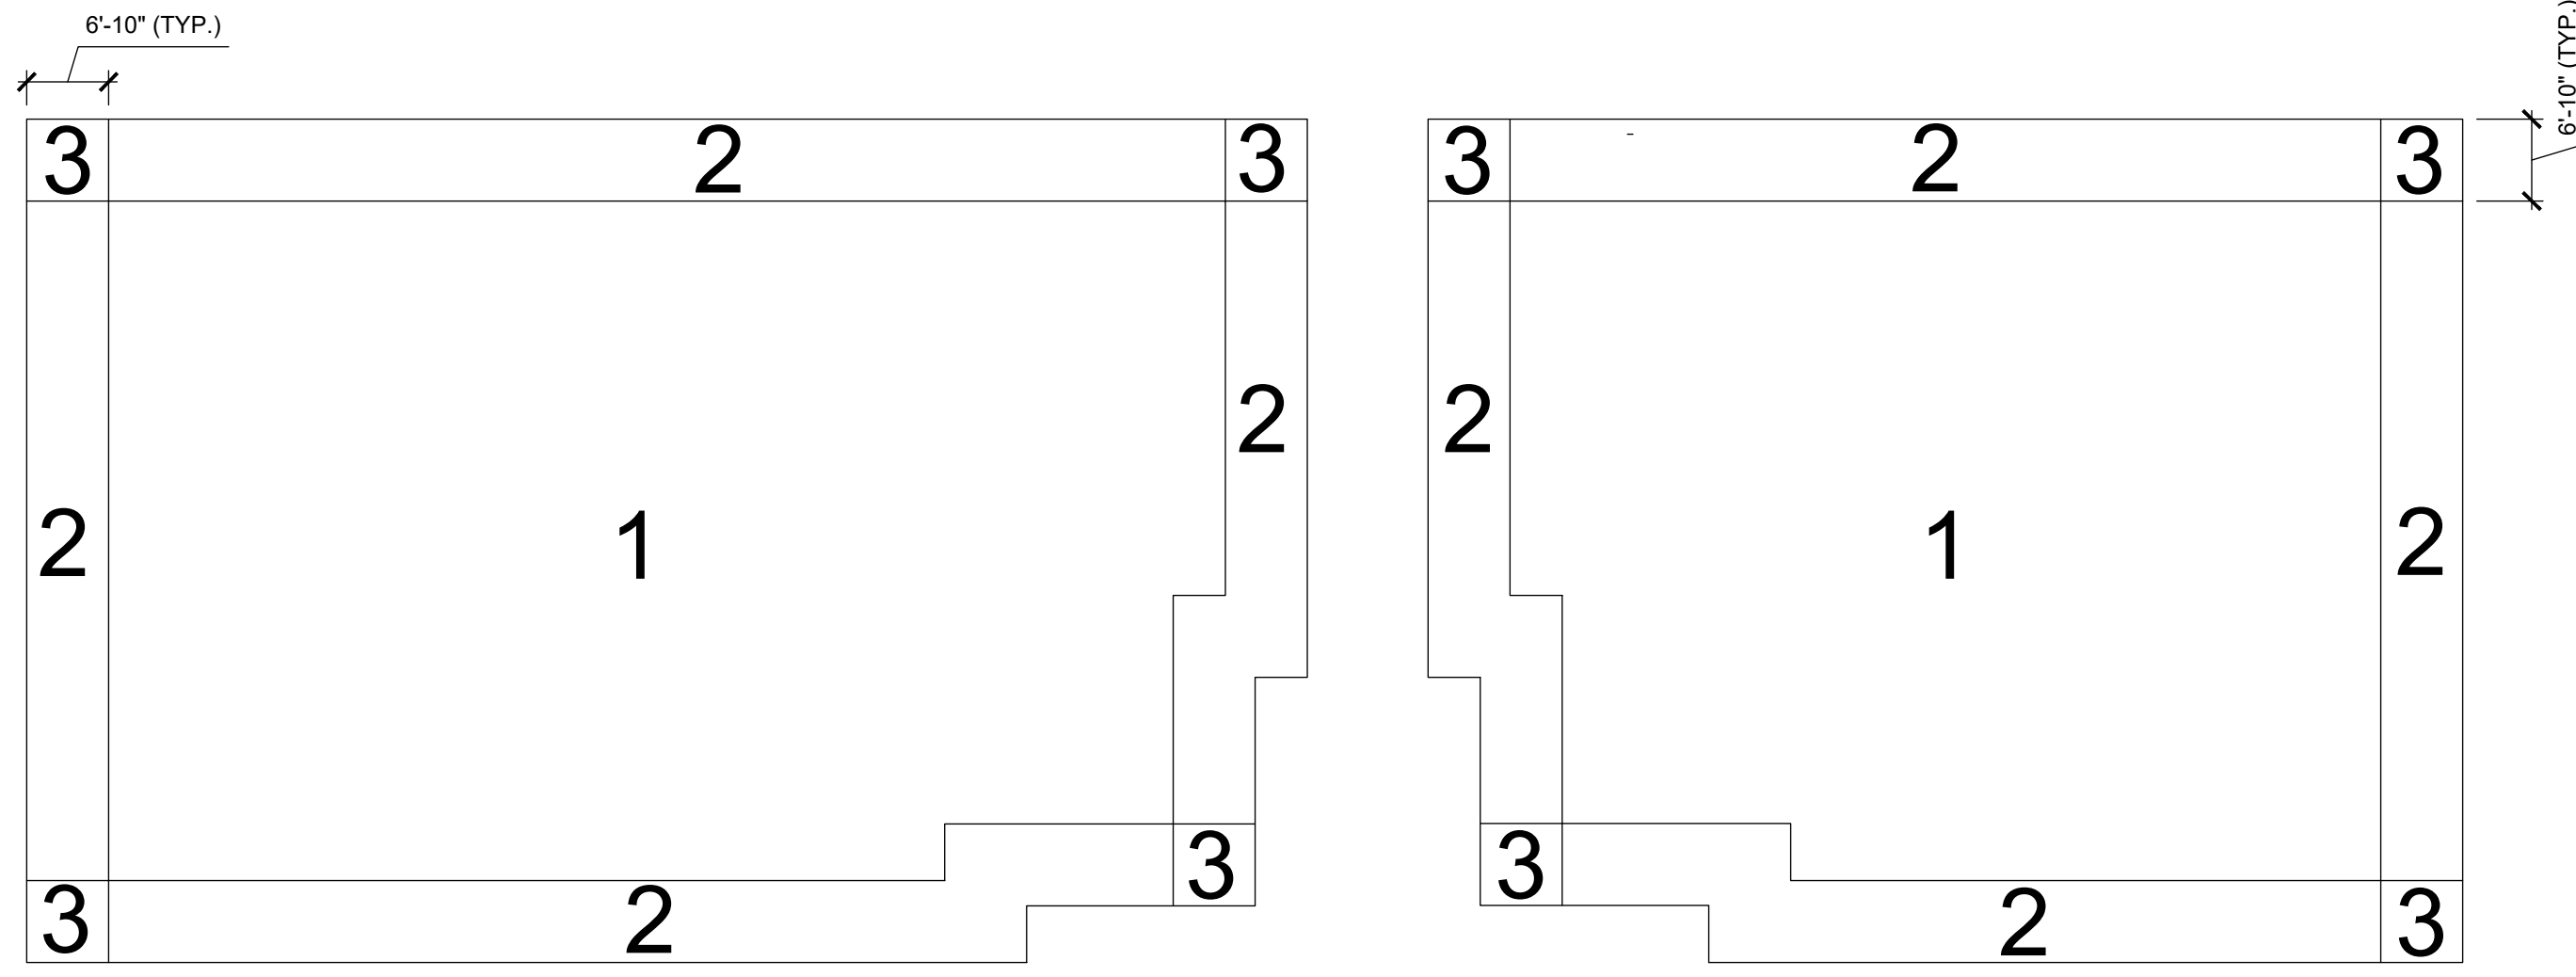

1 ROOF ULTIMATE UPLIFT DIAGRAM
S0.2 NTS

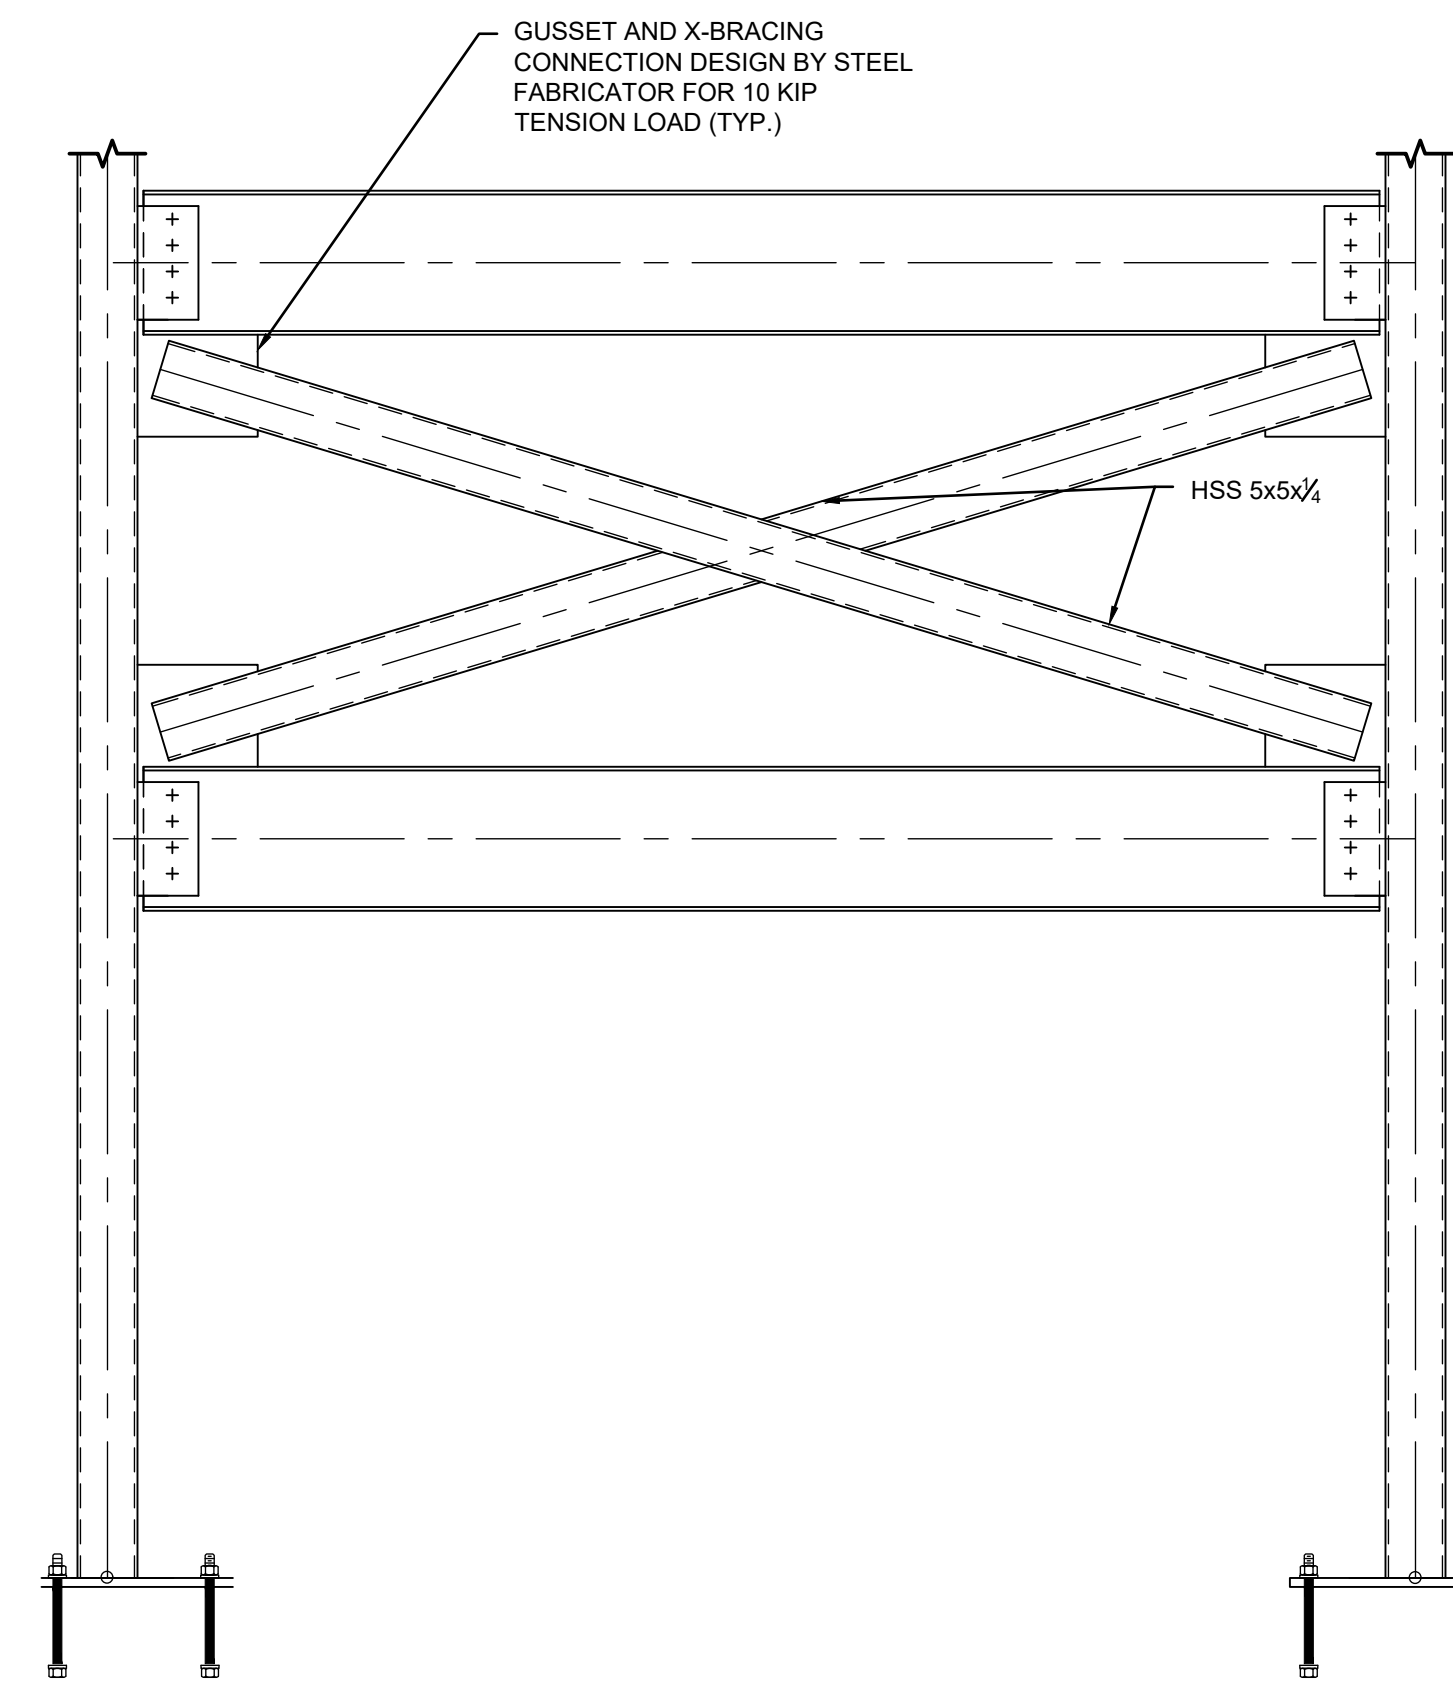


2 SECTION
S0.2
1'-4" 8" 0' 1'-4" 2'-8"
SCALE: 3/4" = 1'-0"

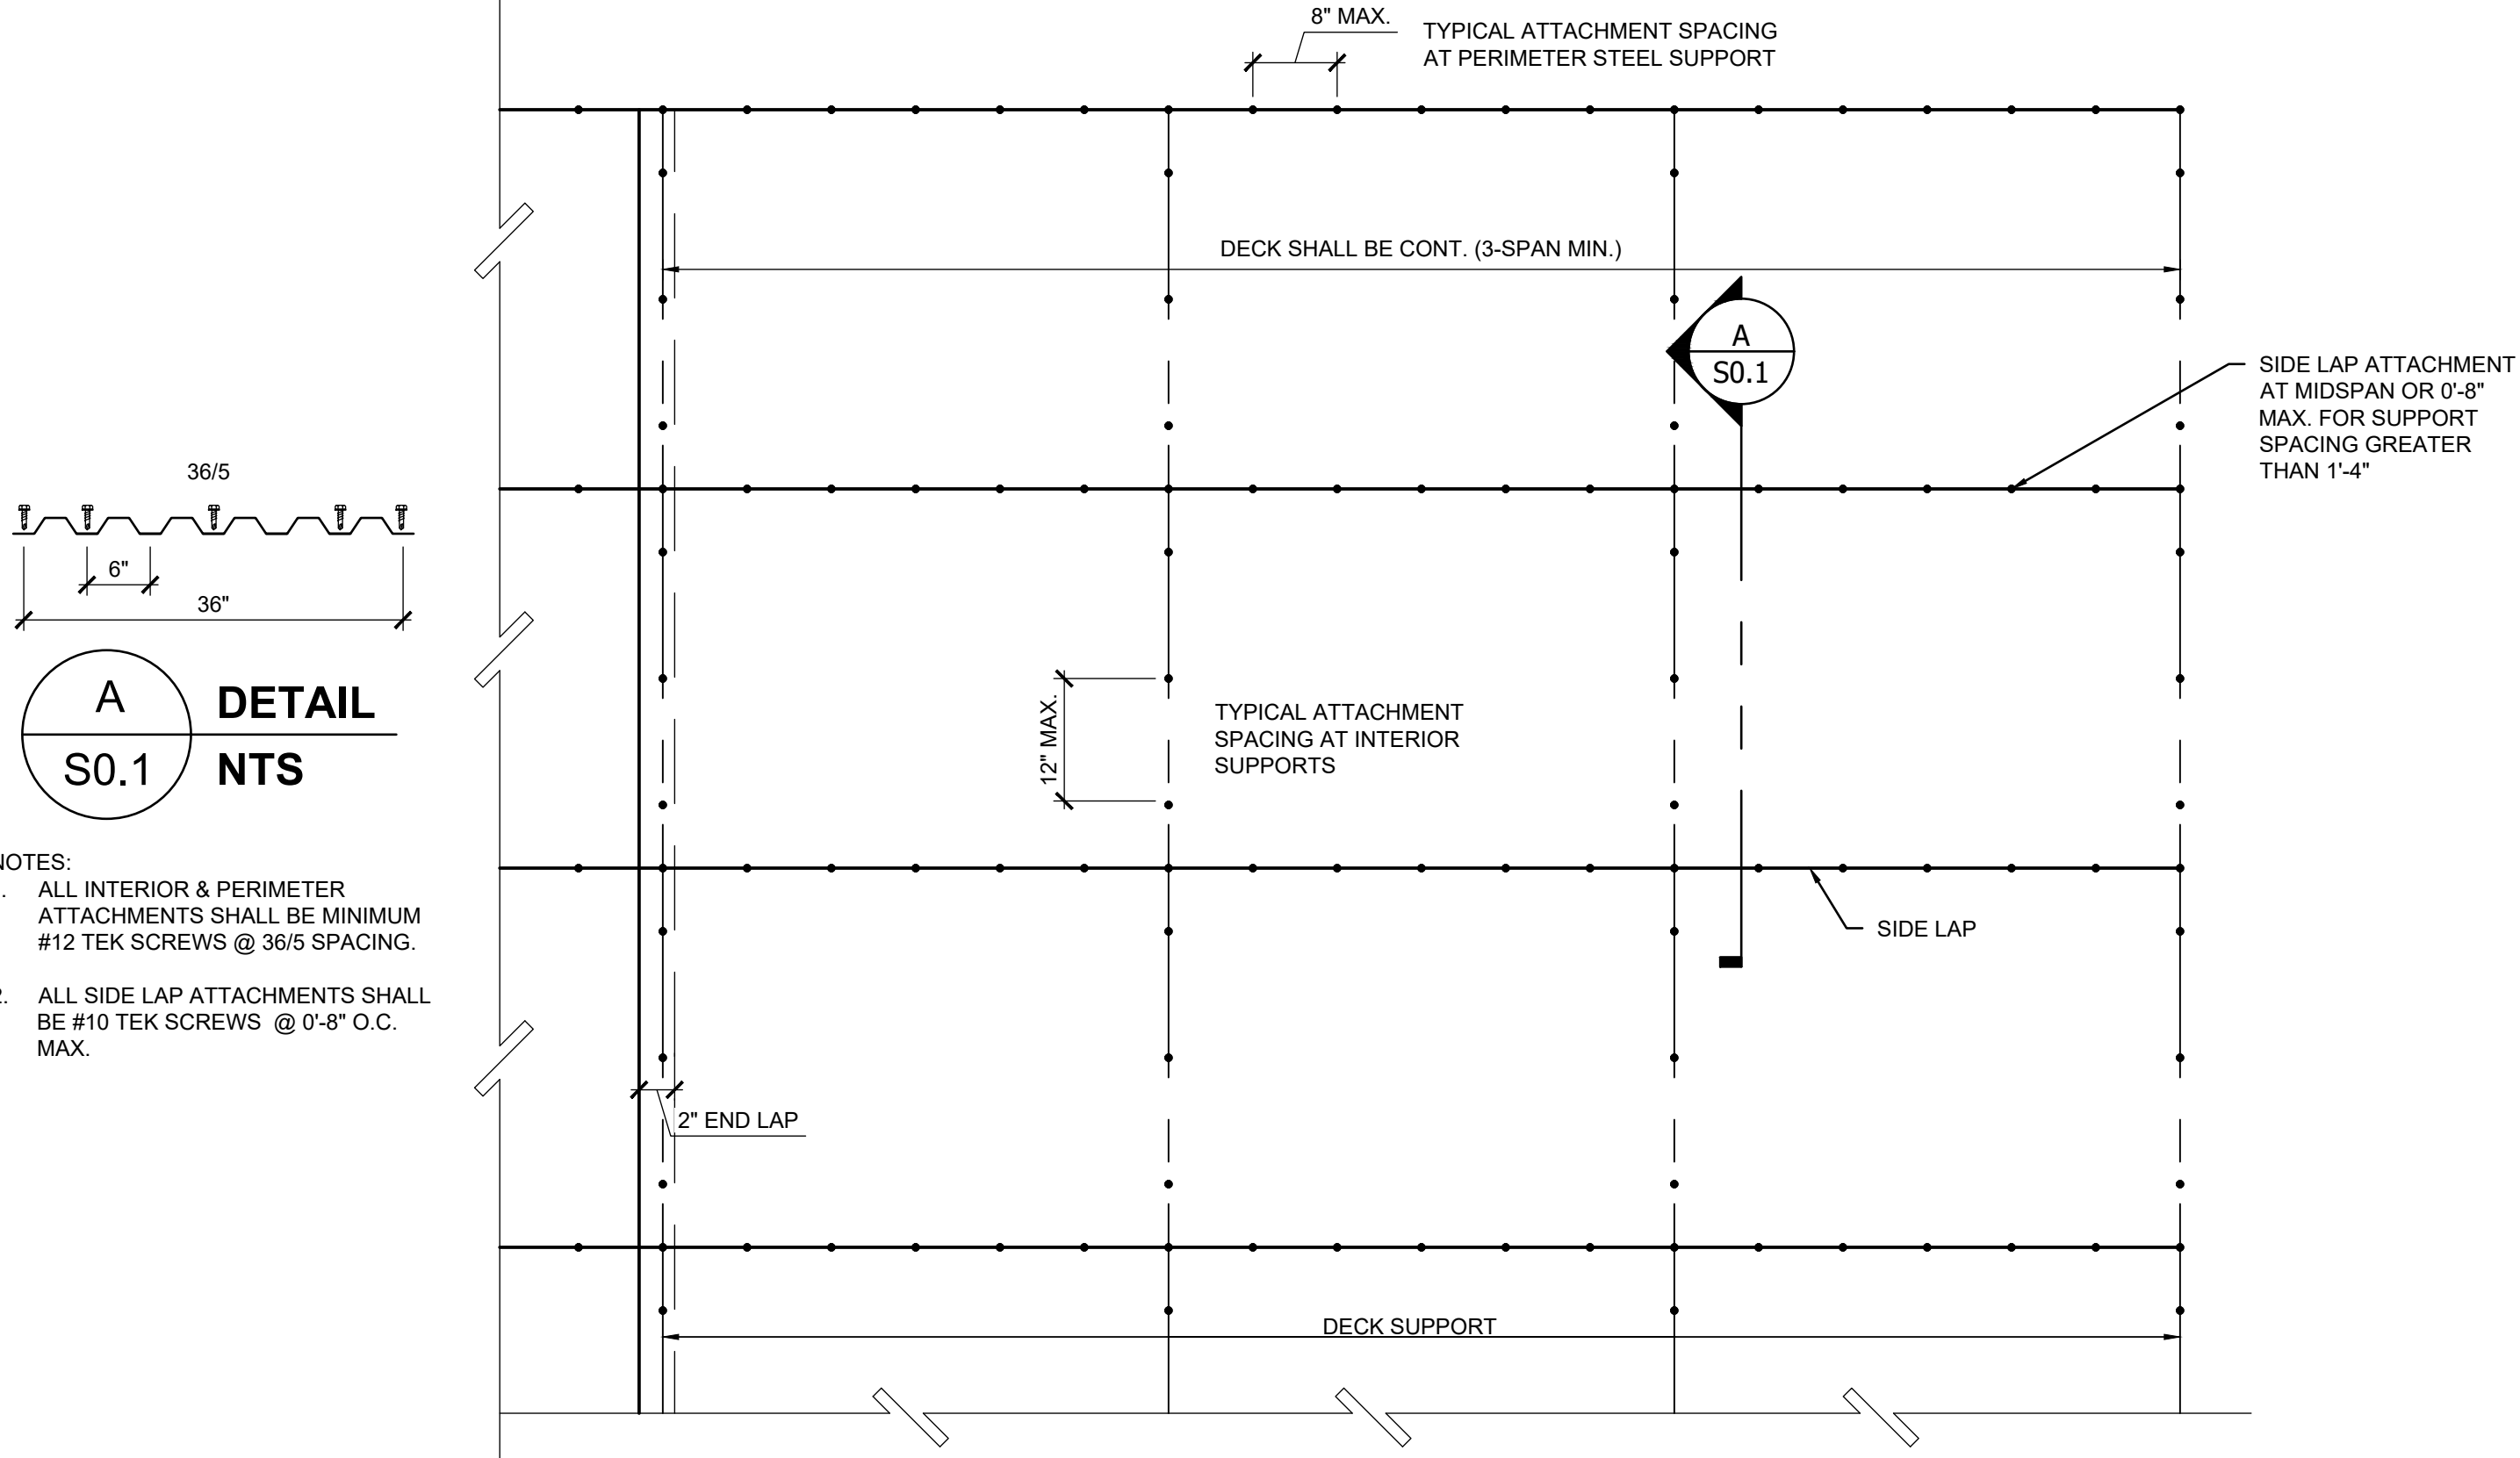

A DETAIL
S0.1 NTS

- NOTES:
 1. ALL INTERIOR & PERIMETER ATTACHMENTS SHALL BE MINIMUM #12 TEK SCREWS @ 36/5 SPACING.
 2. ALL SIDE LAP ATTACHMENTS SHALL BE #10 TEK SCREWS @ 0'-8" O.C. MAX.

3 TYPICAL METAL DECK ATTACHMENT
S0.2 NTS

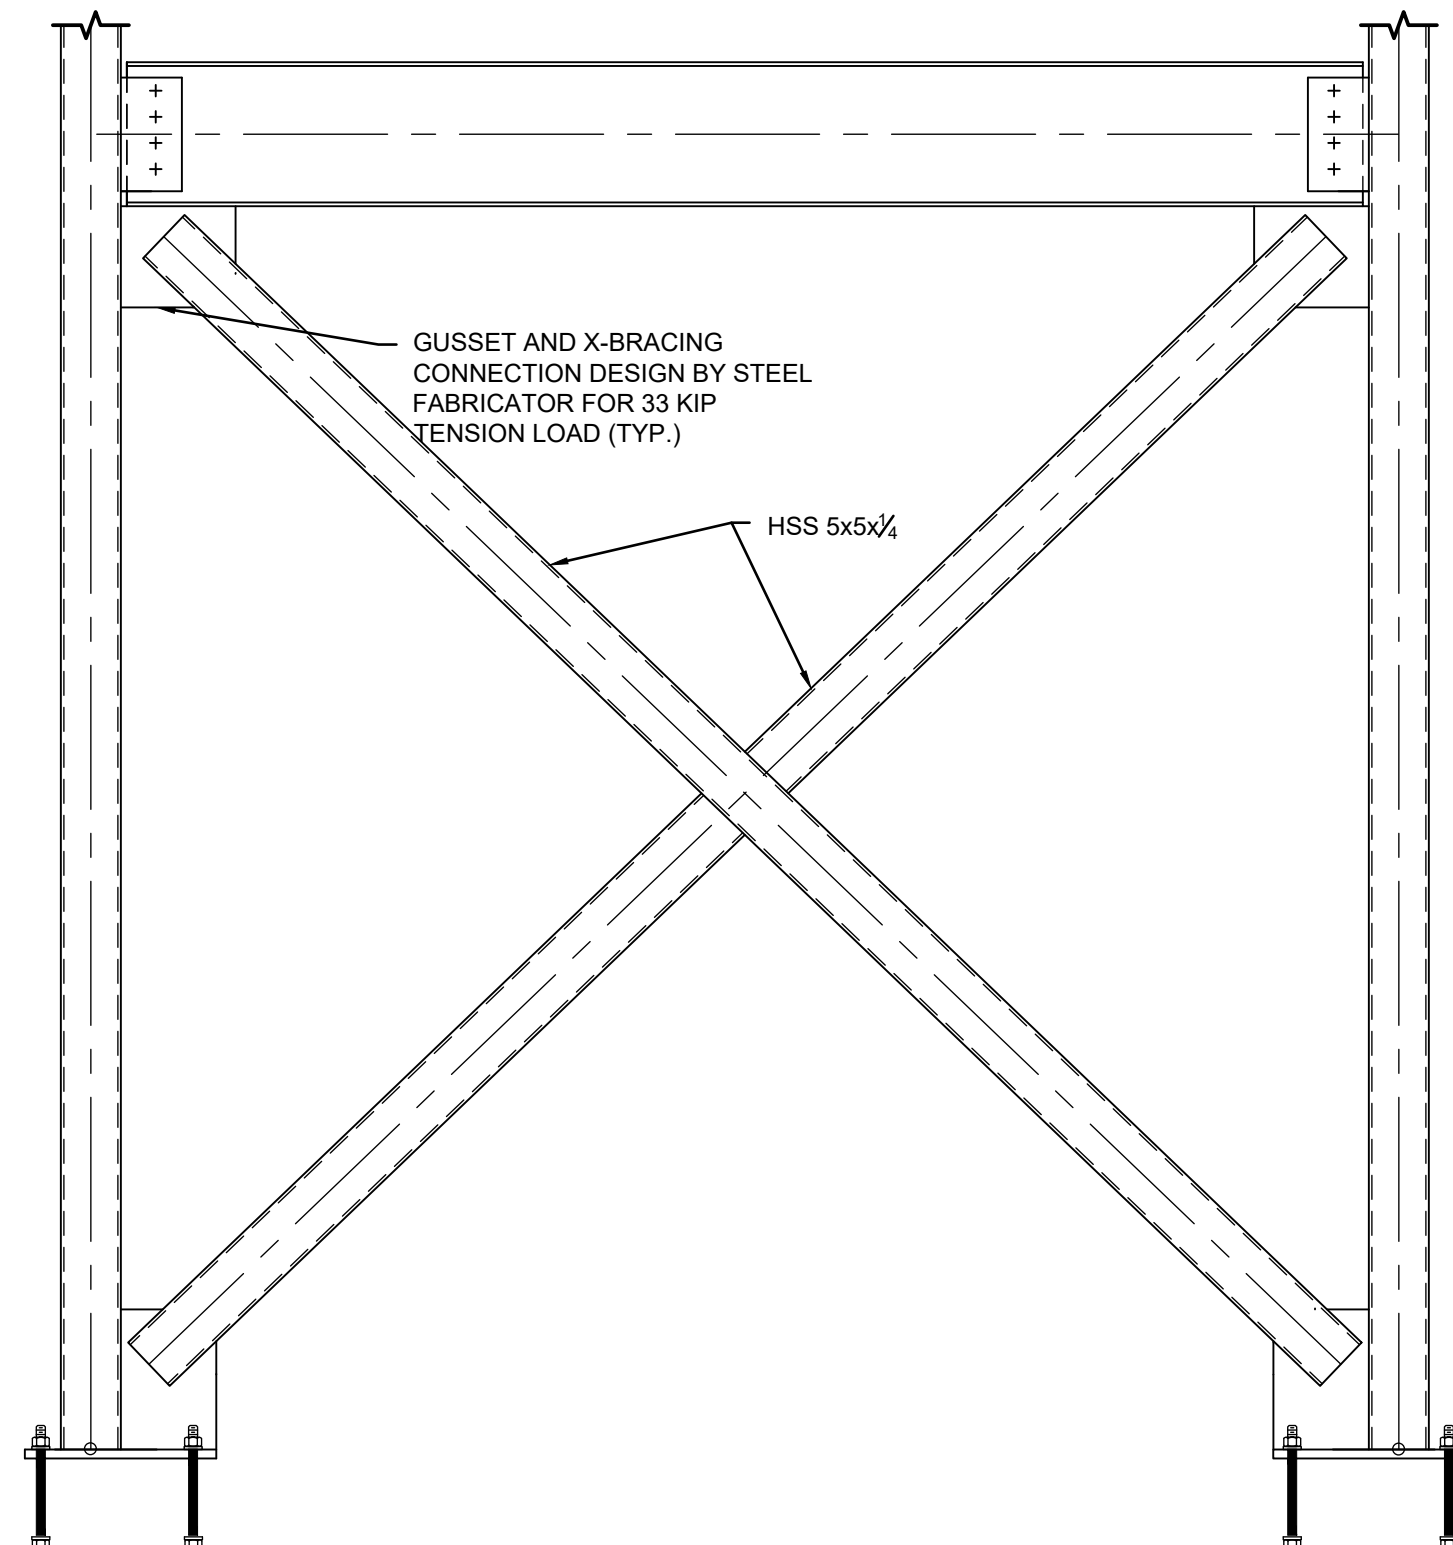

4 SECTION
S0.2
1'-4" 8" 0' 1'-4" 2'-8"
SCALE: 3/4" = 1'-0"


WD
WEATHERFORD & DAY
ENGINEERS, INC.

8150 OLD FEDERAL ROAD
MONTGOMERY, AL 36117
334.277.9550


GMC
AS-BUILT

ISSUE	DATE	REVISION
	04/23/2019	75% REVIEW
	05/30/2019	95% REVIEW
	10/17/2019	PERMIT

EXCHANGE AT HOMEPACE
PRATTVILLE, AL
GMC PROJECT#AMGM180037

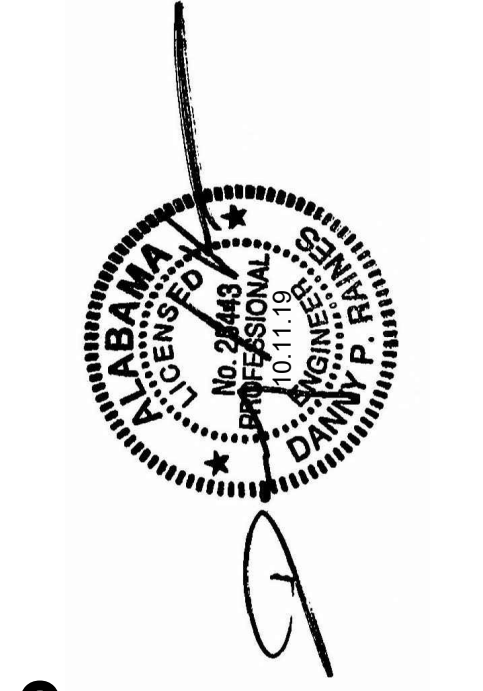

GENERAL NOTES AND TYPICAL SECTIONS
S0.2

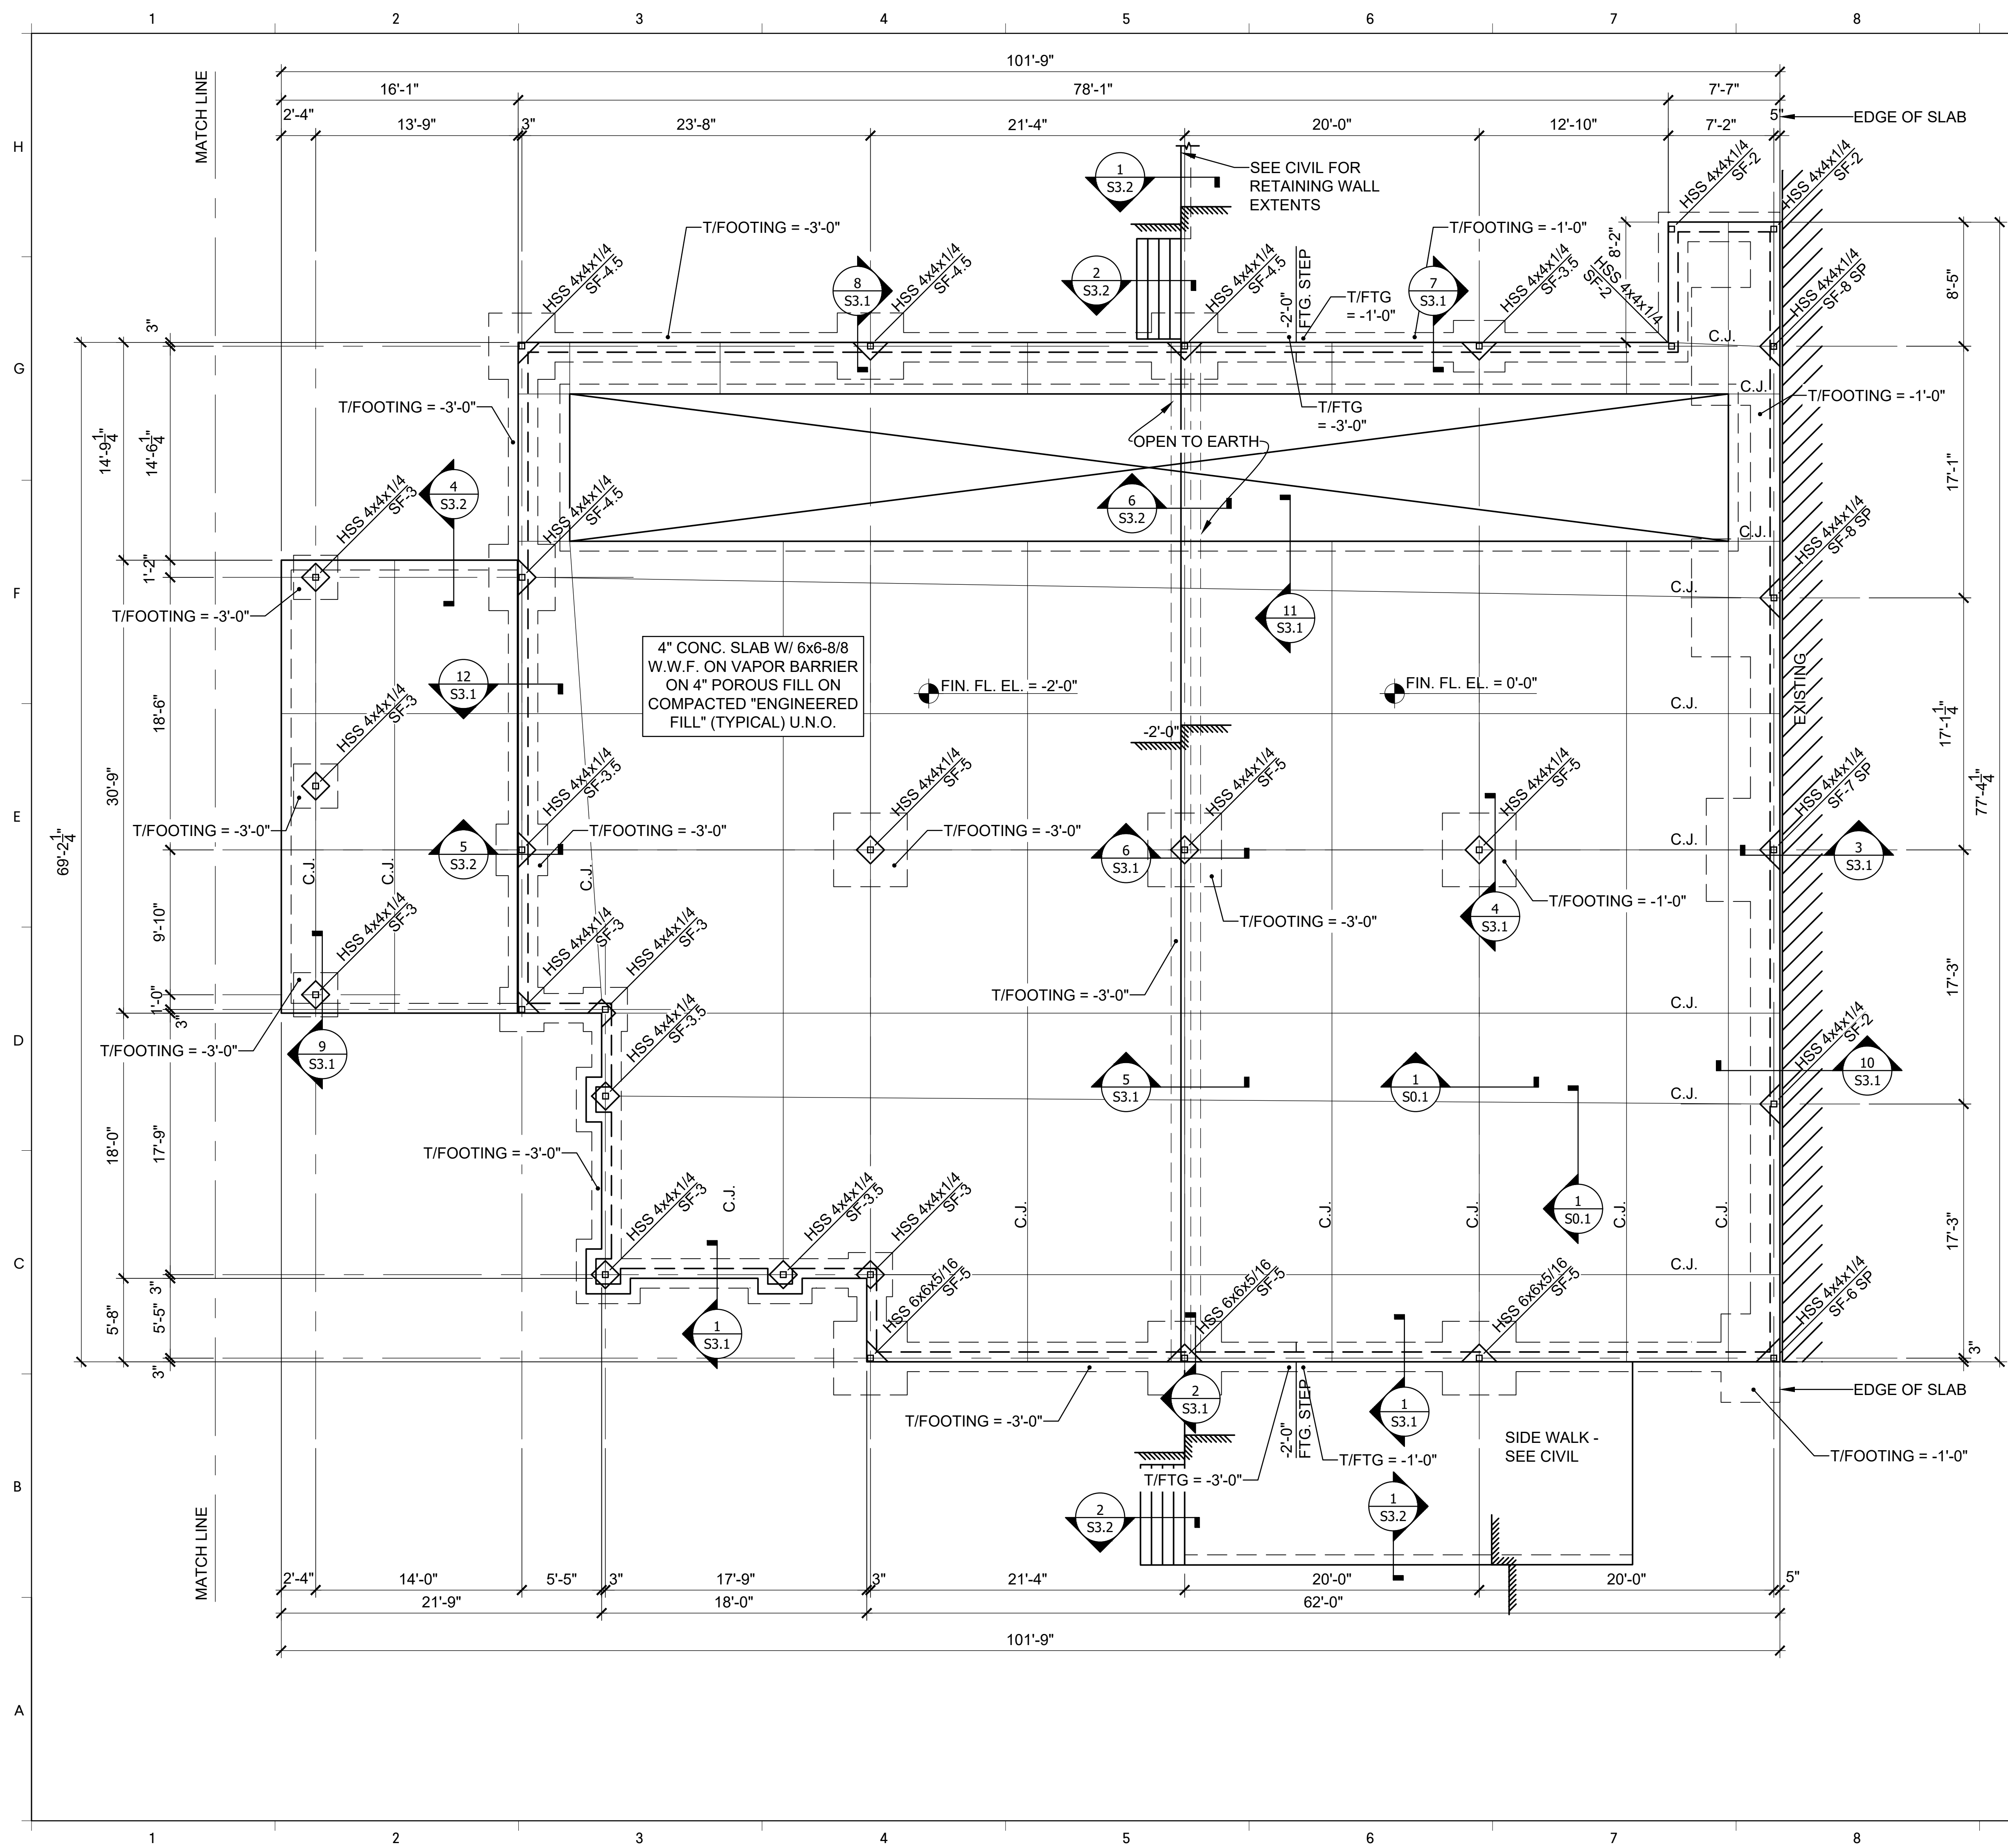



1 PART A FOUNDATION PLAN
 S1.1
 SCALE: 3/16" = 1'-0"

- NOTES:**
- 329.16 = REF. DAUTM 0'-0"
 - SEE S0.1/S0.2 FOR GENERAL NOTES AND TYPICAL SECTIONS.
 - SEE ARCH. FOR ALL DIMENSIONS NOT SHOWN
 - IT IS THE CONTRACTOR'S RESPONSIBILITY TO VERIFY AND COORDINATE ALL TOP OF FOOTING ELEVATIONS SHOWN ON DRAWINGS WITH FINAL GRADING PLAN. MINIMUM COVER FROM TOP OF FOOTING TO OUTSIDE FINISH GRADE SHALL BE 1'-0".
 - COORDINATE ALL SLOPES, STEPS, RECESSES, AND PLUMBING FIXTURES W/ CONTRACT DRAWINGS.
 - MASONRY WALLS ARE UNSTABLE AND REQUIRE TEMPORARY BRACING UNTIL PERMANENT CONNECTION IS INSTALLED. TEMPORARY MASONRY BRACING IS THE SOLE RESPONSIBILITY OF THE CONTRACTOR.
 - COORDINATE LOCATION AND EXTENTS OF RETAINING WALLS AND SIDEWALK STAIRS WITH CIVIL.

ISSUE	DATE
04/23/2019	75% REVIEW
05/20/2019	85% REVIEW
10/17/2019	PERMIT

EXCHANGE AT HOMEPAGE
 PRATTVILLE, AL
 GMC PROJECT#AMGM180037

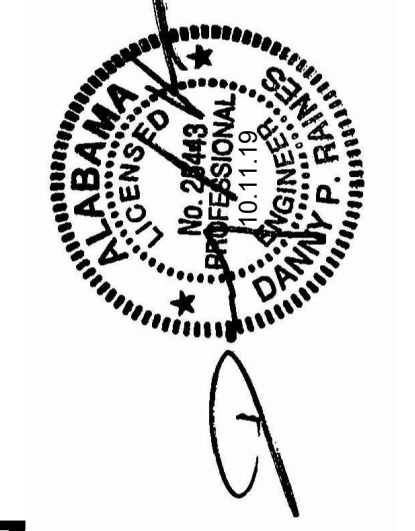

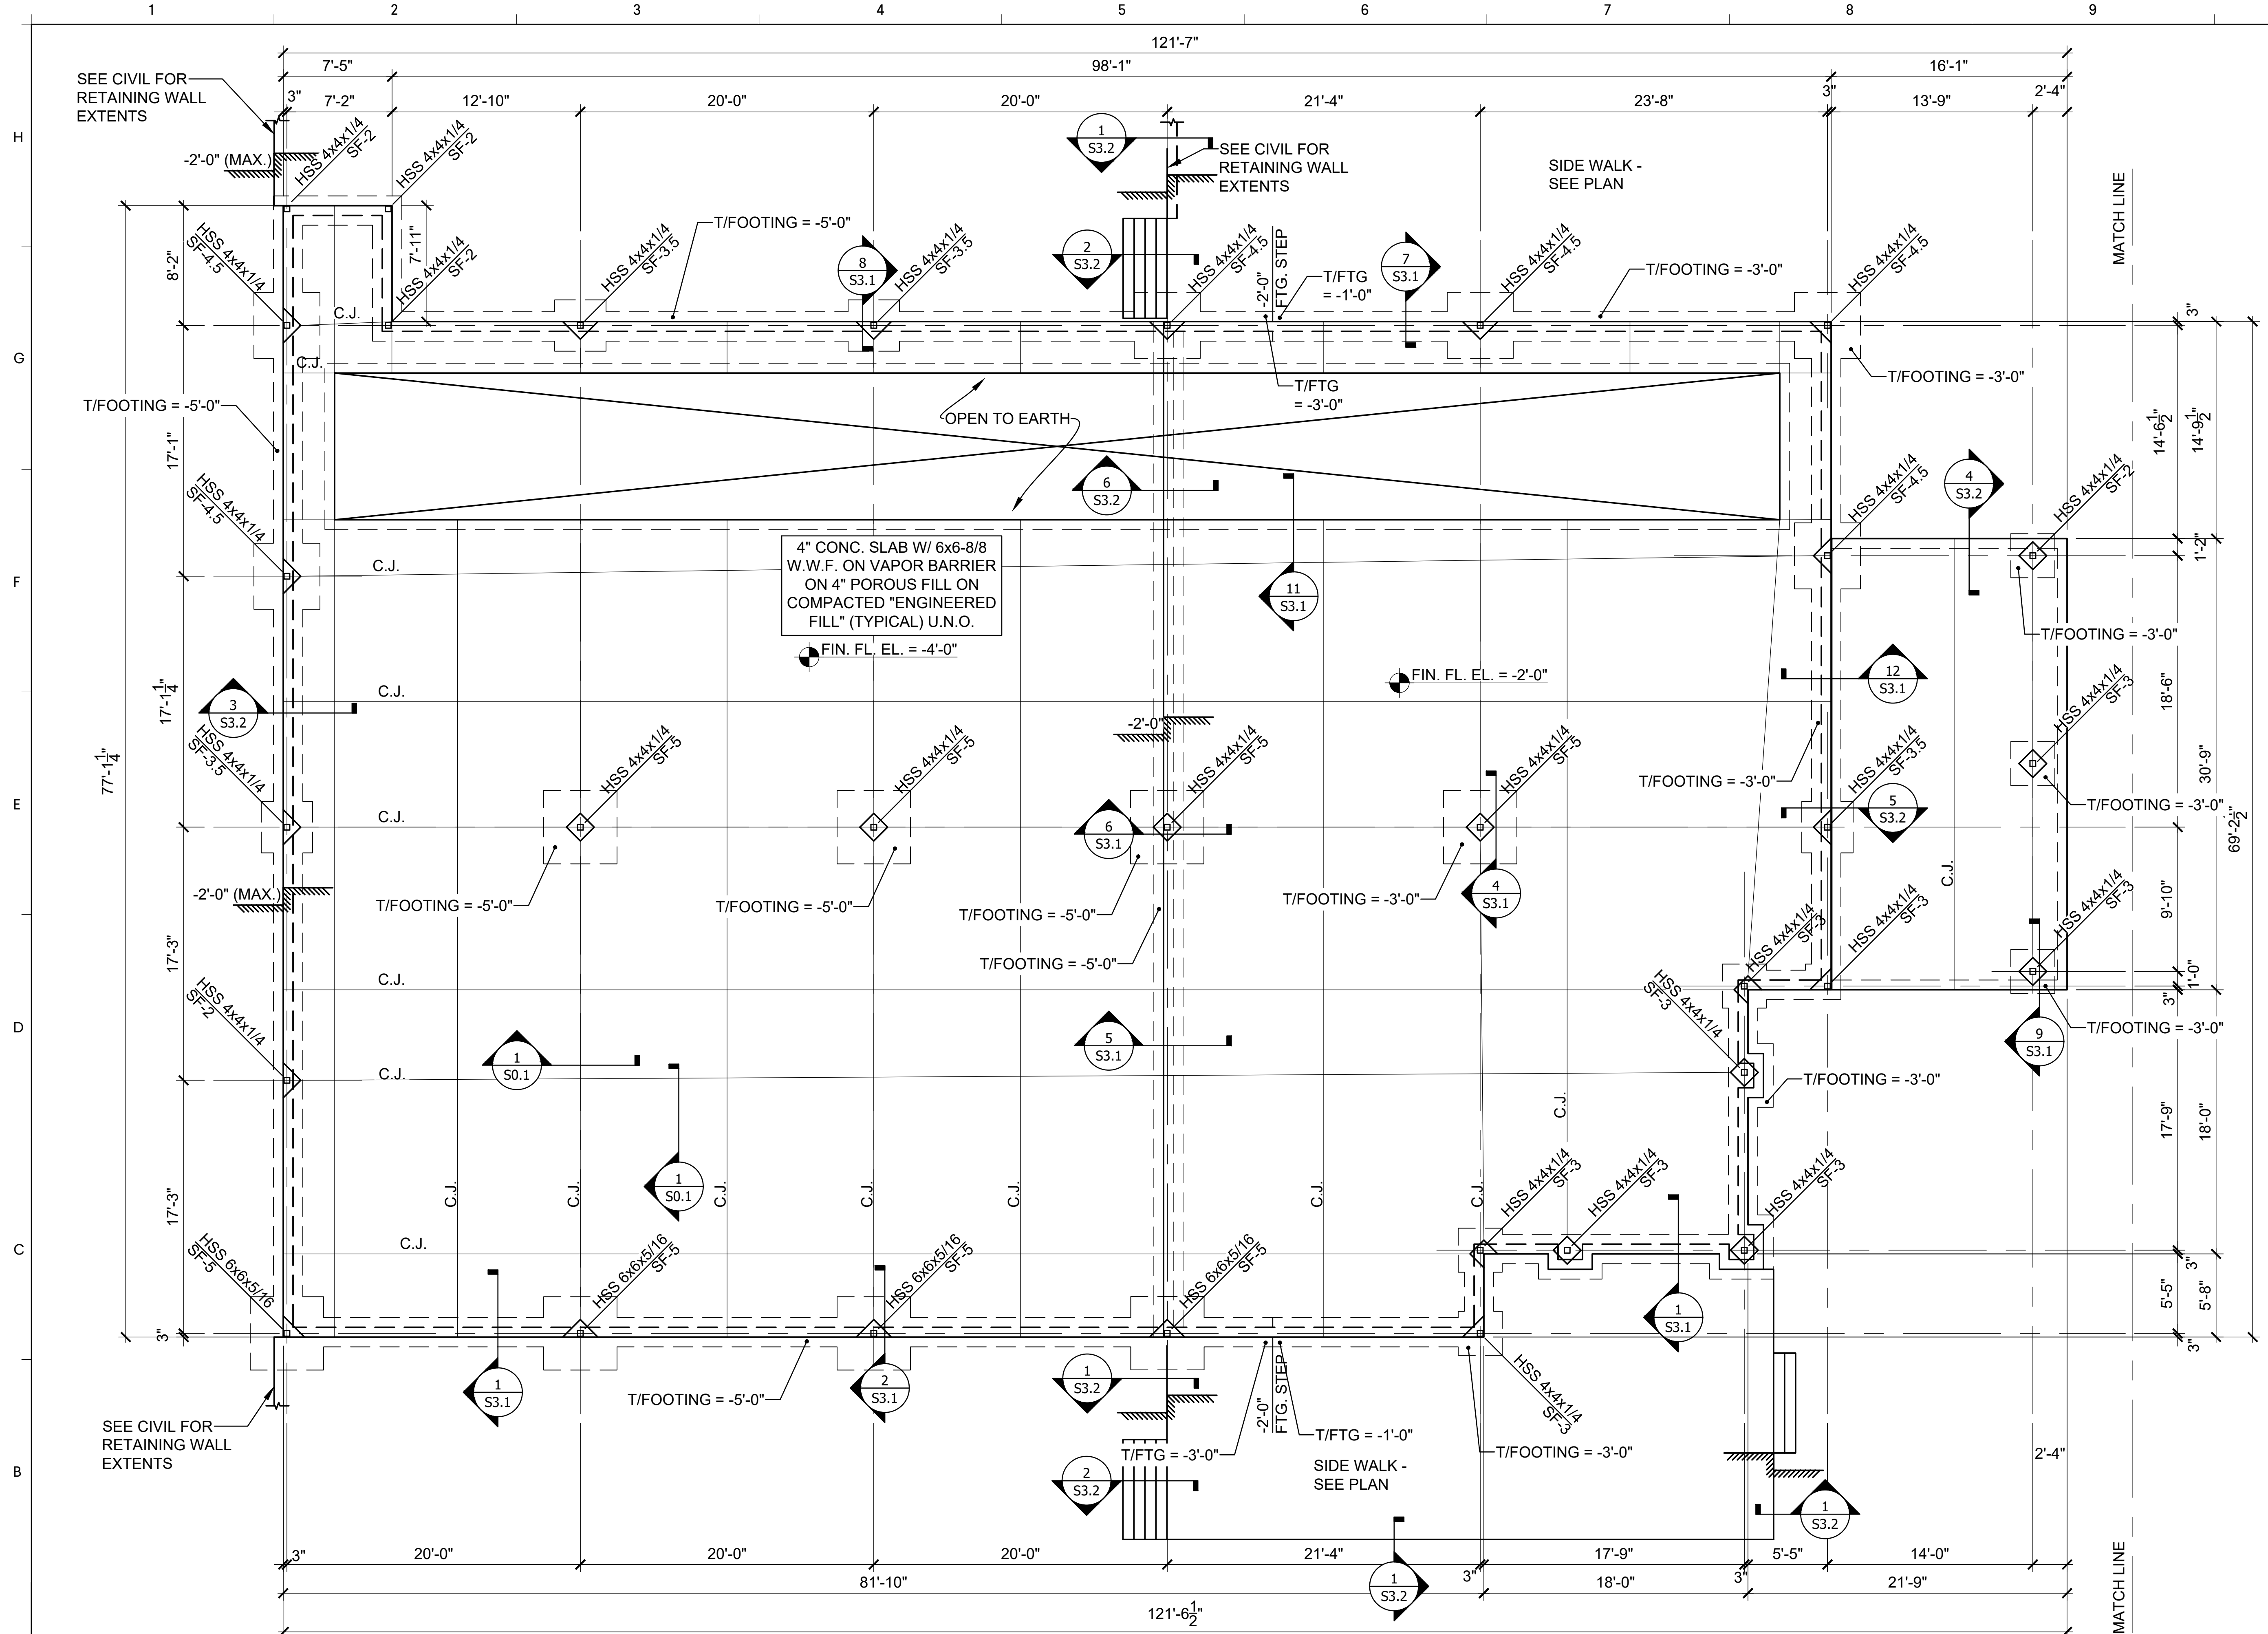


1
S1.2
PART B FOUNDATION PLAN
SCALE: 3/16" = 1'-0"

- NOTES:**
- 329.16 = REF. DAUTM 0'-0"
 - SEE S0.1 FOR GENERAL NOTES AND TYPICAL SECTIONS.
 - SEE ARCH. FOR ALL DIMENSIONS NOT SHOWN
 - IT IS THE CONTRACTOR'S RESPONSIBILITY TO VERIFY AND COORDINATE ALL TOP OF FOOTING ELEVATIONS SHOWN ON DRAWINGS WITH FINAL GRADING PLAN. MINIMUM COVER FROM TOP OF FOOTING TO OUTSIDE FINISH GRADE SHALL BE 1'-0".
 - COORDINATE ALL SLOPES, STEPS, RECESSES, AND PLUMBING FIXTURES W/ CONTRACT DRAWINGS.
 - MASONRY WALLS ARE UNSTABLE AND REQUIRE TEMPORARY BRACING UNTIL PERMANENT CONNECTION IS INSTALLED. TEMPORARY MASONRY BRACING IS THE SOLE RESPONSIBILITY OF THE CONTRACTOR.
 - COORDINATE LOCATION AND EXTENTS OF ALL RETAINING WALLS AND SIDEWALK STAIRS WITH CIVIL.

GMC
AS-BUILT


ISSUE	DATE
04/23/2019	75% REVIEW
05/02/2019	85% REVIEW
10/17/2019	PERMIT

EXCHANGE AT HOMEPLACE
PRATTVILLE, AL
GMC PROJECT#AMGM180037

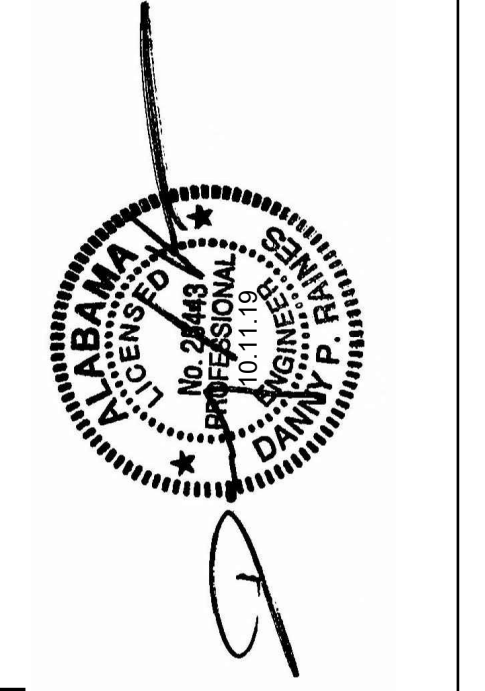

WD
WEATHERFORD & DAY
8150 OLD FEDERAL ROAD
MONTGOMERY, AL 36117
334.277.9550

PART B FOUNDATION PLAN
S1.2

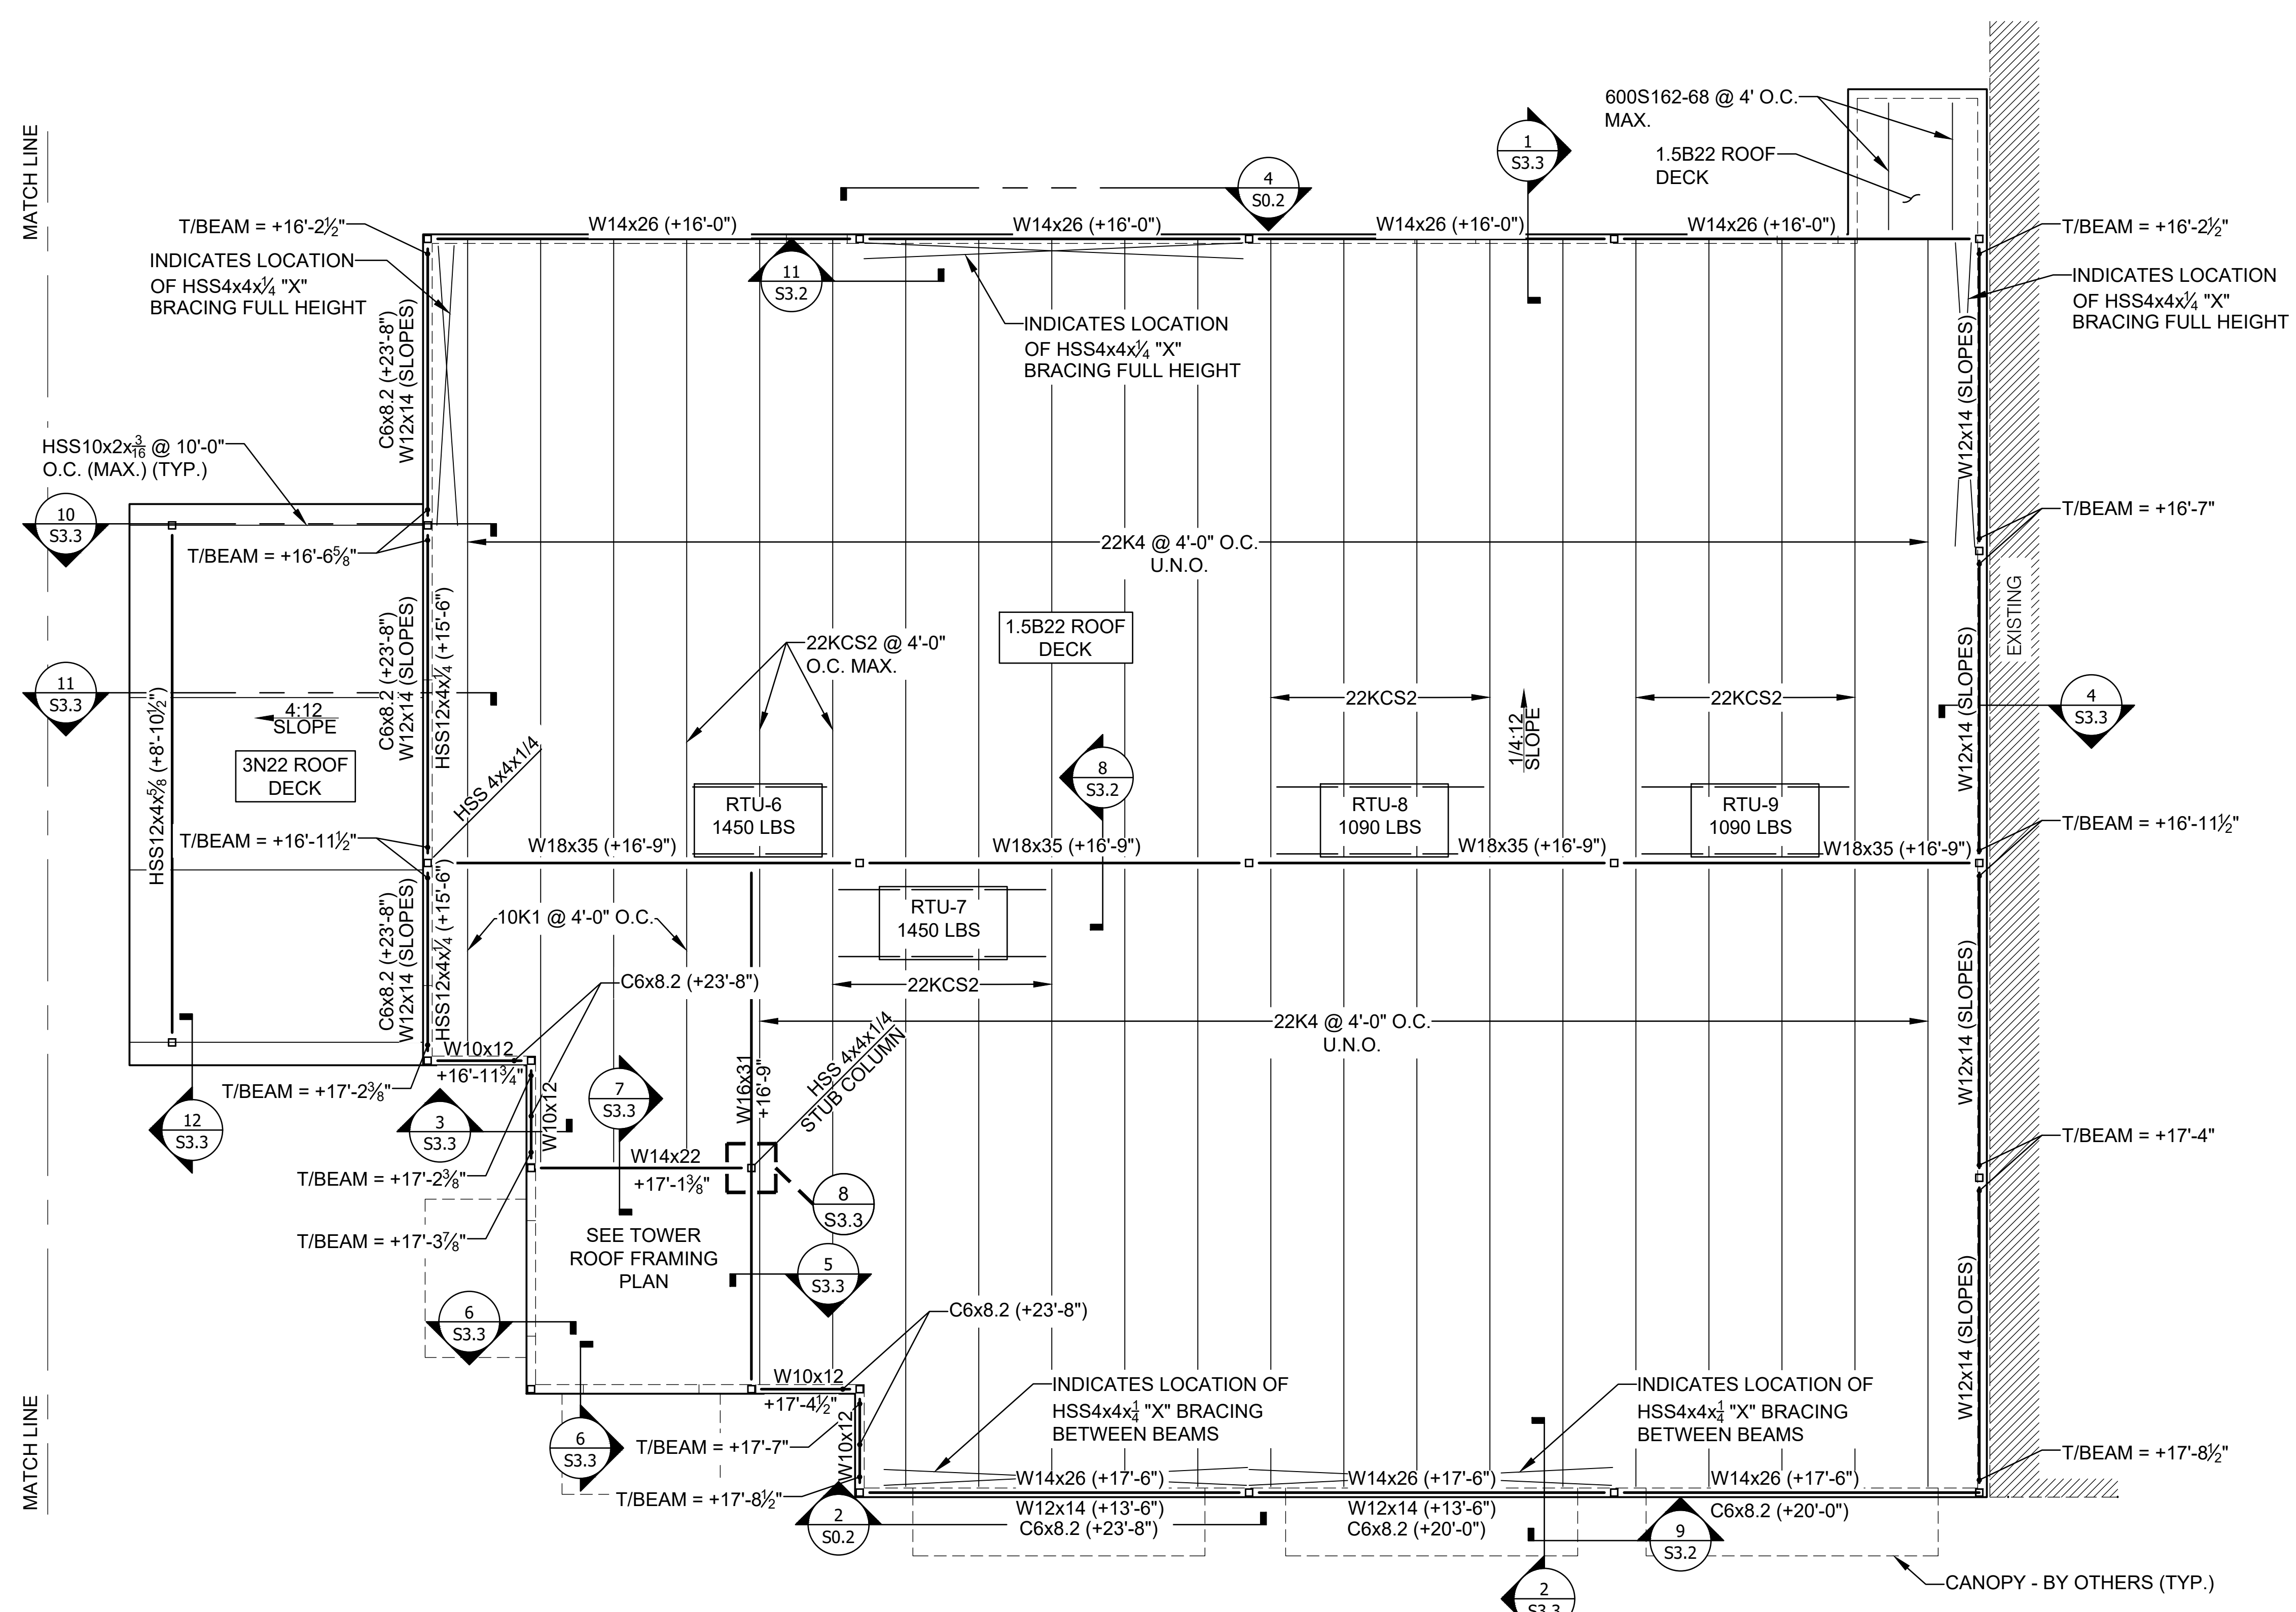

3 PART A ROOF FRAMING PLAN
 S1.3
 SCALE: 3/16" = 1'-0"


- NOTES:**
- 329.16 = REF. DAUTM 0'-0"
 - SEE S0.1 FOR GENERAL NOTES AND TYPICAL SECTIONS.
 - SEE ARCH. FOR ALL DIMENSIONS NOT SHOWN
 - SEE ARCH FOR PARAPET EXTENTS AND HEIGHT CHANGES

GMC
AS-BUILT

ISSUE	DATE
04/23/2019	75% REVIEW
05/30/2019	95% REVIEW
10/17/2019	PERMIT


DESIGNED BY: LGS
 DRAWN BY: LGS
 CHECKED BY: DPR

EXCHANGE AT HOMEPLACE
 PRATTVILLE, AL
 GMC PROJECT#AMGM180037

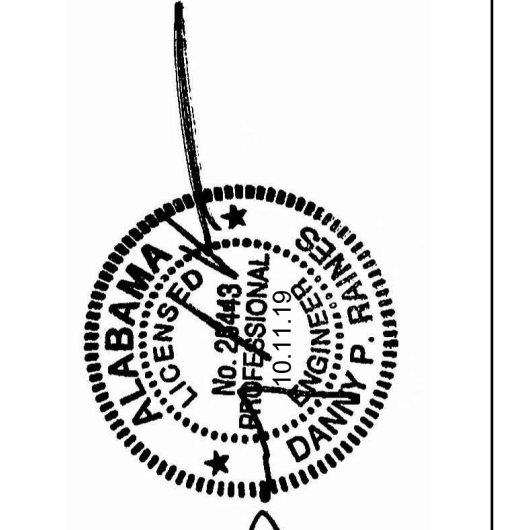

PART A ROOF FRAMING PLAN
S1.3

WD
 WEATHERFORD & DAY
 8150 OLD FEDERAL ROAD
 MONTGOMERY, AL 36117
 334.277.9550

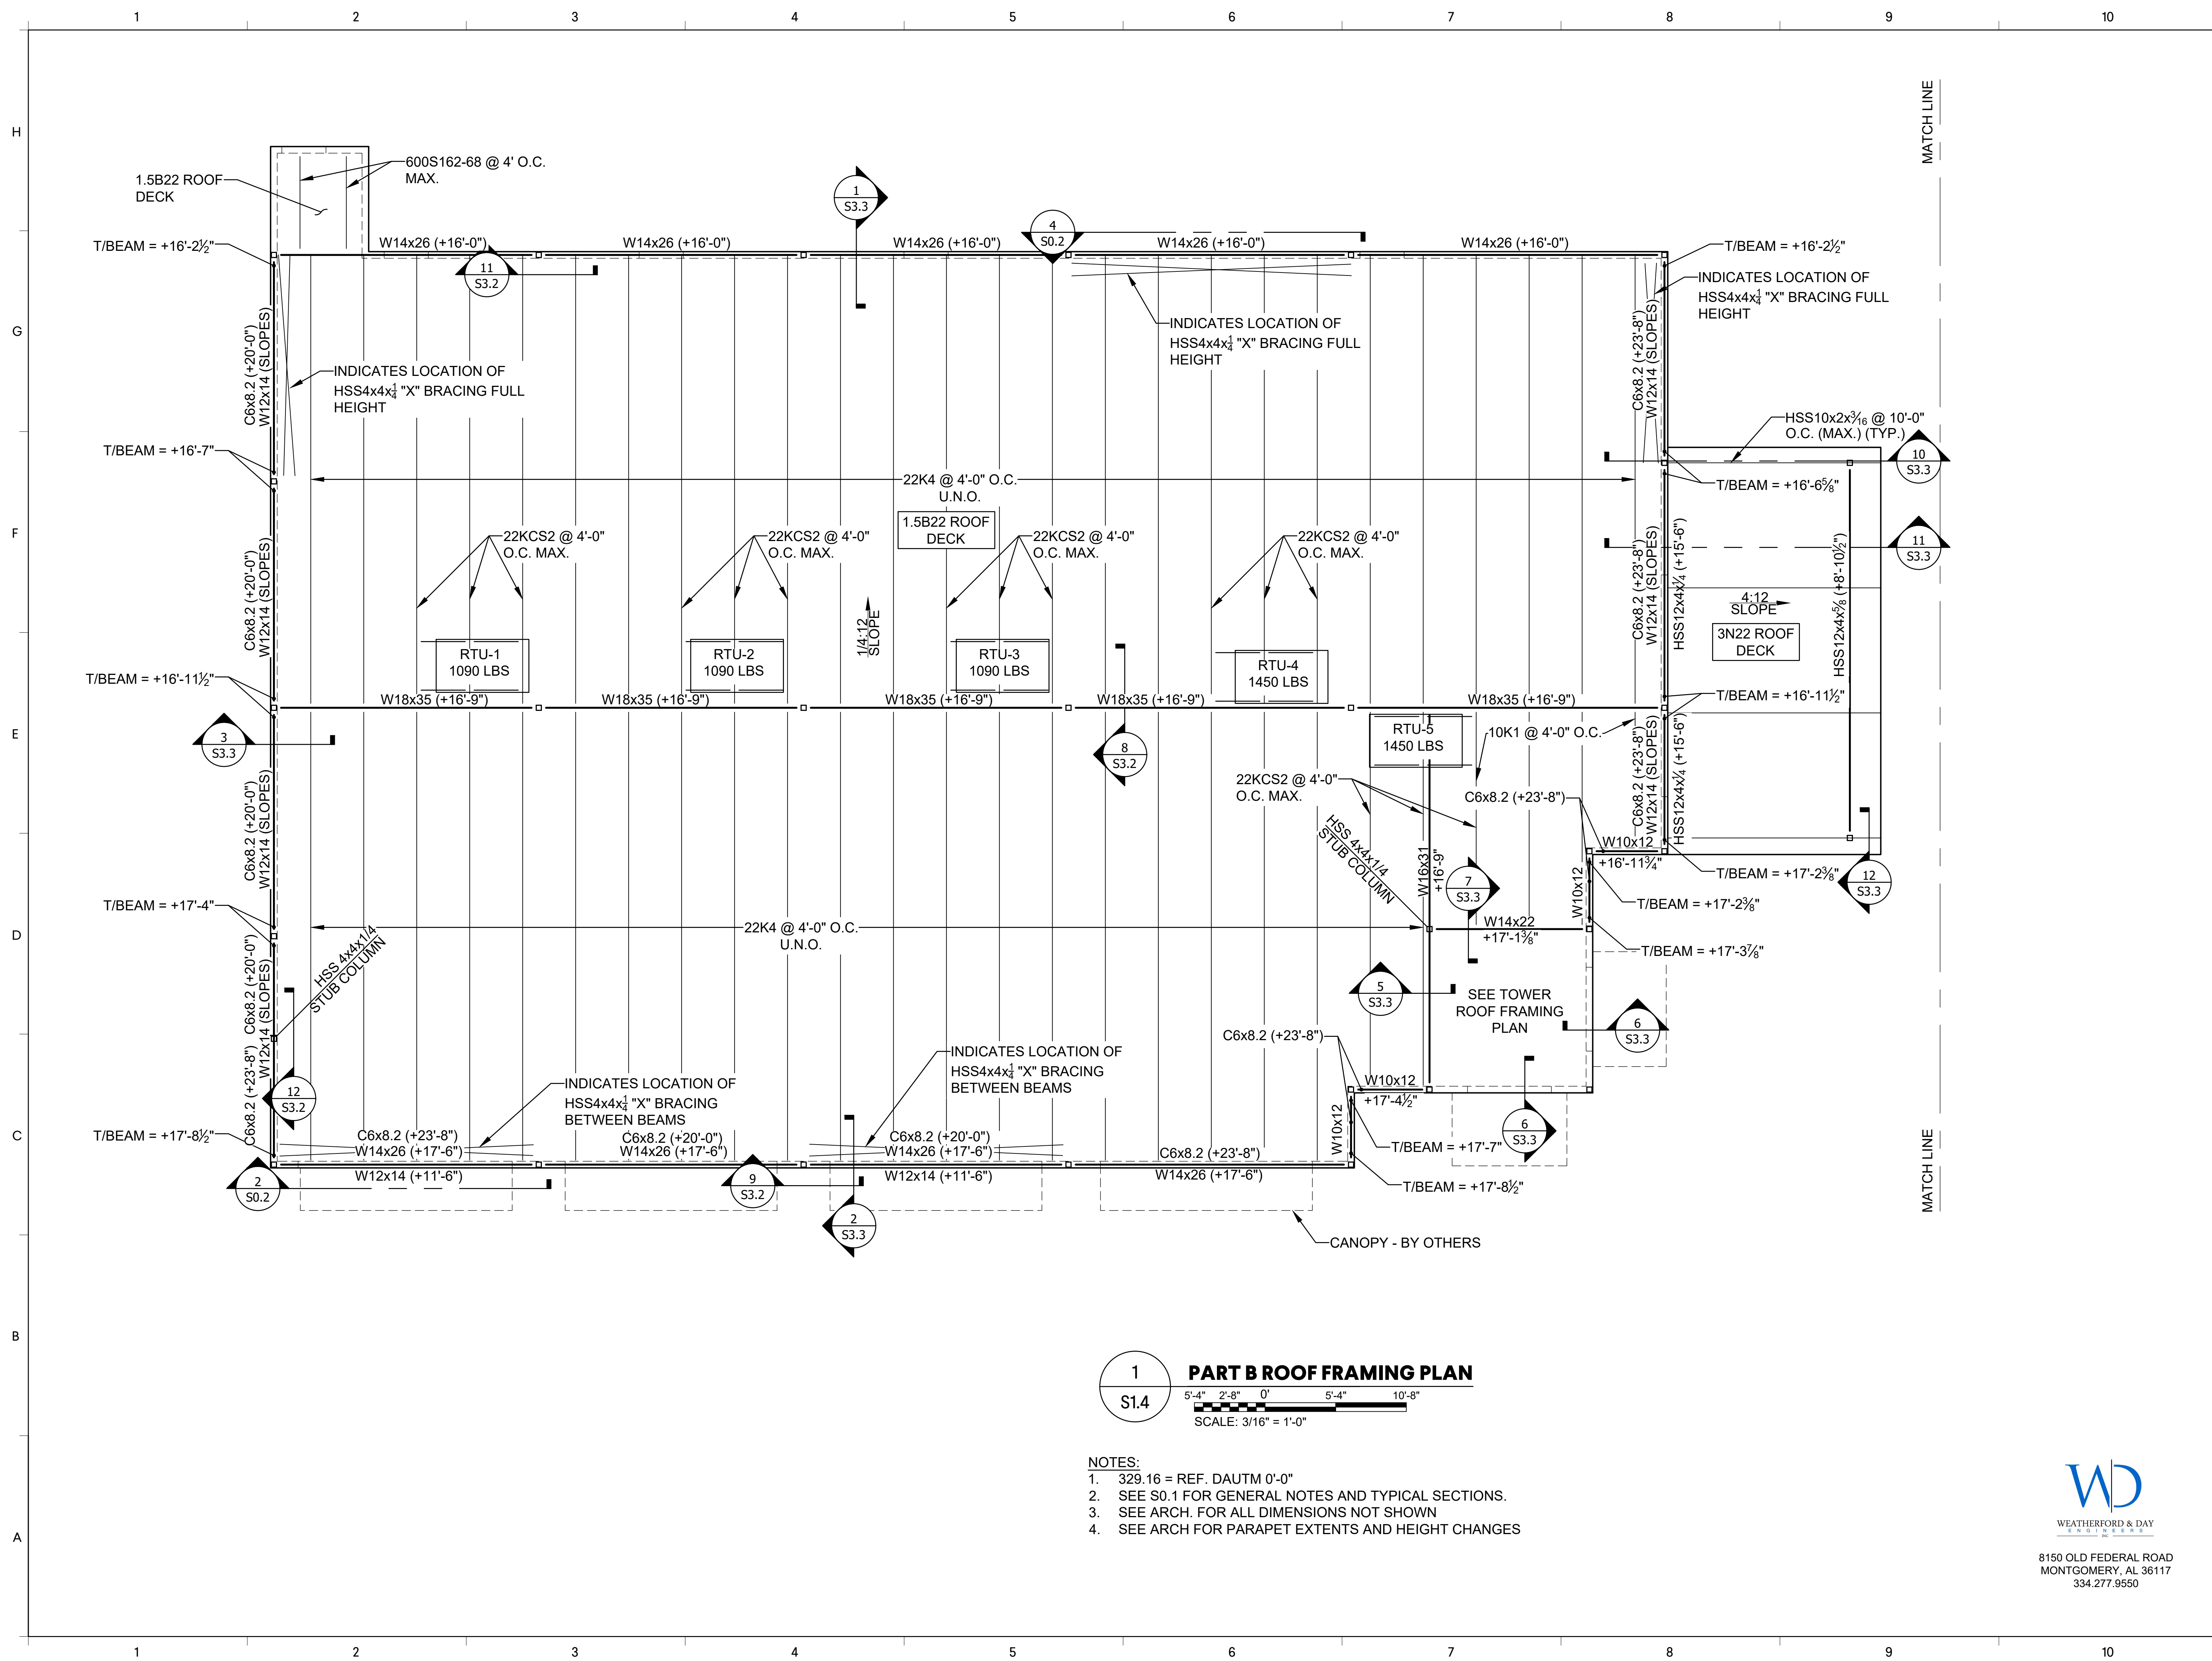

1 PART B ROOF FRAMING PLAN
 S1.4
 SCALE: 3/16" = 1'-0"

- NOTES:**
- 329.16 = REF. DAUTM 0'-0"
 - SEE S0.1 FOR GENERAL NOTES AND TYPICAL SECTIONS.
 - SEE ARCH. FOR ALL DIMENSIONS NOT SHOWN
 - SEE ARCH FOR PARAPET EXTENTS AND HEIGHT CHANGES




GMC
AS-BUILT


ISSUE	DATE	75% REVIEW	85% REVIEW	PERMIT
	04/23/2019			
	05/20/2019			
	10/17/2019			

DESIGNED BY: LGS
 DRAWN BY: LGS
 CHECKED BY: DPR

EXCHANGE AT HOMEPLACE
 PRATTVILLE, AL
 GMC PROJECT#AMGM180037

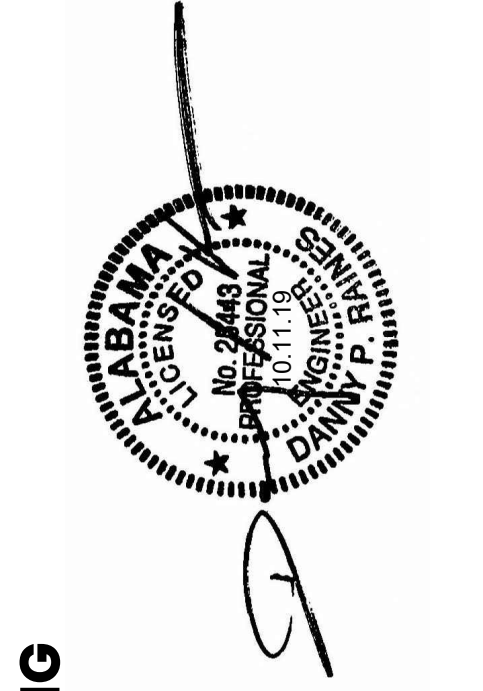


PART B ROOF FRAMING PLAN
S1.4

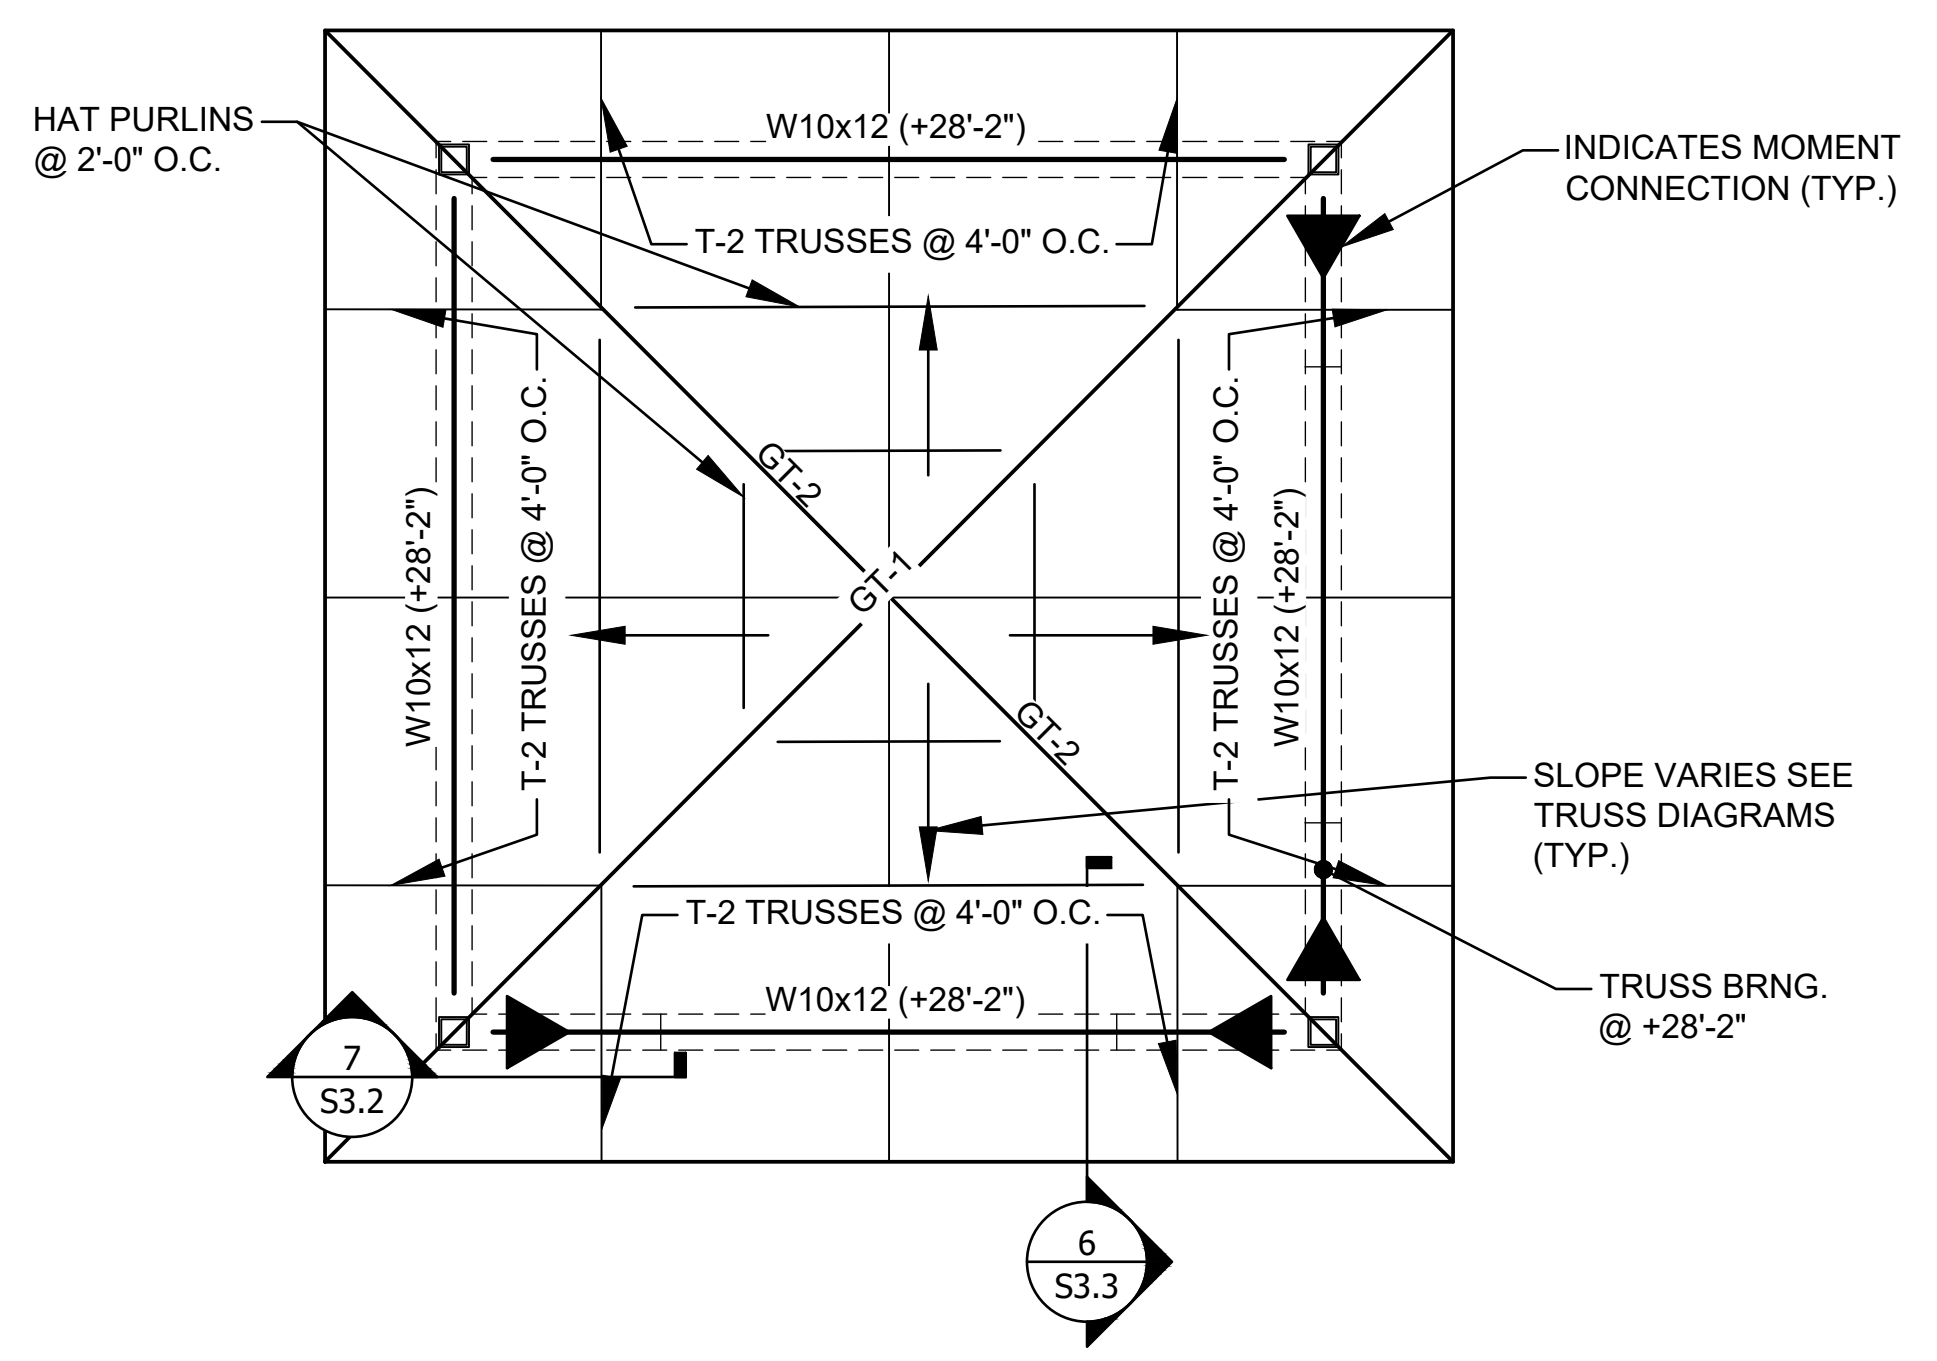

1
S1.5 **PART B TOWER ROOF FRAMING PLAN**
SCALE: 3/8" = 1'-0"


- NOTES:
 1. 329.16 = REF. DAUTM 0'-0"
 2. SEE S0.1/S0.2 FOR GENERAL NOTES AND TYPICAL SECTIONS.
 3. SEE ARCH. FOR ALL DIMENSIONS NOT SHOWN

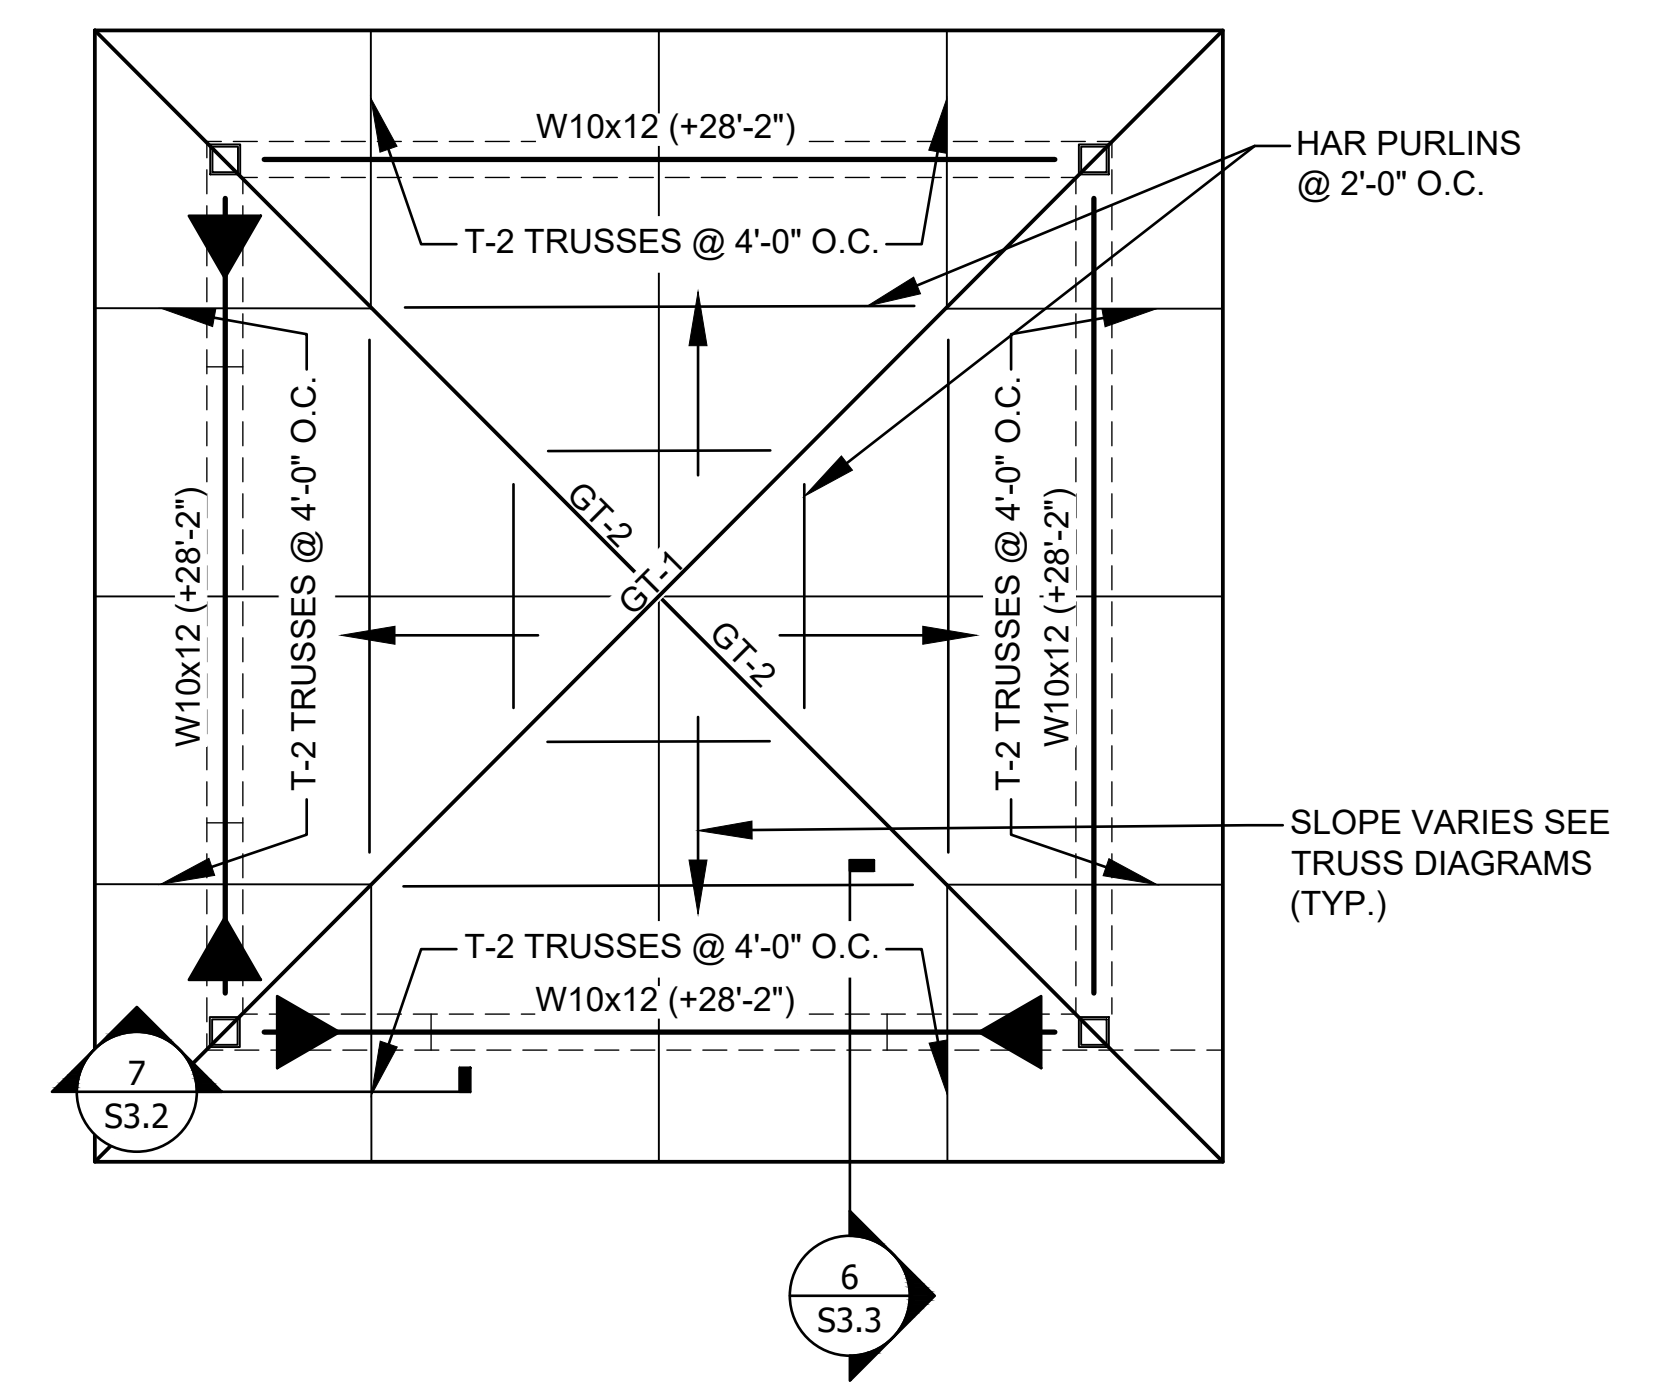

2
S1.5 **PART A TOWER ROOF FRAMING PLAN**
SCALE: 3/8" = 1'-0"

- NOTES:
 1. 329.16 = REF. DAUTM 0'-0"
 2. SEE S0.1/S0.2 FOR GENERAL NOTES AND TYPICAL SECTIONS.
 3. SEE ARCH. FOR ALL DIMENSIONS NOT SHOWN

WD
 WEATHERFORD & DAY
 ENGINEERS
 8150 OLD FEDERAL ROAD
 MONTGOMERY, AL 36117
 334.277.9550

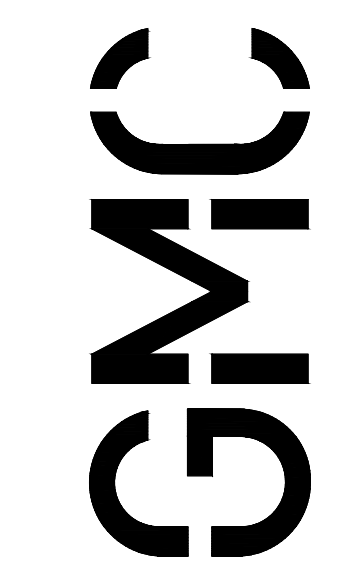


AS-BUILT

ISSUE	DATE
75% REVIEW	04/23/2019
85% REVIEW	05/20/2019
PERMIT	10/17/2019
DESIGNED BY:	LGS
DRAWN BY:	LGS
CHECKED BY:	DPR


EXCHANGE AT HOMEPLACE
 PRATTVILLE, AL

GMC PROJECT#AMGM180037

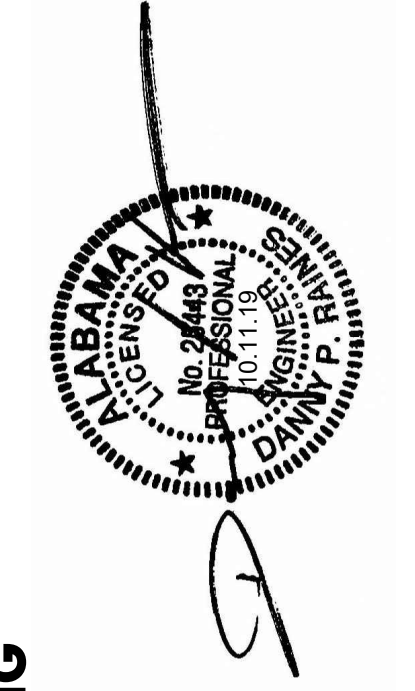

PART B ROOF FRAMING PLAN

S1.5

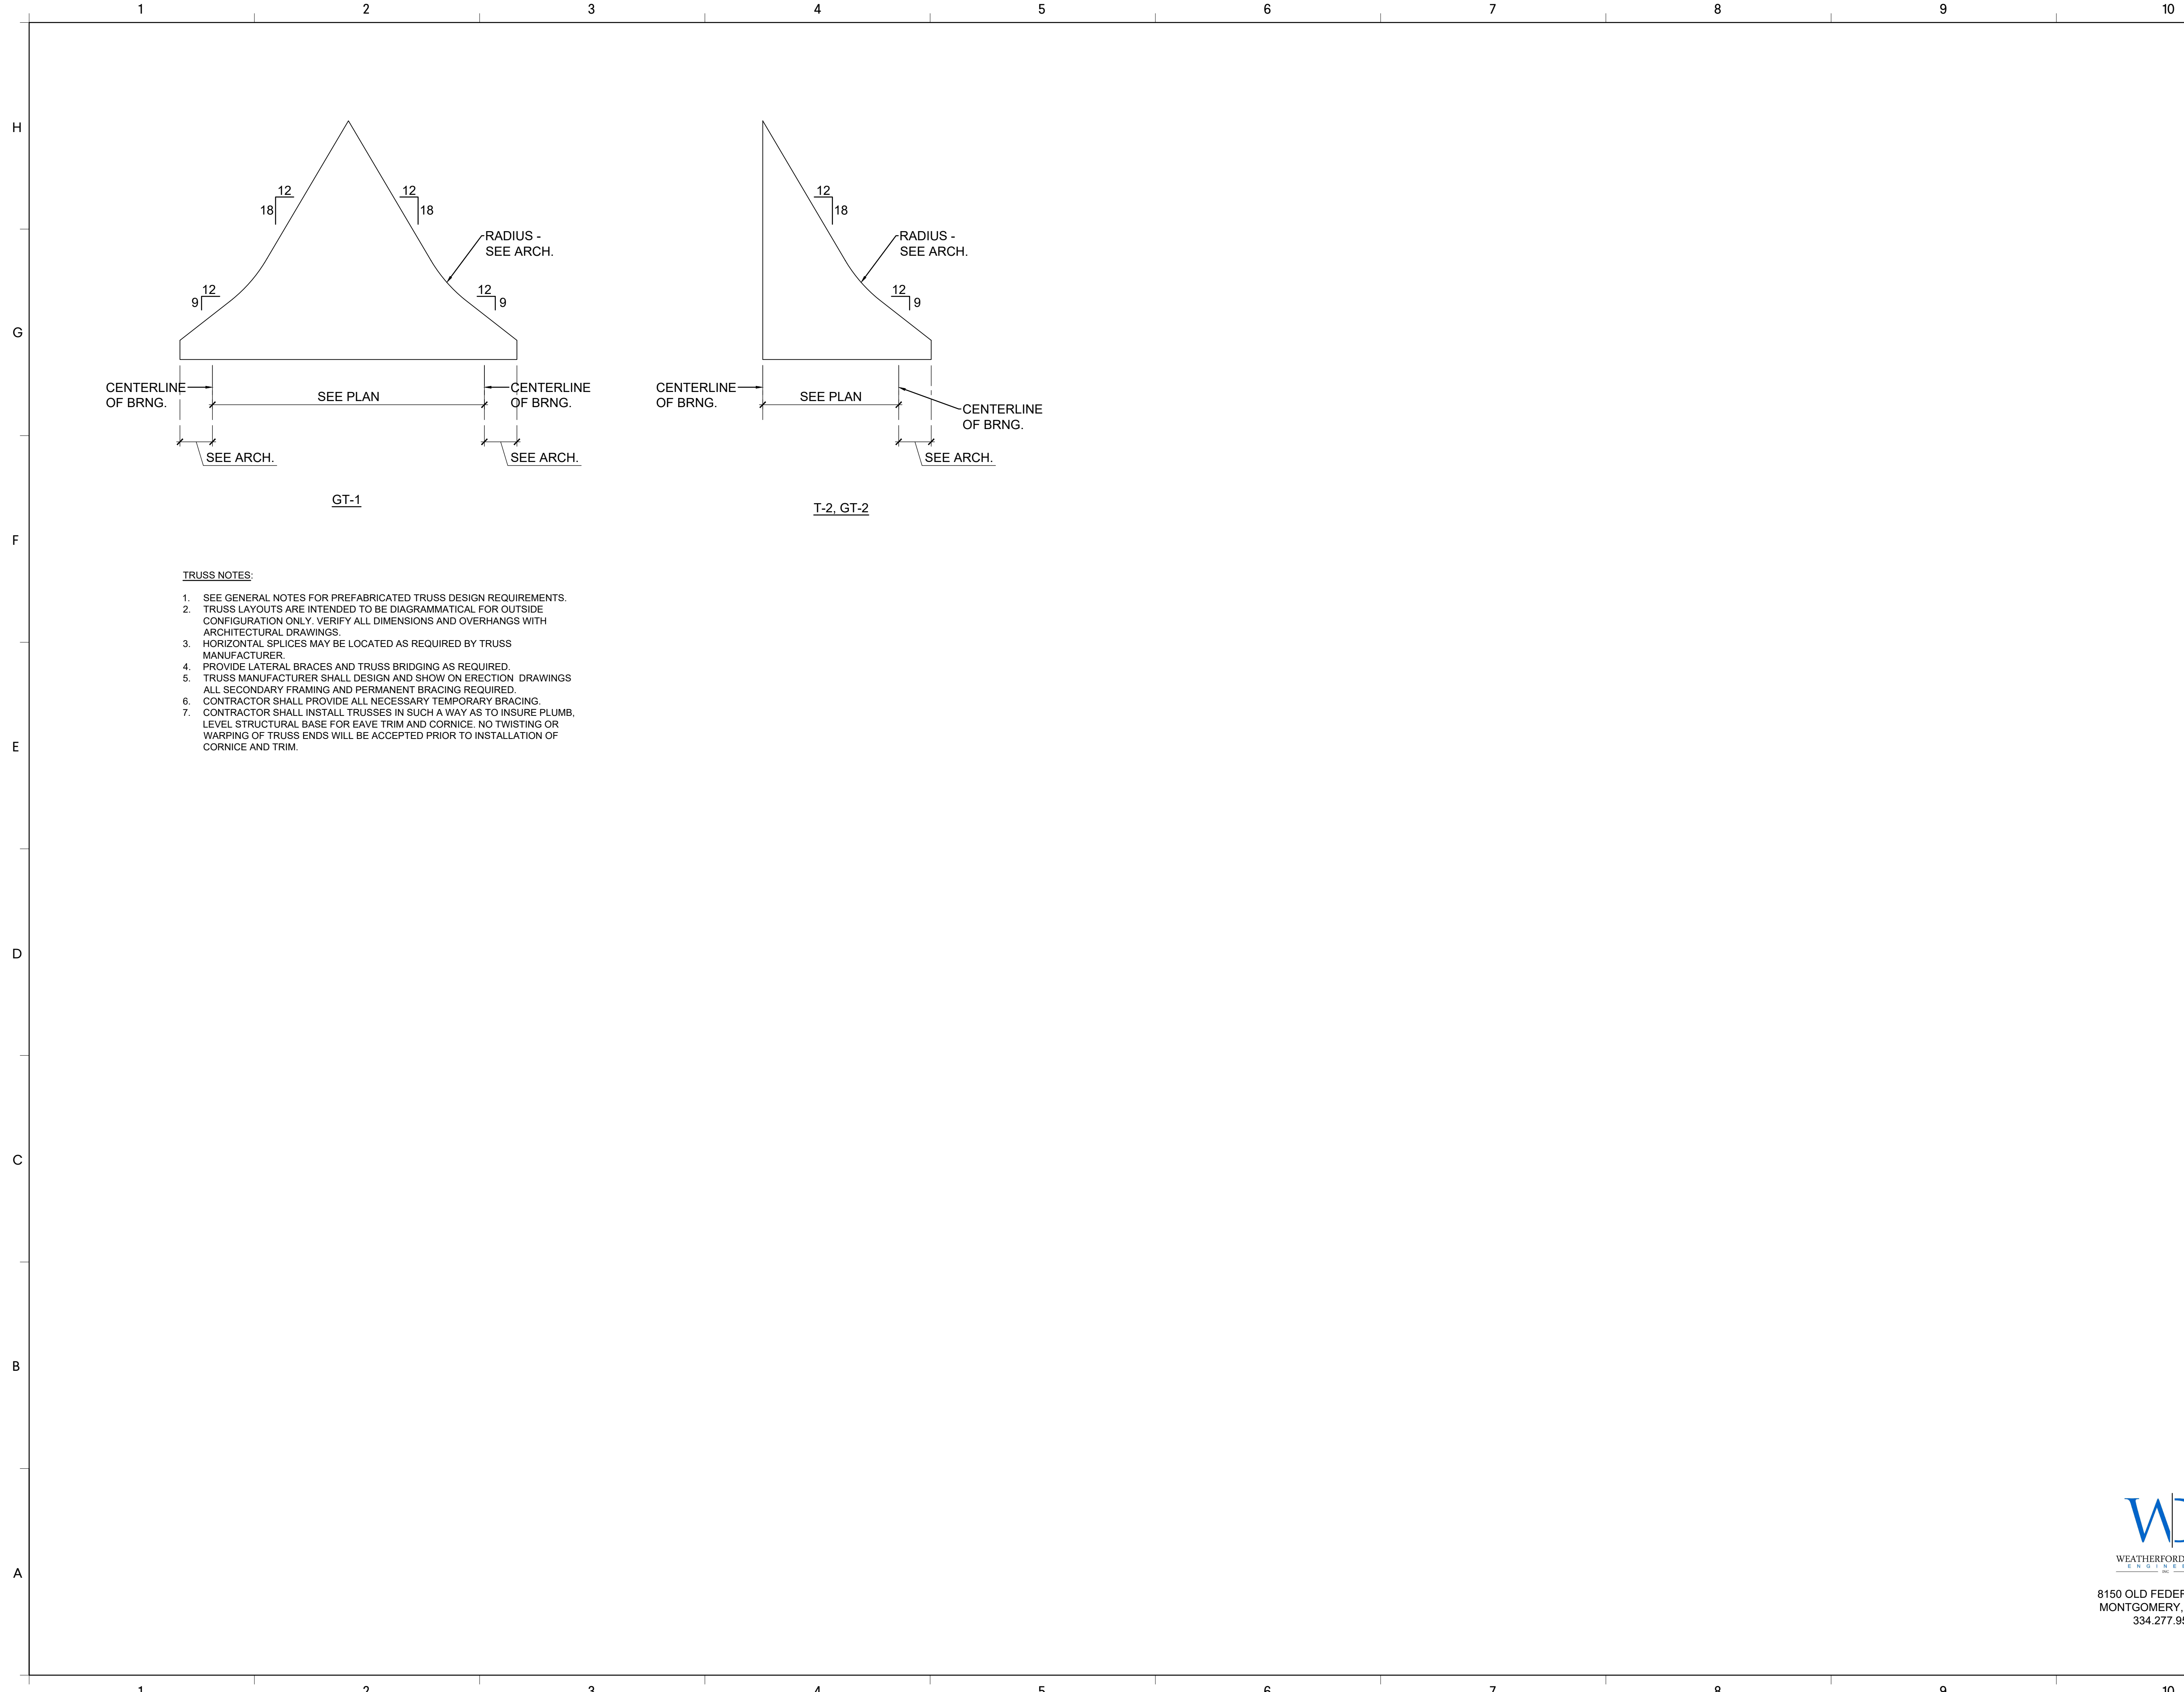

GT-1

T-2_GT-2

TRUSS NOTES:

1. SEE GENERAL NOTES FOR PREFABRICATED TRUSS DESIGN REQUIREMENTS.
2. TRUSS LAYOUTS ARE INTENDED TO BE DIAGRAMMATICAL FOR OUTSIDE CONFIGURATION ONLY. VERIFY ALL DIMENSIONS AND OVERHANGS WITH ARCHITECTURAL DRAWINGS.
3. HORIZONTAL SPLICES MAY BE LOCATED AS REQUIRED BY TRUSS MANUFACTURER.
4. PROVIDE LATERAL BRACES AND TRUSS BRIDGING AS REQUIRED.
5. TRUSS MANUFACTURER SHALL DESIGN AND SHOW ON ERECTION DRAWINGS ALL SECONDARY FRAMING AND PERMANENT BRACING REQUIRED.
6. CONTRACTOR SHALL PROVIDE ALL NECESSARY TEMPORARY BRACING.
7. CONTRACTOR SHALL INSTALL TRUSSES IN SUCH A WAY AS TO INSURE PLUMB, LEVEL STRUCTURAL BASE FOR EAVE TRIM AND CORNICE. NO TWISTING OR WARPING OF TRUSS ENDS WILL BE ACCEPTED PRIOR TO INSTALLATION OF CORNICE AND TRIM.



8150 OLD FEDERAL ROAD
MONTGOMERY, AL 36117
334.277.9550


ISSUE DATE

04/23/2019	75% REVIEW
05/20/2019	85% REVIEW
10/17/2019	PERMIT
	DESIGNED BY: LGS
	DRAWN BY: LGS
	CHECKED BY: DPR

EXCHANGE AT HOMEPLACE


PRATTVILLE, AL

GMC PROJECT#AMGM180037

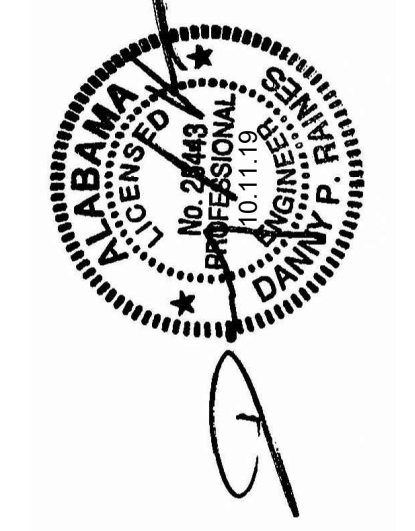


TRUSS DIAGRAMS


S2.1

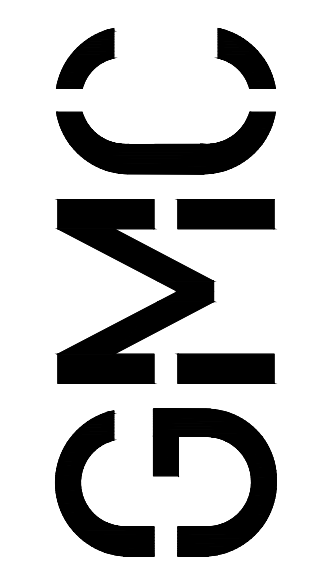


AS-BUILT

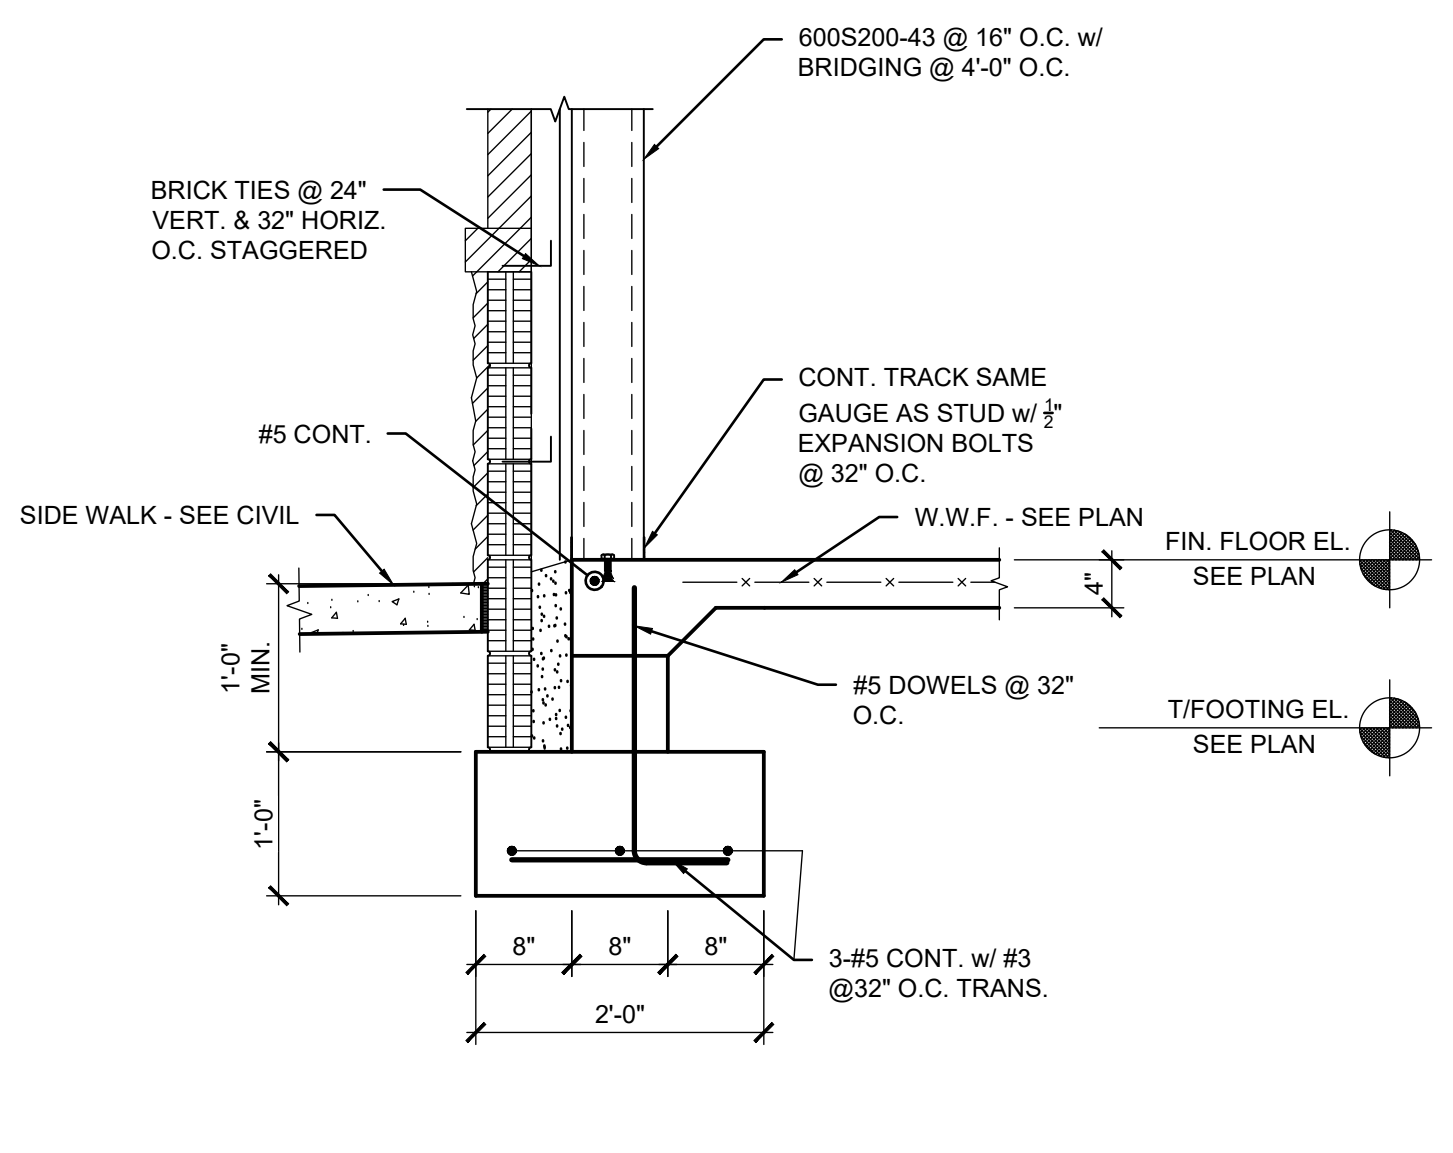


1 SECTION
S3.1
1'-4" 8" 0" 1'-4" 2'-8"
SCALE: 3/4" = 1'-0"

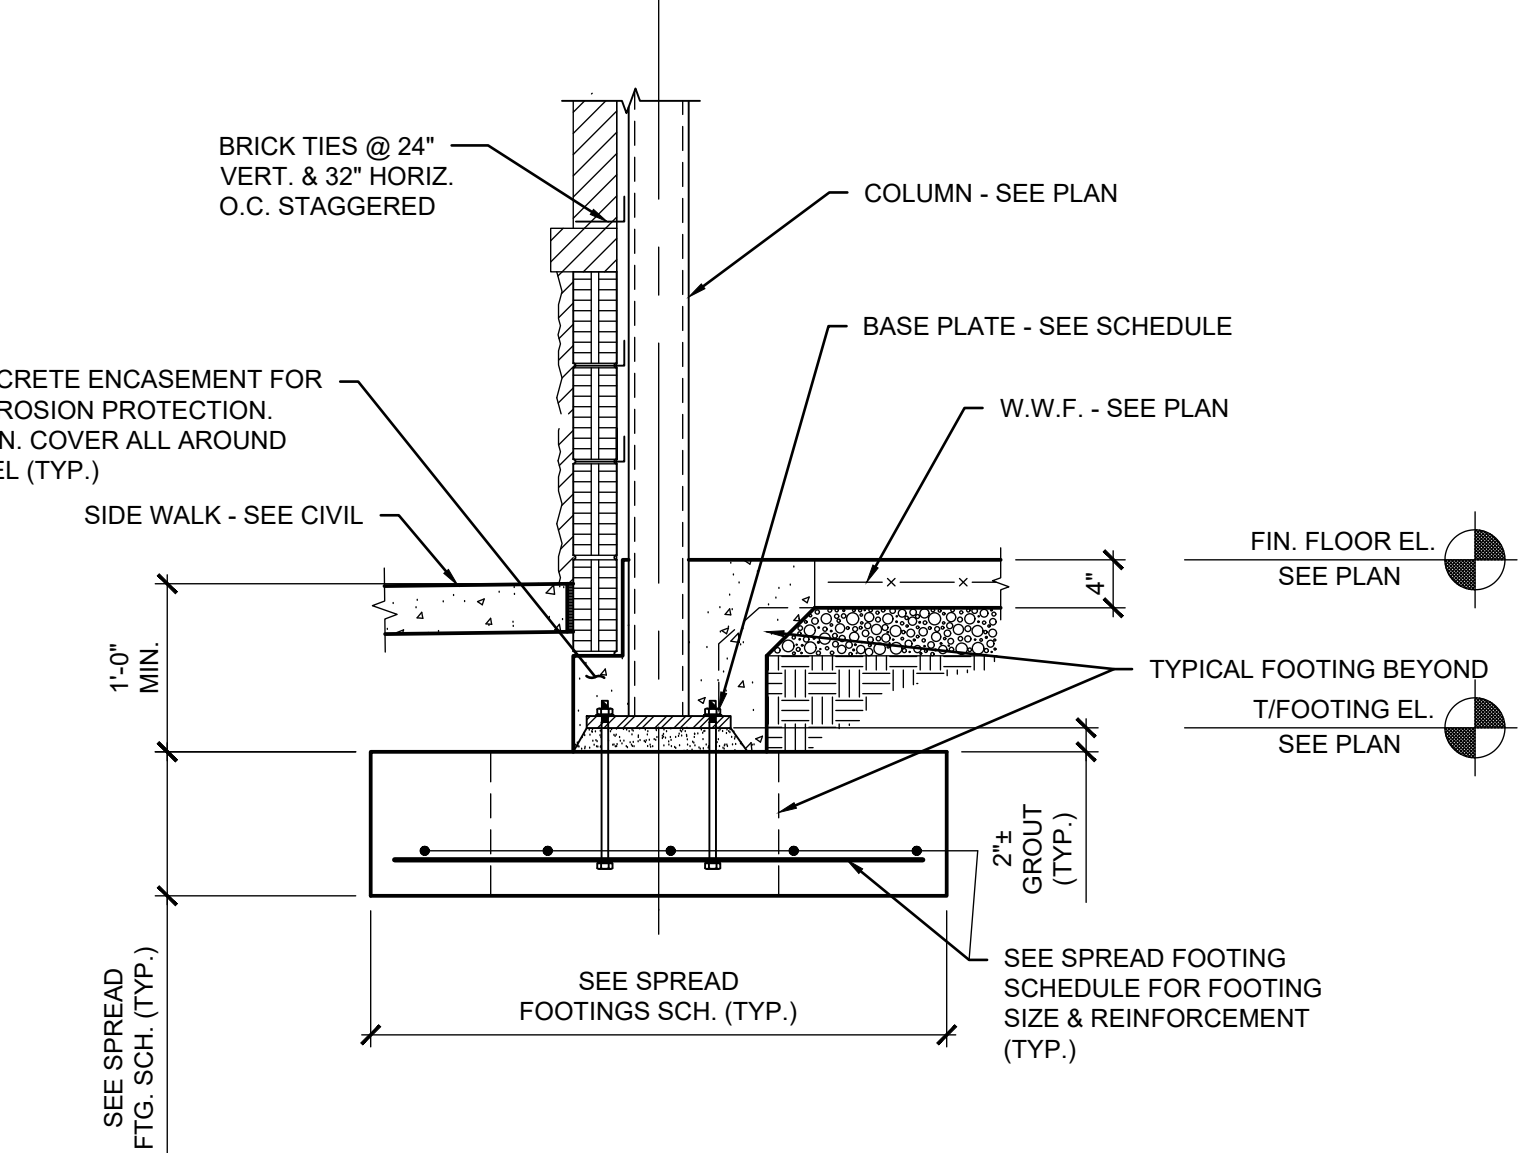


2 SECTION
S3.1
1'-4" 8" 0" 1'-4" 2'-8"
SCALE: 3/4" = 1'-0"

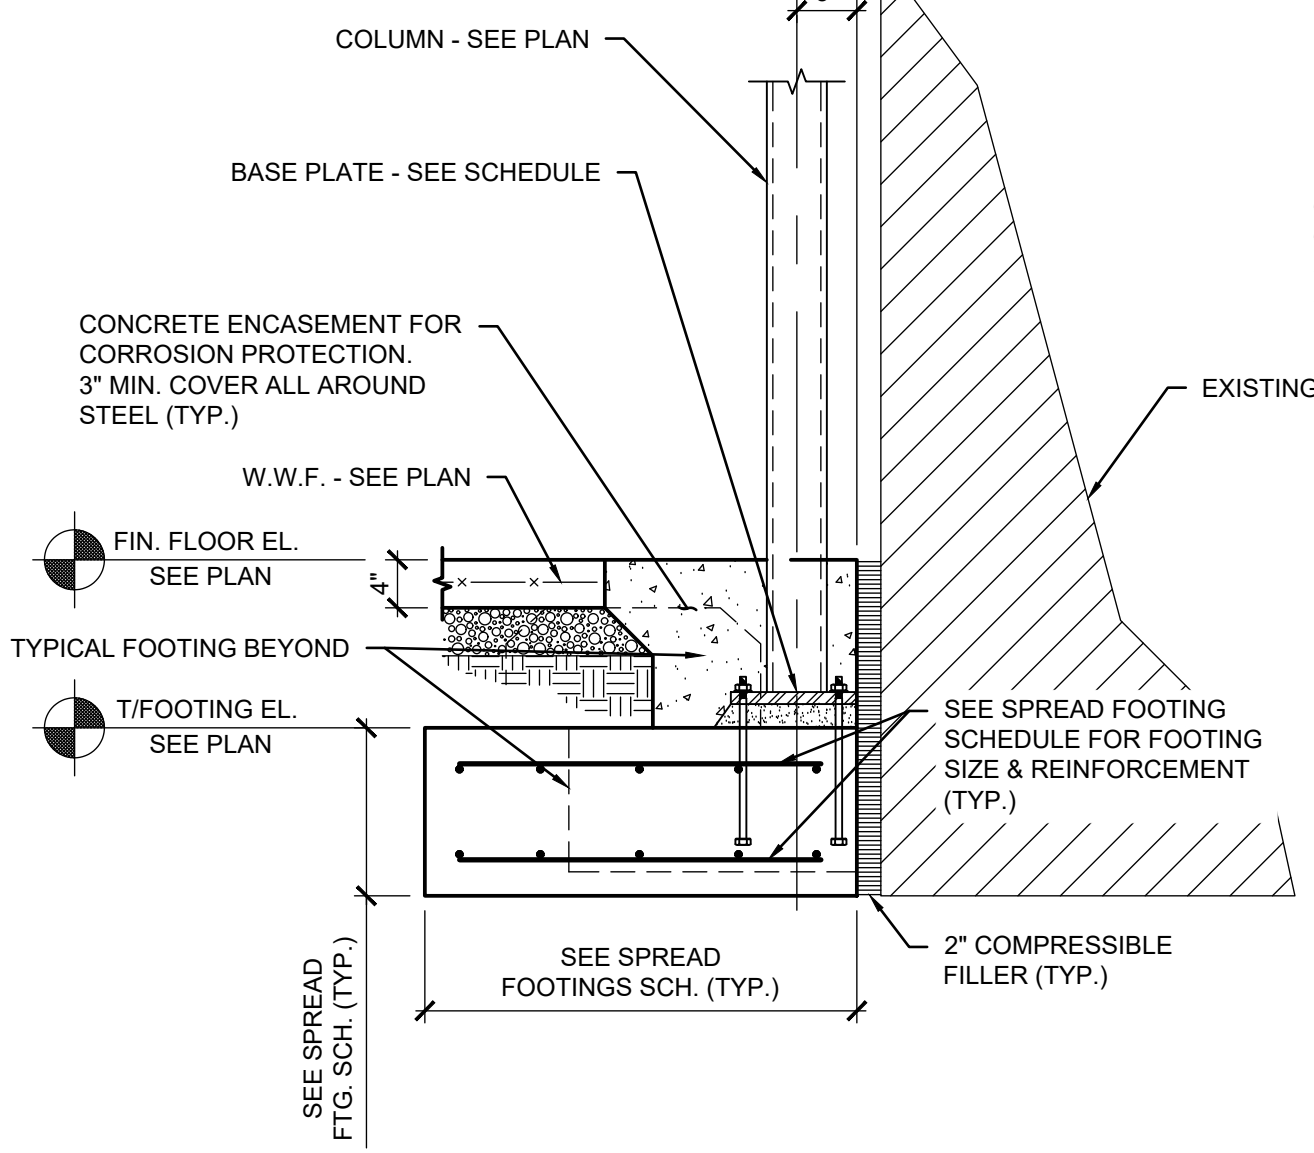


3 SECTION
S3.1
1'-4" 8" 0" 1'-4" 2'-8"
SCALE: 3/4" = 1'-0"

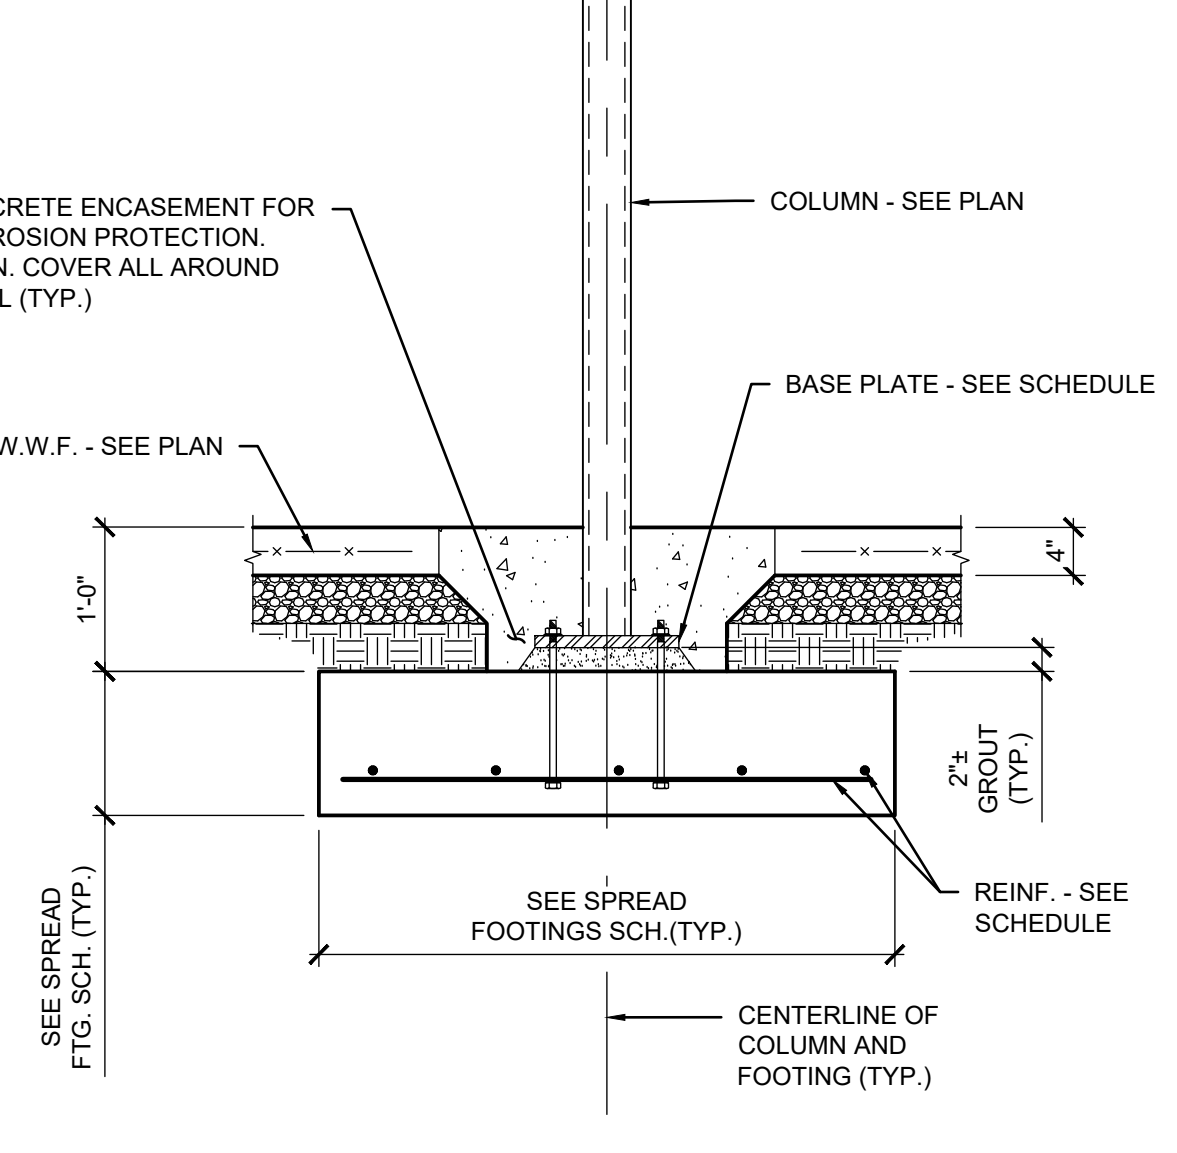


4 SECTION
S3.1
1'-4" 8" 0" 1'-4" 2'-8"
SCALE: 3/4" = 1'-0"

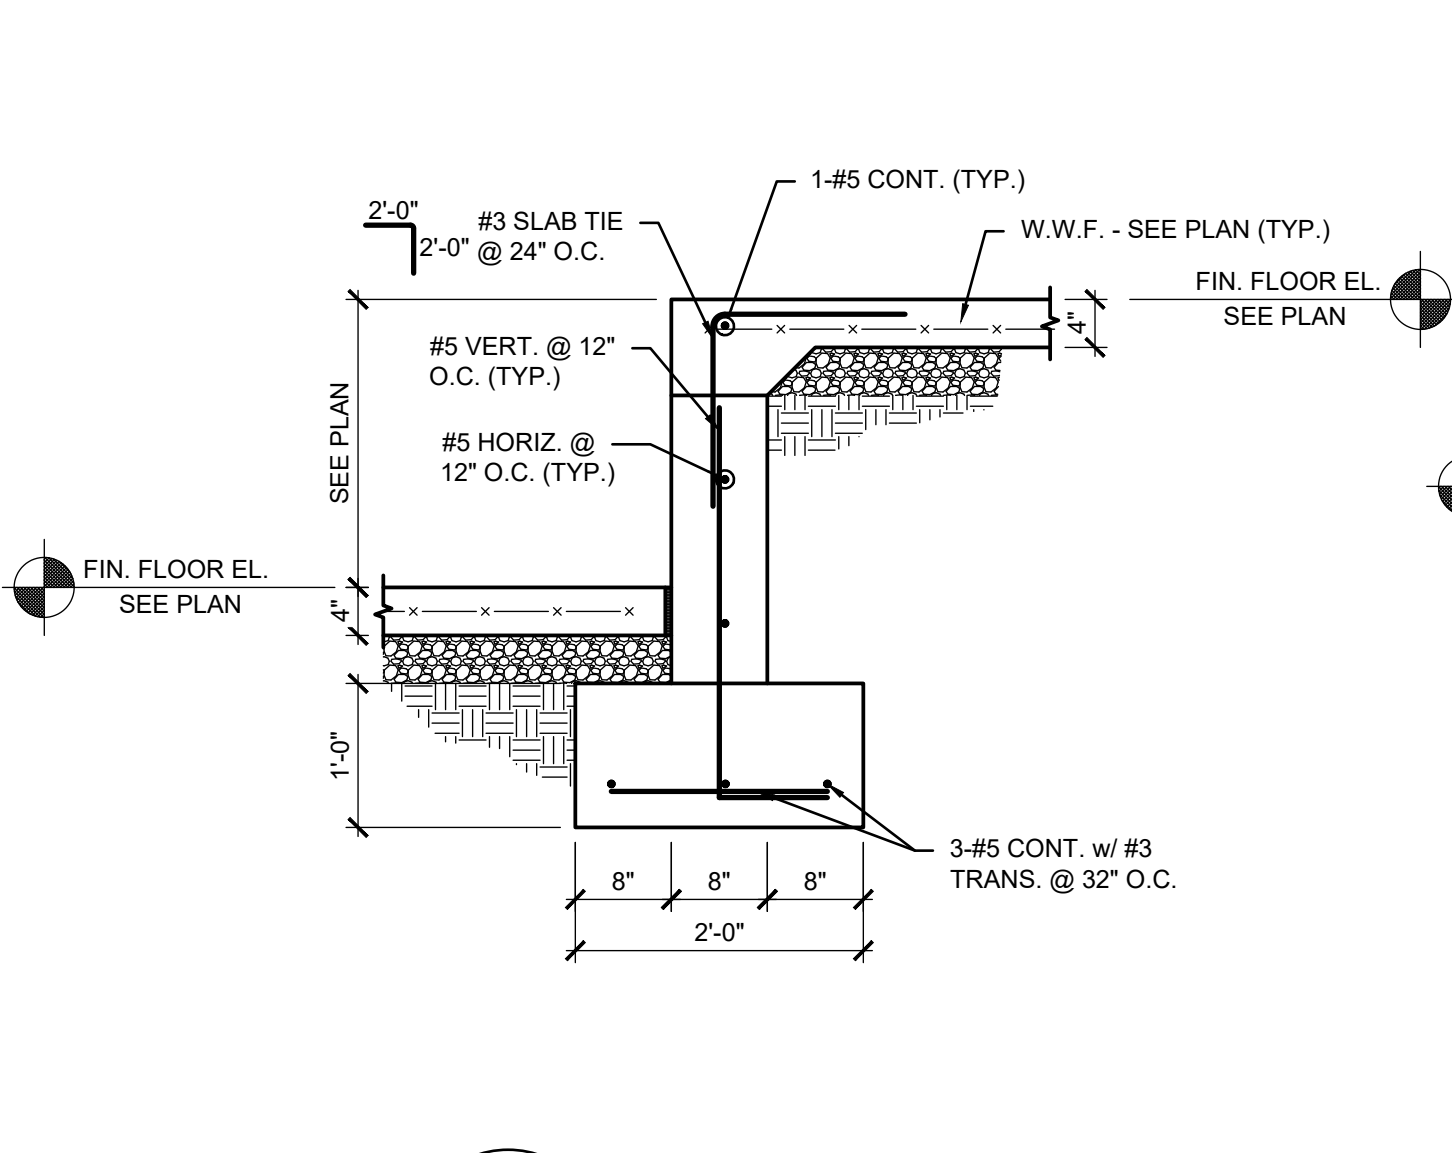


5 SECTION
S3.1
1'-4" 8" 0" 1'-4" 2'-8"
SCALE: 3/4" = 1'-0"

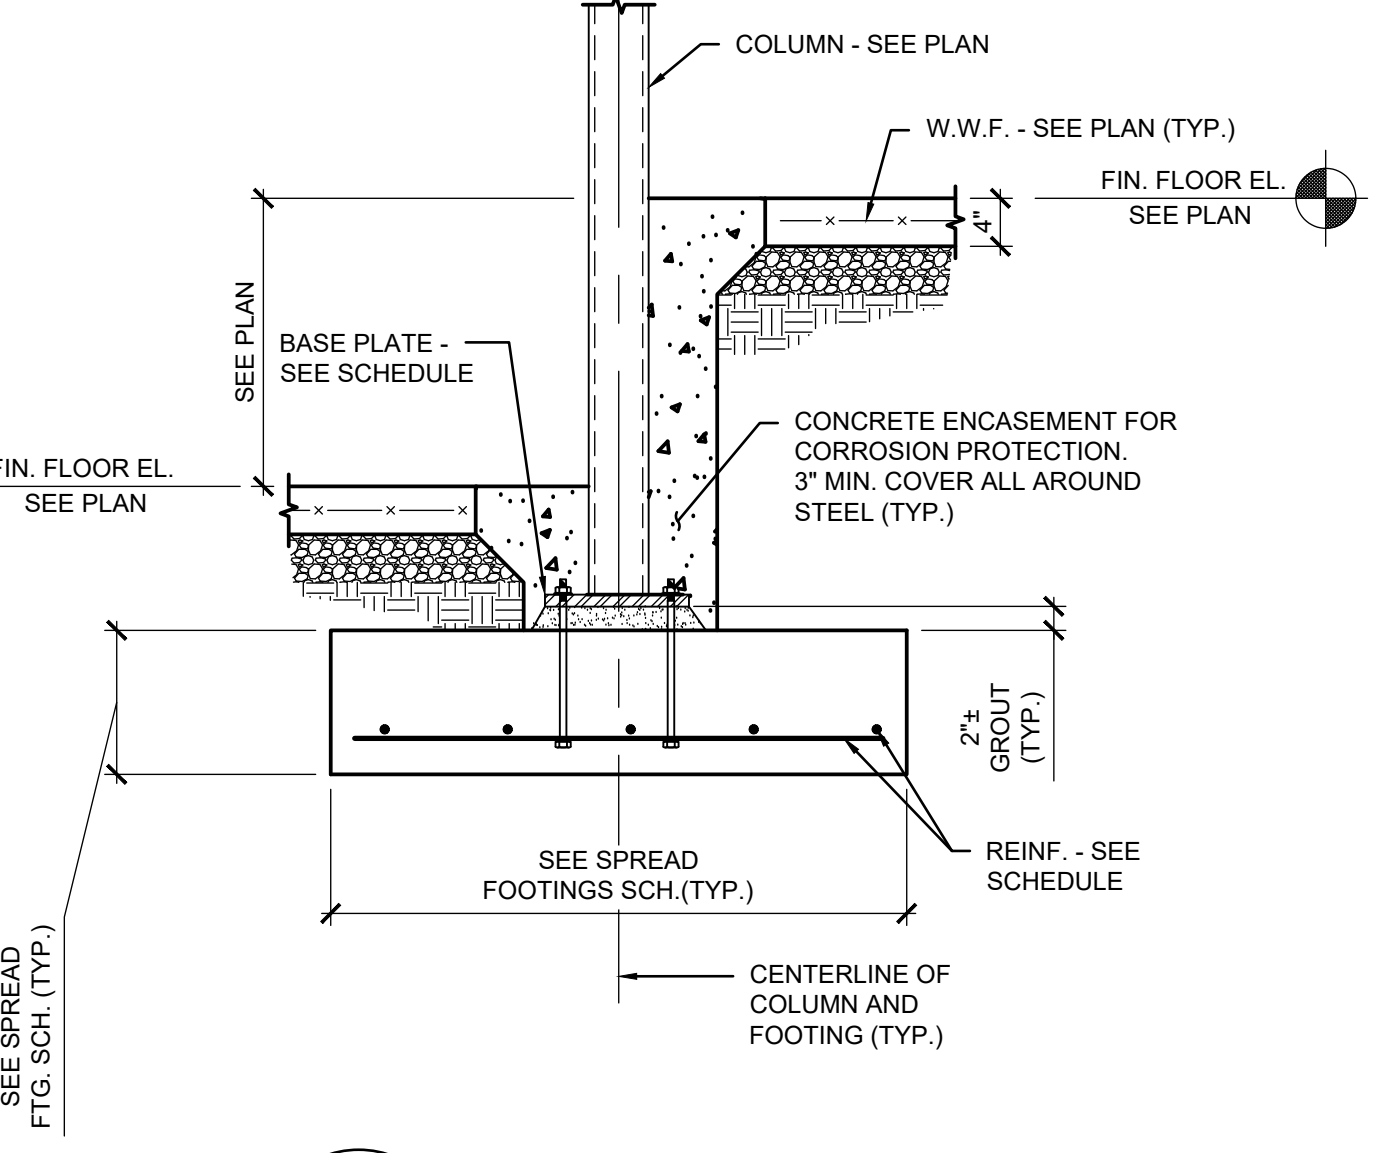


6 SECTION
S3.1
1'-4" 8" 0" 1'-4" 2'-8"
SCALE: 3/4" = 1'-0"

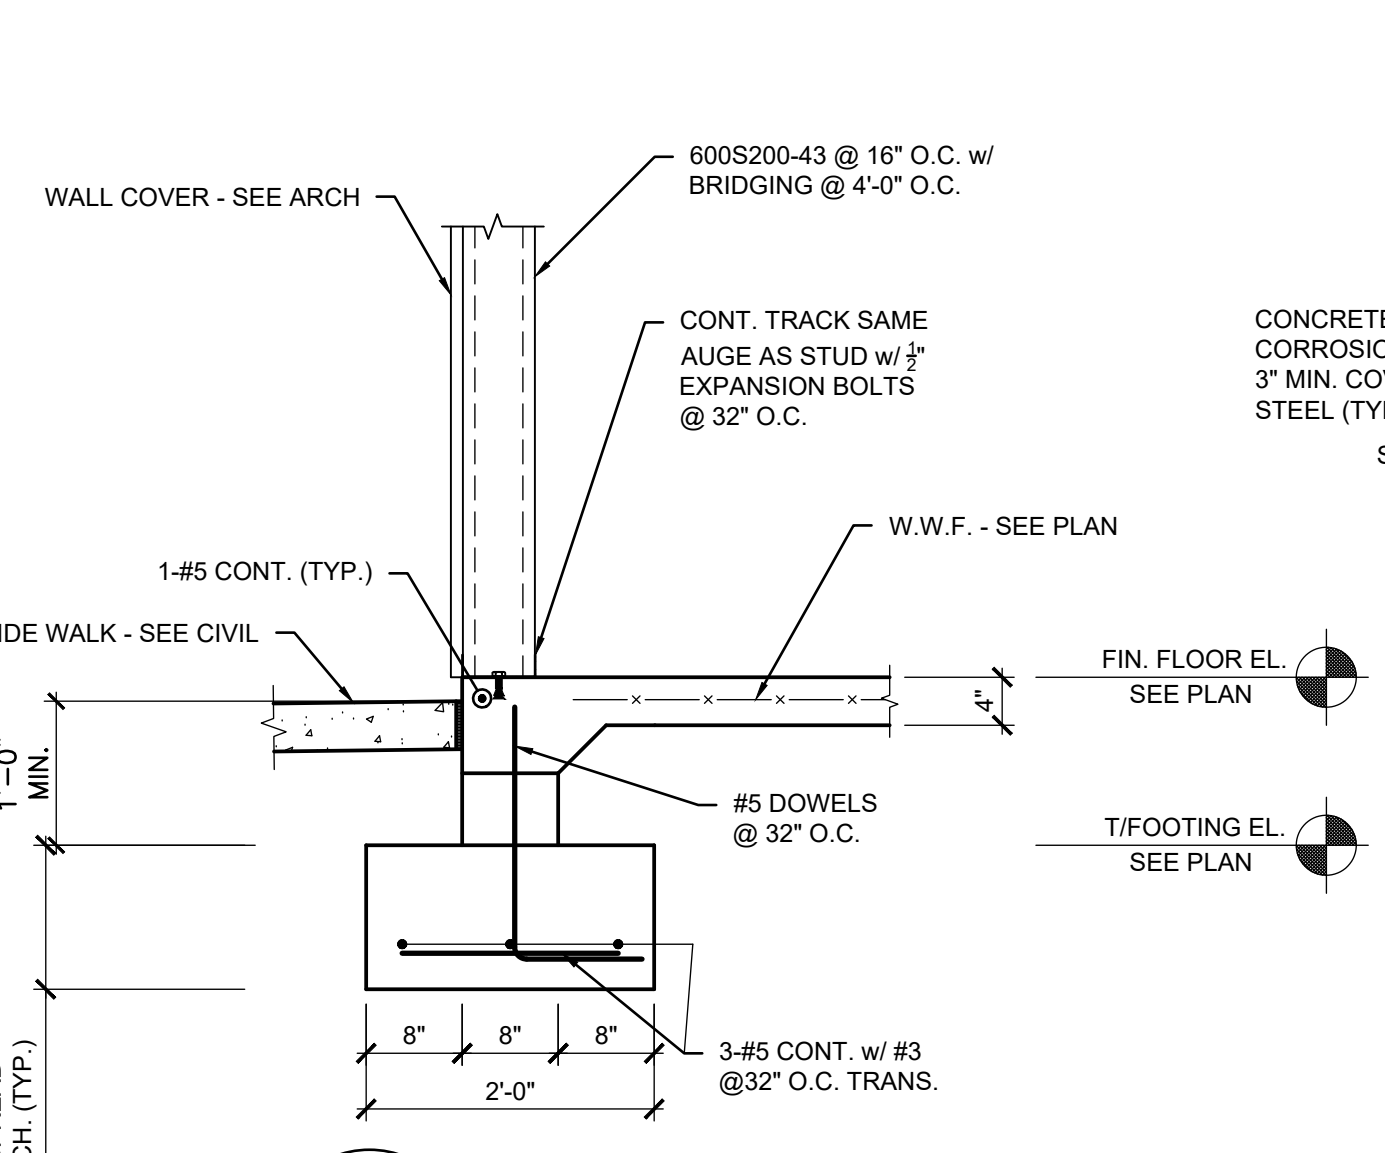


7 SECTION
S3.1
1'-4" 8" 0" 1'-4" 2'-8"
SCALE: 3/4" = 1'-0"

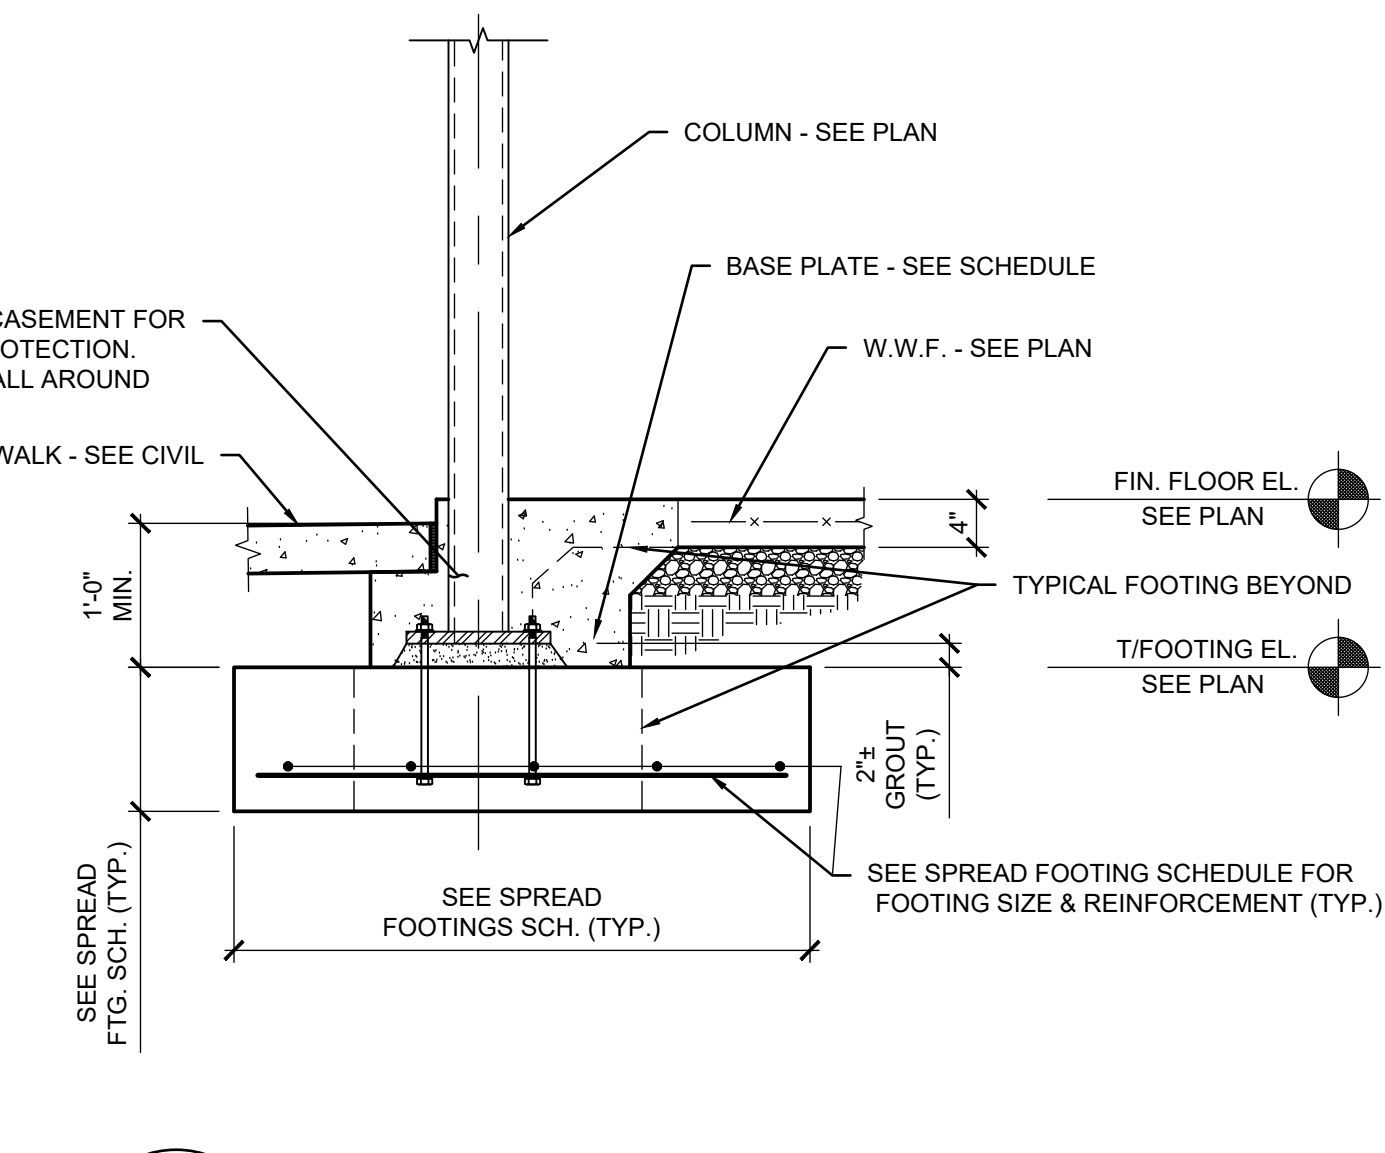


8 SECTION
S3.1
1'-4" 8" 0" 1'-4" 2'-8"
SCALE: 3/4" = 1'-0"

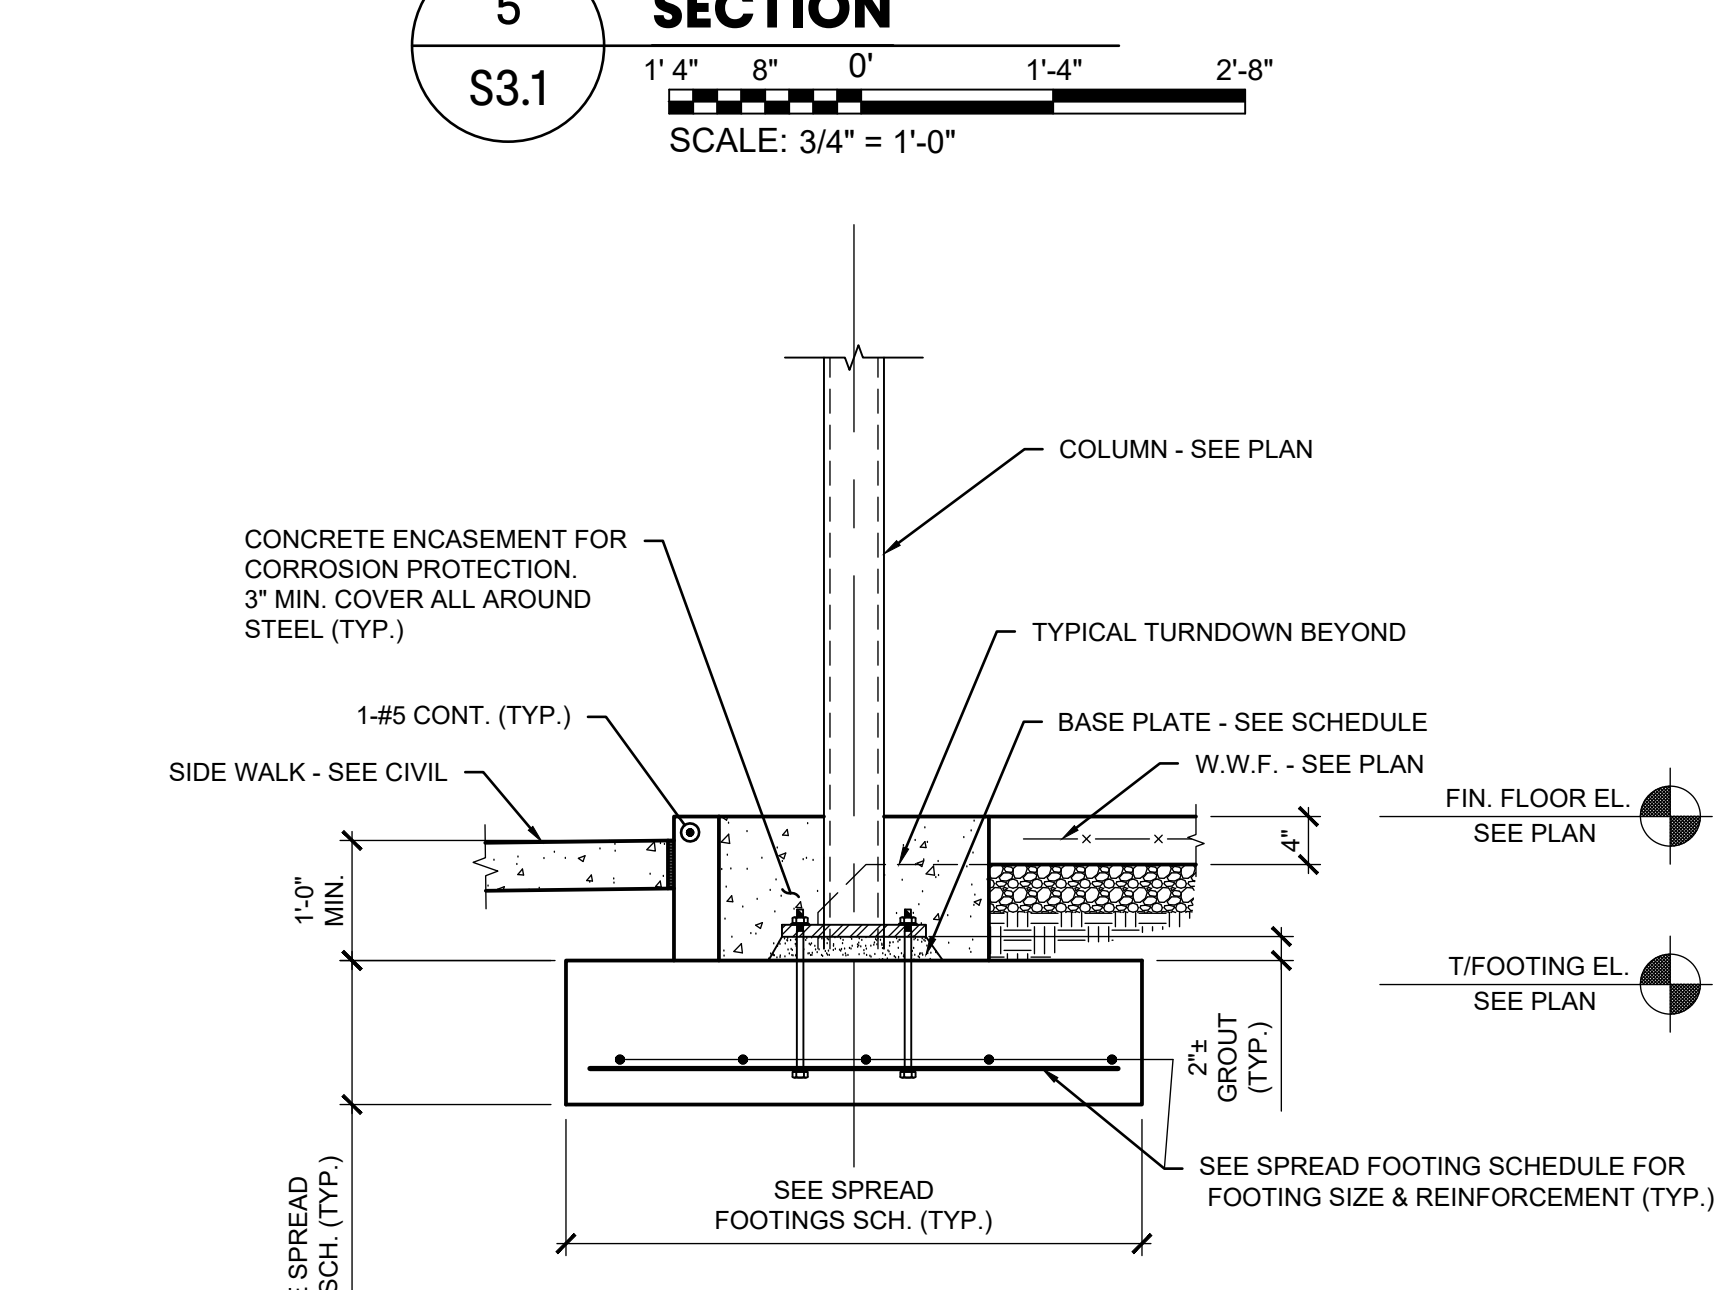


9 SECTION
S3.1
1'-4" 8" 0" 1'-4" 2'-8"
SCALE: 3/4" = 1'-0"

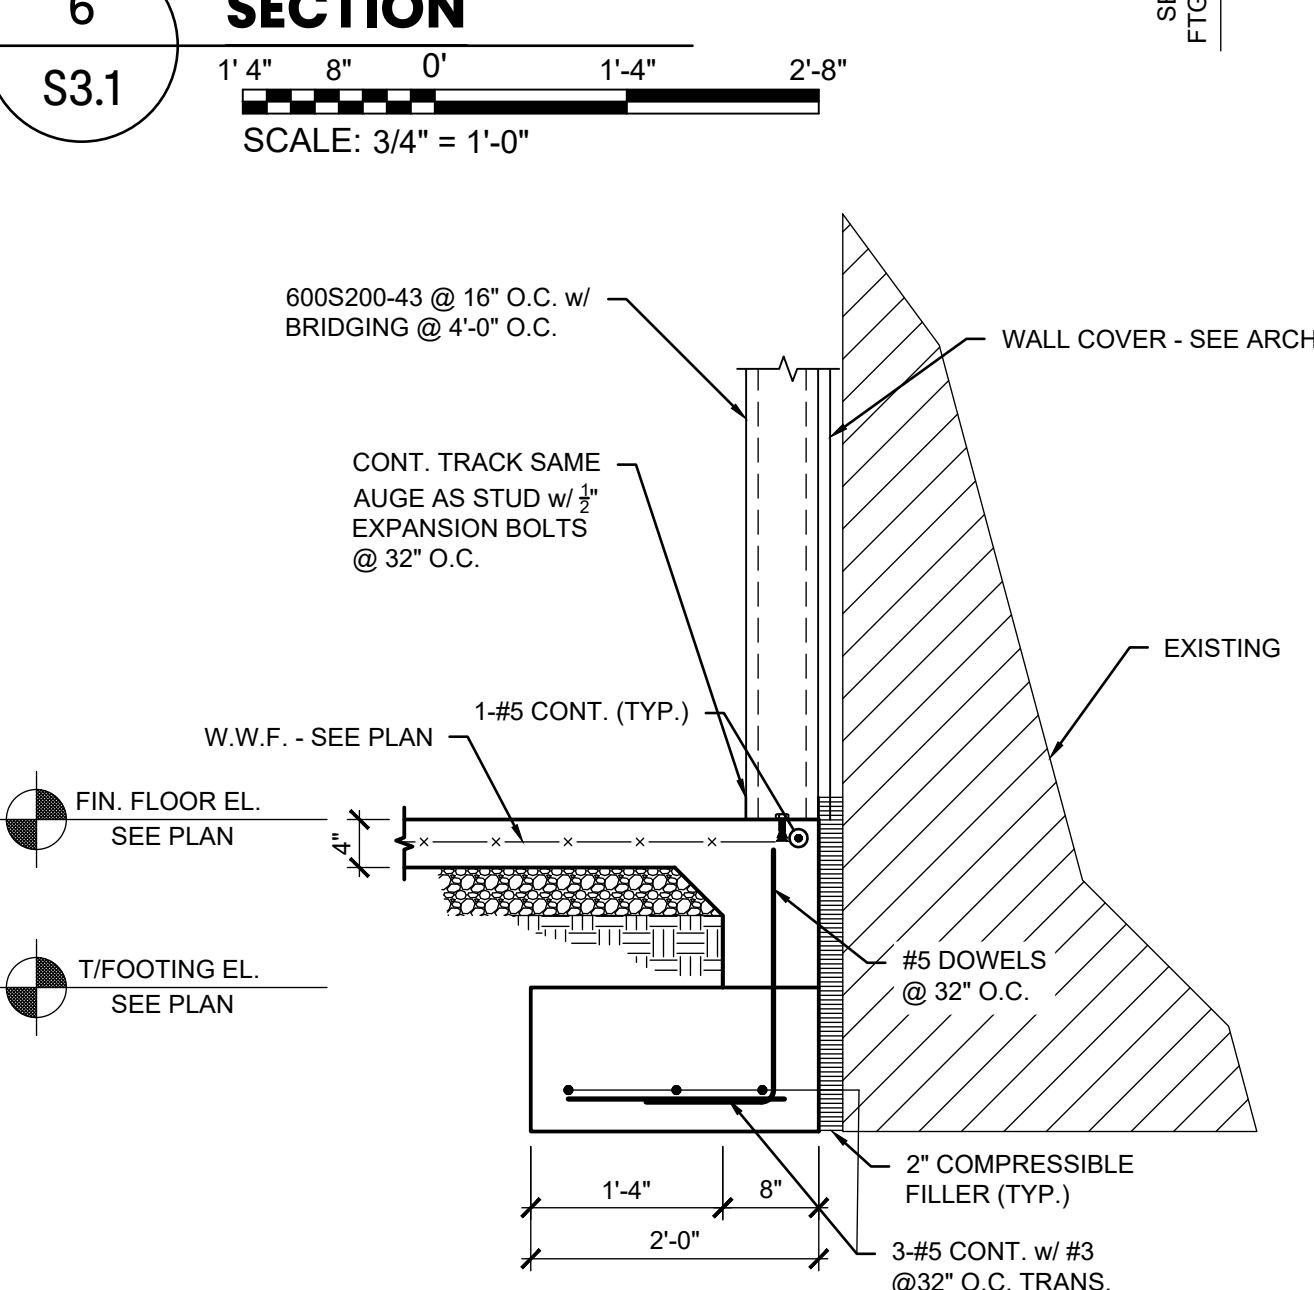

10 SECTION
S3.1
1'-4" 8" 0" 1'-4" 2'-8"
SCALE: 3/4" = 1'-0"

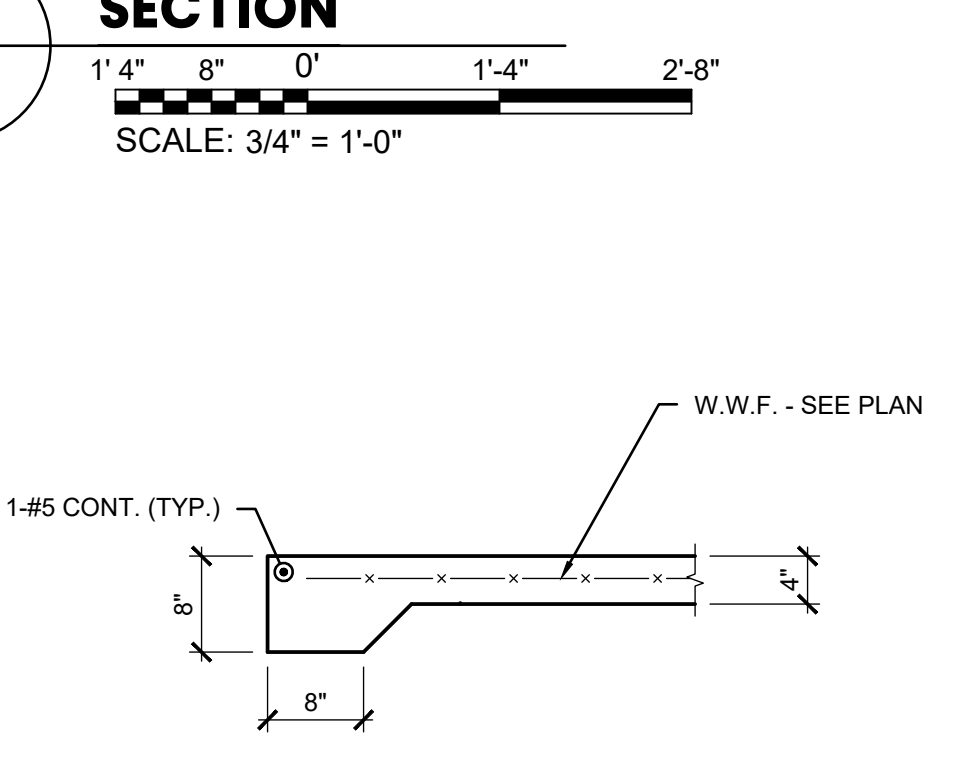

11 SECTION
S3.1
1'-4" 8" 0" 1'-4" 2'-8"
SCALE: 3/4" = 1'-0"

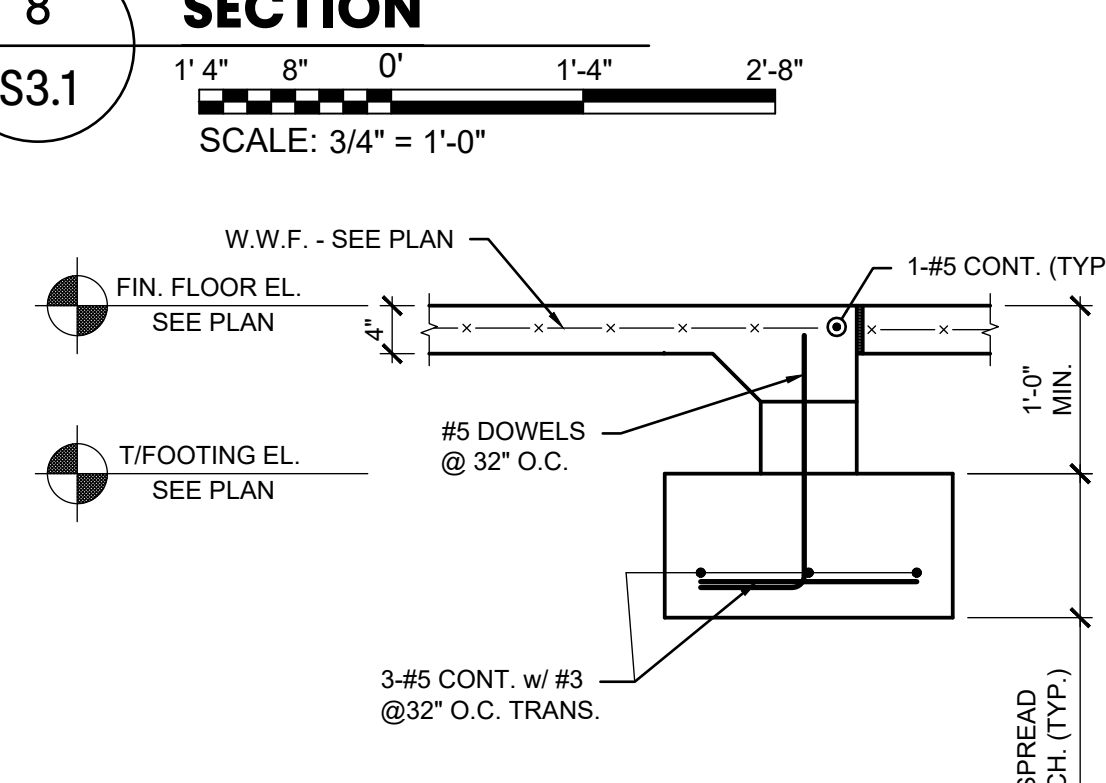


12 SECTION
S3.1
1'-4" 8" 0" 1'-4" 2'-8"
SCALE: 3/4" = 1'-0"

GMC
AS-BUILT


ISSUE DATE	REVISION
04/23/2019	75% REVIEW
05/30/2019	95% REVIEW
10/17/2019	PERMIT

EXCHANGE AT HOMEPAGE
PRATTVILLE, AL
GMC PROJECT#AMGM180037

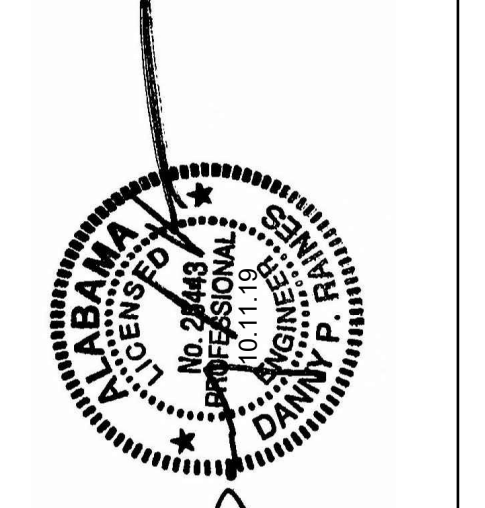


SECTIONS
S3.1


WD
WEATHERFORD & DAY
8150 OLD FEDERAL ROAD
MONTGOMERY, AL 36117
334.277.9550

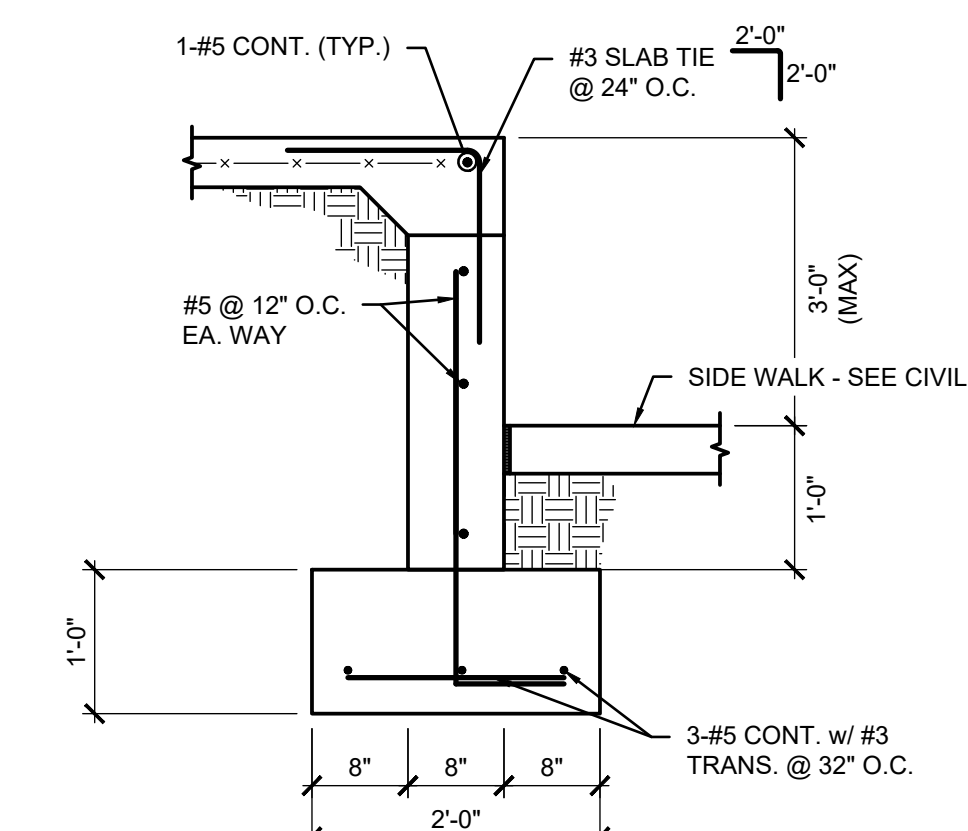


1 SECTION
S3.2
SCALE: 3/4" = 1'-0"

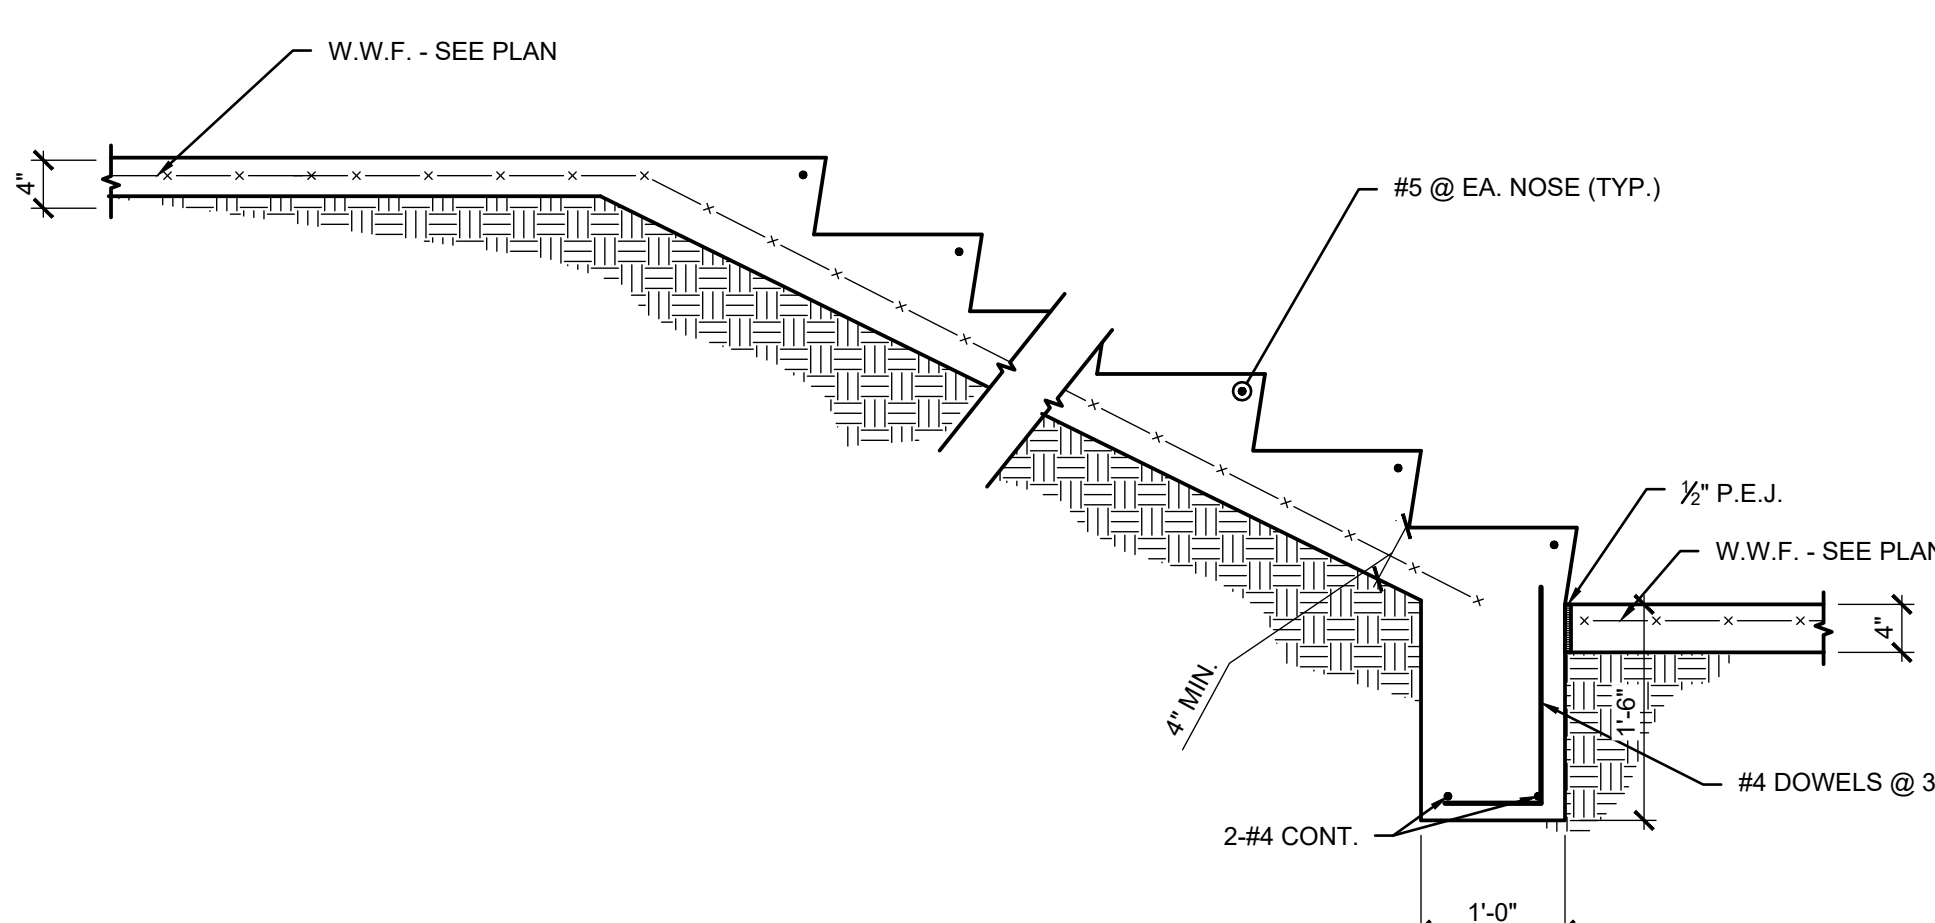


2 SECTION
S3.2
SCALE: 3/4" = 1'-0"

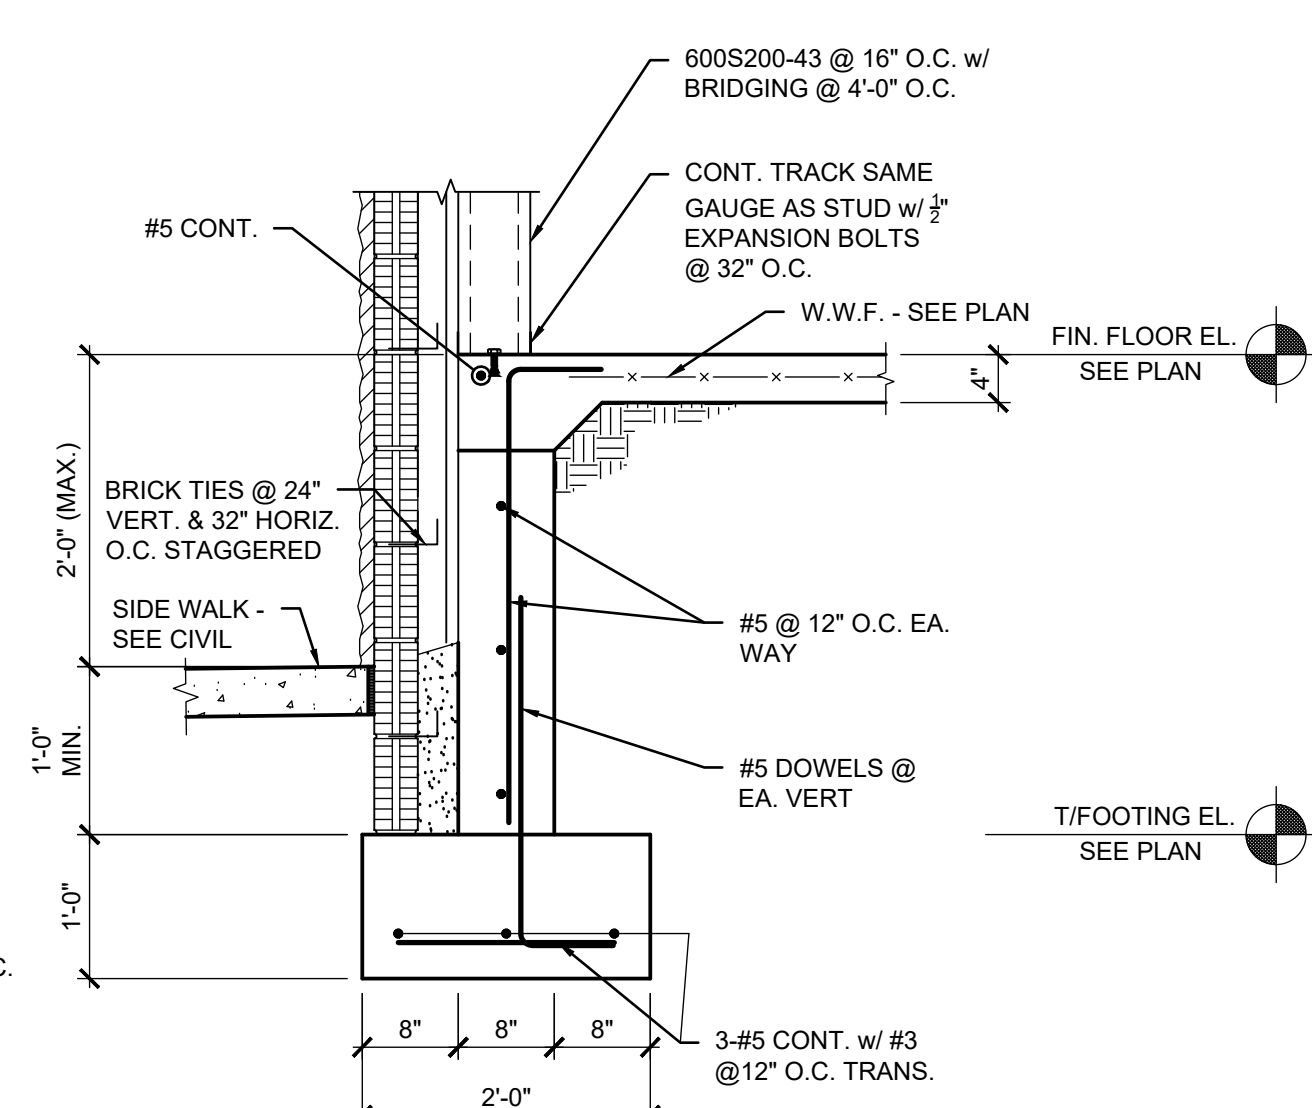


3 SECTION
S3.2
SCALE: 3/4" = 1'-0"

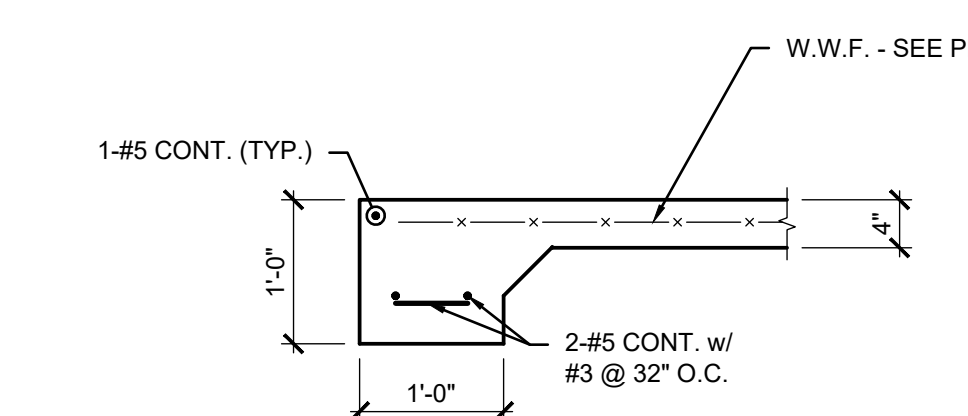


4 SECTION
S3.2
SCALE: 3/4" = 1'-0"

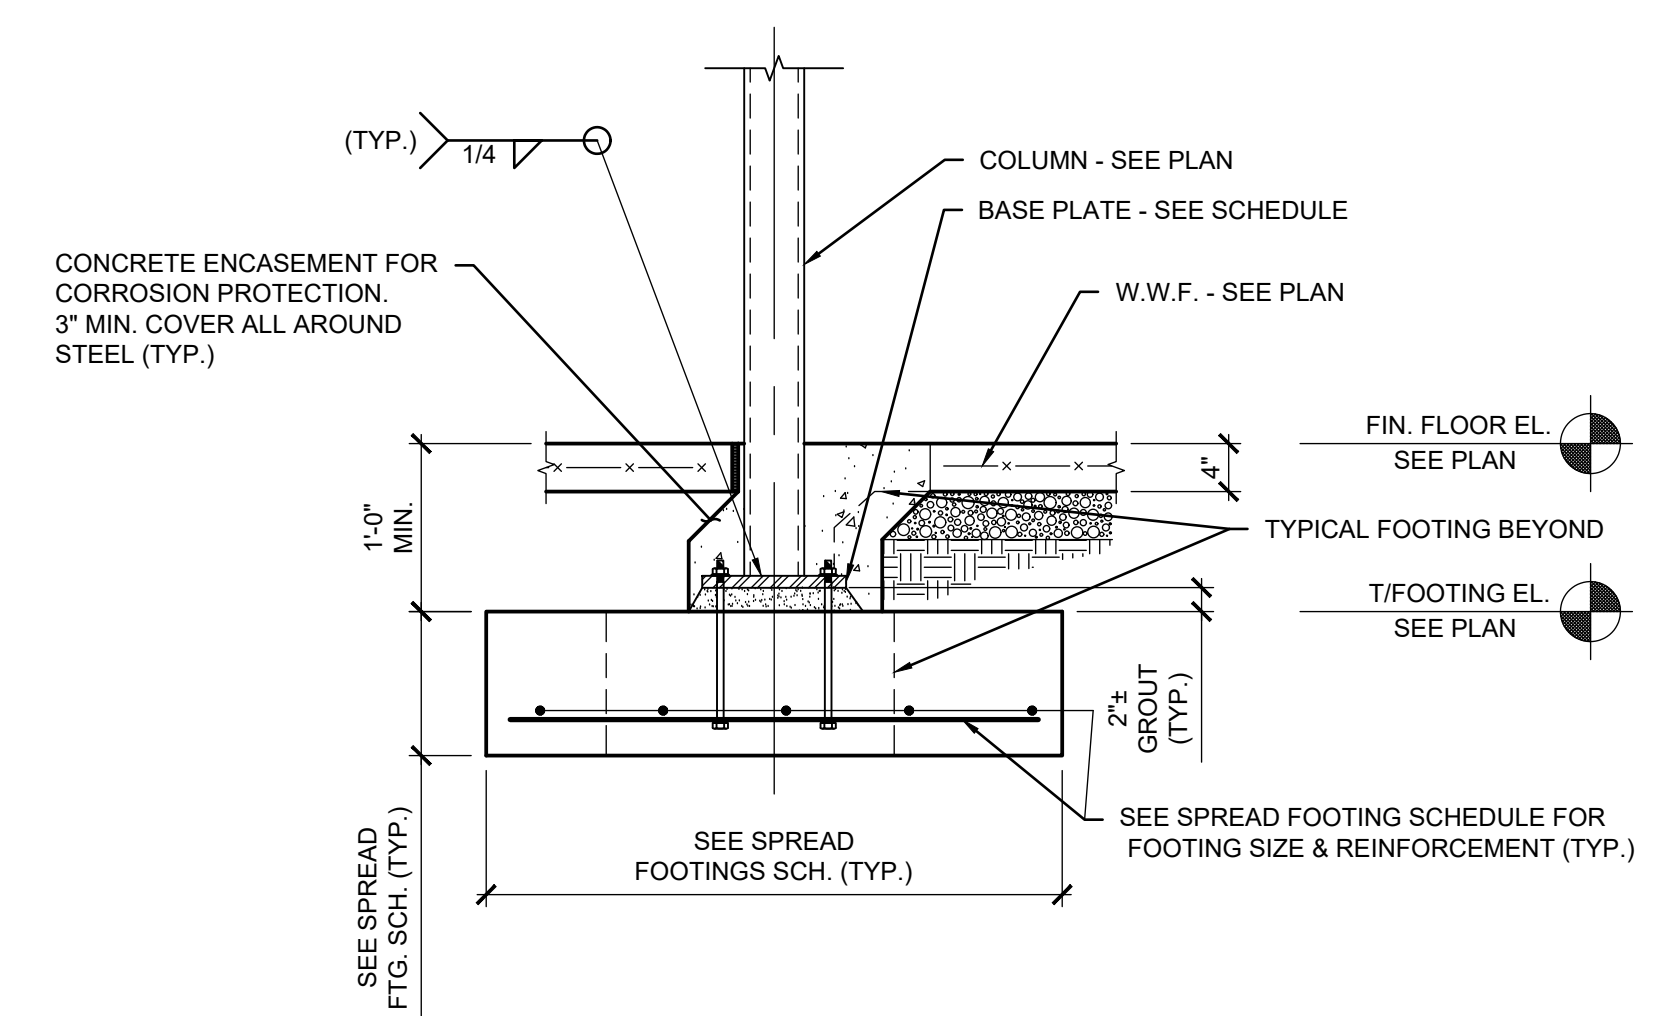


5 SECTION
S3.2
SCALE: 3/4" = 1'-0"

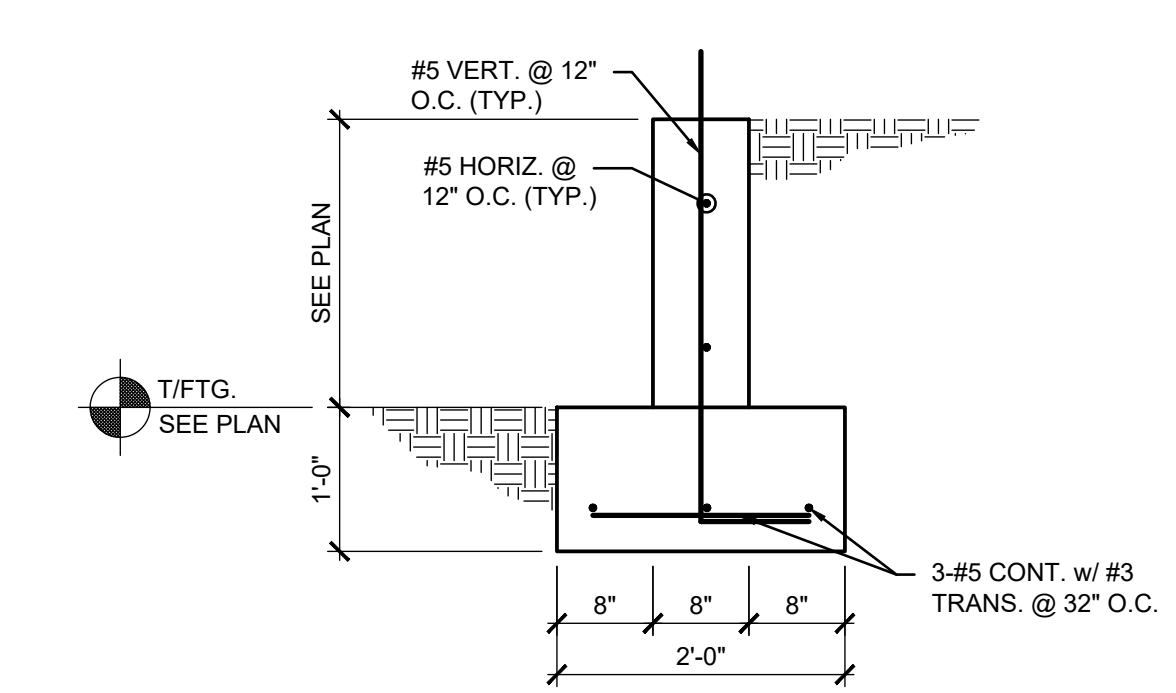


6 SECTION
S3.2
SCALE: 3/4" = 1'-0"

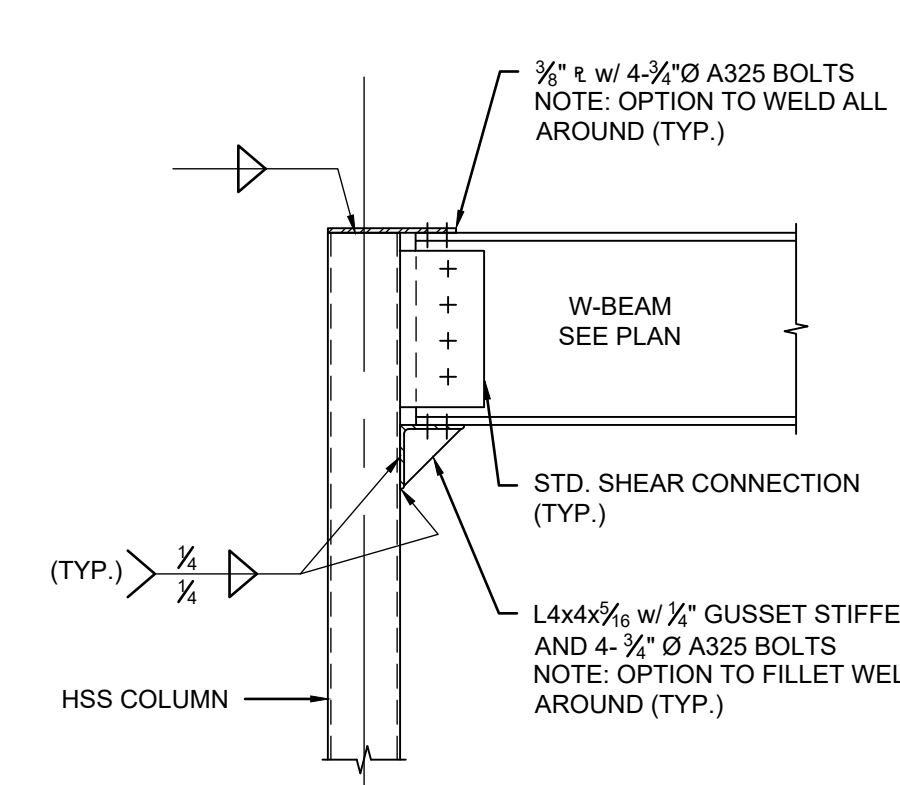


7 SECTION
S3.2
SCALE: 3/4" = 1'-0"

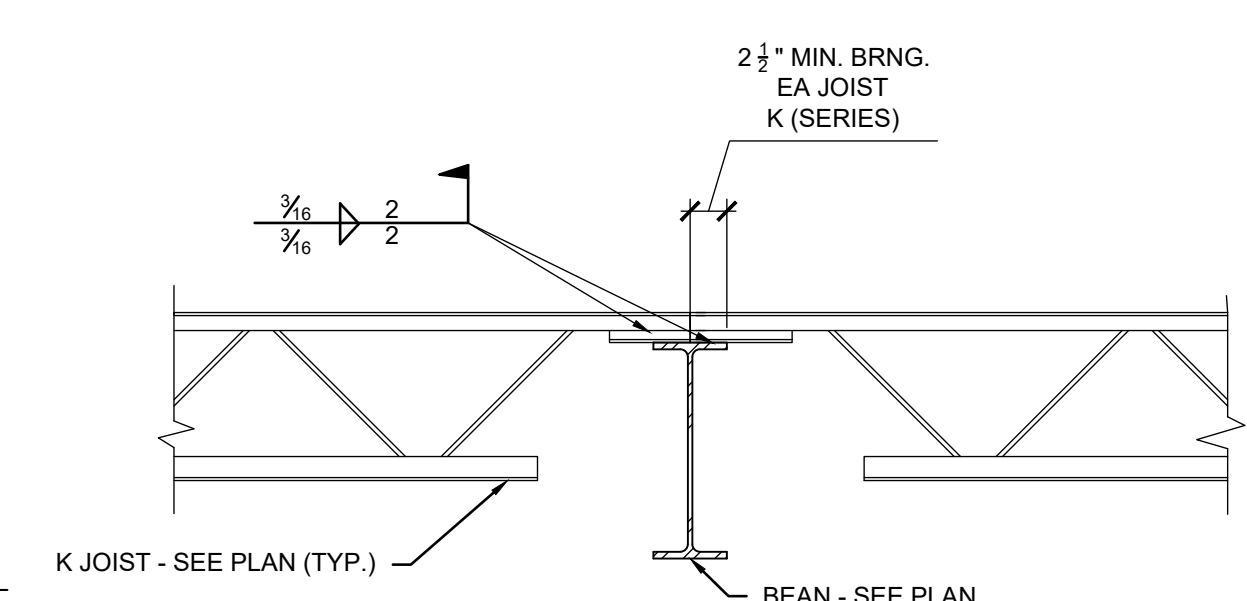


8 SECTION
S3.2
SCALE: 3/4" = 1'-0"

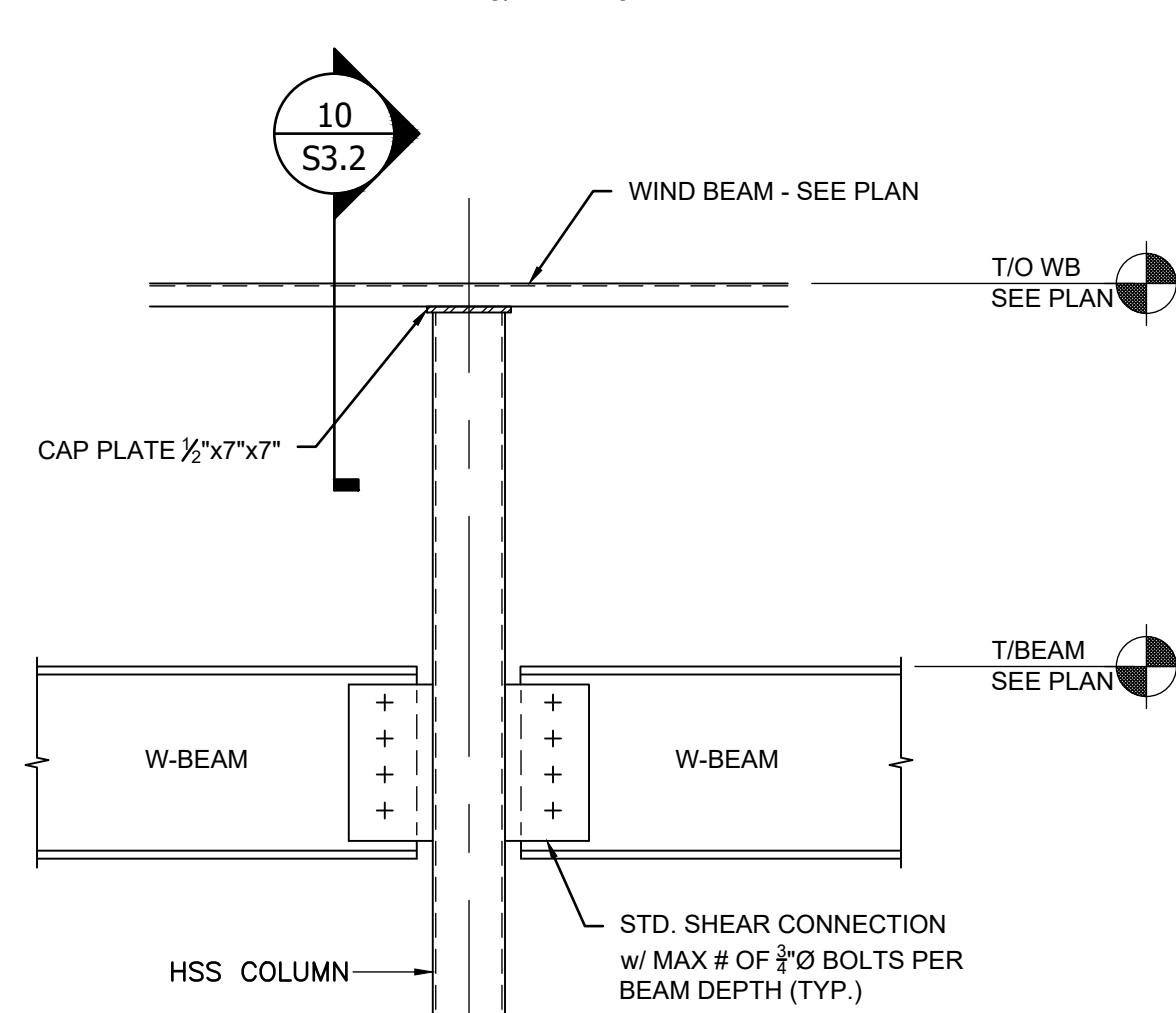


9 SECTION
S3.2
SCALE: 3/4" = 1'-0"

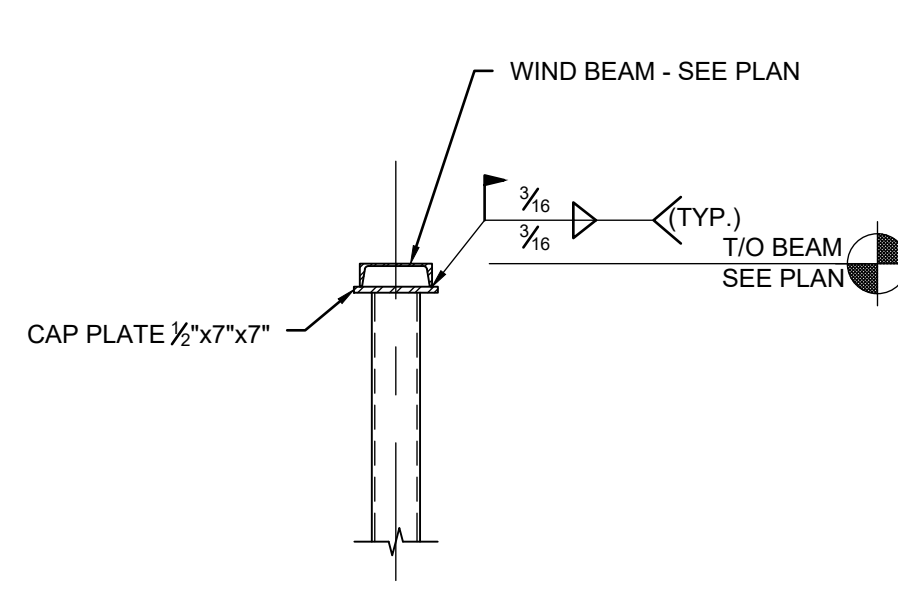

10 SECTION
S3.2
SCALE: 3/4" = 1'-0"

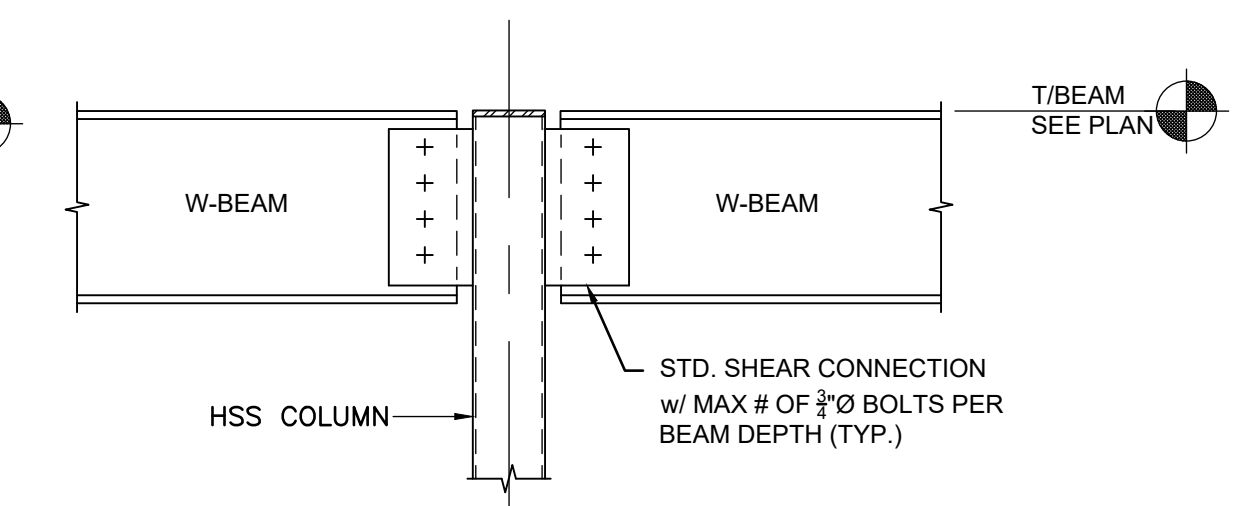

11 SECTION
S3.2
SCALE: 3/4" = 1'-0"

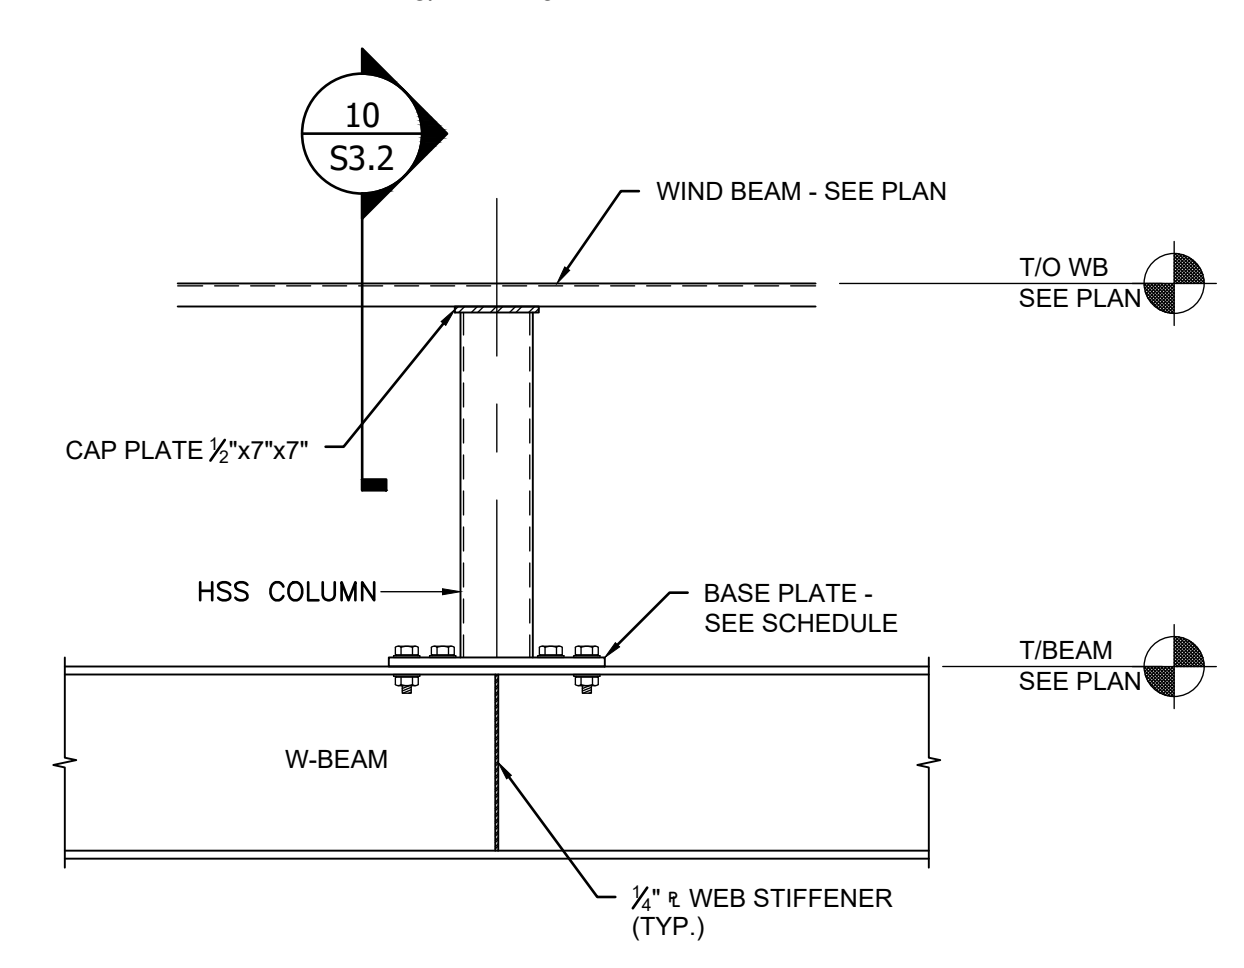


12 SECTION
S3.2
SCALE: 3/4" = 1'-0"

GMC
AS-BUILT


ISSUE	DATE
75% REVIEW	04/23/2019
95% REVIEW	05/02/2019
PERMIT	10/17/2019

EXCHANGE AT HOMEPLACE
PRATTVILLE, AL
GMC PROJECT#AMGM180037

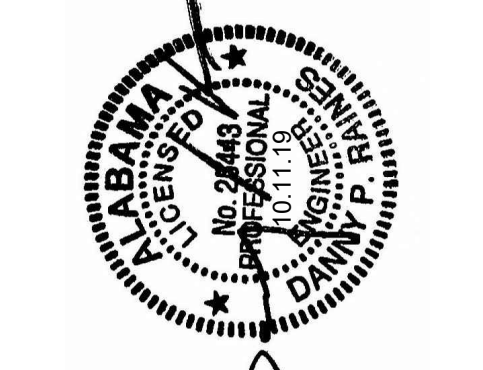

SECTIONS
S3.2

WD
WEATHERFORD & DAY
8150 OLD FEDERAL ROAD
MONTGOMERY, AL 36117
334.277.9550

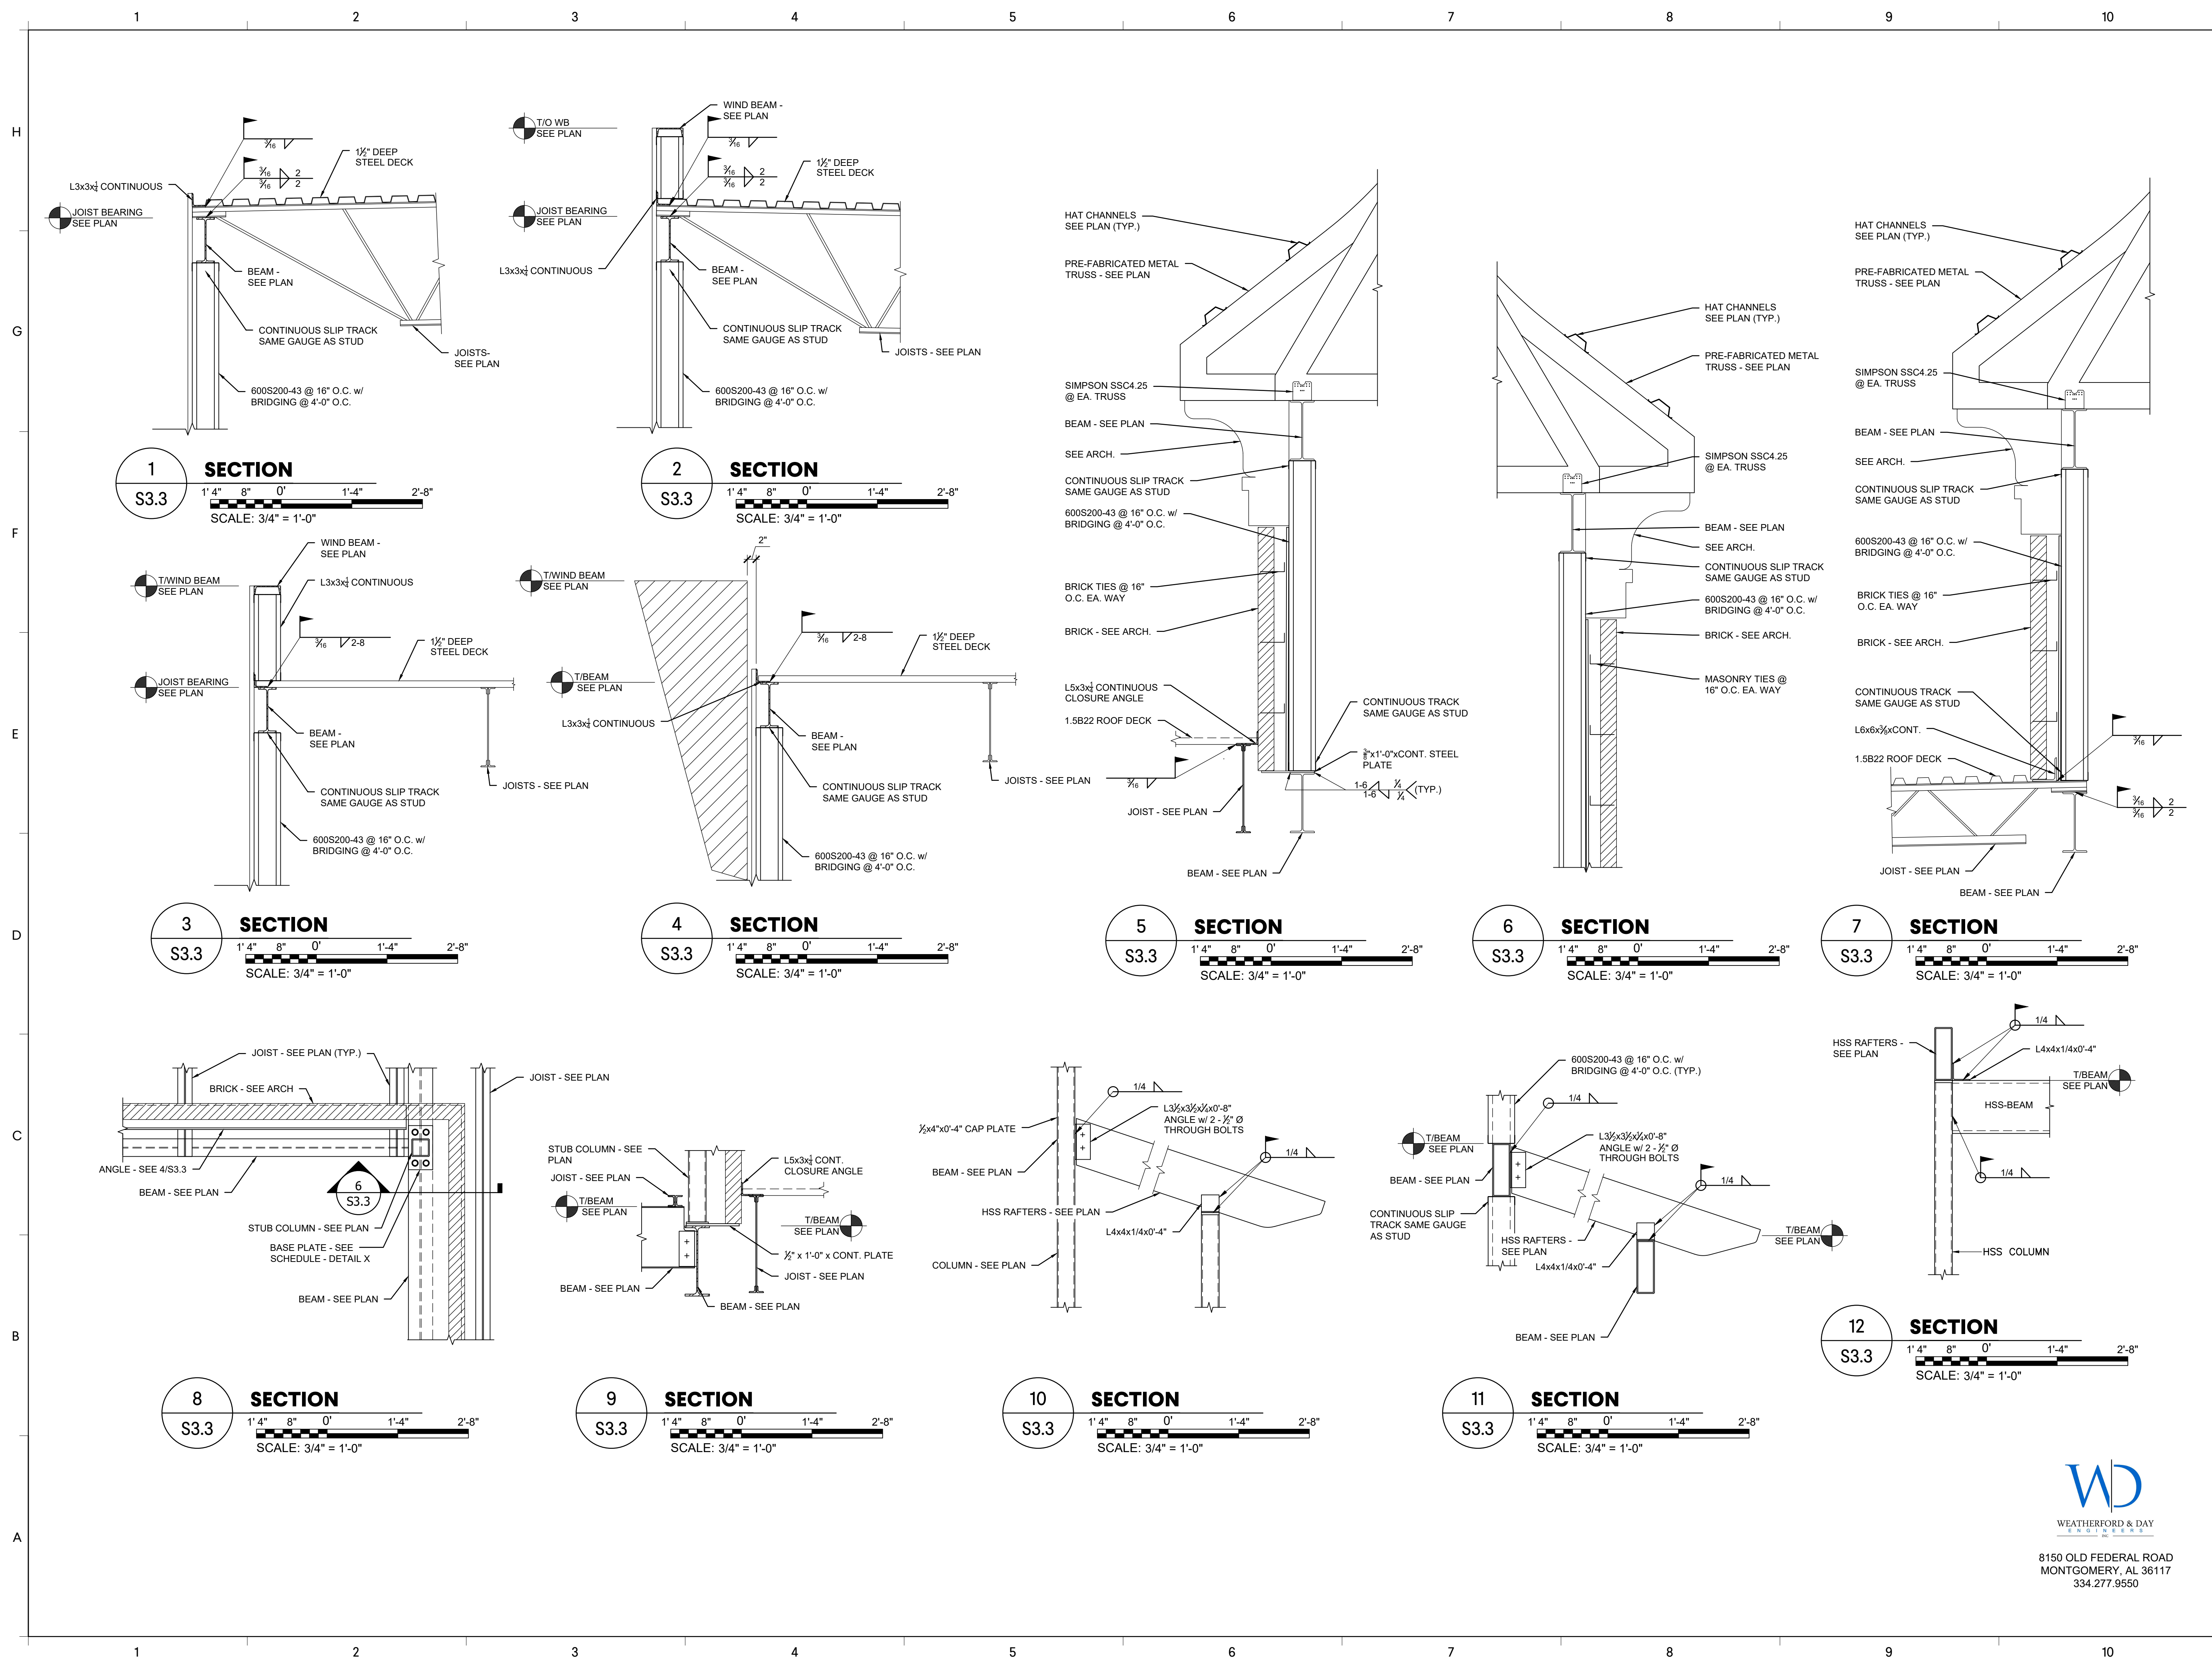


GMC
AS-BUILT

ISSUE	DATE	DESCRIPTION
04/23/2019	75% REVIEW	
05/30/2019	85% REVIEW	
10/17/2019	PERMIT	


DESIGNED BY: LGS
DRAWN BY: LGS
CHECKED BY: DPR

EXCHANGE AT HOMEPAGE
PRATTVILLE, AL
GMC PROJECT#AMGM180037

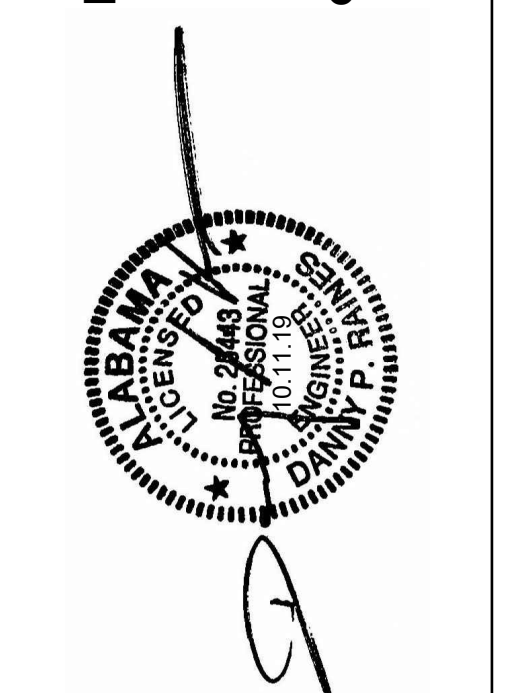

WD
WEATHERFORD & DAY
8150 OLD FEDERAL ROAD
MONTGOMERY, AL 36117
334.277.9550

SECTIONS
S3.3

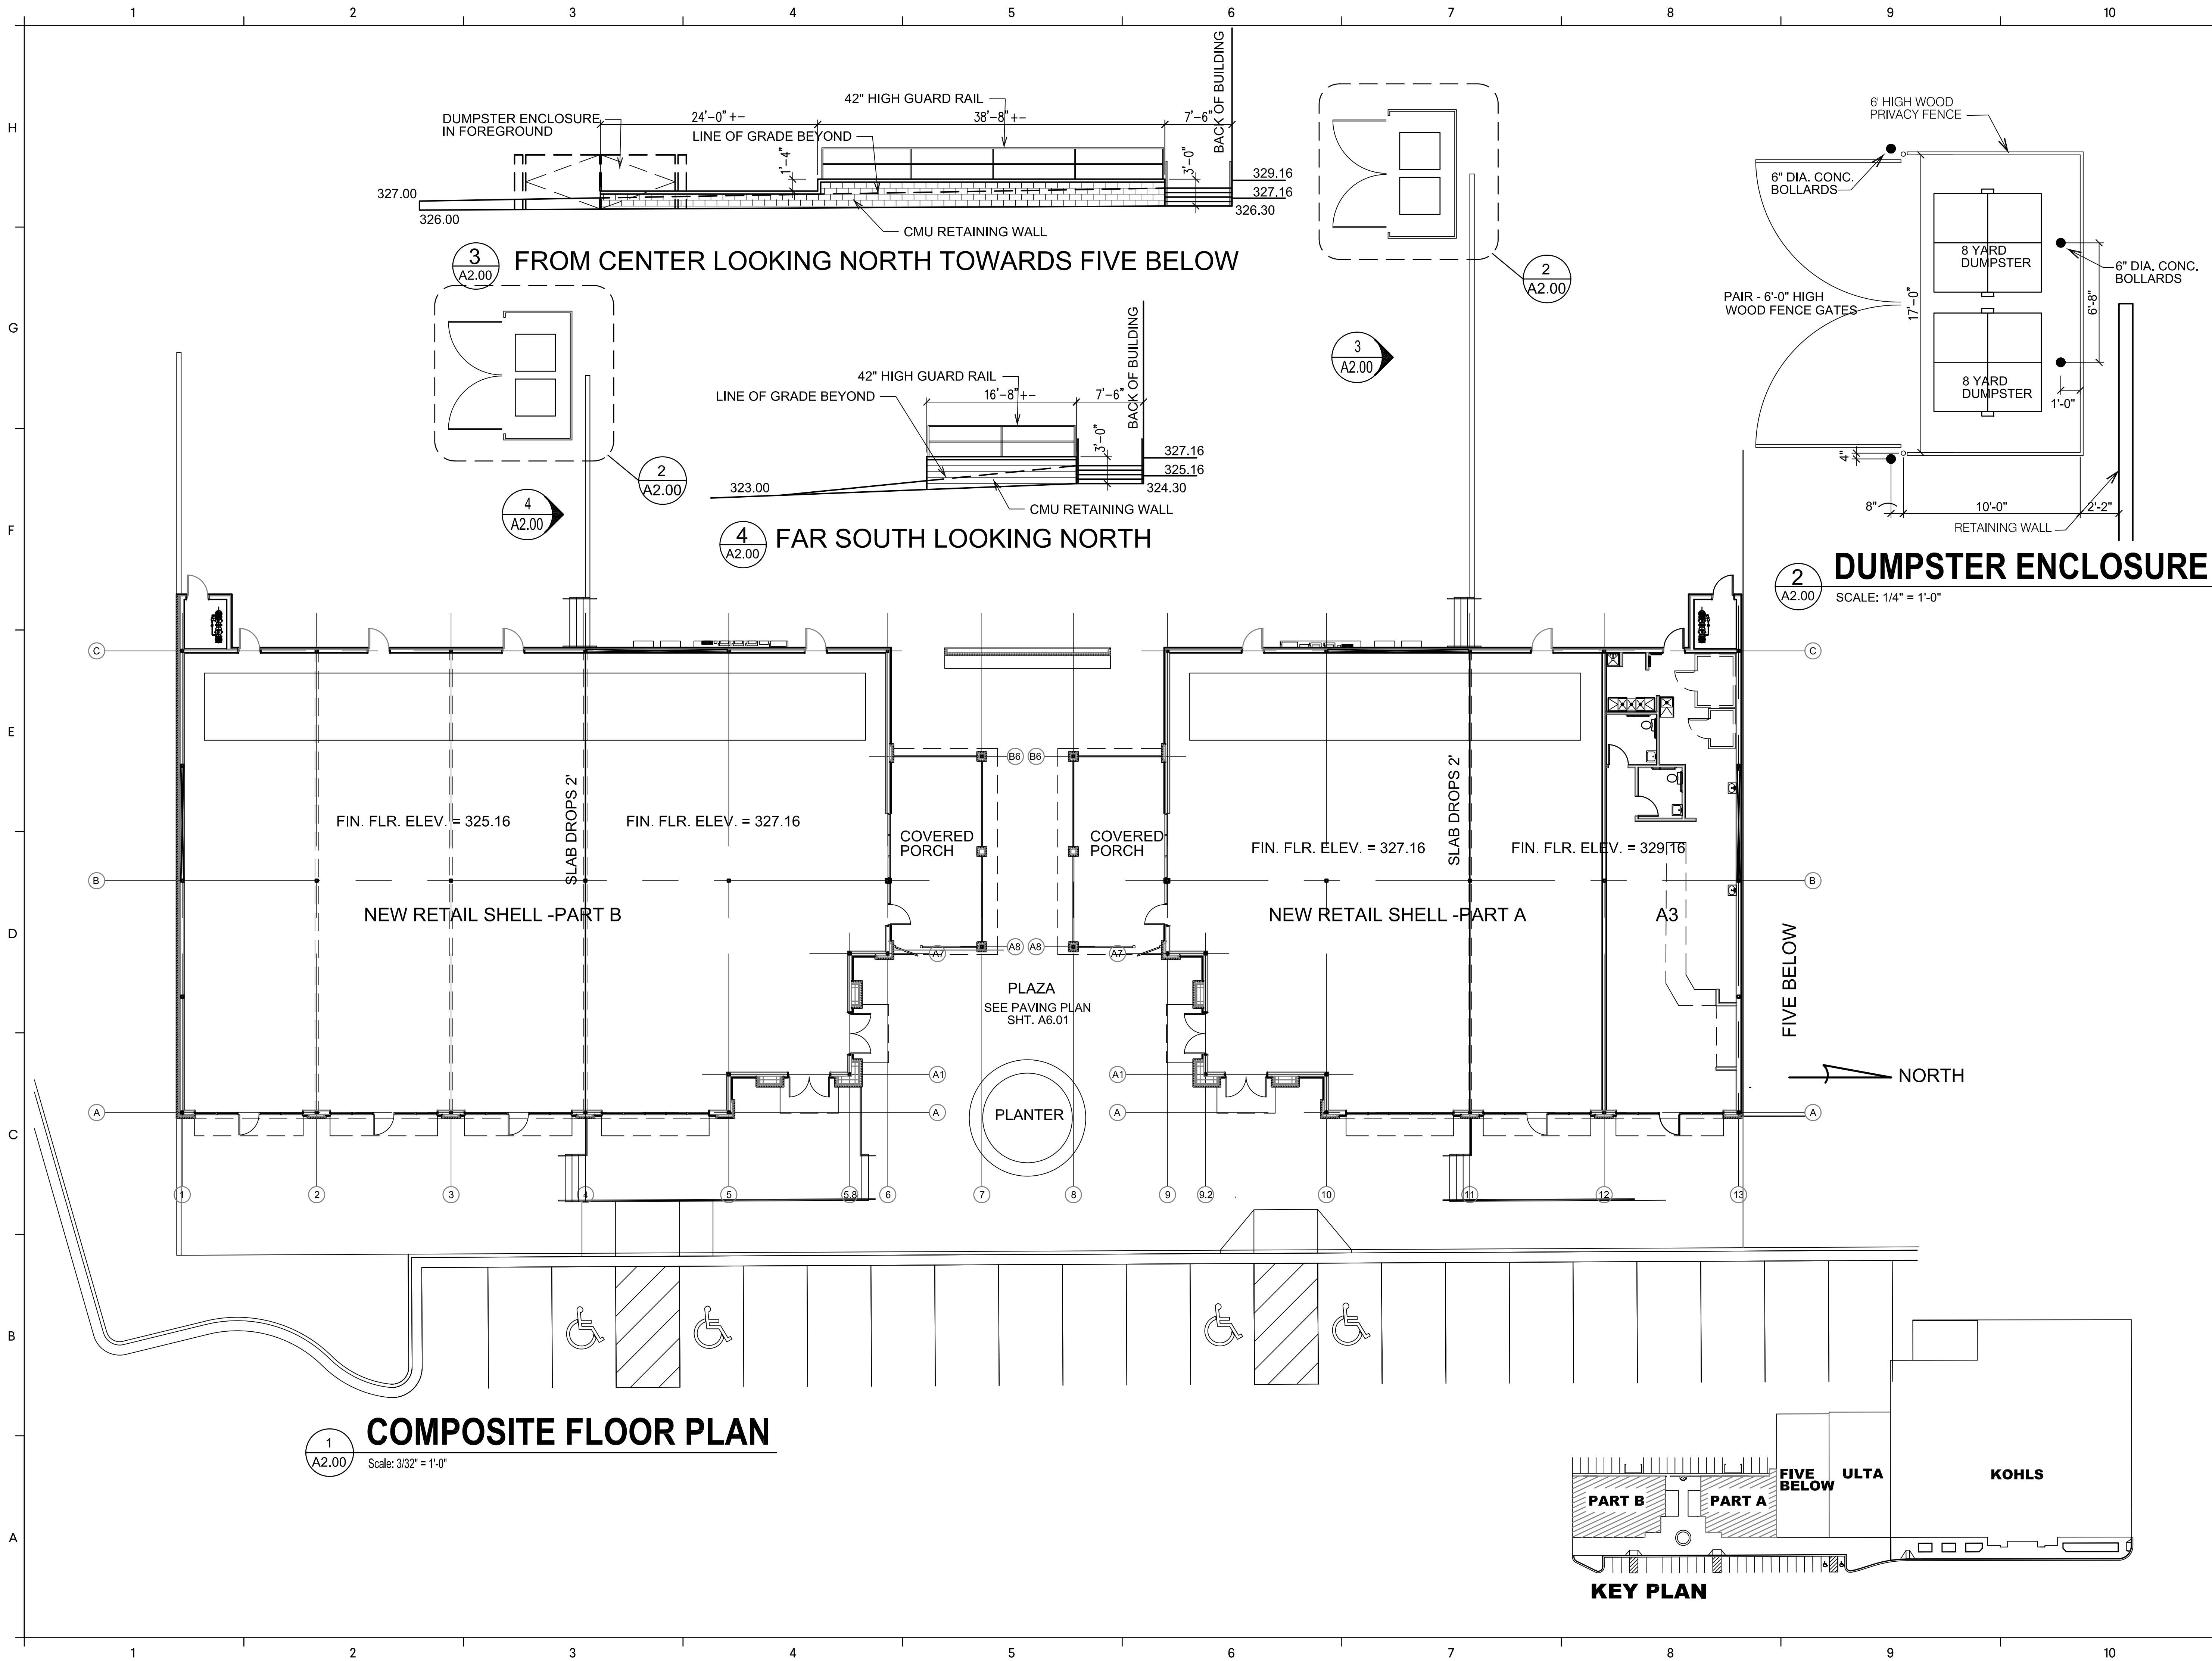


1
A2.00
COMPOSITE FLOOR PLAN
Scale: 3/32" = 1'-0"

3
A2.00
FROM CENTER LOOKING NORTH TOWARDS FIVE BELOW

4
A2.00
FAR SOUTH LOOKING NORTH

2
A2.00
DUMPSTER ENCLOSURE
SCALE: 1/4" = 1'-0"

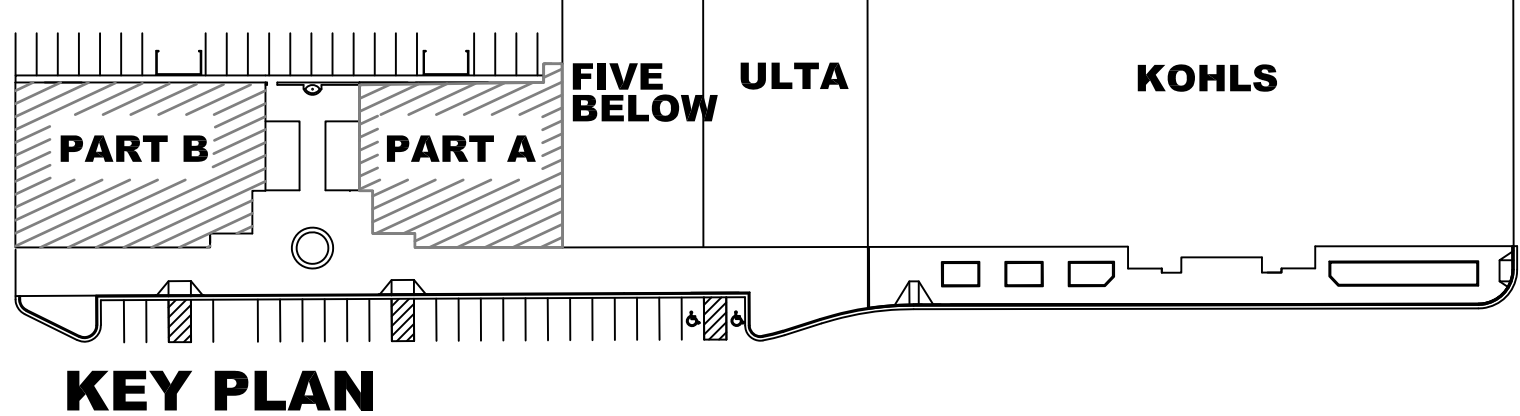

GMC

AS-BUILT


2660 East Chase Lane, Suite 200
Montgomery, AL 36117
T 334.271.3200
GMCNETWORK.COM

ISSUE	DATE
75% REVIEW	04/18/19
95% REVIEW	05/30/19
PERMIT SET	10/17/19

DESIGNED BY: GMC
DRAWN BY: GMC
CHECKED BY: GMC



THE EXCHANGE AT HOMEPLACE
PRATTVILLE, AL

GMC PROJECT #AMGM180037

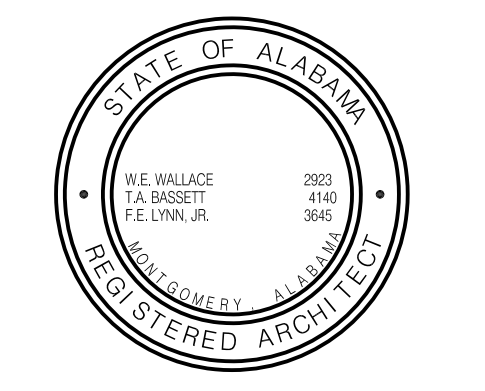

COMPOSITE FLOOR PLAN

A2.00
Sheet of

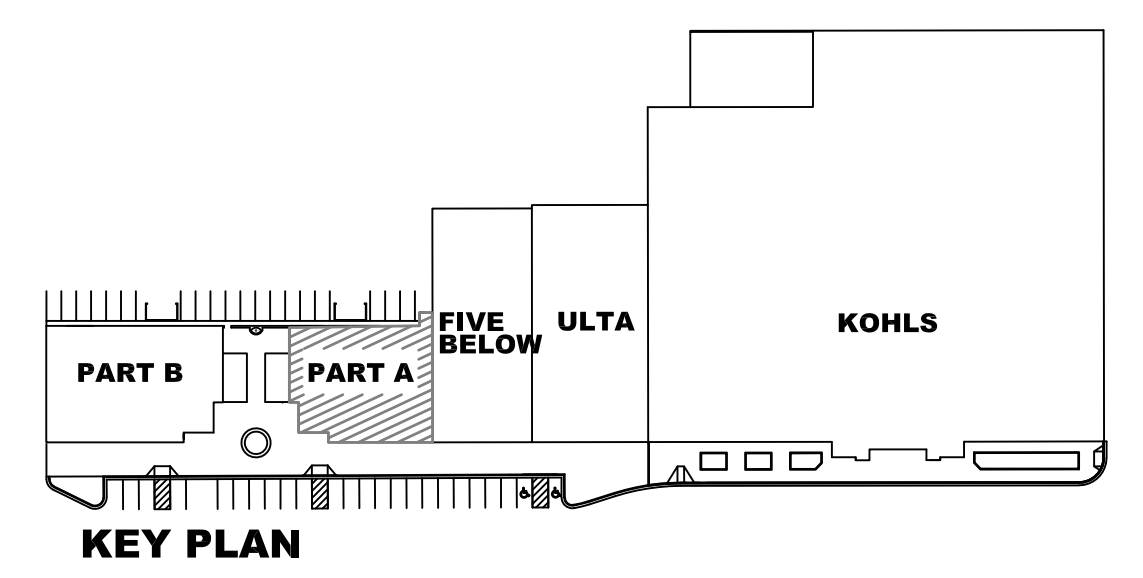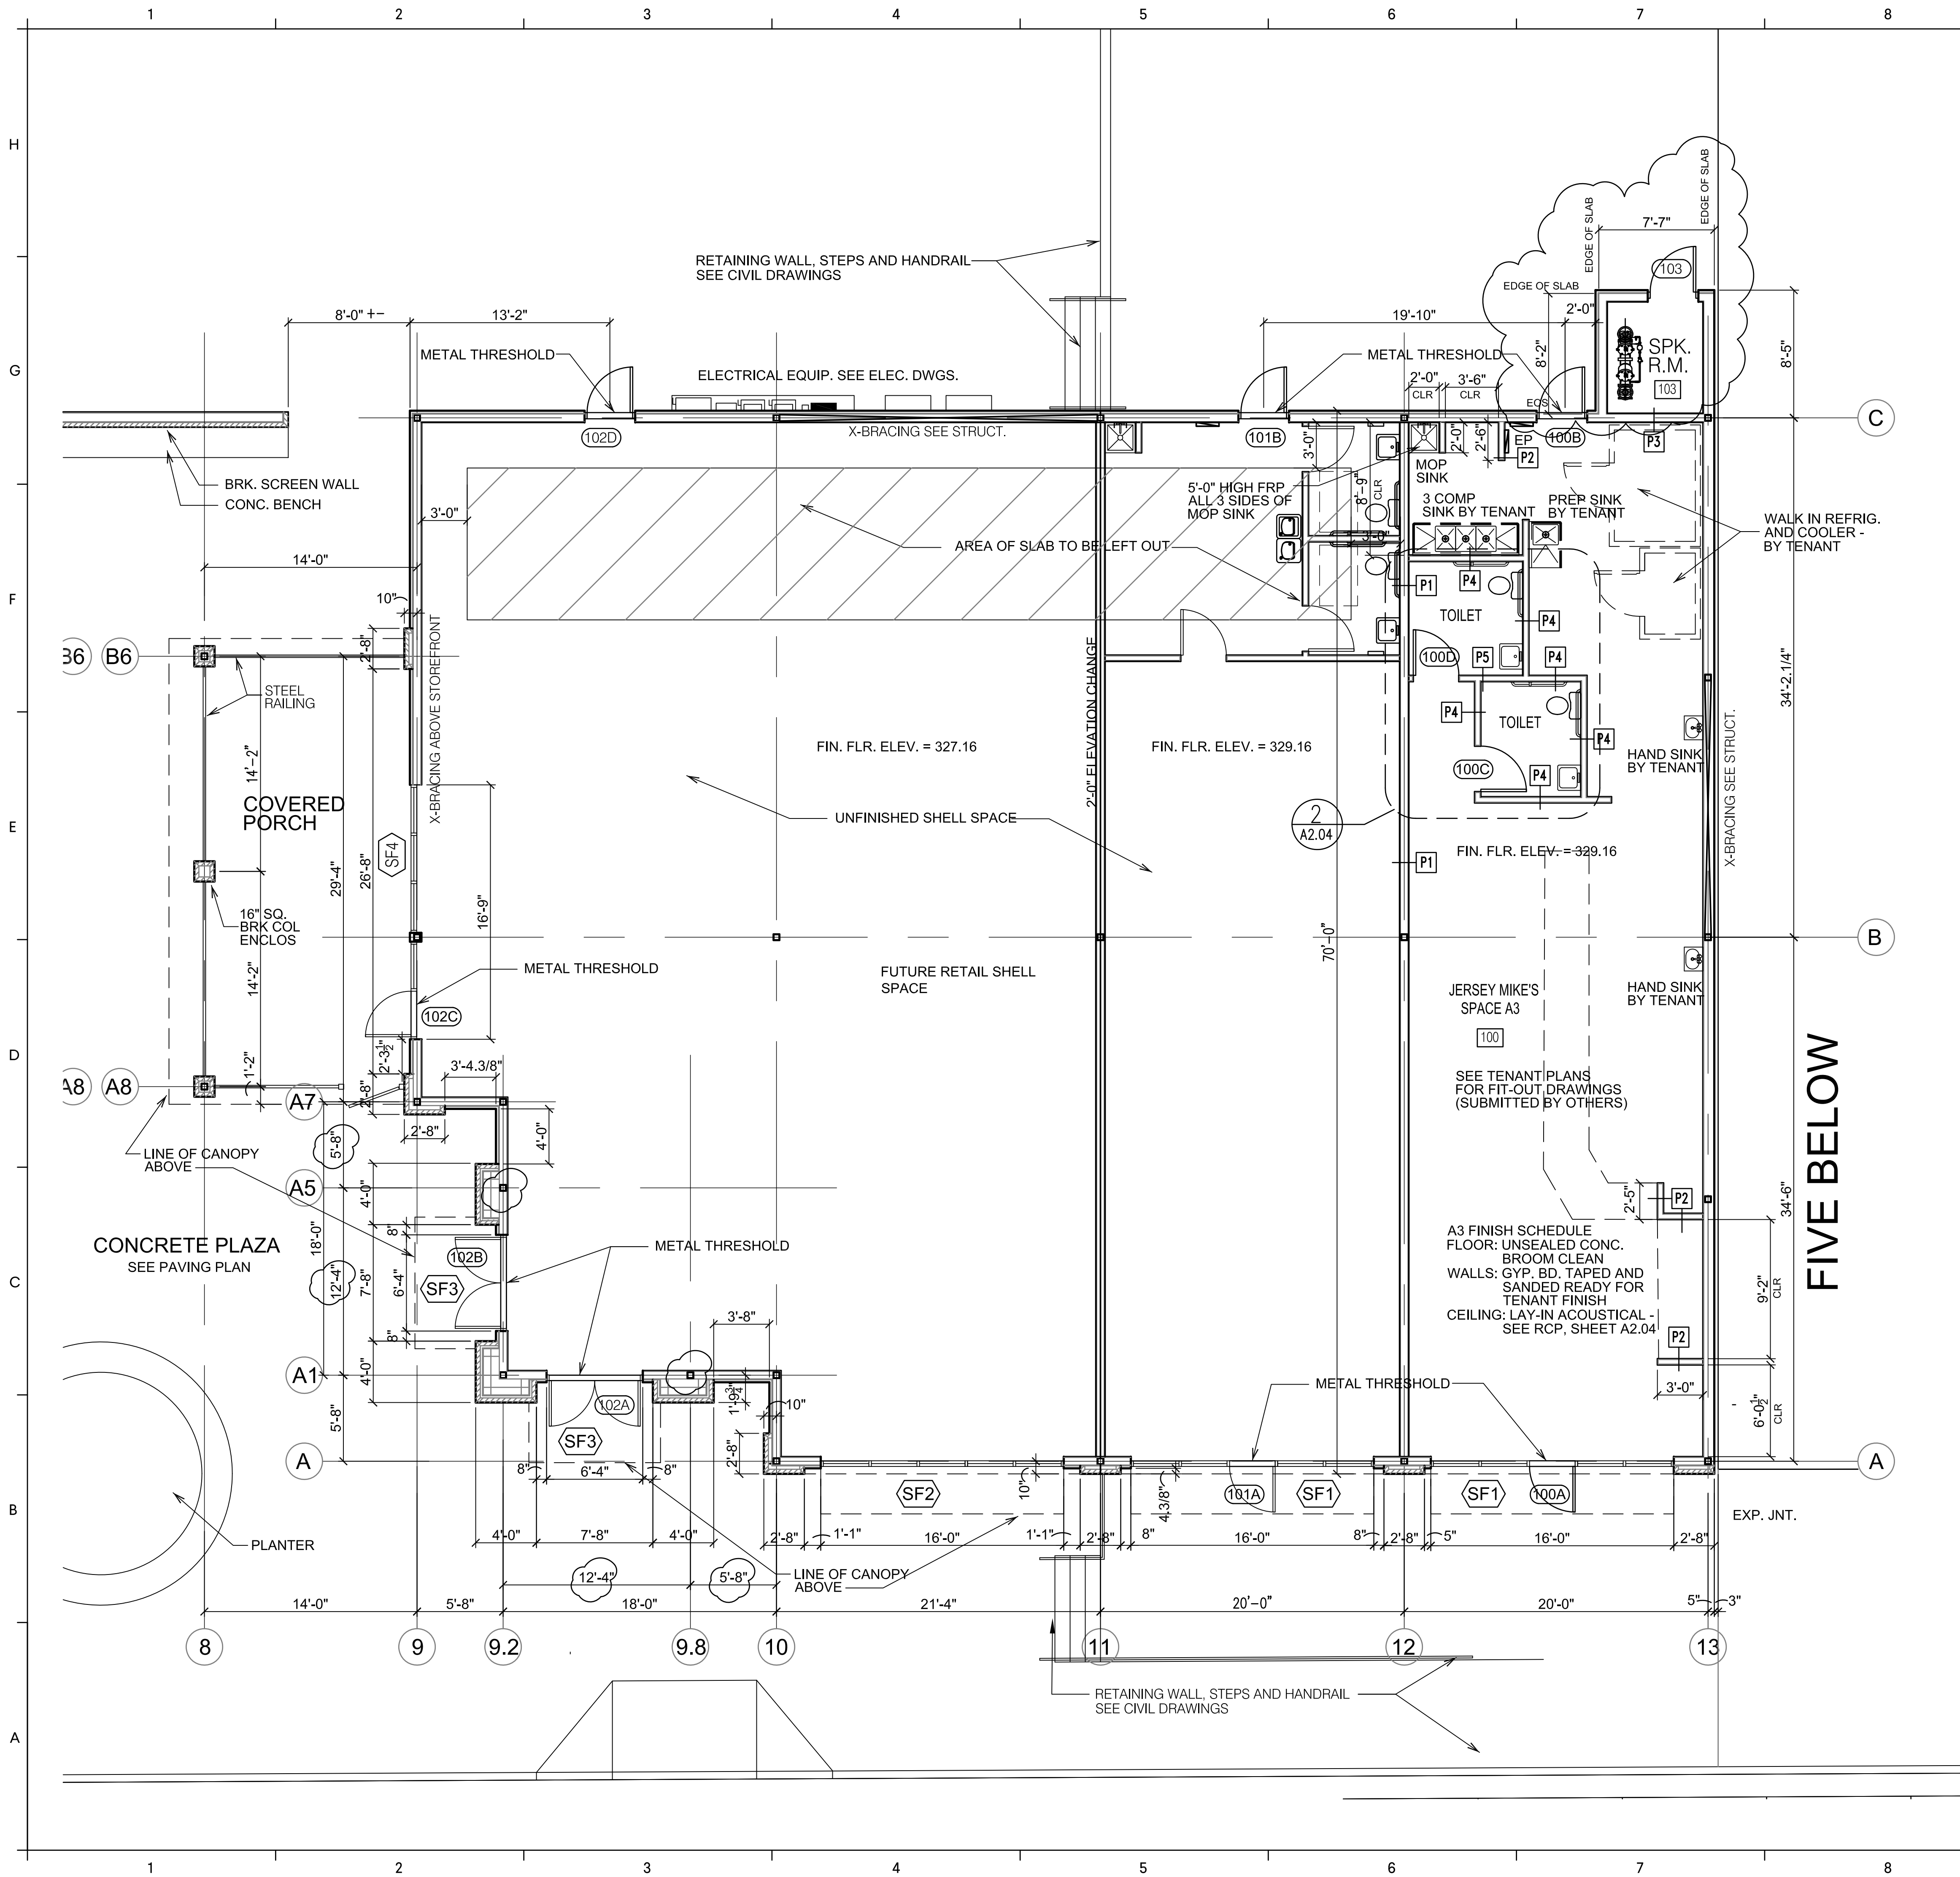


GMC
AS-BUILT

2660 East Chase Lane, Suite 200
 Montgomery, AL 36117
 T 334.271.3200
 GMCNETWORK.COM


ISSUE	DATE
75% REVIEW	04/18/19
95% REVIEW	05/20/19
PERMIT SET	10/17/19
REVISIONS	12/03/19

DESIGNED BY: GMC
 DRAWN BY: GMC
 CHECKED BY: JGMC


THE EXCHANGE AT HOMEPACE
 PRATTVILLE, AL
 GMC PROJECT #AMGM180037

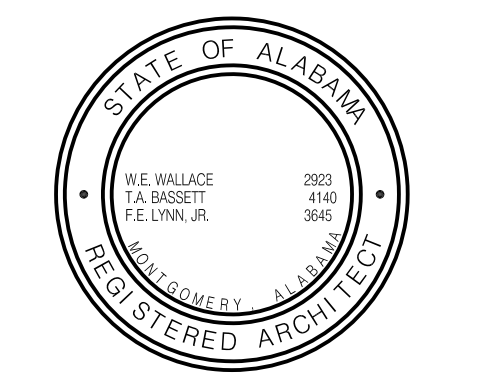

FLOOR PLAN - PART A
A2.01
 Sheet of

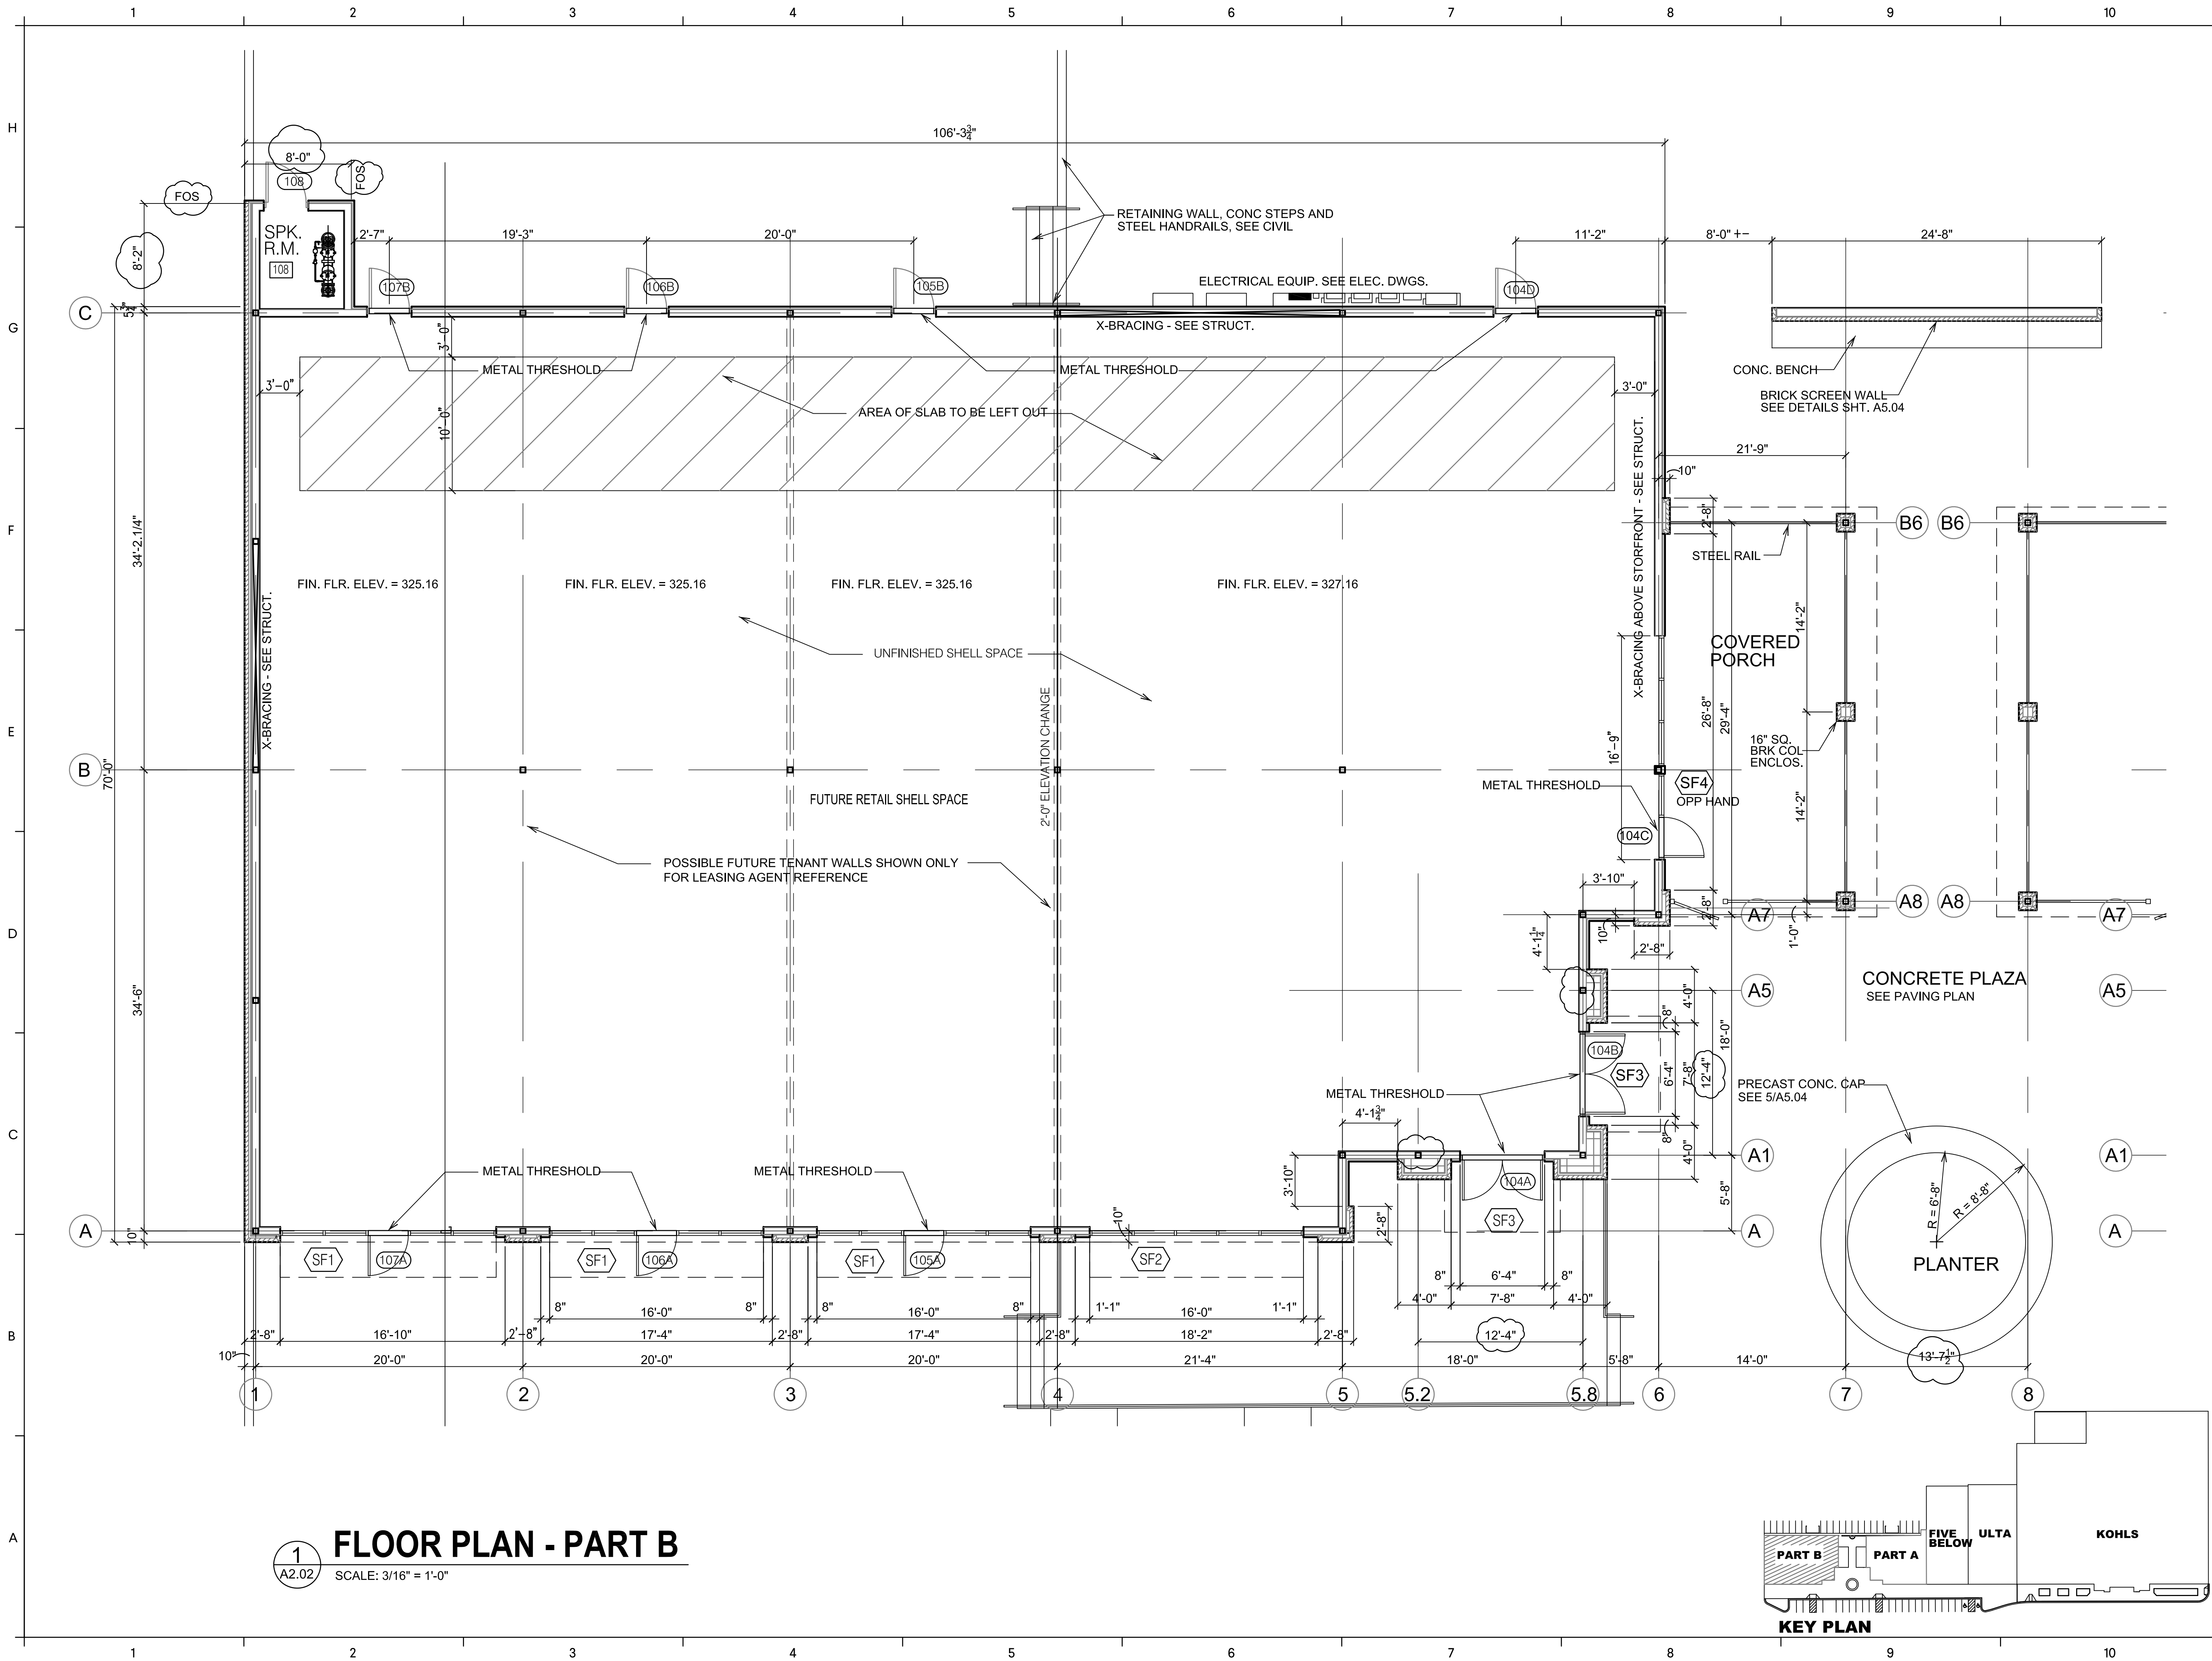

1 FLOOR PLAN - PART B
 SCALE: 3/16" = 1'-0"

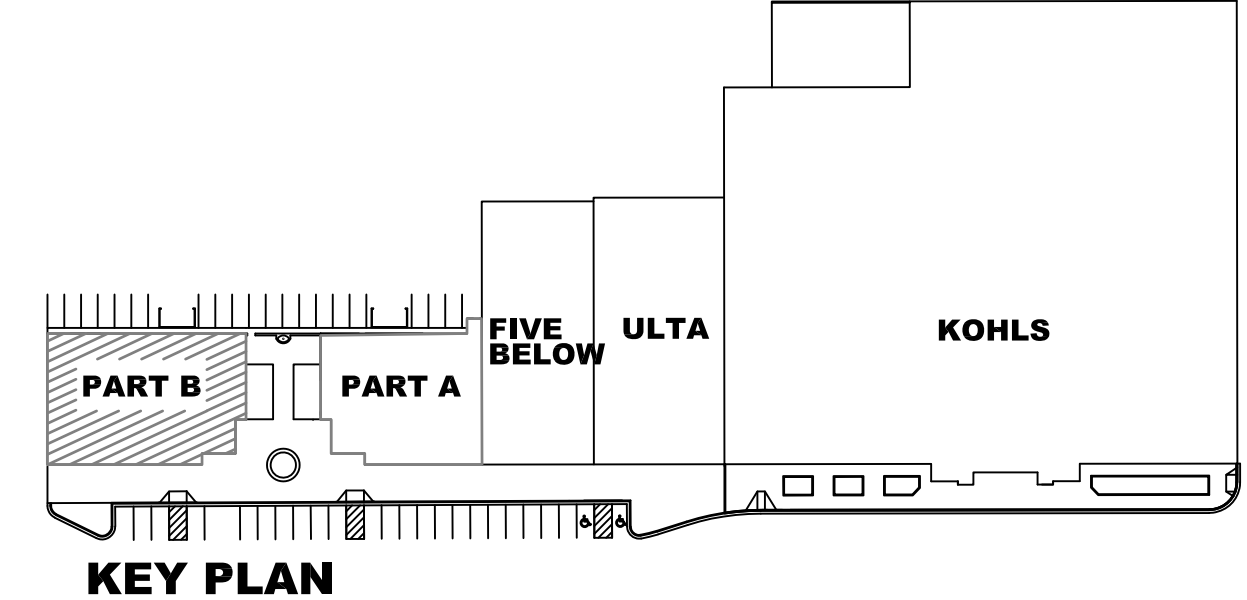

GMC


AS-BUILT

2660 East Chase Lane, Suite 200
 Montgomery, AL 36117
 T 334.271.3200
 GMCNETWORK.COM

ISSUE	DATE
75% REVIEW	04/18/19
95% REVIEW	05/30/19
PERMIT SET	10/17/19
REVISIONS	12/03/19

DESIGNED BY: GMC
 DRAWN BY: GMC
 CHECKED BY: JGMC

THE EXCHANGE AT HOMEPLACE
 PRATTVILLE, AL
 GMC PROJECT #AMGM180037

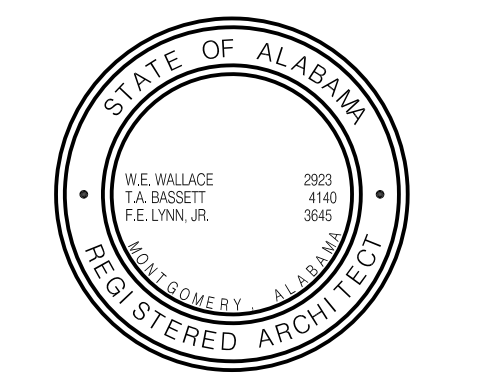

FLOOR PLAN - PART B

A2.02
 Sheet of

DOOR SCHEDULE - PARTS A & B

Table with columns: DOOR NO., LOCATION, SIZE, TYPE, MATERIAL, FINISH, FRAME, FINISH, HDW. SET, HEAD/JAMB, REMARKS. Rows include 100A-100D, 101A-101B, 102A-102D, 103, 104A-104C, 104D, 105A-105B, 106A-106B, 107A-107B, 108.

SET NO. 1 - ENTRY DOORS

NORTON #8501-H CLOSURE
PULL TO BE HAGER #P4E, 32D OR APPROVED EQ.
PUSH TO BE HAGER #80S, 32D OR APPROVED EQ.
LOCK TO BE 7 PIN BEST ACCEPTABLE CYLINDER W/TEE
TURN INSIDE & EXTERIOR CYLINDER GUARD,
MAJOR MANUF. #CGL-26D.
HOLD OPEN FOOT TO BE HAGER 270D - US26D.
FINISH TO MATCH STOREFRONT
WEATHERING PER MANUF. SPECS, INCLUDING FLOOR
SWEEPS
CHAINHOLD TO BE HAGER #300D-25 1/2" - US26D

SET NO. 2 - EXIT DOOR W/PANIC HARDWARE

NORTON #8501-H CLOSURE
TAMPER PROOF HINGES
ALUMINUM THRESHOLD
DETEX ECL-230D EXIT DEVICE
24" x 34" STAINLESS STEEL KICK PLATE
WEATHERSTRIPPING
RAIN GUARD ABOVE
HAGER 1755 180 DEGREE DOOR VIEWER
ALL HARDWARE TO ACCEPT A BEST 7 PIN CORE
BEST 7 PIN CONSTRUCTION CORE TO BE INSTALLED

SET NO. 3 - SPRINKLER RISER

CLOSER LCN 4041, ALUMINUM FINISH
HINGES TO BE IVES 5BB1-NRP, 626
LOCKSET SCHLAGE ND SERIES 20-022 RIM CYLINDER,
FINISH MATCH DOOR
EXIT DEVICE RIM-EXIT ONLY, HAGER 4500 SERIES 45NL ARC US26D
WEATHERING: 1885-H&J x 8198 AAX 142A
THRESHOLD 625A 626


SET NO. 4 - TOILET

3 HINGE TA2714 4.1/2" x 4.1/2" US26D MK
1 PRIVACY SET AU4707LN US26D YA
1 DOOR STOP 409 / 446 (AS REQUIRED) US32D RO



DOOR GENERAL NOTES:

- 1. ALL DOORS SHALL MEET A.D.A. REQUIREMENTS.
- 2. ALL DOOR THRESHOLDS SHALL NOT EXCEED 1/2" HEIGHT
- 3. PROVIDE SEALANT BOTH SIDES OF DOOR FRAMES, WHERE DIFFERENT MATERIALS MEET AND FOR WEATHER TIGHTNESS.
- 4. INSTALL FIBERGLASS INSULATION IN ALL EXTERIOR HOLLOW METAL DOOR FRAMES.
- 5. VERIFY ALL ROUGH OPENING REQUIREMENT WITH MANUFACTURES DRAWINGS.
- 6. DOOR, FRAME AND HARDWARE SCHEDULE TO BE PROVIDED BY HARDWARE SUPPLIER FOR A/E REVIEW - NUMBERING SYSTEM AND NOMENCLATURE SHALL MATCH THOSE FOUND IN CONSTRUCTION DOCUMENTS.
- 7. HARDWARE SUPPLIER IS RESPONSIBLE FOR COORDINATING KEYING REQUIREMENTS WITH OWNER.
- 8. ALUMINUM SUPPLIER SHALL FURNISH AND INSTALL ALL HARDWARE FOR ALUMINUM DOORS AS NOTED ON PLANS - THE SAME MANUFACTURES AND MODELS SHALL BE USED FOR BOTH ALUMINUM AND OTHER DOOR HARDWARE.
- 9. CONTRACTOR TO PROVIDE PRODUCTS AND SYSTEMS COMPLETE WITH ALL ACCESSORIES, TRIM, FINISH, FASTENERS AND OTHER ITEMS NEEDED FOR A COMPLETE INSTALLATION AND INTENDED USE AND EFFECT.
- 10. FERROUS METAL (PAINTED) - DOORS, FRAMES, HANDRAILS & MISC. METALS:
a. (1) COAT SW KEM KROMIC UNIVERSAL METAL PRIMER, B50WZ SERIES
b. (2) COSTS PRO MAR 200 ALKYD ENAMEL EG-SHEL OR SEMI GLOSS B33 OR B34 SERIES.


DOOR TYPES

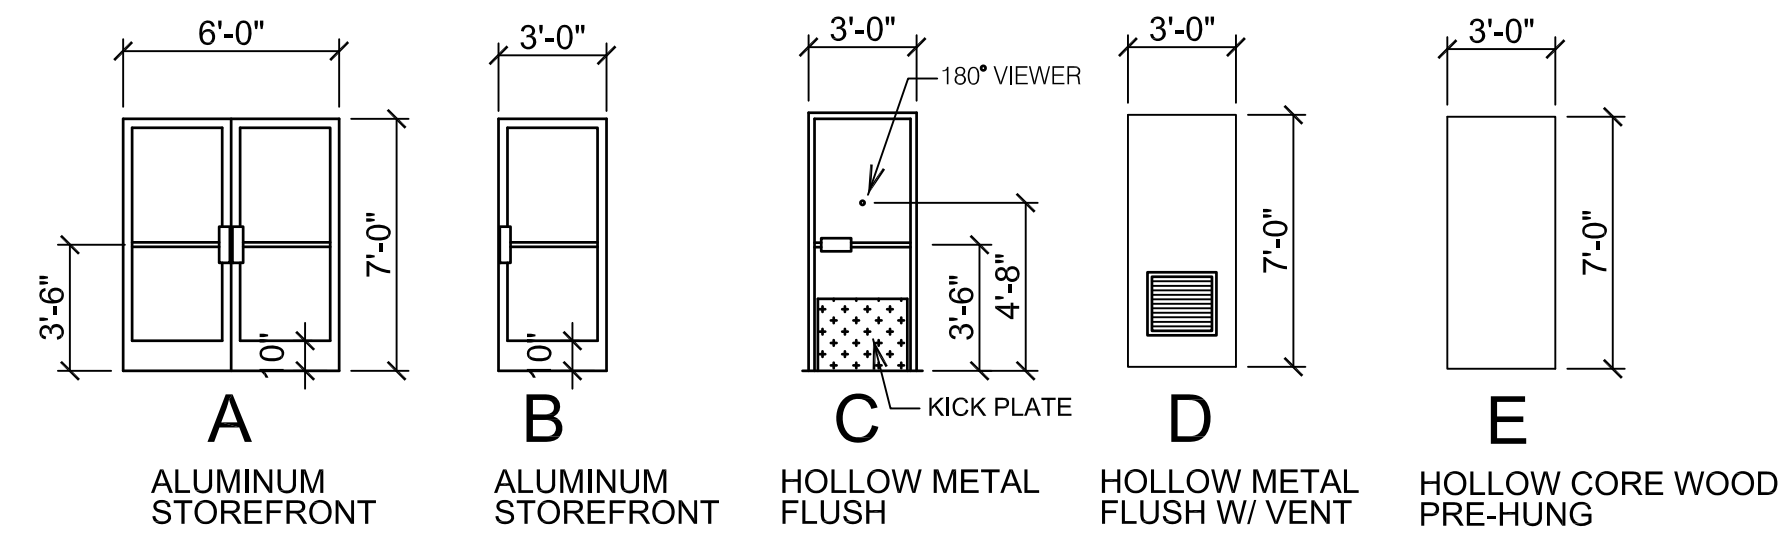


STOREFRONT ELEVATIONS

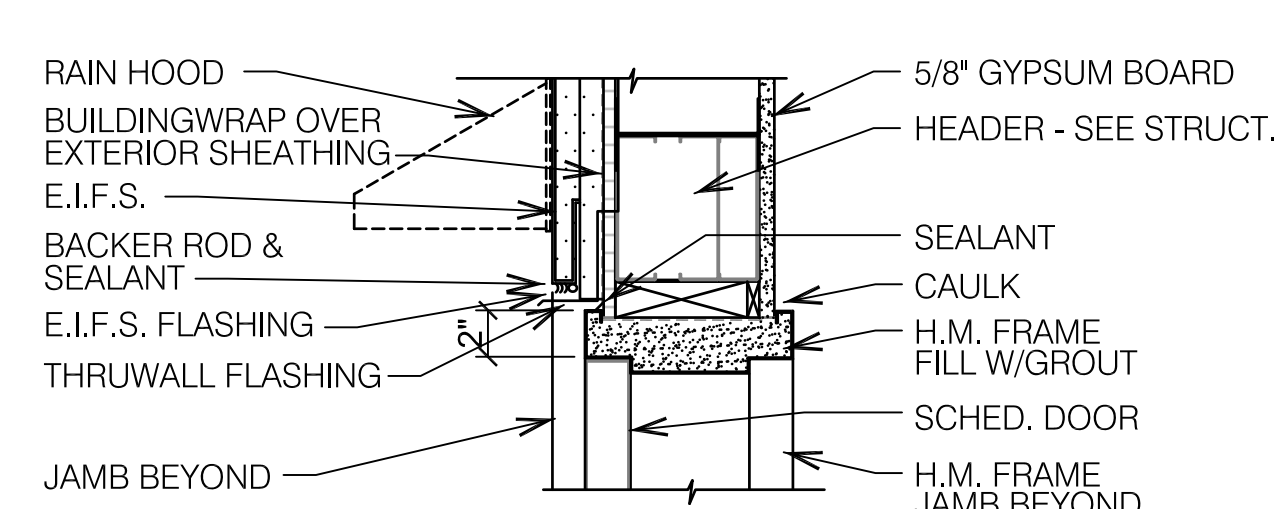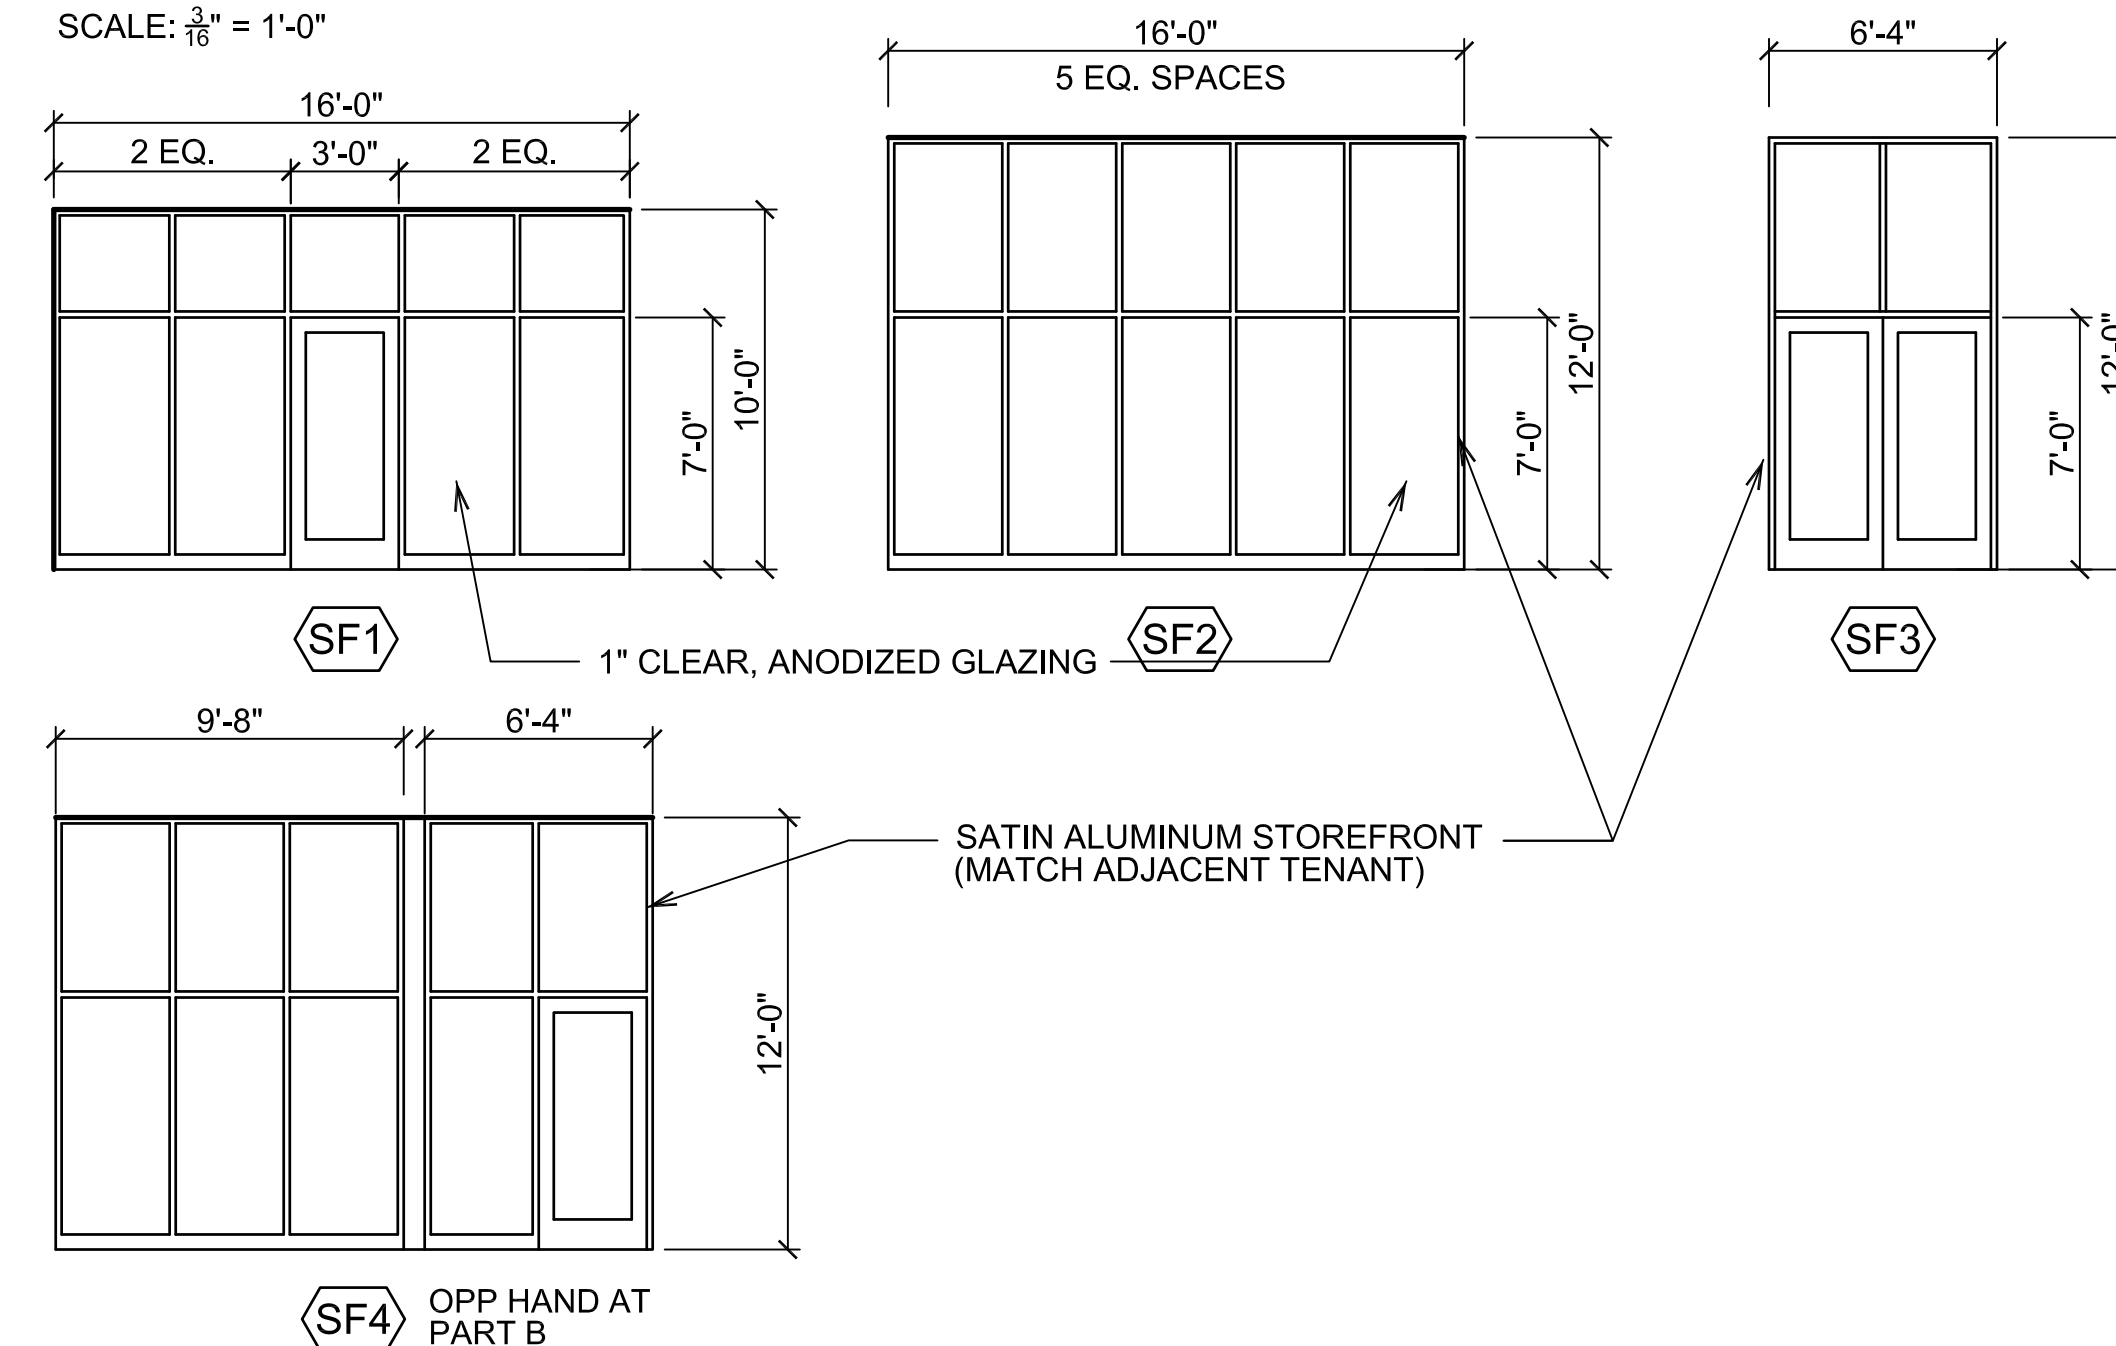


1 DOOR HEAD SCALE: 1-1/2" = 1'-0"

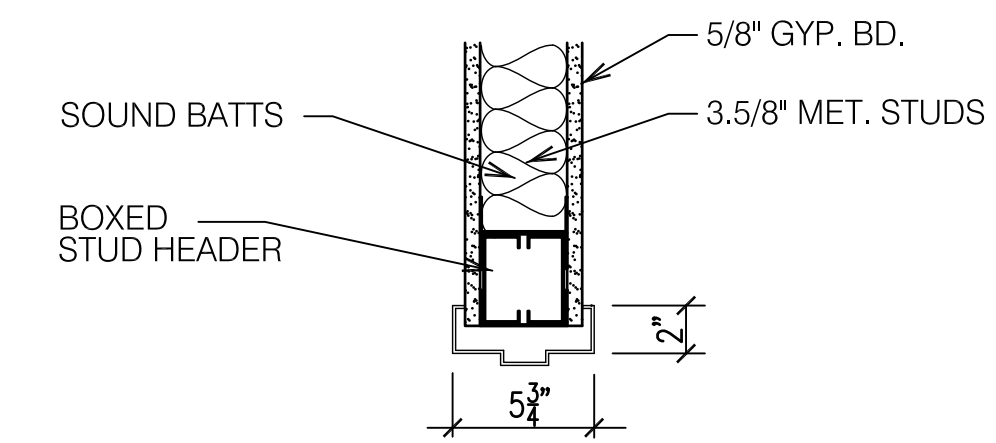


3 DOOR HEAD SCALE: 1-1/2" = 1'-0"

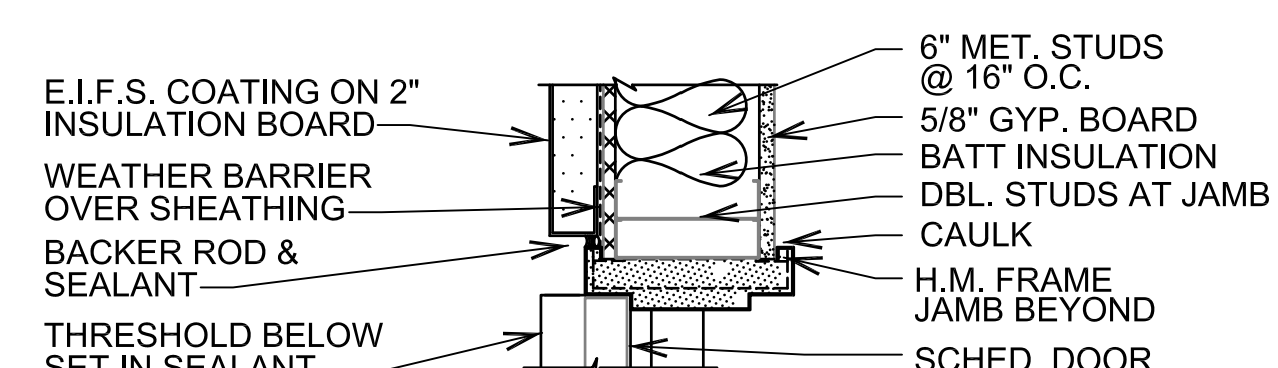

2 DOOR JAMB SCALE: 1-1/2" = 1'-0"

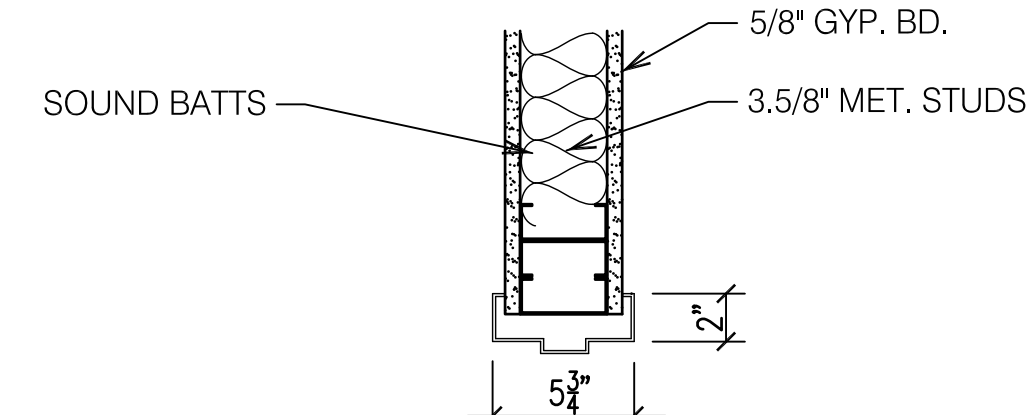

4 DOOR JAMB SCALE: 1-1/2" = 1'-0"

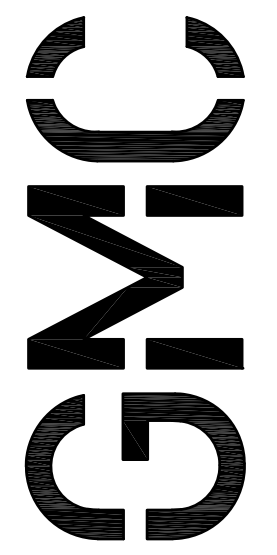

AS-BUILT

2660 East Chase Lane, Suite 200
Montgomery, AL 36117
T 334.271.3200
GMCNETWORK.COM

ISSUE / DATE

Table with columns: ISSUE / DATE, 75% REVIEW 04/18/19, 95% REVIEW 05/20/19, PERMIT SET 10/17/19, DESIGNED BY: GMC, DRAWN BY: GMC, CHECKED BY: GMC


THE EXCHANGE AT HOMEPLACE
PRATTVILLE, AL

GMC PROJECT#AMGM180037




SCHEDULES / DETAILS

A2.03
Sheet of

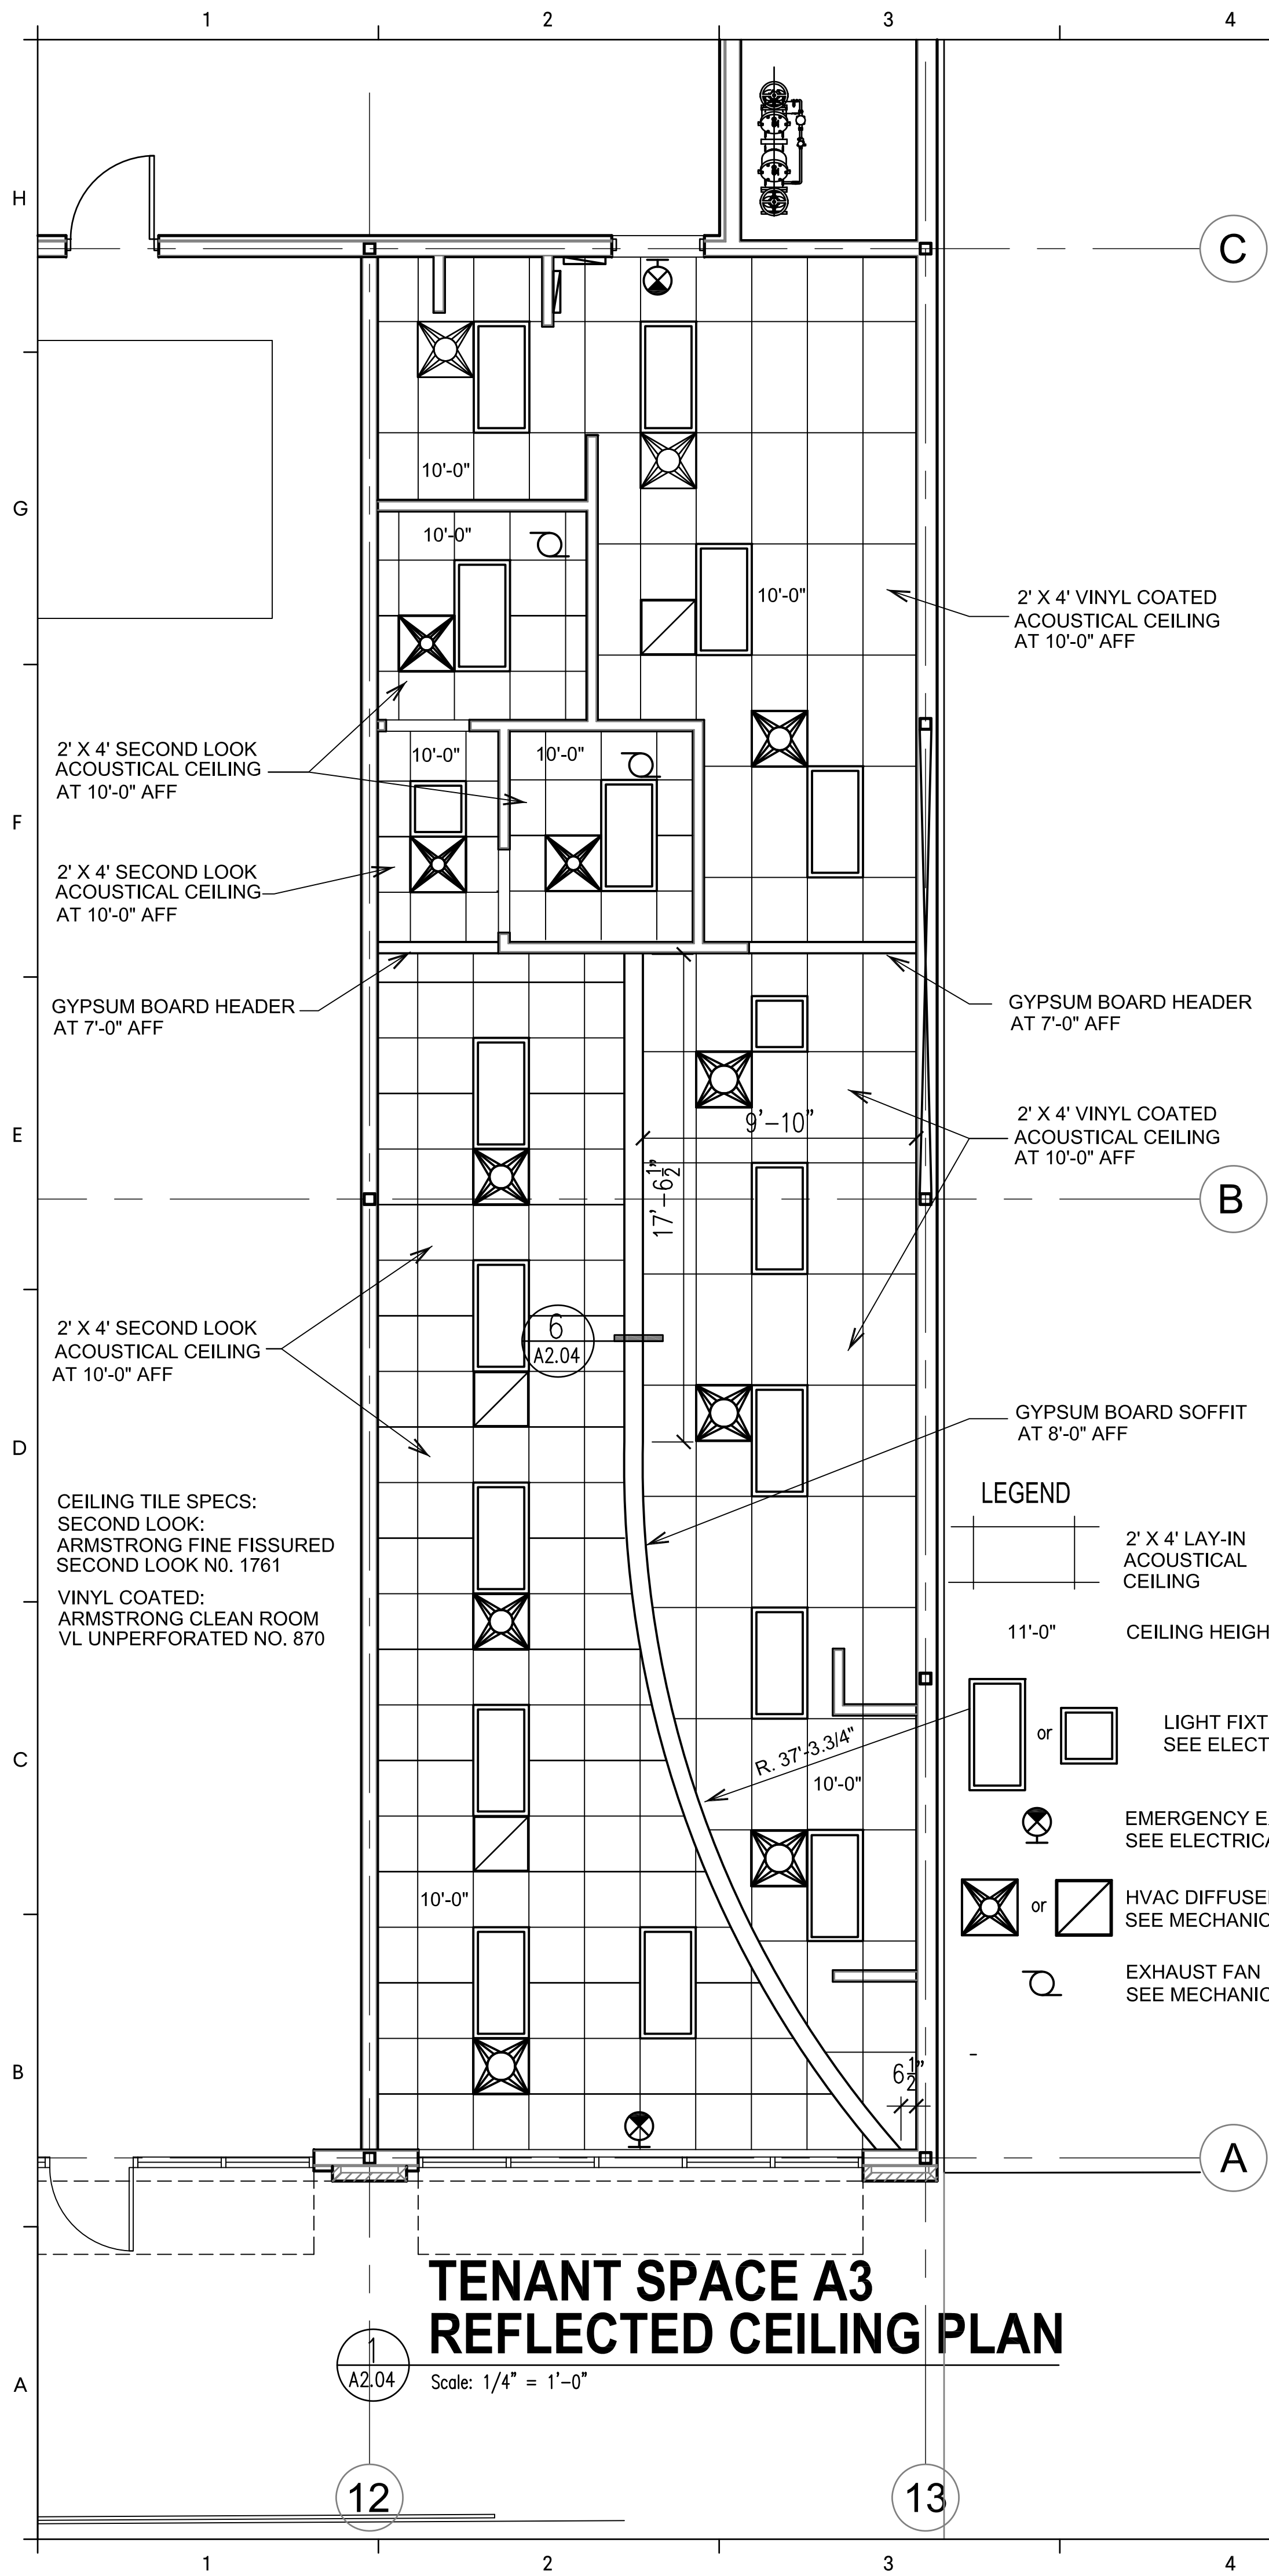


TENANT SPACE A3 REFLECTED CEILING PLAN
 Scale: 1/4" = 1'-0"

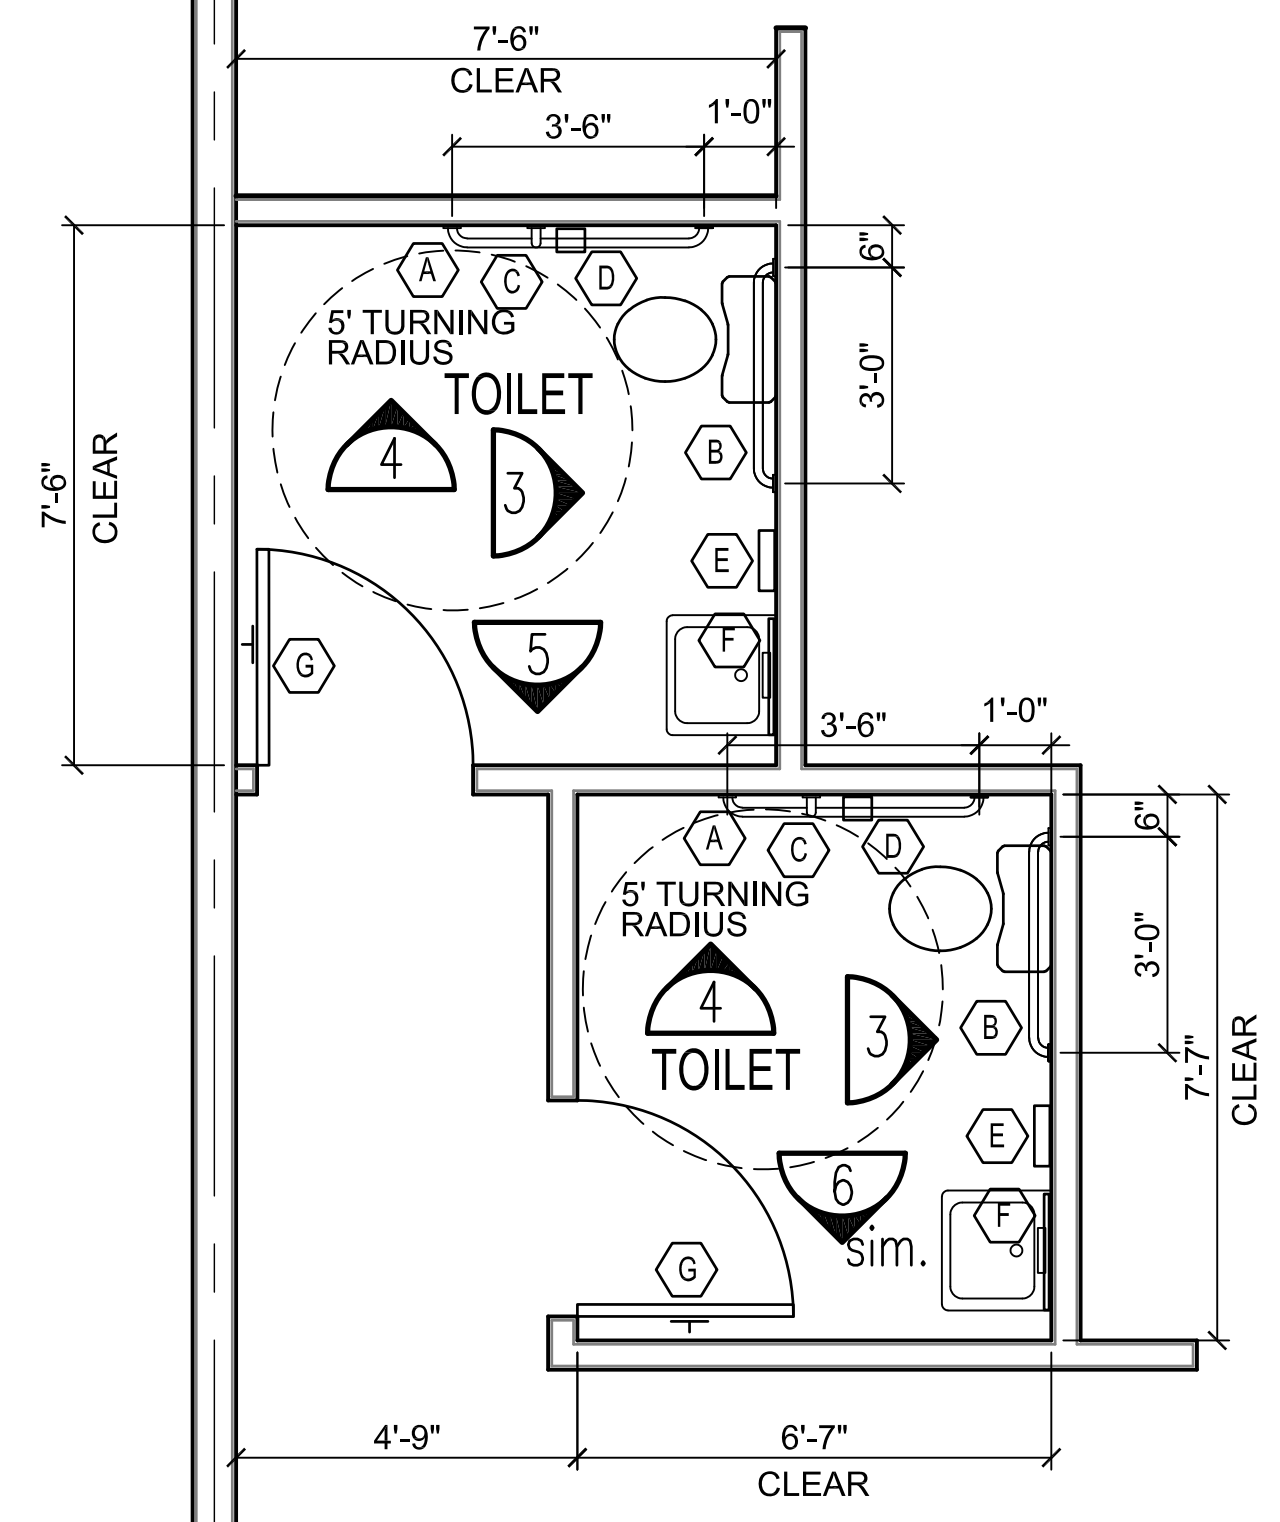

TENANT SPACE A3 TOILET PLANS
 Scale: 3/8" = 1'-0"


TOILET ACCESSORY LEGEND

A	42" LONG GRAB BAR	ASI 6806-42P OR EQ.
B	36" LONG GRAB BAR	ASI 6806-36P OR EQ.
C	18" VERT. GRAB BAR	ASI 6806-18P OR EQ.
D	TOILET PAPER DISPENSER	ASI 0715 OR EQ.
E	PAPER TOWEL DISPENSER	ASI 0210 OR EQ.
F	METAL FRAMED MIRROR	ASI 0620-2436 OR EQ.
G	COAT HOOK	ASI 8425 OR EQ.
H	MOP RACK	ASI 1315-3 OR EQ.

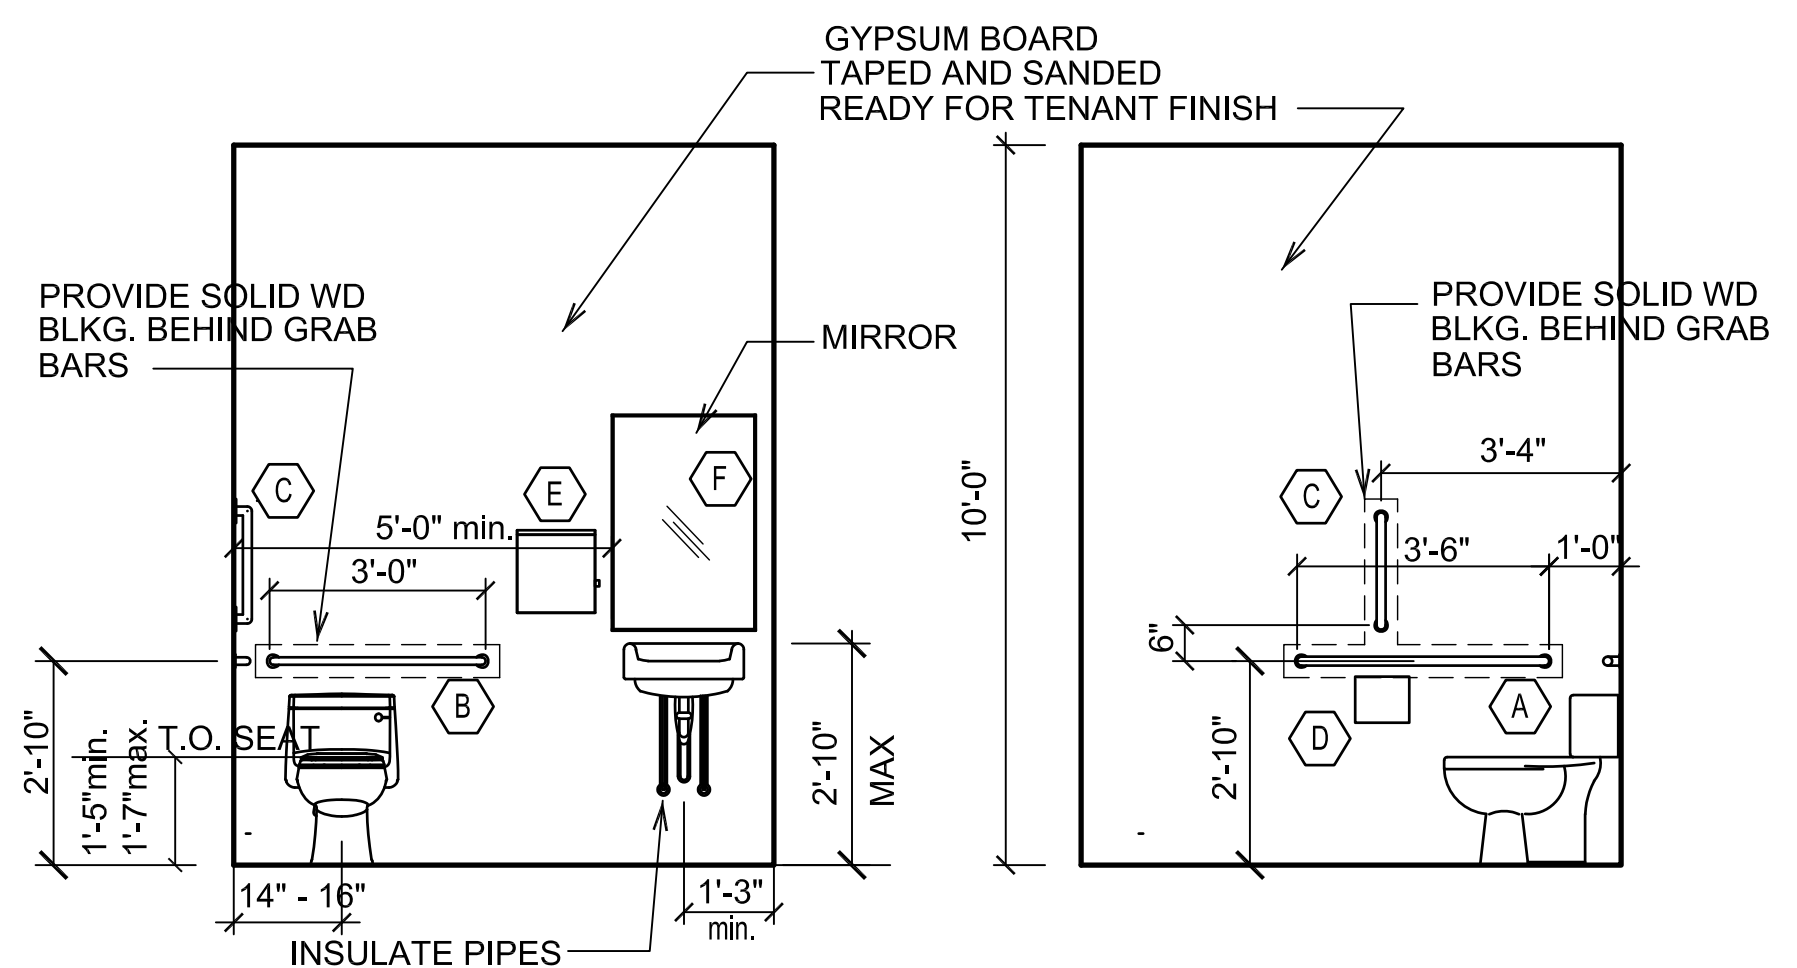


ELEV. 3
 Scale: 3/8" = 1'-0"

ELEV. 4
 Scale: 3/8" = 1'-0"


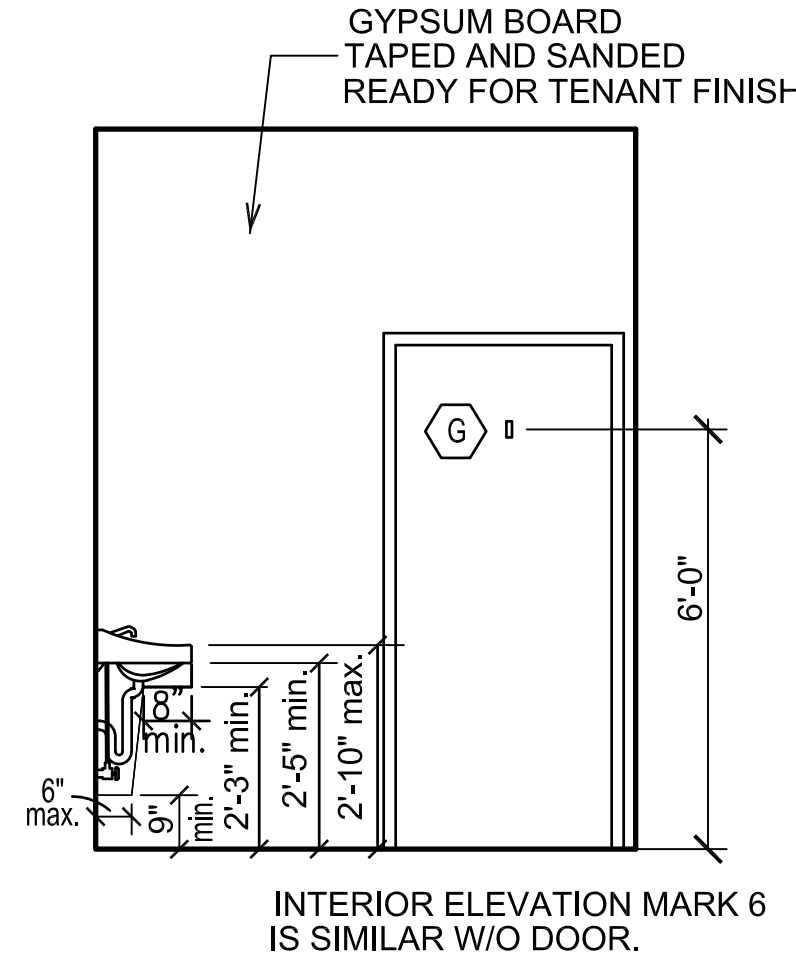


ELEV. 5
 Scale: 1/4" = 1'-0"

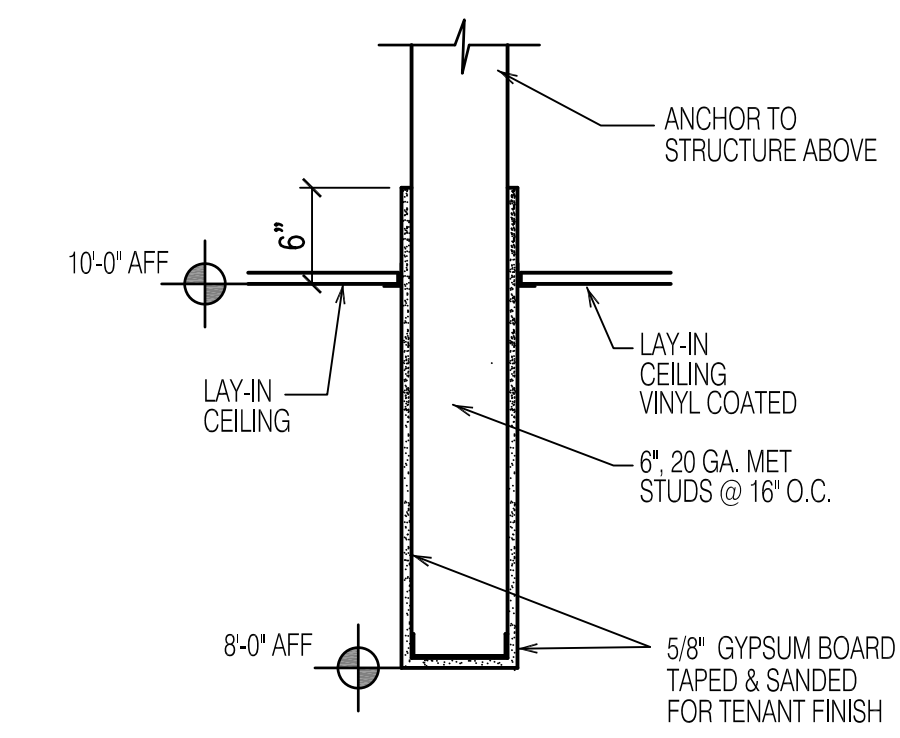

SOFFIT DETAIL
 Scale: 1" = 1'-0"

TENANT SPACE A3 PARTITION TYPES

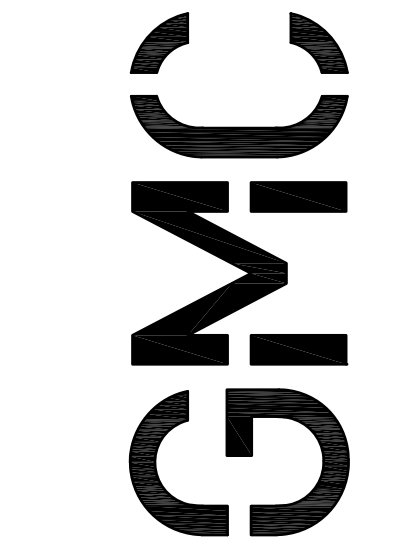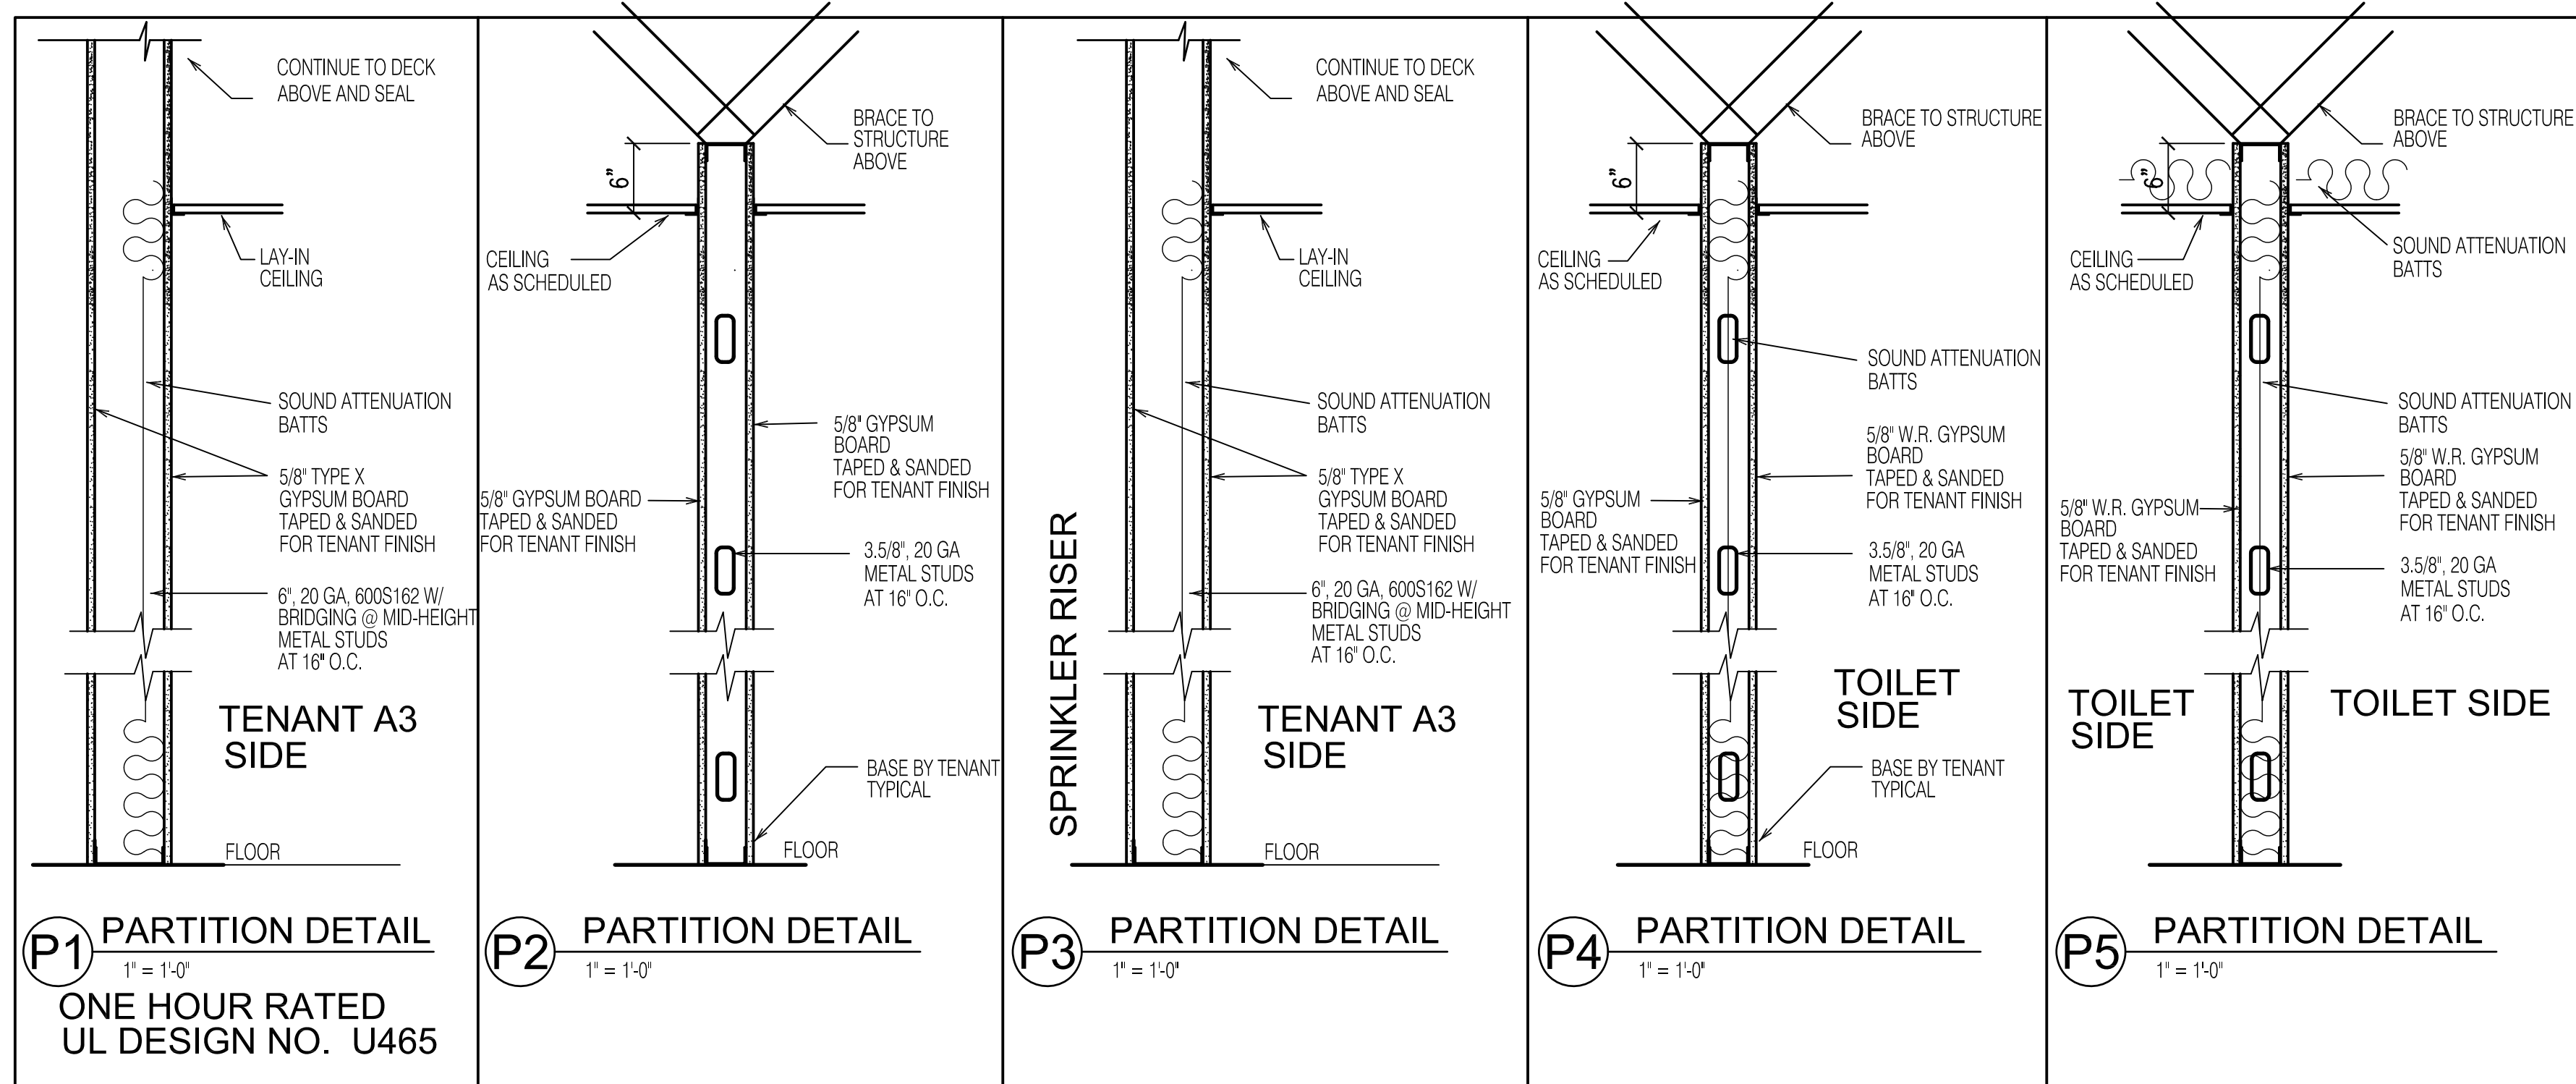


AS-BUILT


2660 East Chase Lane, Suite 200
 Montgomery, AL 36117
 T 334.271.3200
 GMCNETWORK.COM

ISSUE	DATE
75% REVIEW	04/18/19
95% REVIEW	05/20/19
PERMIT SET	10/17/19
DESIGNED BY:	GMC
DRAWN BY:	GMC
CHECKED BY:	JGMC

THE EXCHANGE AT HOMEPLACE
 PRATTVILLE, AL
 GMC PROJECT#AMGM180037

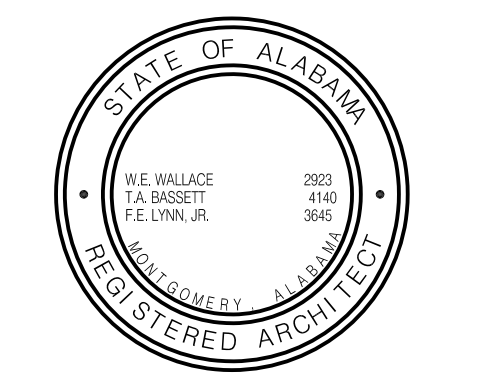

TENANT SPACE A3 REFLECTED CEILING PLAN ELEVATIONS AND DETAILS
 A2.04
 Sheet of

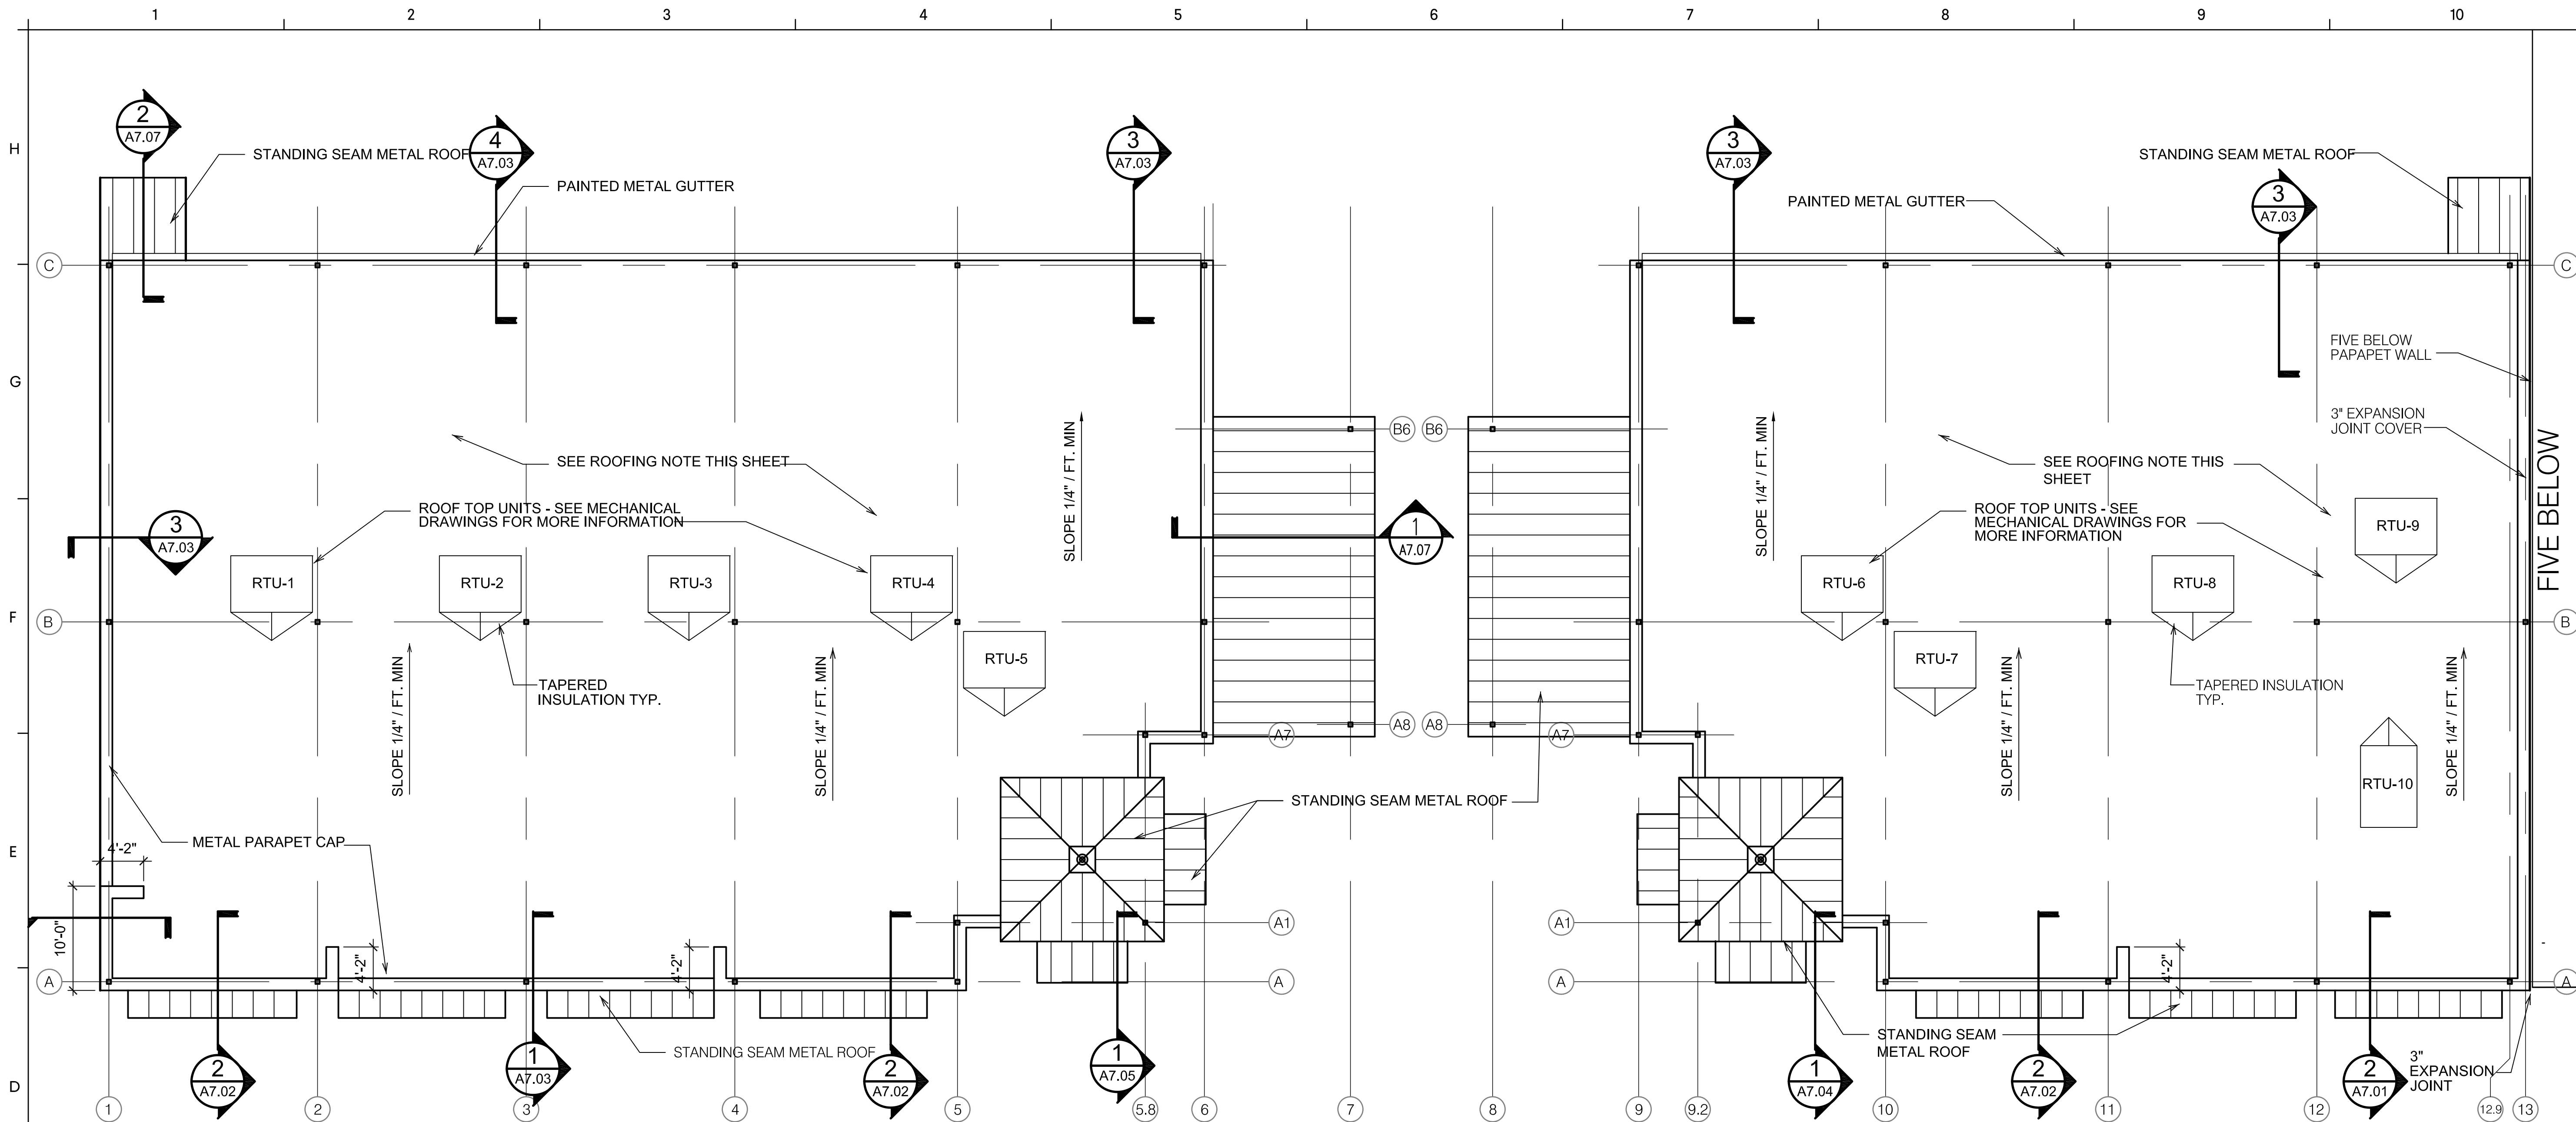


NEW RETAIL SHELL -PART B


NEW RETAIL SHELL -PART A

1
A4.01 **COMPOSITE ROOF PLAN**
SCALE: 1/8" = 1'-0"

ROOFING:
THE ROOF SHALL BE A FULLY ADHERED MEMBRANE ROOFING SYSTEM WITH A MINIMUM R-20 INSULATION. ALL ROOFTOP EQUIPMENT, VENTING AND CONDUITS TO BE INSTALLED IN ACCORDANCE WITH THE LATEST EDITION OF THE NRCA STANDARDS AND ROOFING MANUFACTURERS SPECIFICATIONS. THE ROOF SHALL MEET THE REQUIREMENTS OF THE TENANT'S PROPERTY INSURANCE CARRIER, FACTORY MUTUAL.

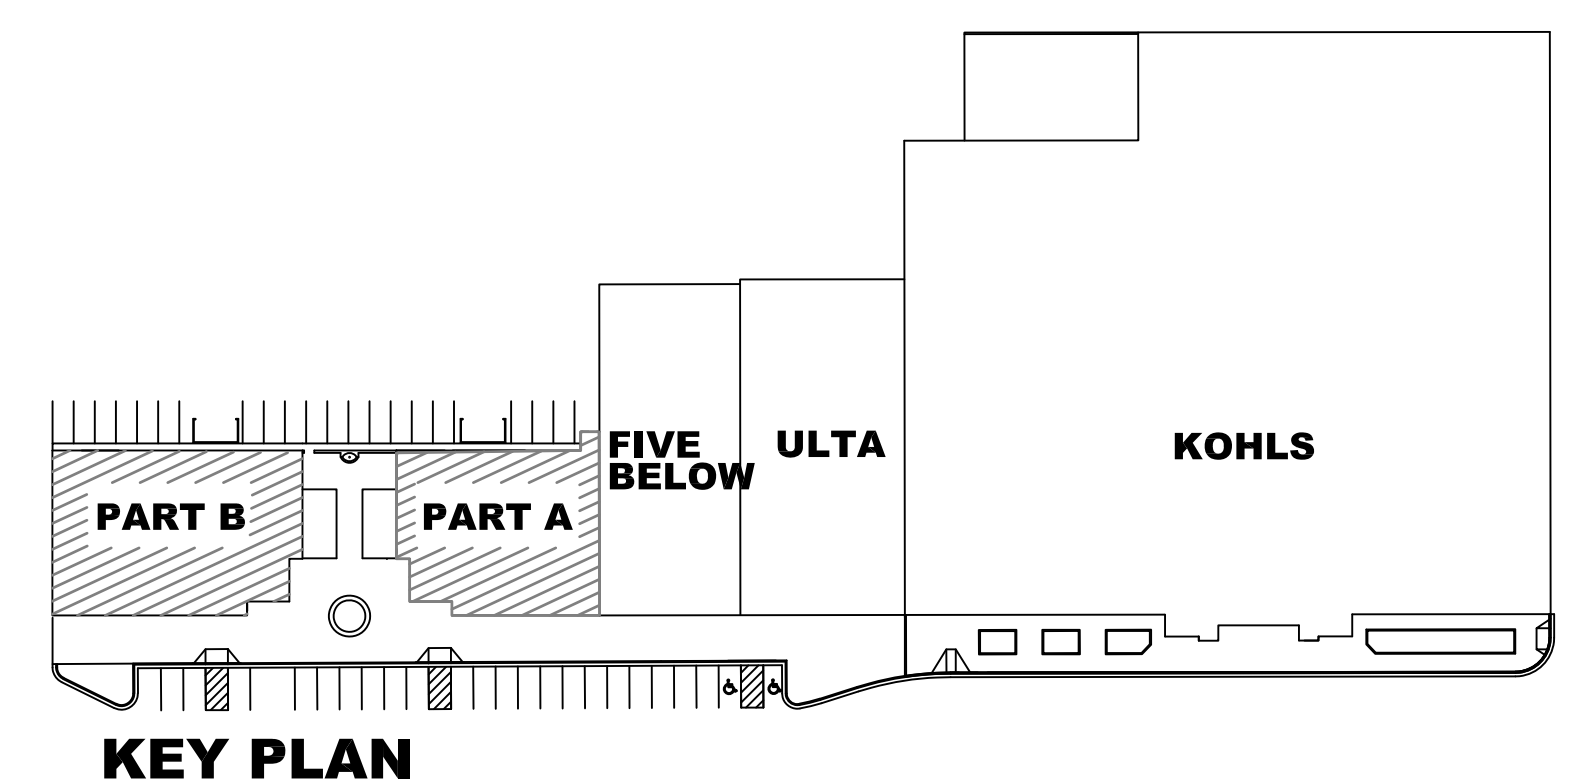

KEY PLAN

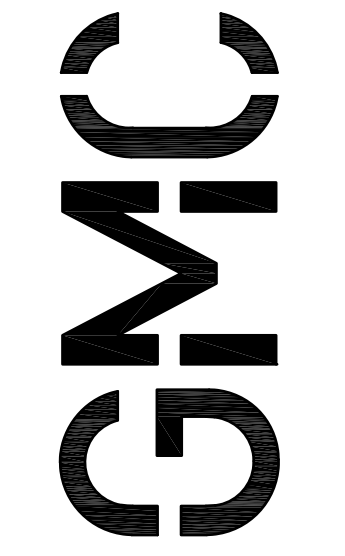


AS-BUILT

2660 East Chase Lane, Suite 200
Montgomery, AL 36117
T 334.271.3200
GMCNETWORK.COM


ISSUE	DATE
75% REVIEW	04/18/19
95% REVIEW	05/20/19
PERMIT SET	10/17/19

THE EXCHANGE AT HOMEPACE
PRATTVILLE, AL
GMC PROJECT#AMGM180037
DESIGNED BY: GMC
DRAWN BY: GMC
CHECKED BY: GMC

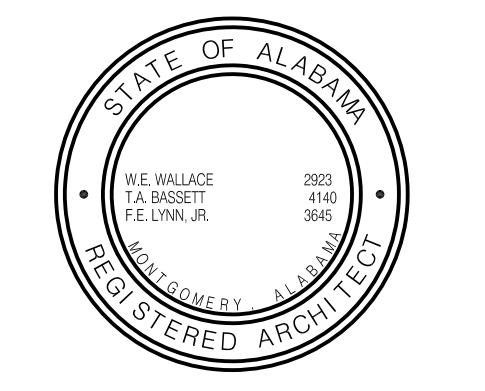


COMPOSITE ROOF PLANS


A4.01
Sheet of

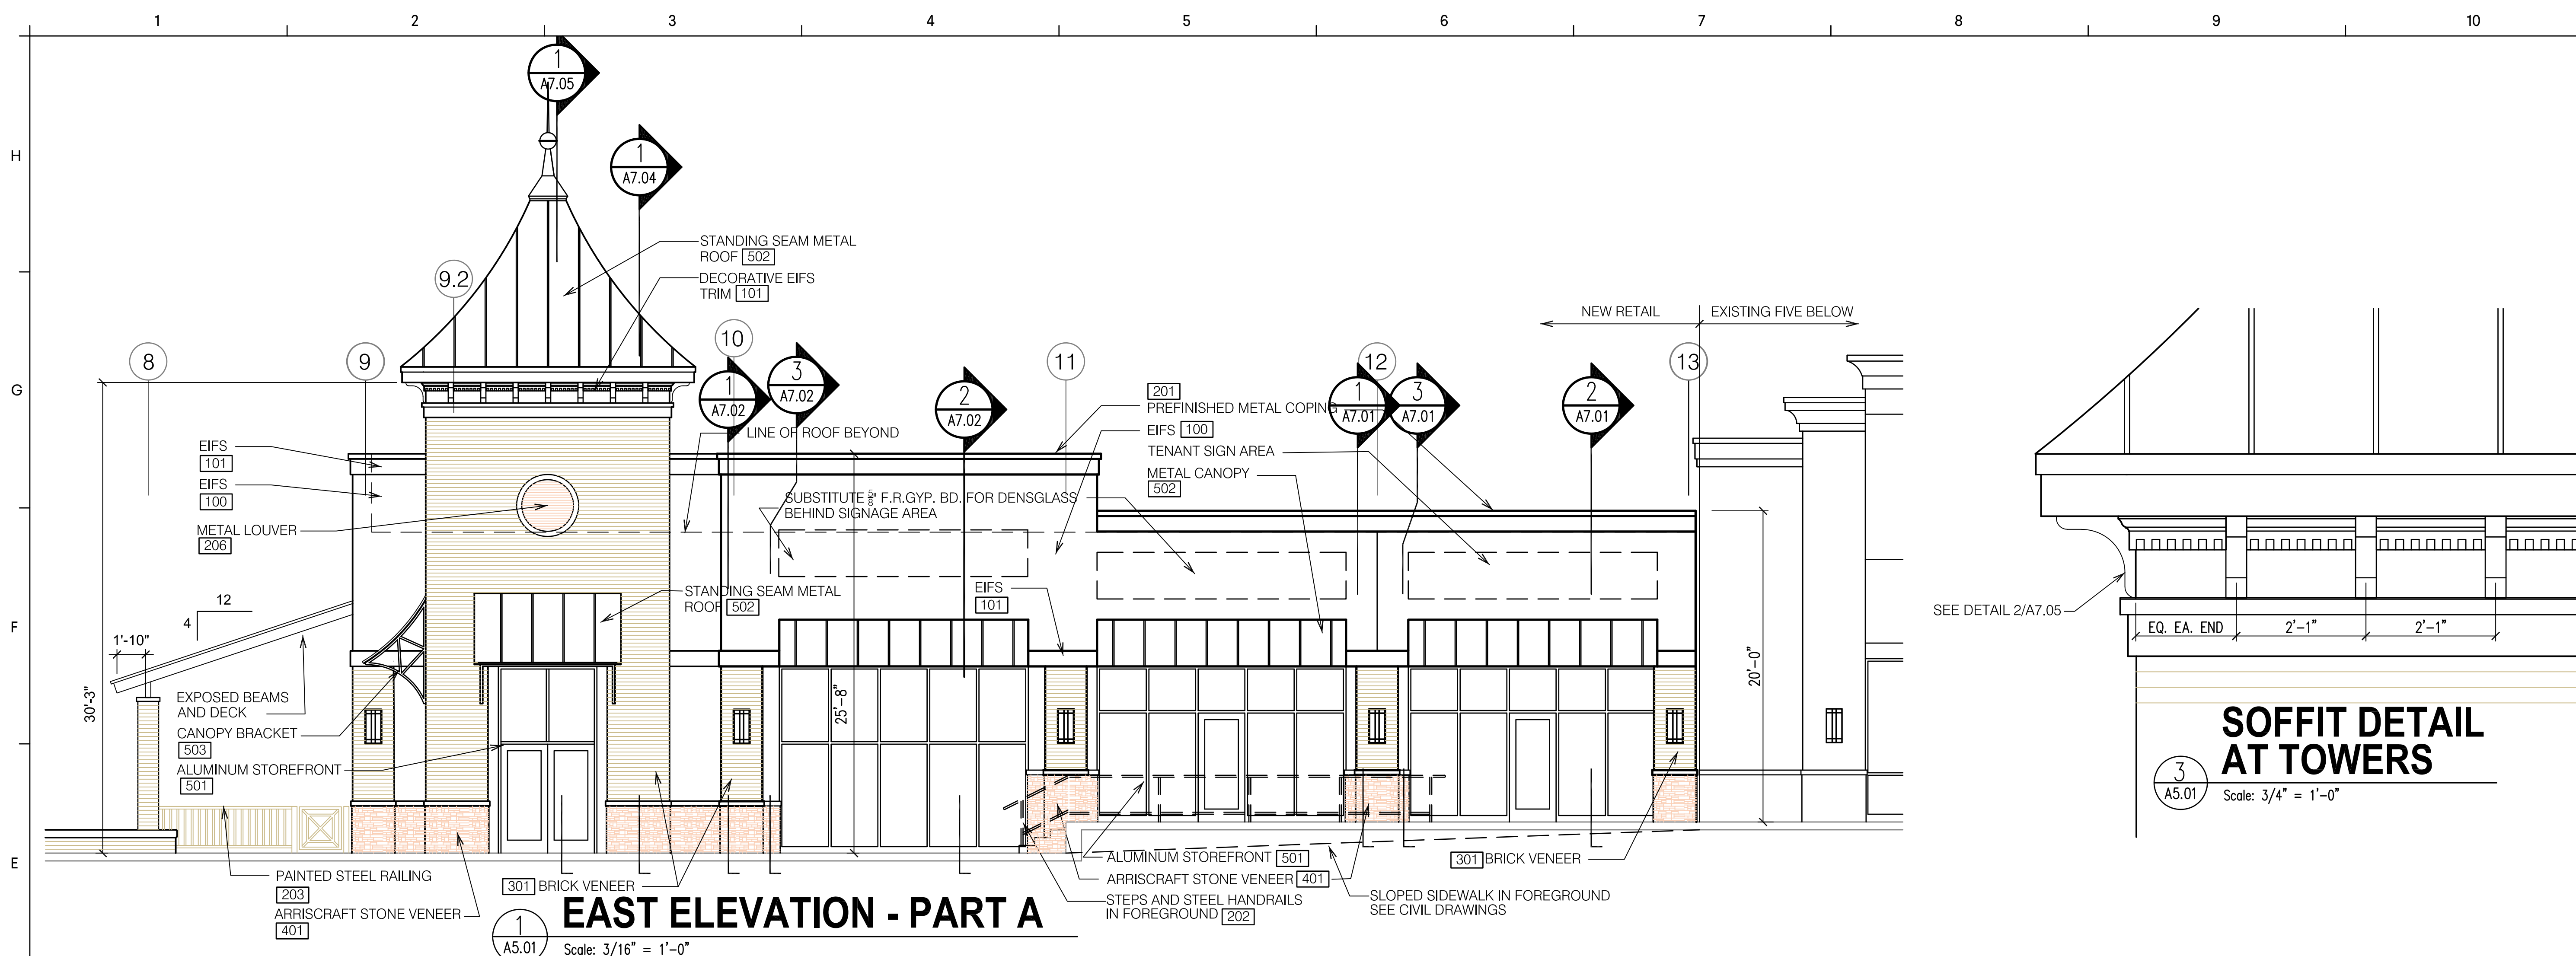

EAST ELEVATION - PART A
Scale: 3/16" = 1'-0"

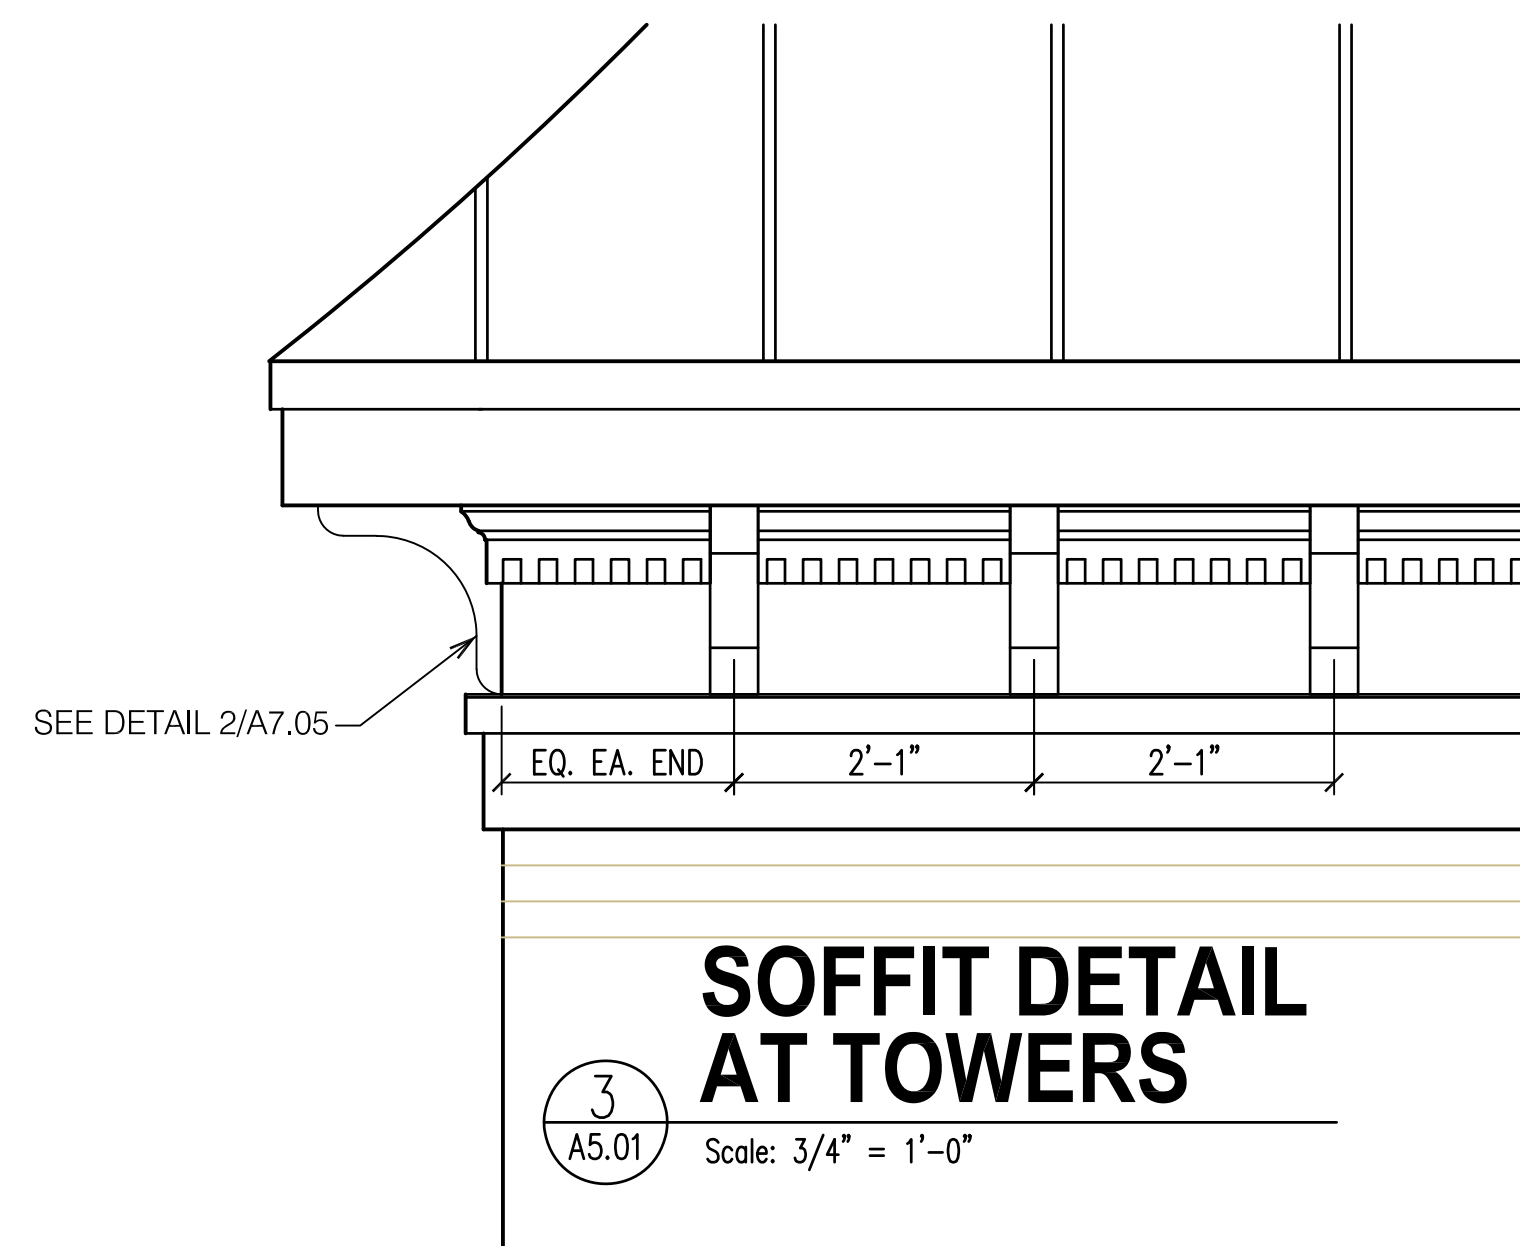

SOFFIT DETAIL AT TOWERS
Scale: 3/4" = 1'-0"

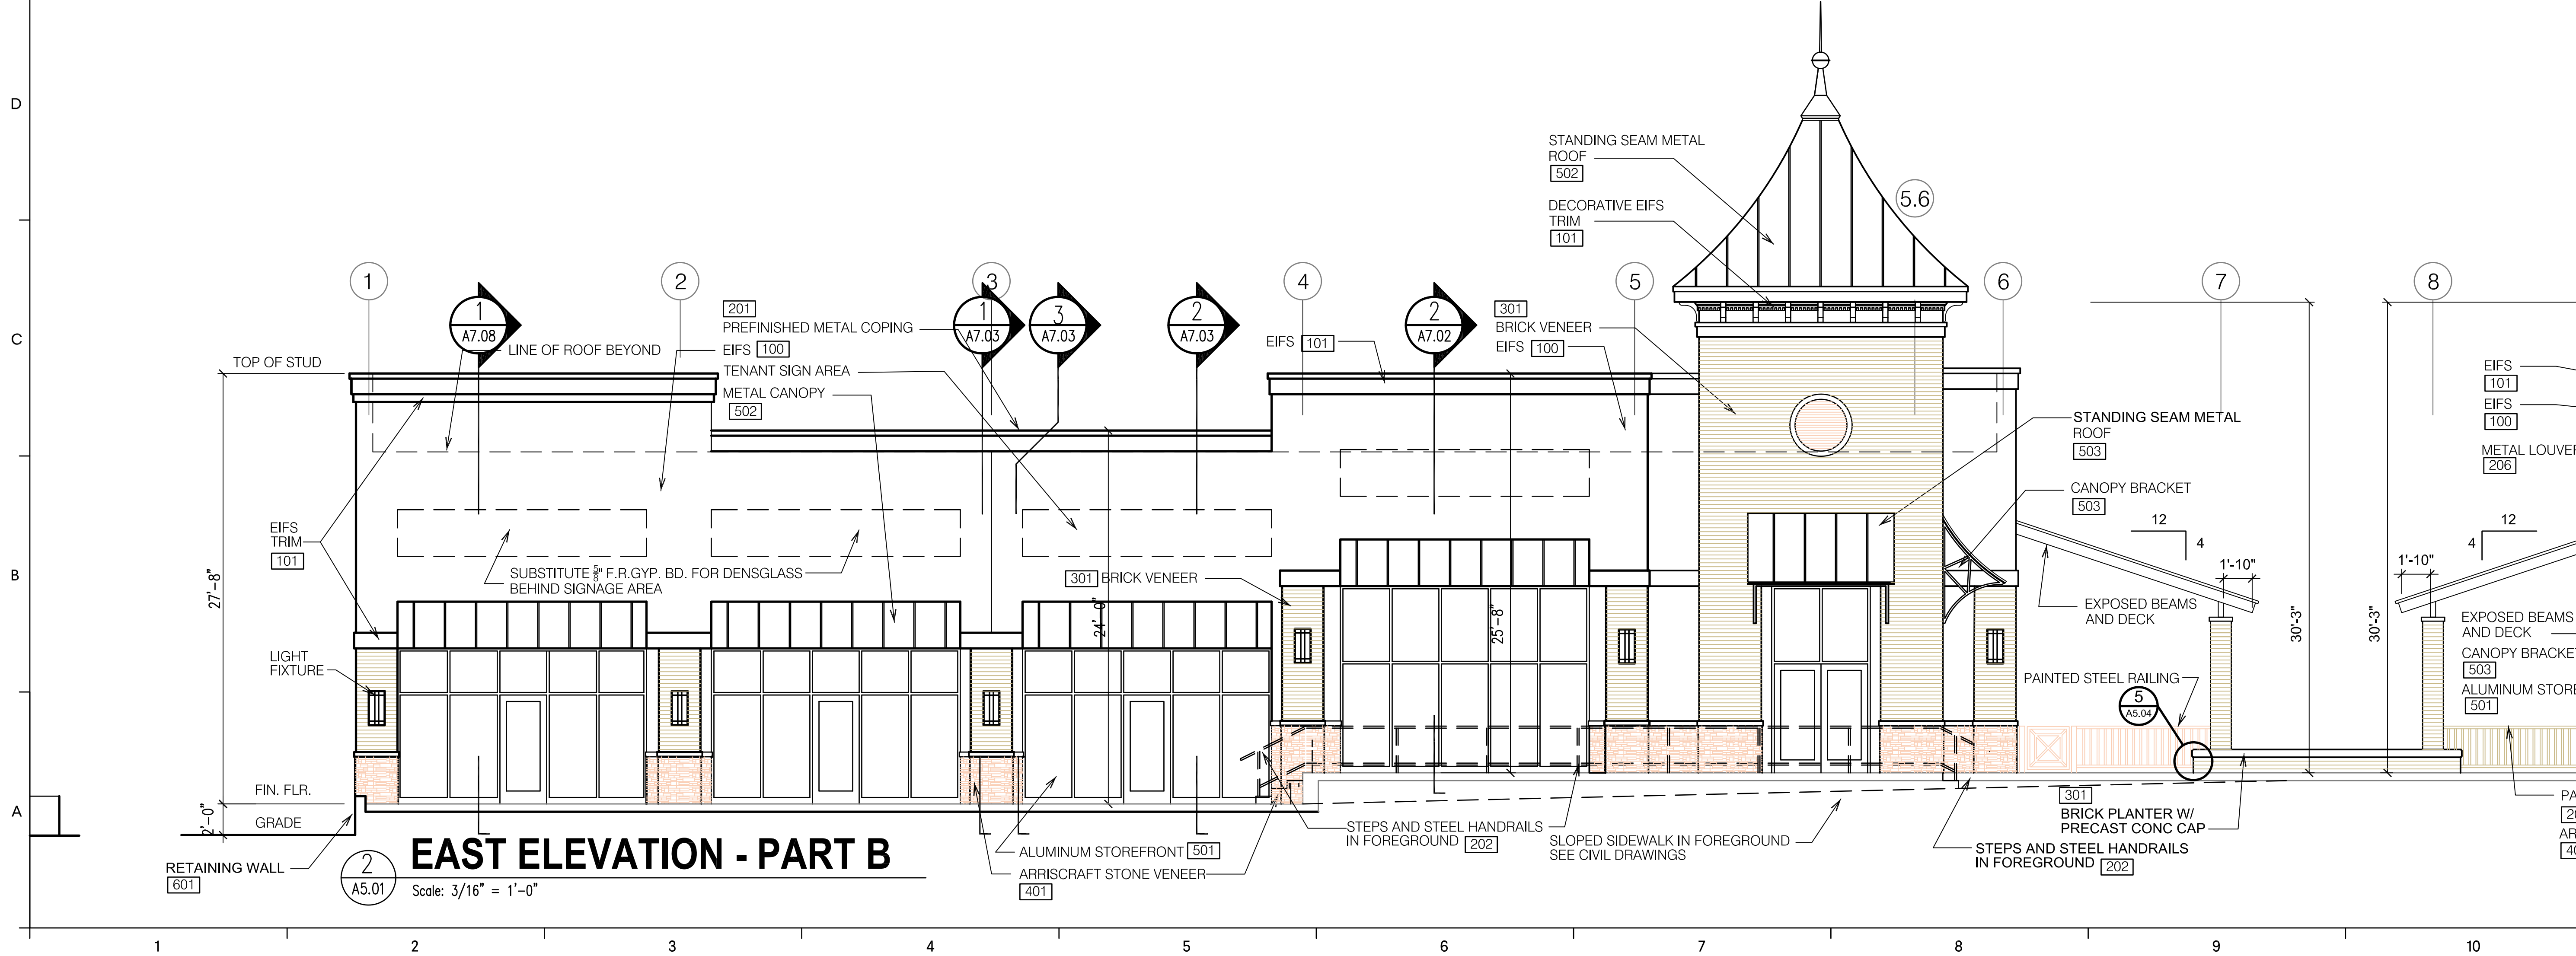


EAST ELEVATION - PART B
Scale: 3/16" = 1'-0"

GMC
AS-BUILT
2660 East Chase Lane, Suite 200
Montgomery, AL 36117
T 334.271.3200
GMCNETWORK.COM


ISSUE	DATE
75% REVIEW	04/18/19
95% REVIEW	05/30/19
PERMIT SET	10/11/19

DESIGNED BY: GMC
DRAWN BY: GMC
CHECKED BY: GMC

THE EXCHANGE AT HOMEPLACE
PRATTVILLE, AL
GMC PROJECT#AMGM180037

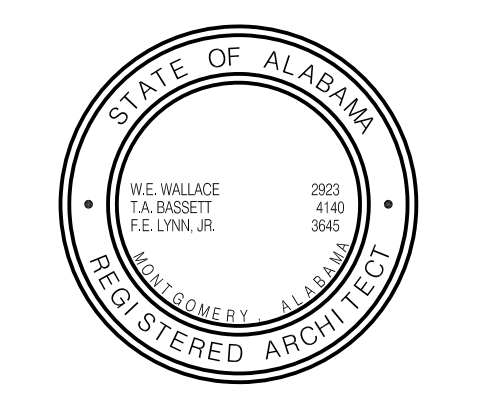


EAST ELEVATIONS PARTS A & B
A5.01
Sheet of

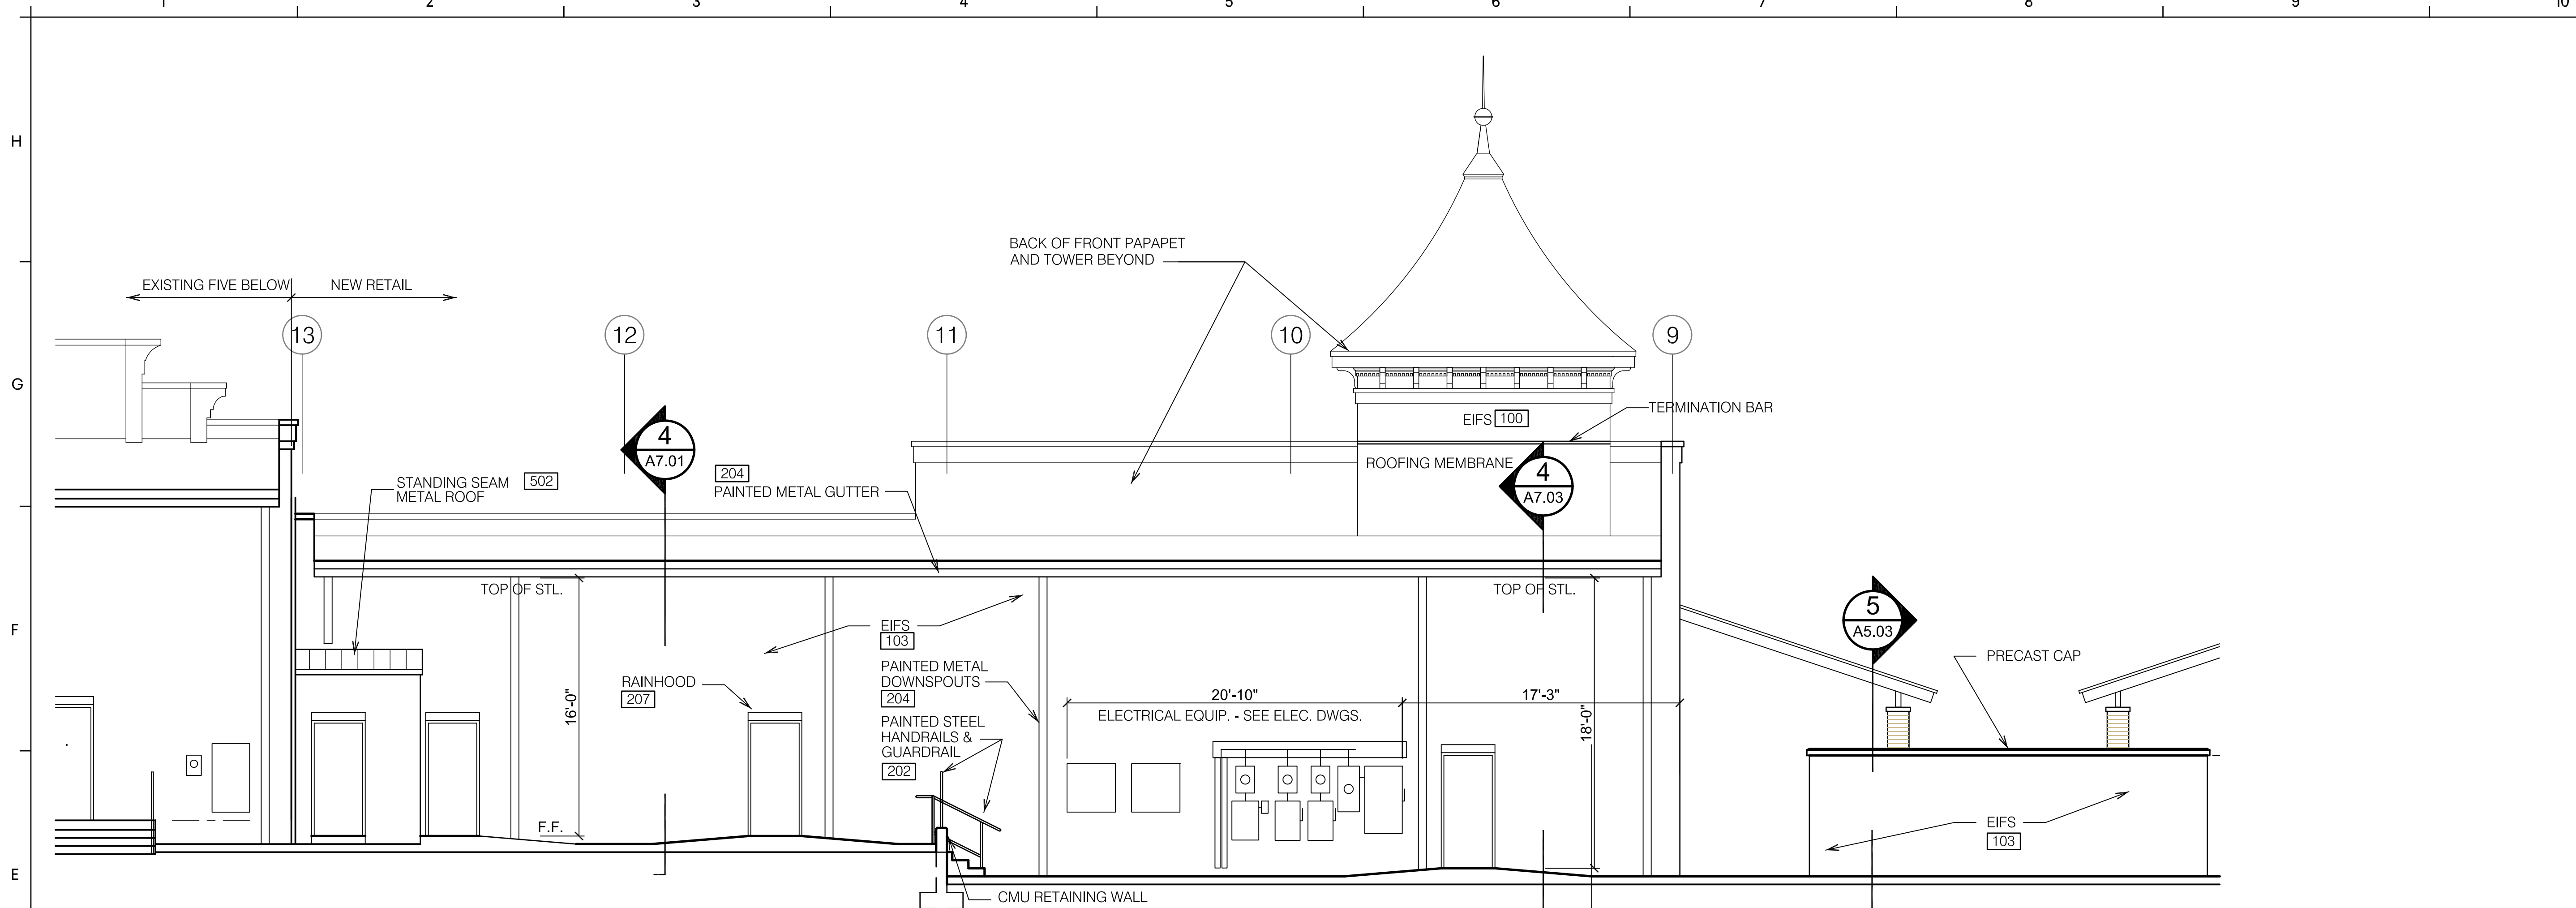

1
A5.02
Scale: 3/16" = 1'-0"

WEST ELEVATION - PART A

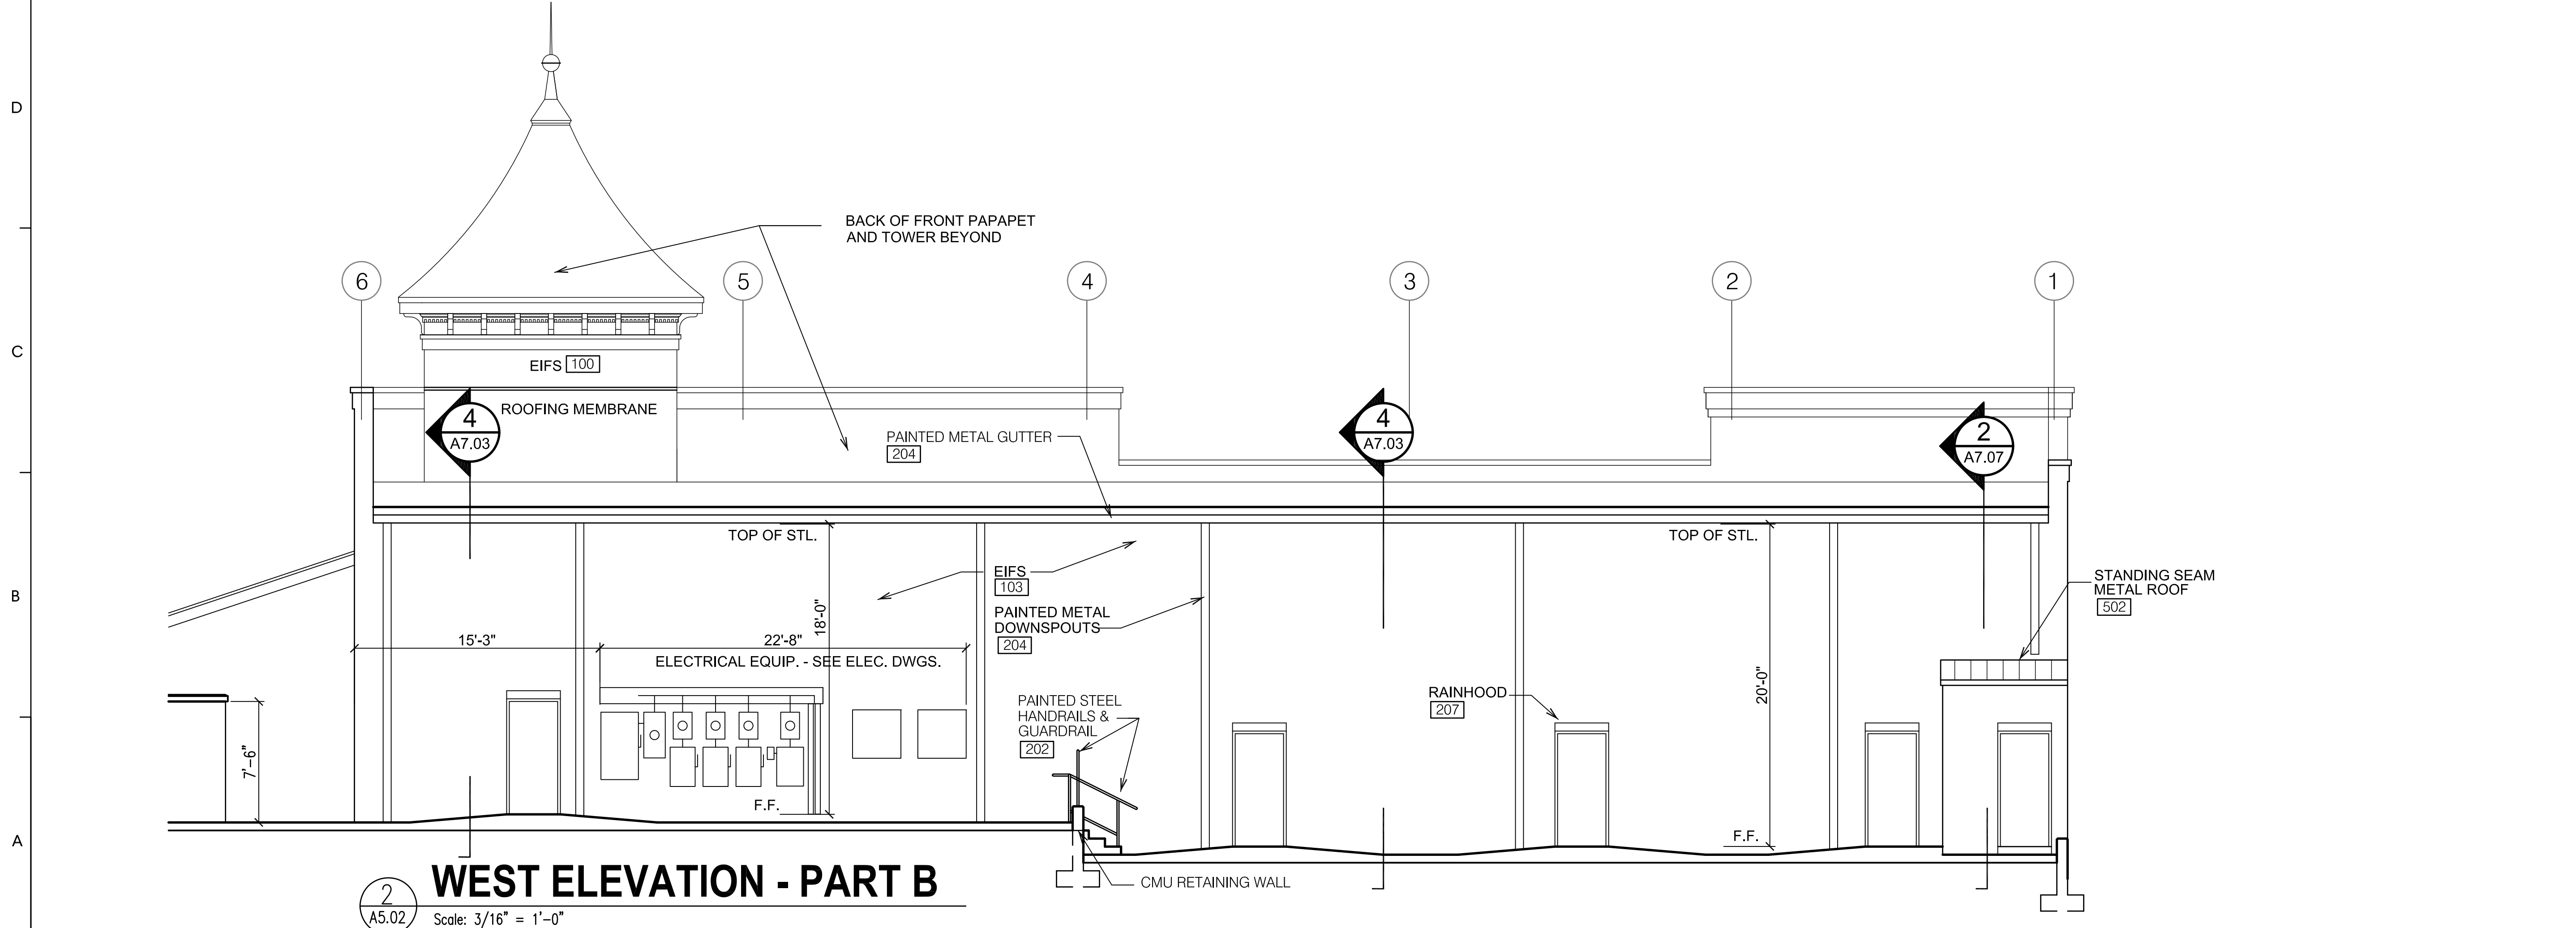

2
A5.02
Scale: 3/16" = 1'-0"

WEST ELEVATION - PART B

GMC

AS-BUILT


2660 East Chase Lane, Suite 200
Montgomery, AL 36117
T 334.271.3200
GMCNETWORK.COM

ISSUE	DATE
75% REVIEW	04/18/19
95% REVIEW	05/30/19
PERMIT SET	10/17/19
DESIGNED BY:	GMC
DRAWN BY:	GMC
CHECKED BY:	GMC

THE EXCHANGE AT HOMEPLACE


PRATTVILLE, AL

GMC PROJECT#AMGM180037

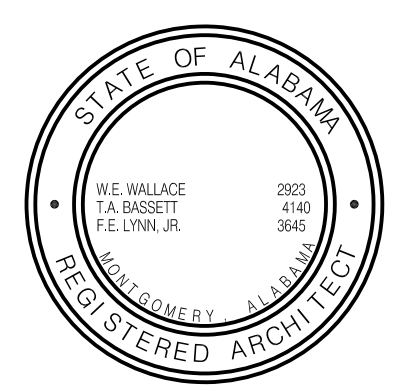


WEST ELEVATIONS
PARTS A & B


A5.02
Sheet of

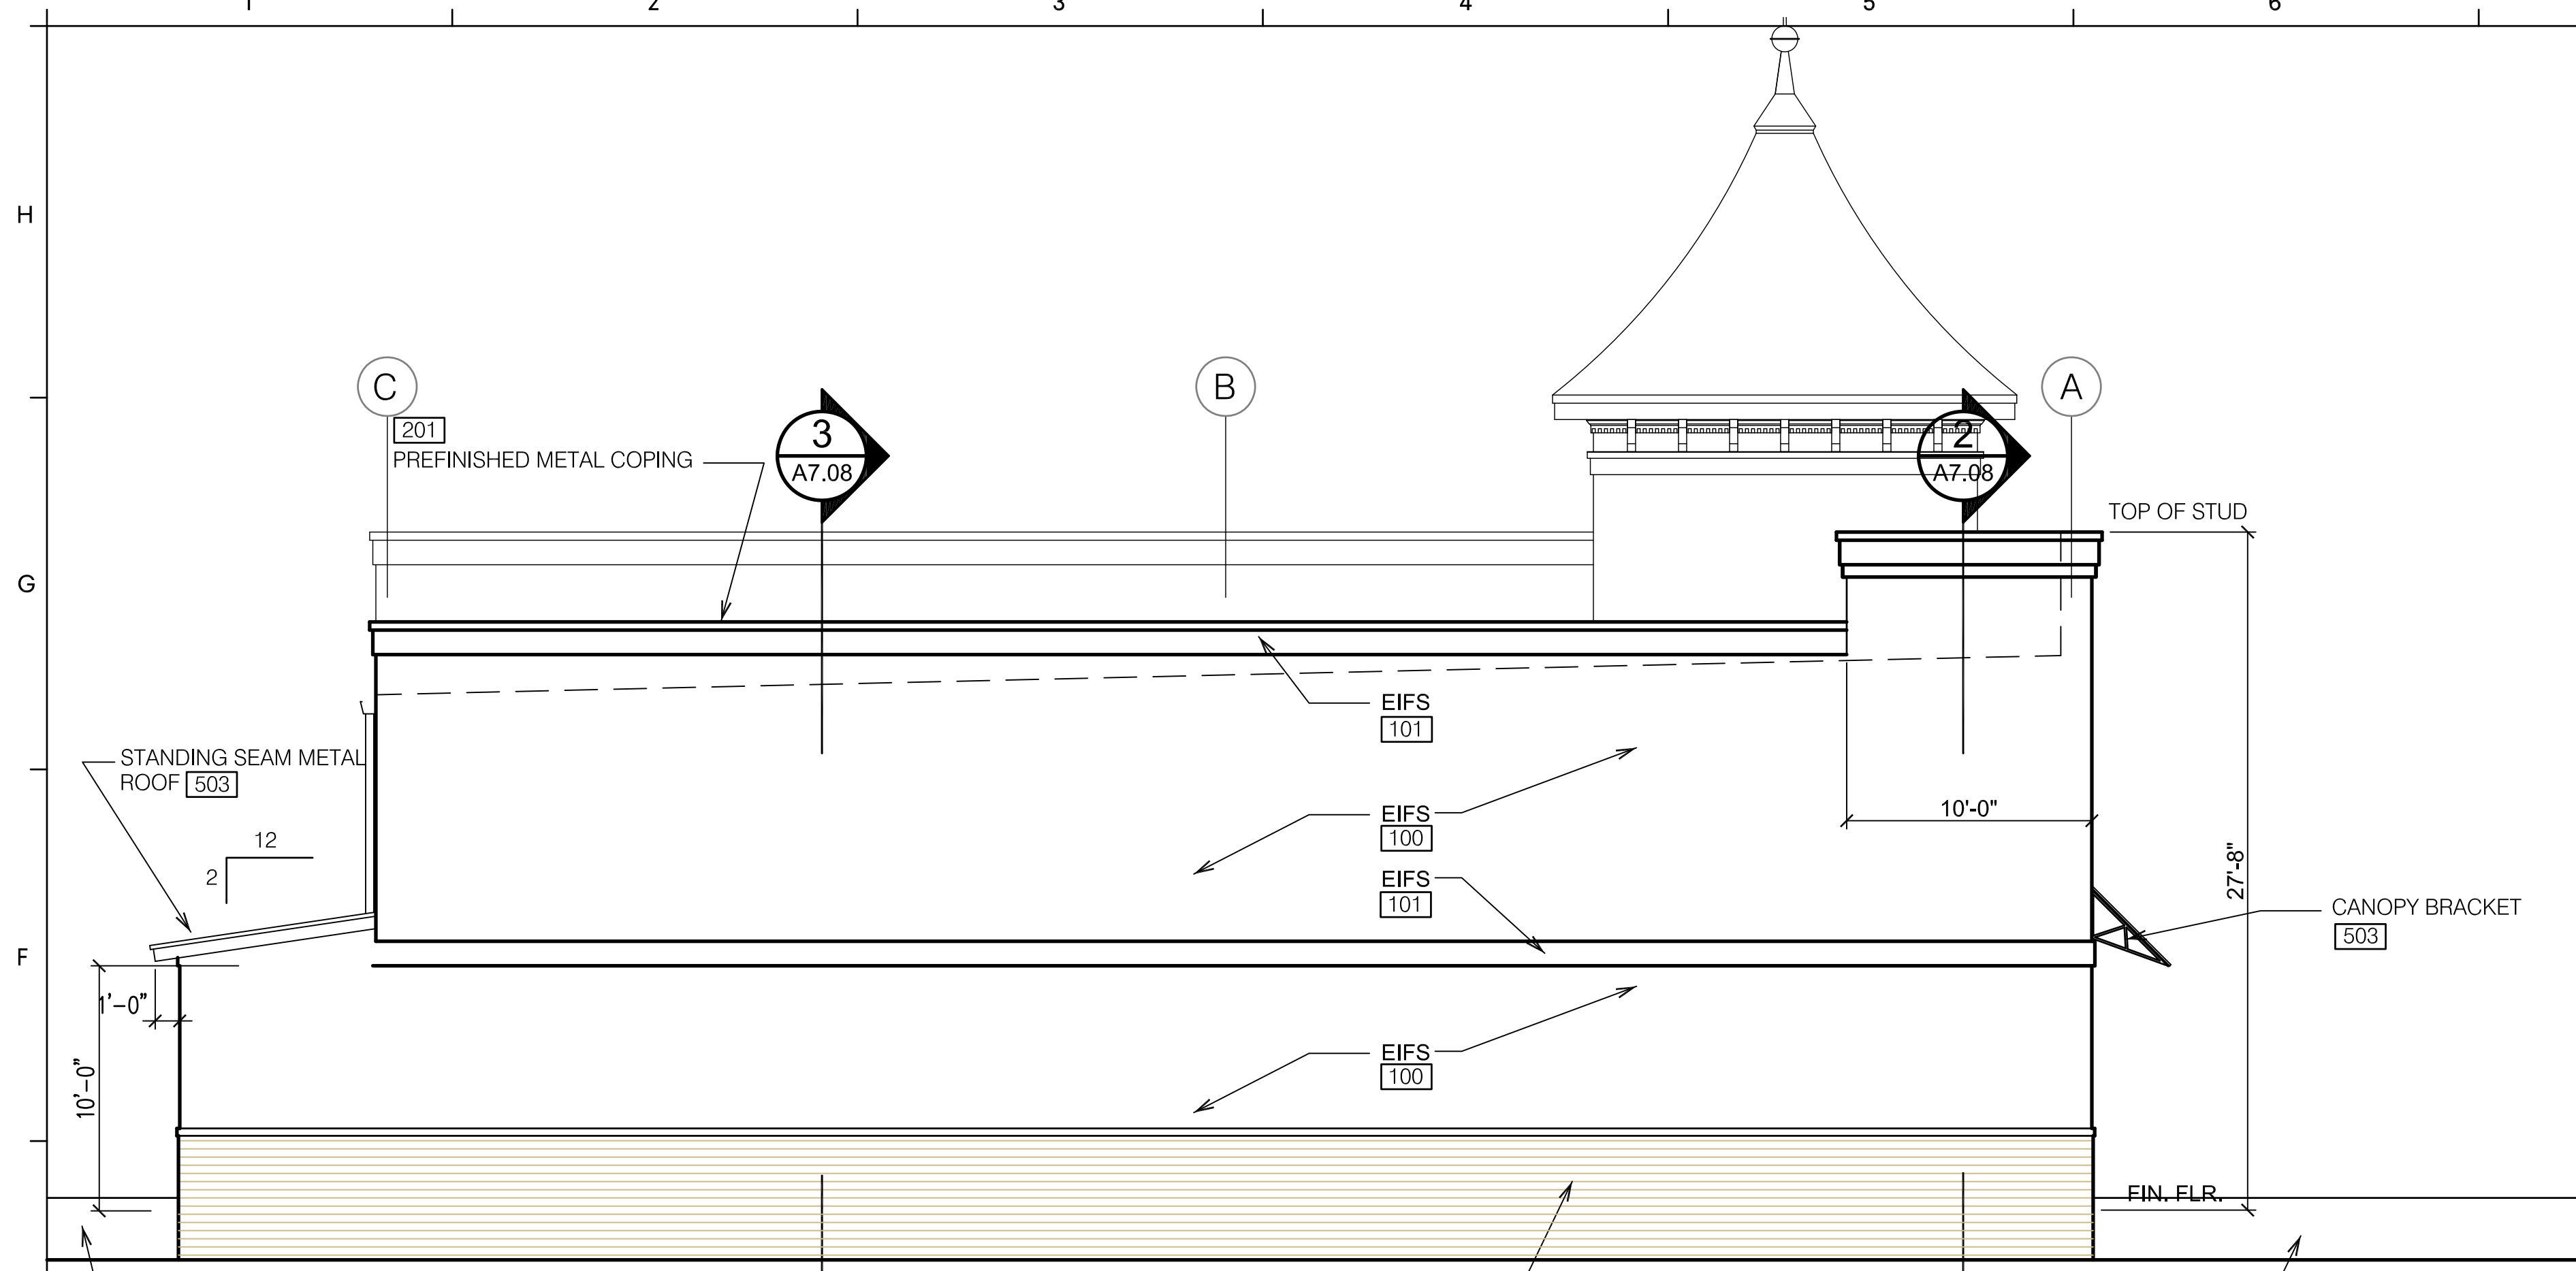

1 SOUTH ELEVATION
 SCALE: 3/16" = 1'-0"

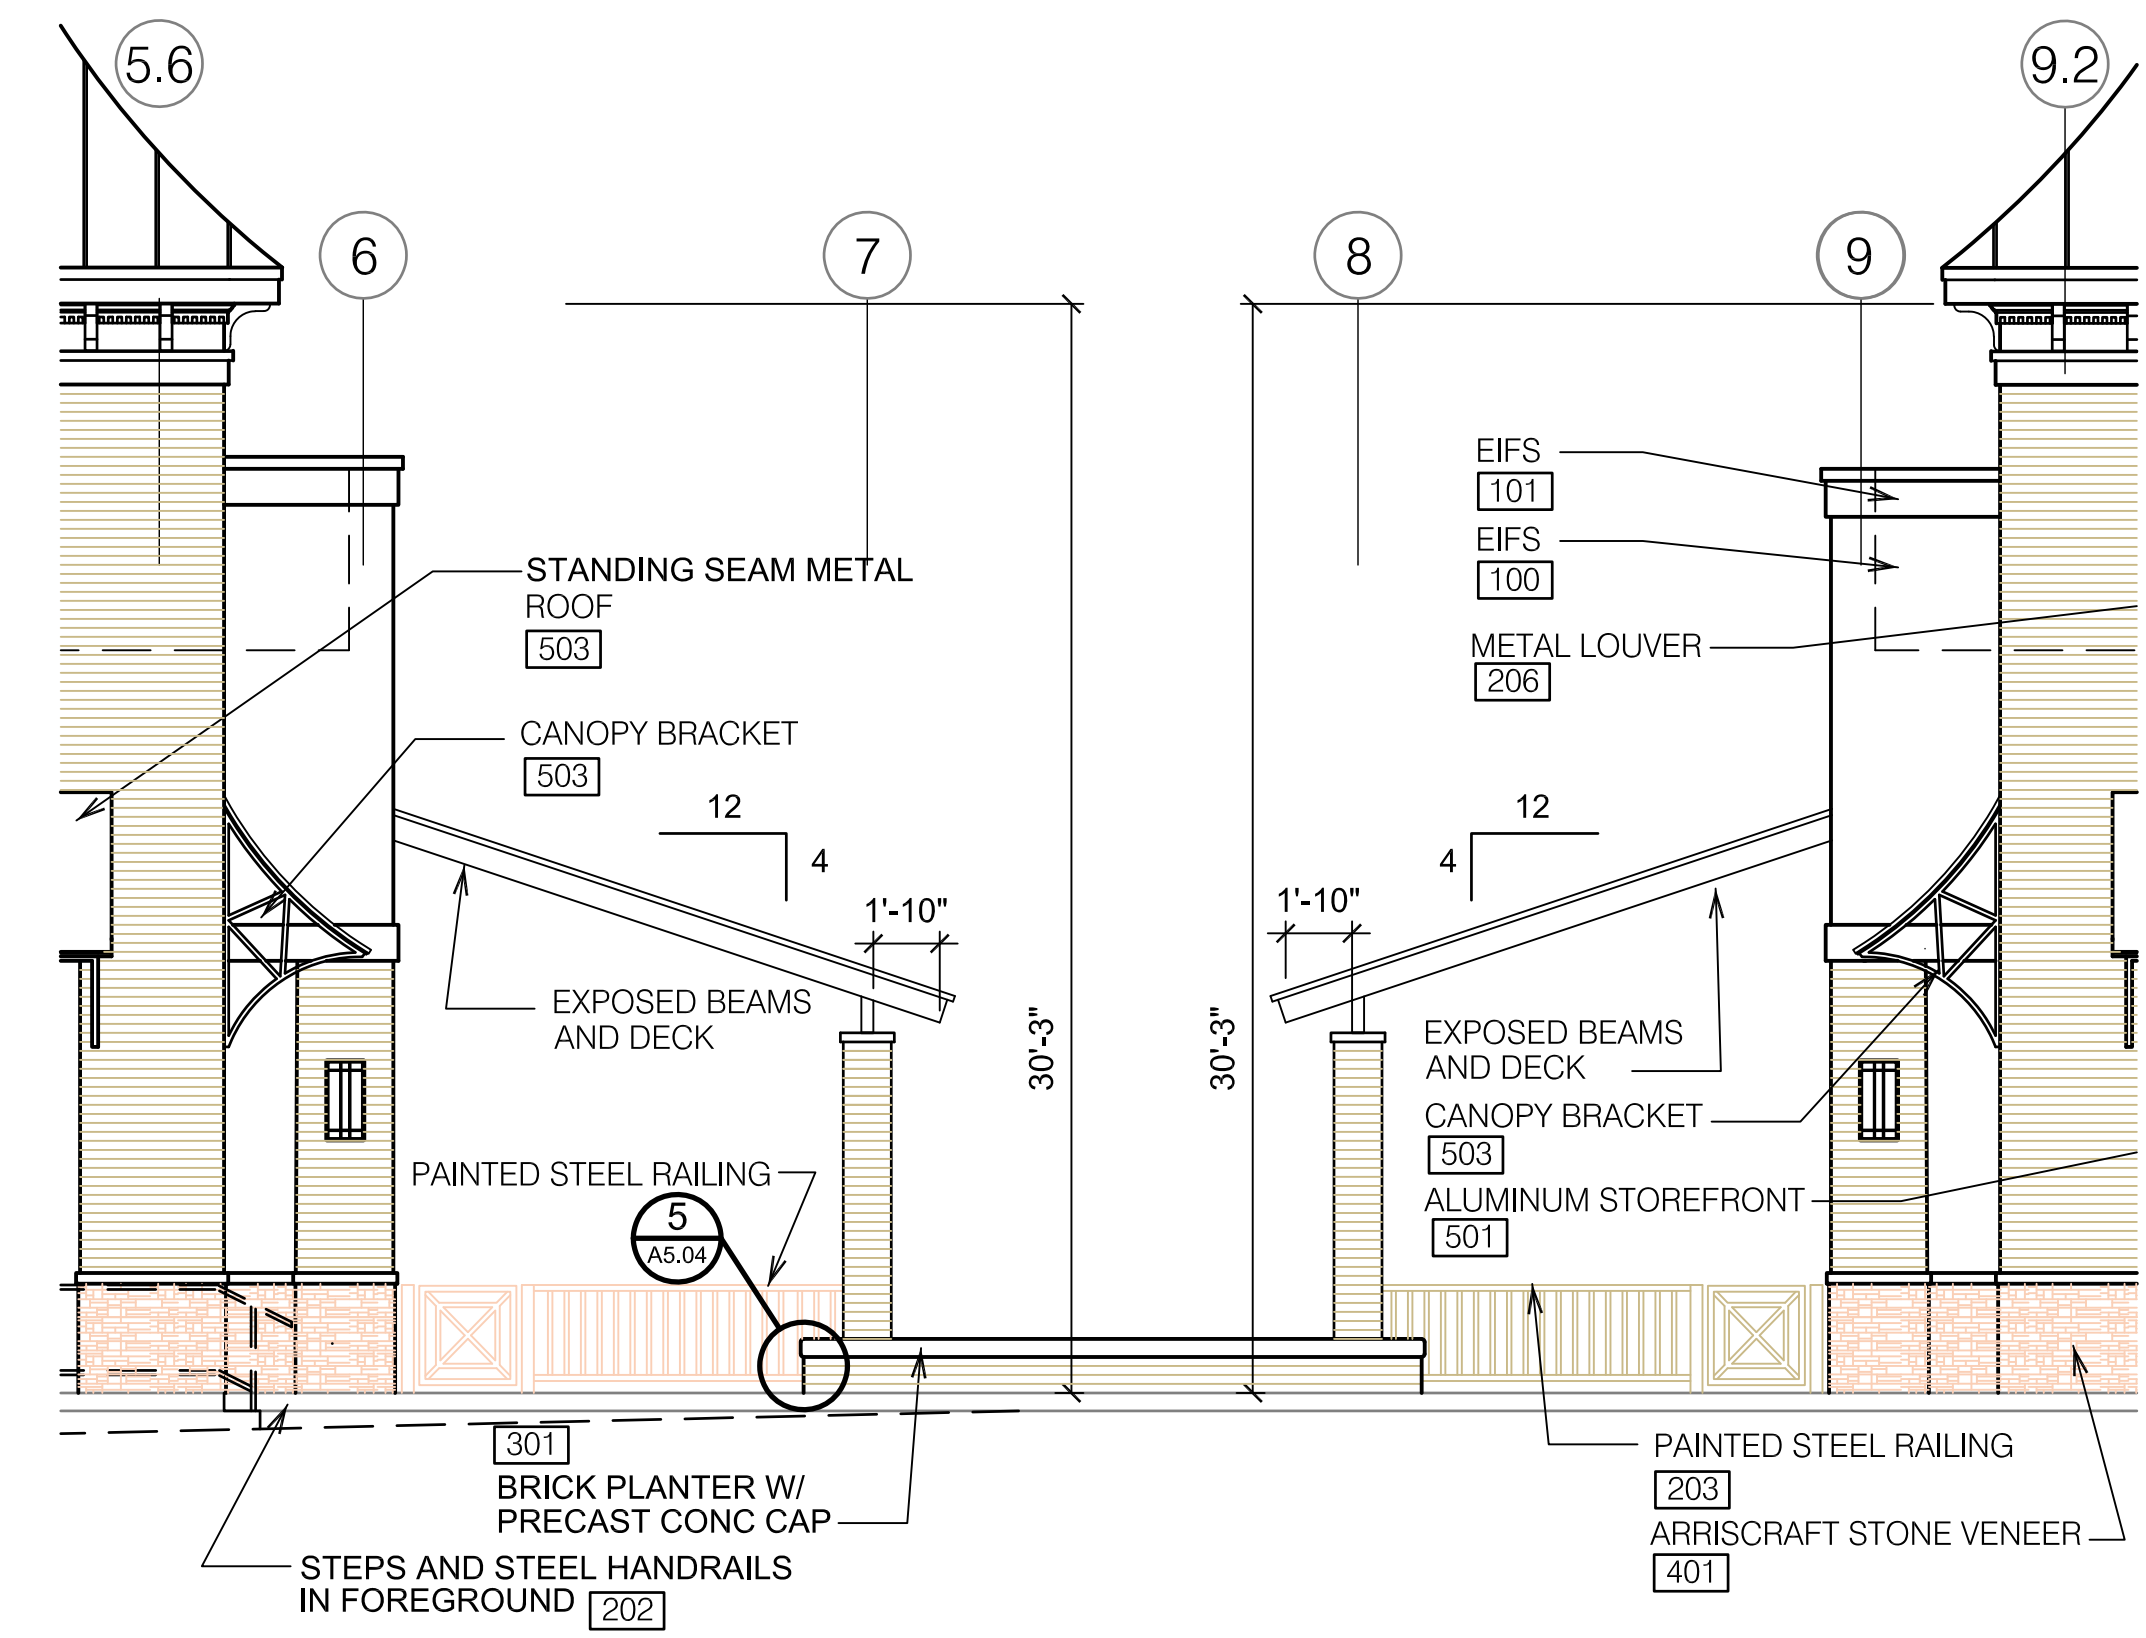

3 COURTYARD ELEVATION
 SCALE: 3/16" = 1'-0"

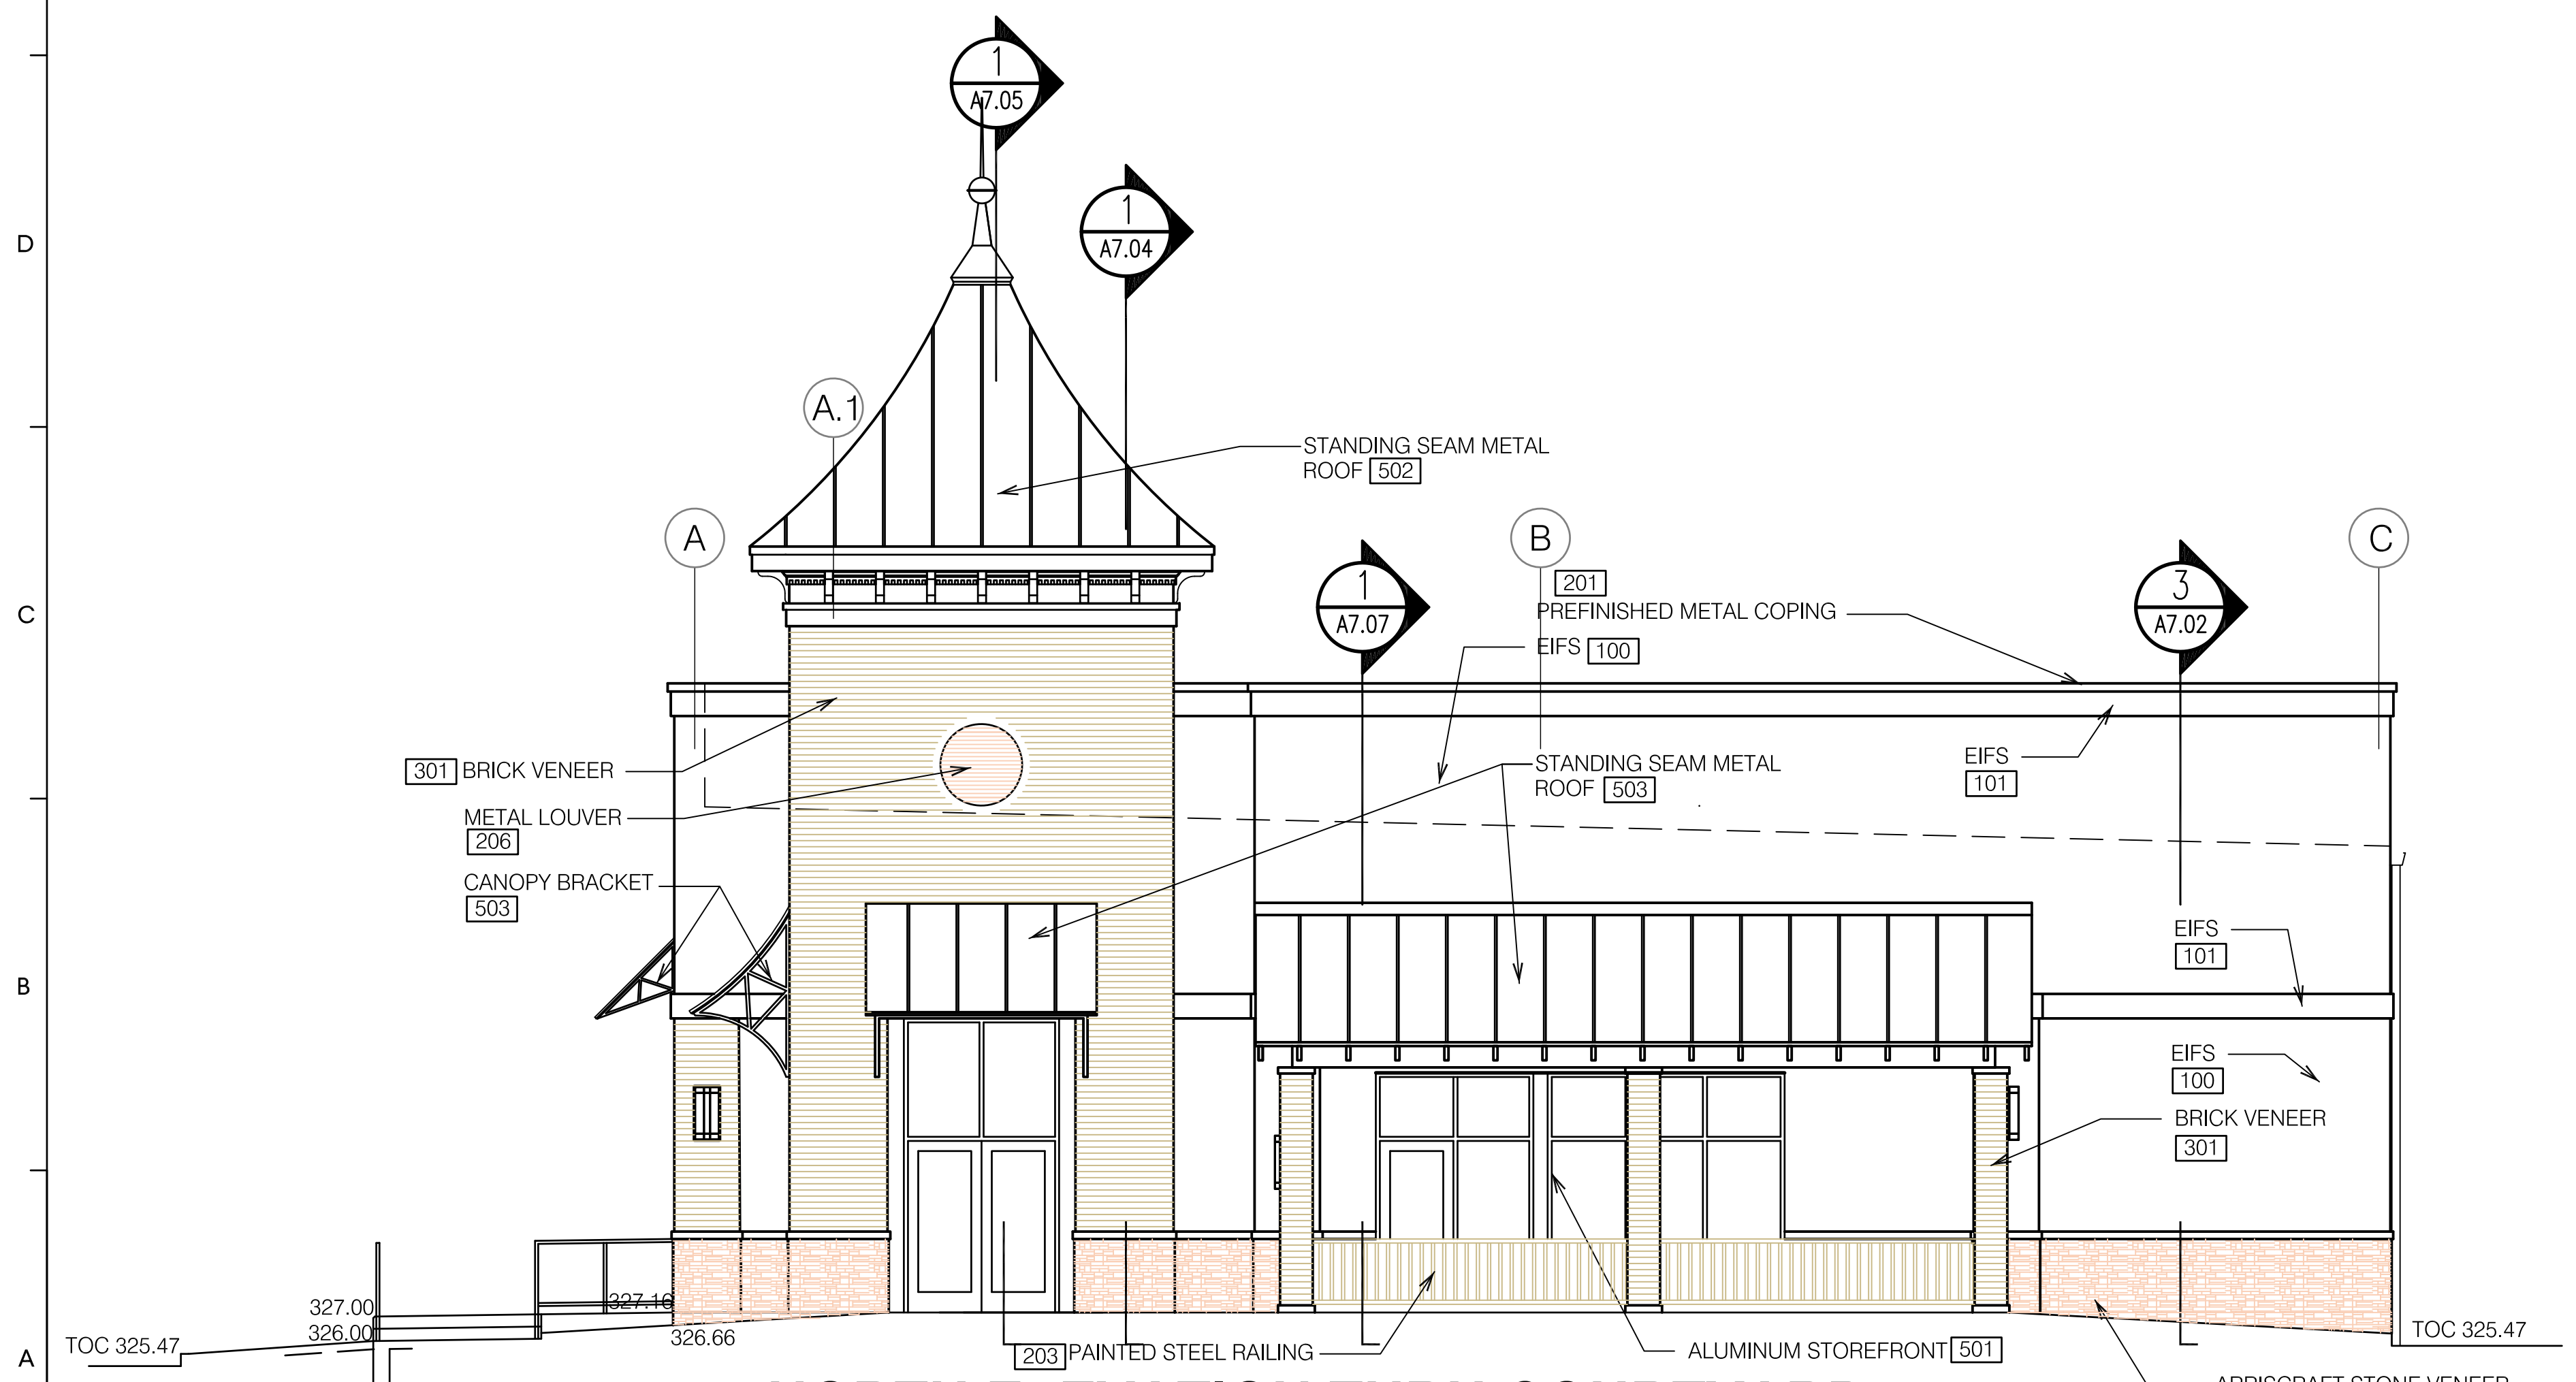


2 NORTH ELEVATION THRU COURTYARD
 SCALE: 3/16" = 1'-0"

GMC
AS-BUILT
 2660 East Chase Lane, Suite 200
 Montgomery, AL 36117
 T 334.271.3200
 GMCNETWORK.COM


ISSUE	DATE
75% REVIEW	04/18/19
95% REVIEW	05/30/19
PERMIT SET	10/11/19

DESIGNED BY: GMC
 DRAWN BY: GMC
 CHECKED BY: GMC


THE EXCHANGE AT HOMEPLACE
 PRATTVILLE, AL
 GMC PROJECT#AMGM180037

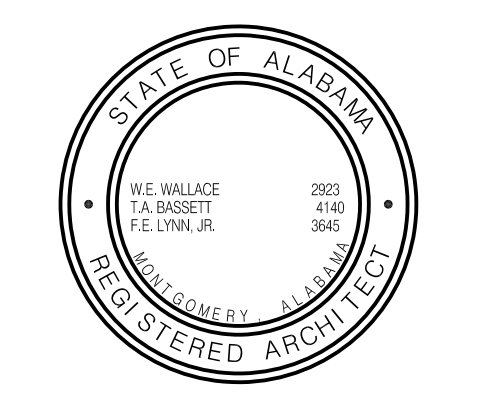

SOUTH ELEVATION
NORTH ELEVATION
COURTYARD ELEVATION
A5.03
 sheet of

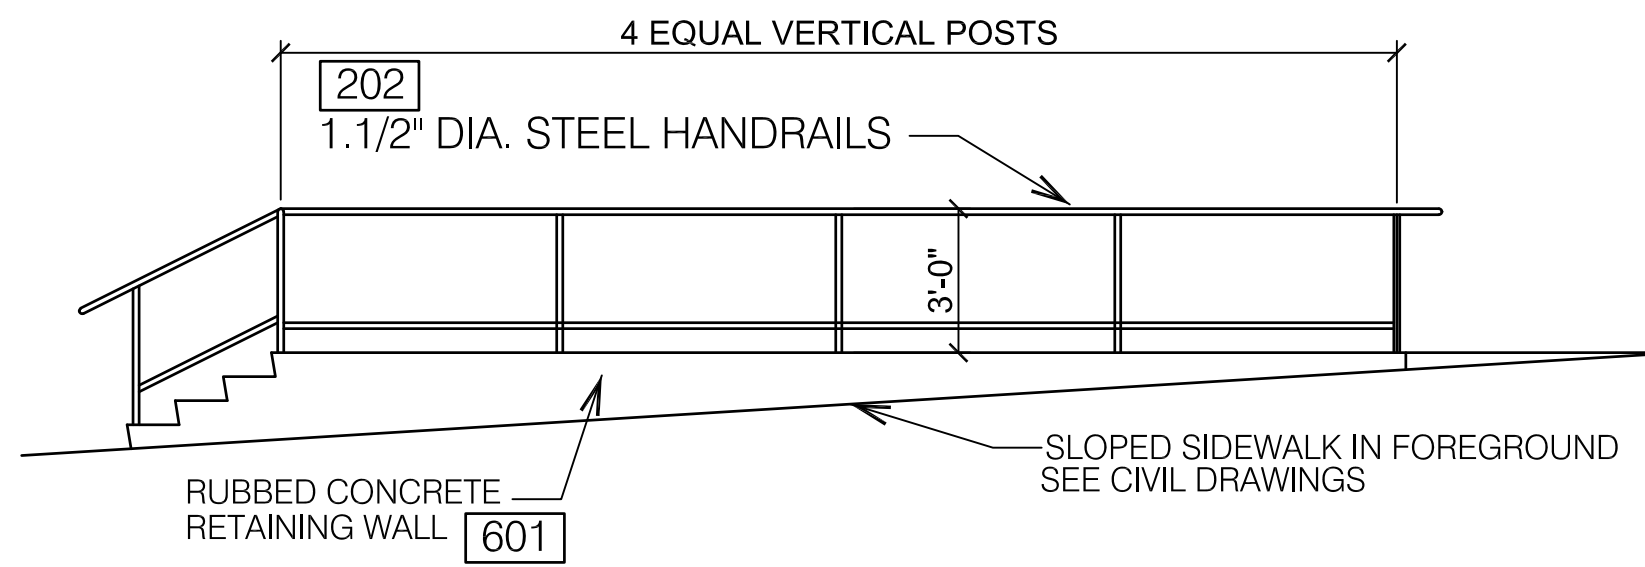


1 EAST RAILING - PART A
A5.04 SCALE: 1/4" = 1'-0"

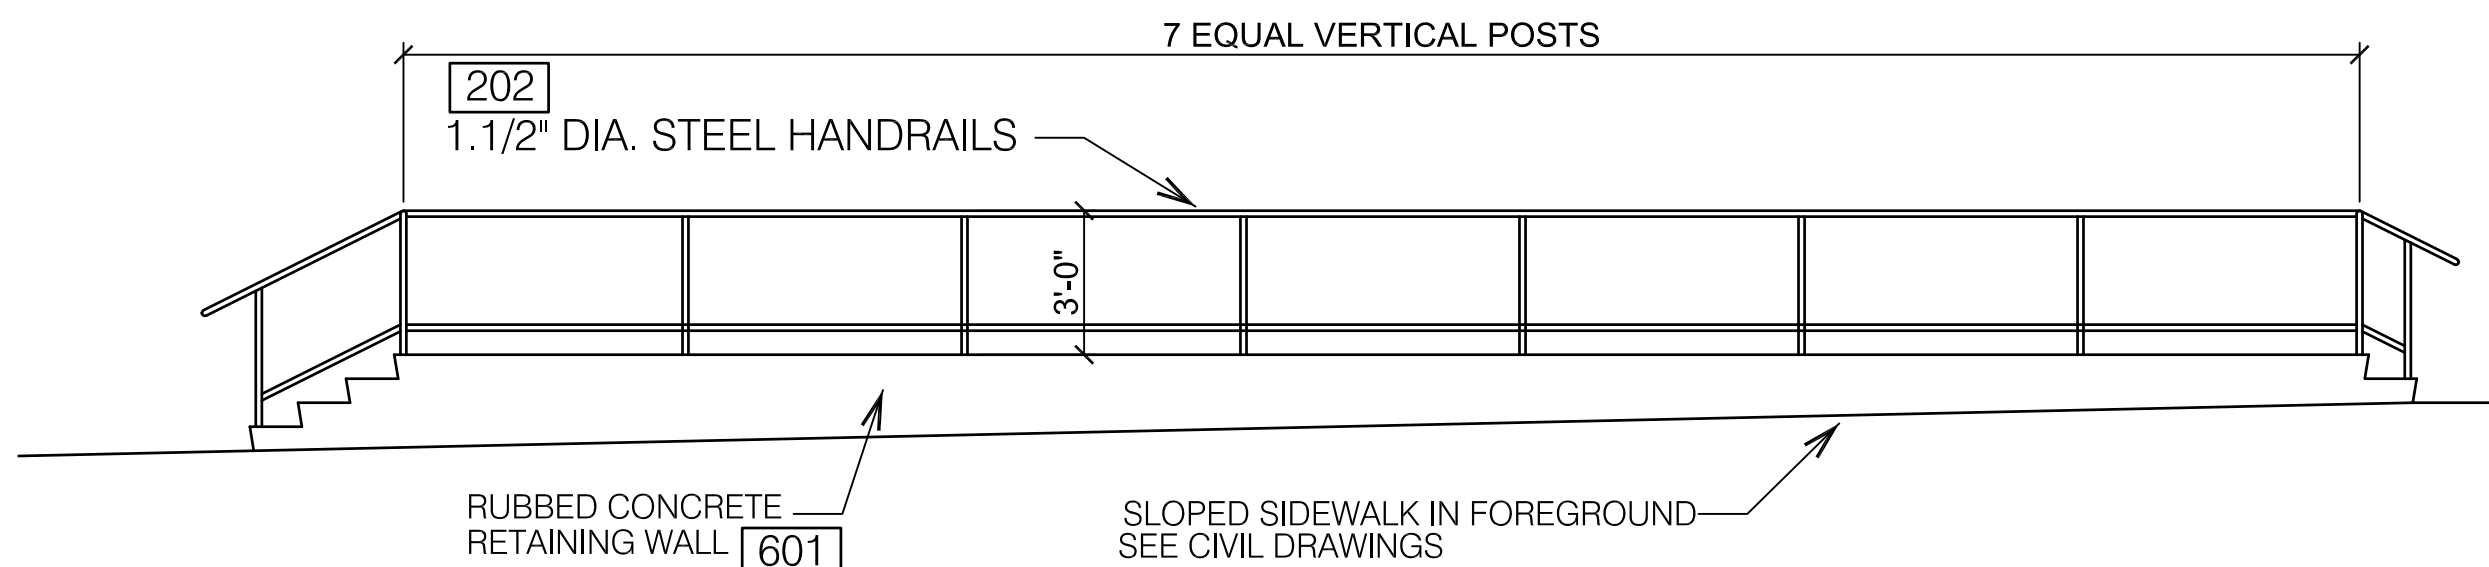

2 EAST RAILING - PART B
A5.04 SCALE: 1/4" = 1'-0"


EXTERIOR FINISH MATERIAL SCHEDULE

FIN. NO.	MATERIAL	MANUFACTURER/SUPPLIER	SERIES/PRODUCT NO.	COLOR	ADDITIONAL INFO
100	E.I.F.S.	DRYVIT	# 456	OYSTER SHELL	
101	E.I.F.S.	DRYVIT	# 113	AMARILLO WHITE	
103	E.I.F.S.	DRYVIT	# 310	CHINA WHITE	
201	PARAPET CAP			T.B.D.	PROVIDE COLOR CHART
202	STEEL HANDRAILS/STEEL GUARDRAILS			SHERWIN-WILLIAMS PURE WHITE -7005	
203	STEEL RAILING AND GATES			SHERWIN-WILLIAMS PURE WHITE -7005	
204	METAL GUTTER/DOWNSPOUTS	PAC CLAD		BONE WHITE	
205	HM DOORS, FRAMES, RAINHOODS			SHERWIN-WILLIAMS PURE WHITE -7005	
206	METAL LOUVERS			T.B.D.	
207	RAINHOOD			SHERWIN-WILLIAMS PURE WHITE -7005	
301	BRICK VENEER	HENRY BRICK		COTTONWOOD	MATCH EXISTING
401	CULTURED STONE	ARRIS-STACK		DESERT SAND	MATCH EXISTING
501	ALUM. STOREFRONT	KAWNEER		SATIN FINISH	MATCH EXISTING
502	STANDING SEAM METAL CANOPY	MATCH EXISTING ENTRY TOWERS		MATCH EXISTING TOWERS	
503	CANOPY BRACKET			SHERWIN-WILLIAMS PURE WHITE -7005	
601	RUBBED CONCRETE RETAINING WALLS			SHERWIN-WILLIAMS PURE WHITE -7005	
602	CONCRETE BOLLARD			SHERWIN-WILLIAMS PURE WHITE -7005	

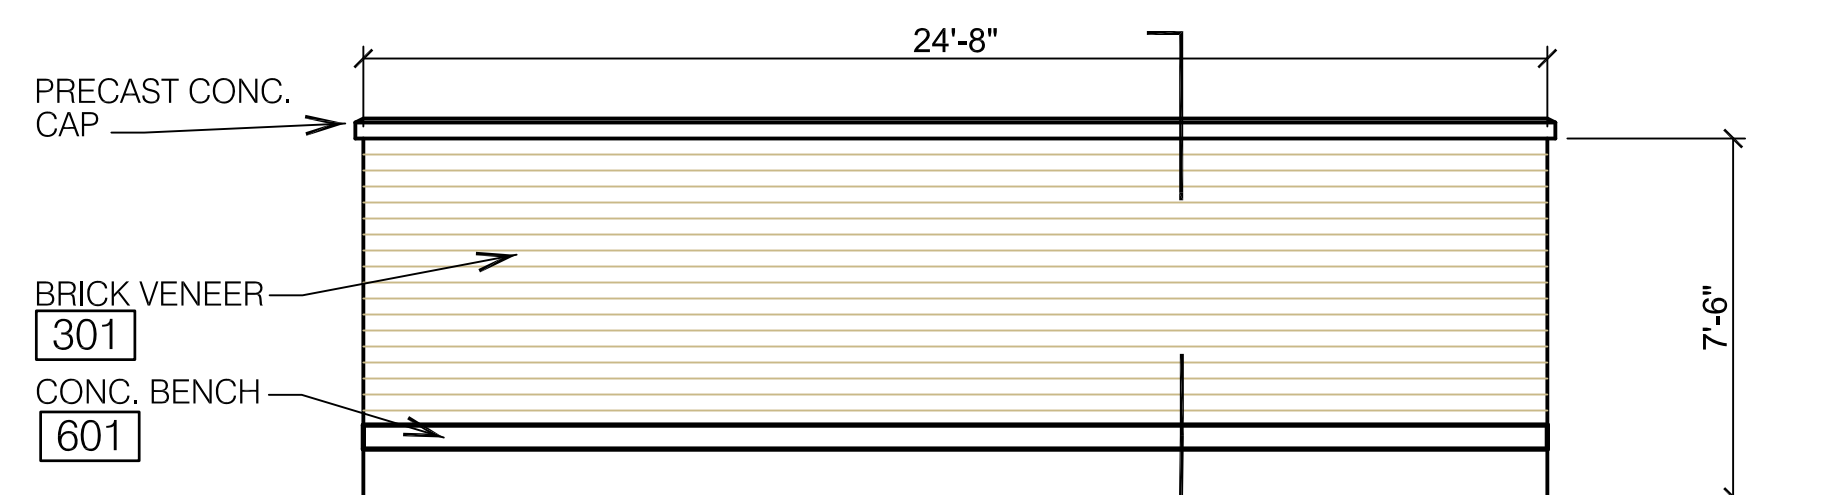


ELEVATION

6
A5.04

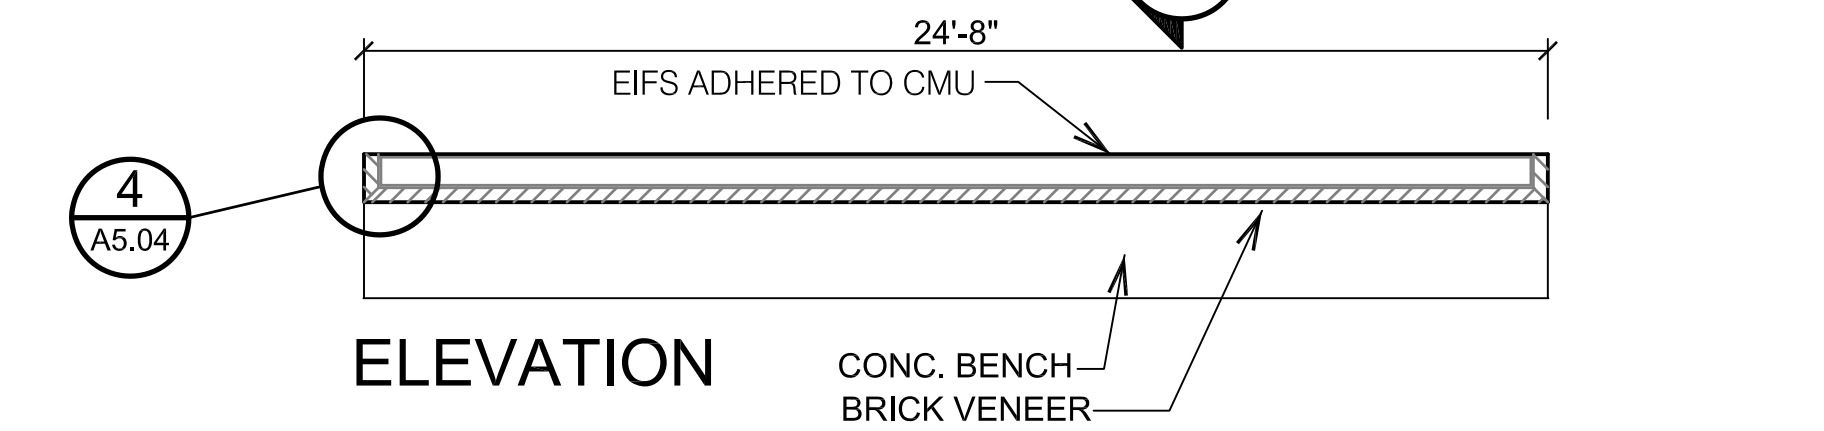


ELEVATION


3 COURTYARD WALL DETAILS
A5.04 SCALE: 1/4" = 1'-0"

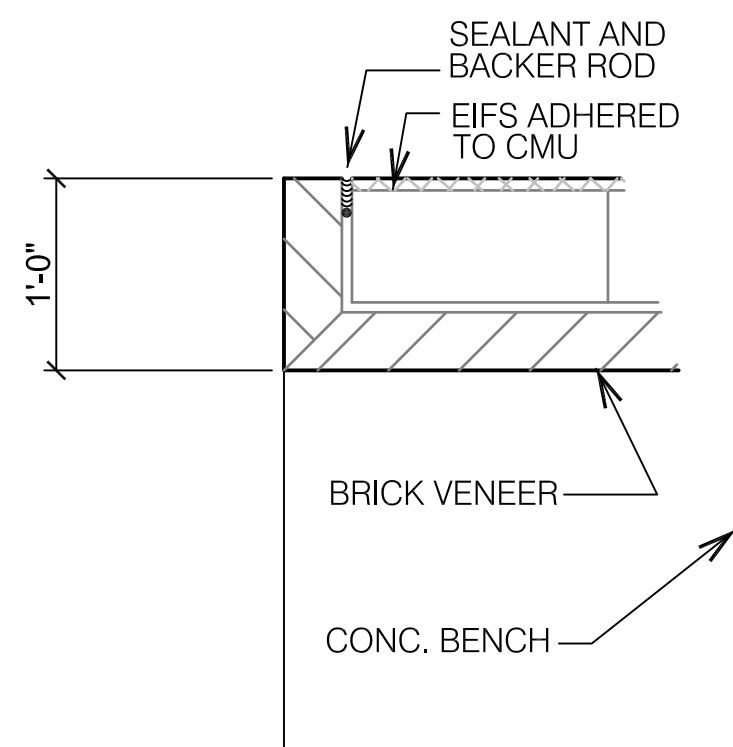


4 WALL DETAILS
A5.04 Scale: 1/4" = 1'-0"

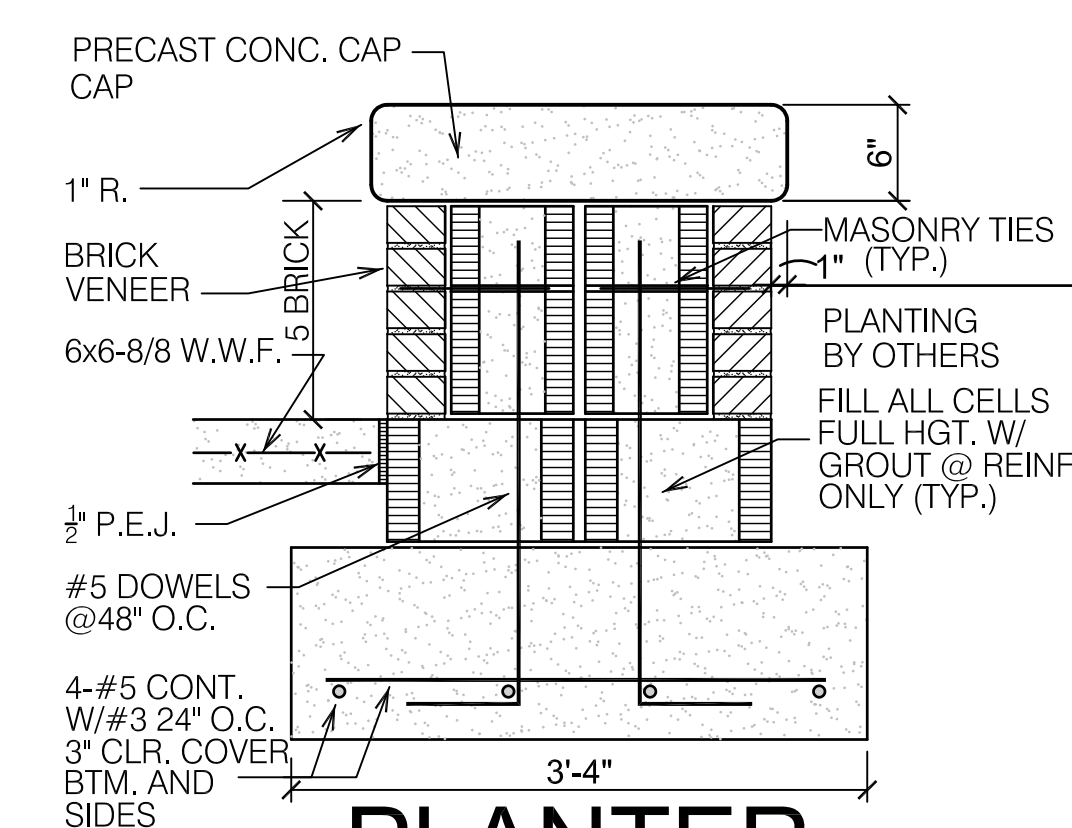

5 PLANTER
A5.04 SCALE: 1" = 1'-0"

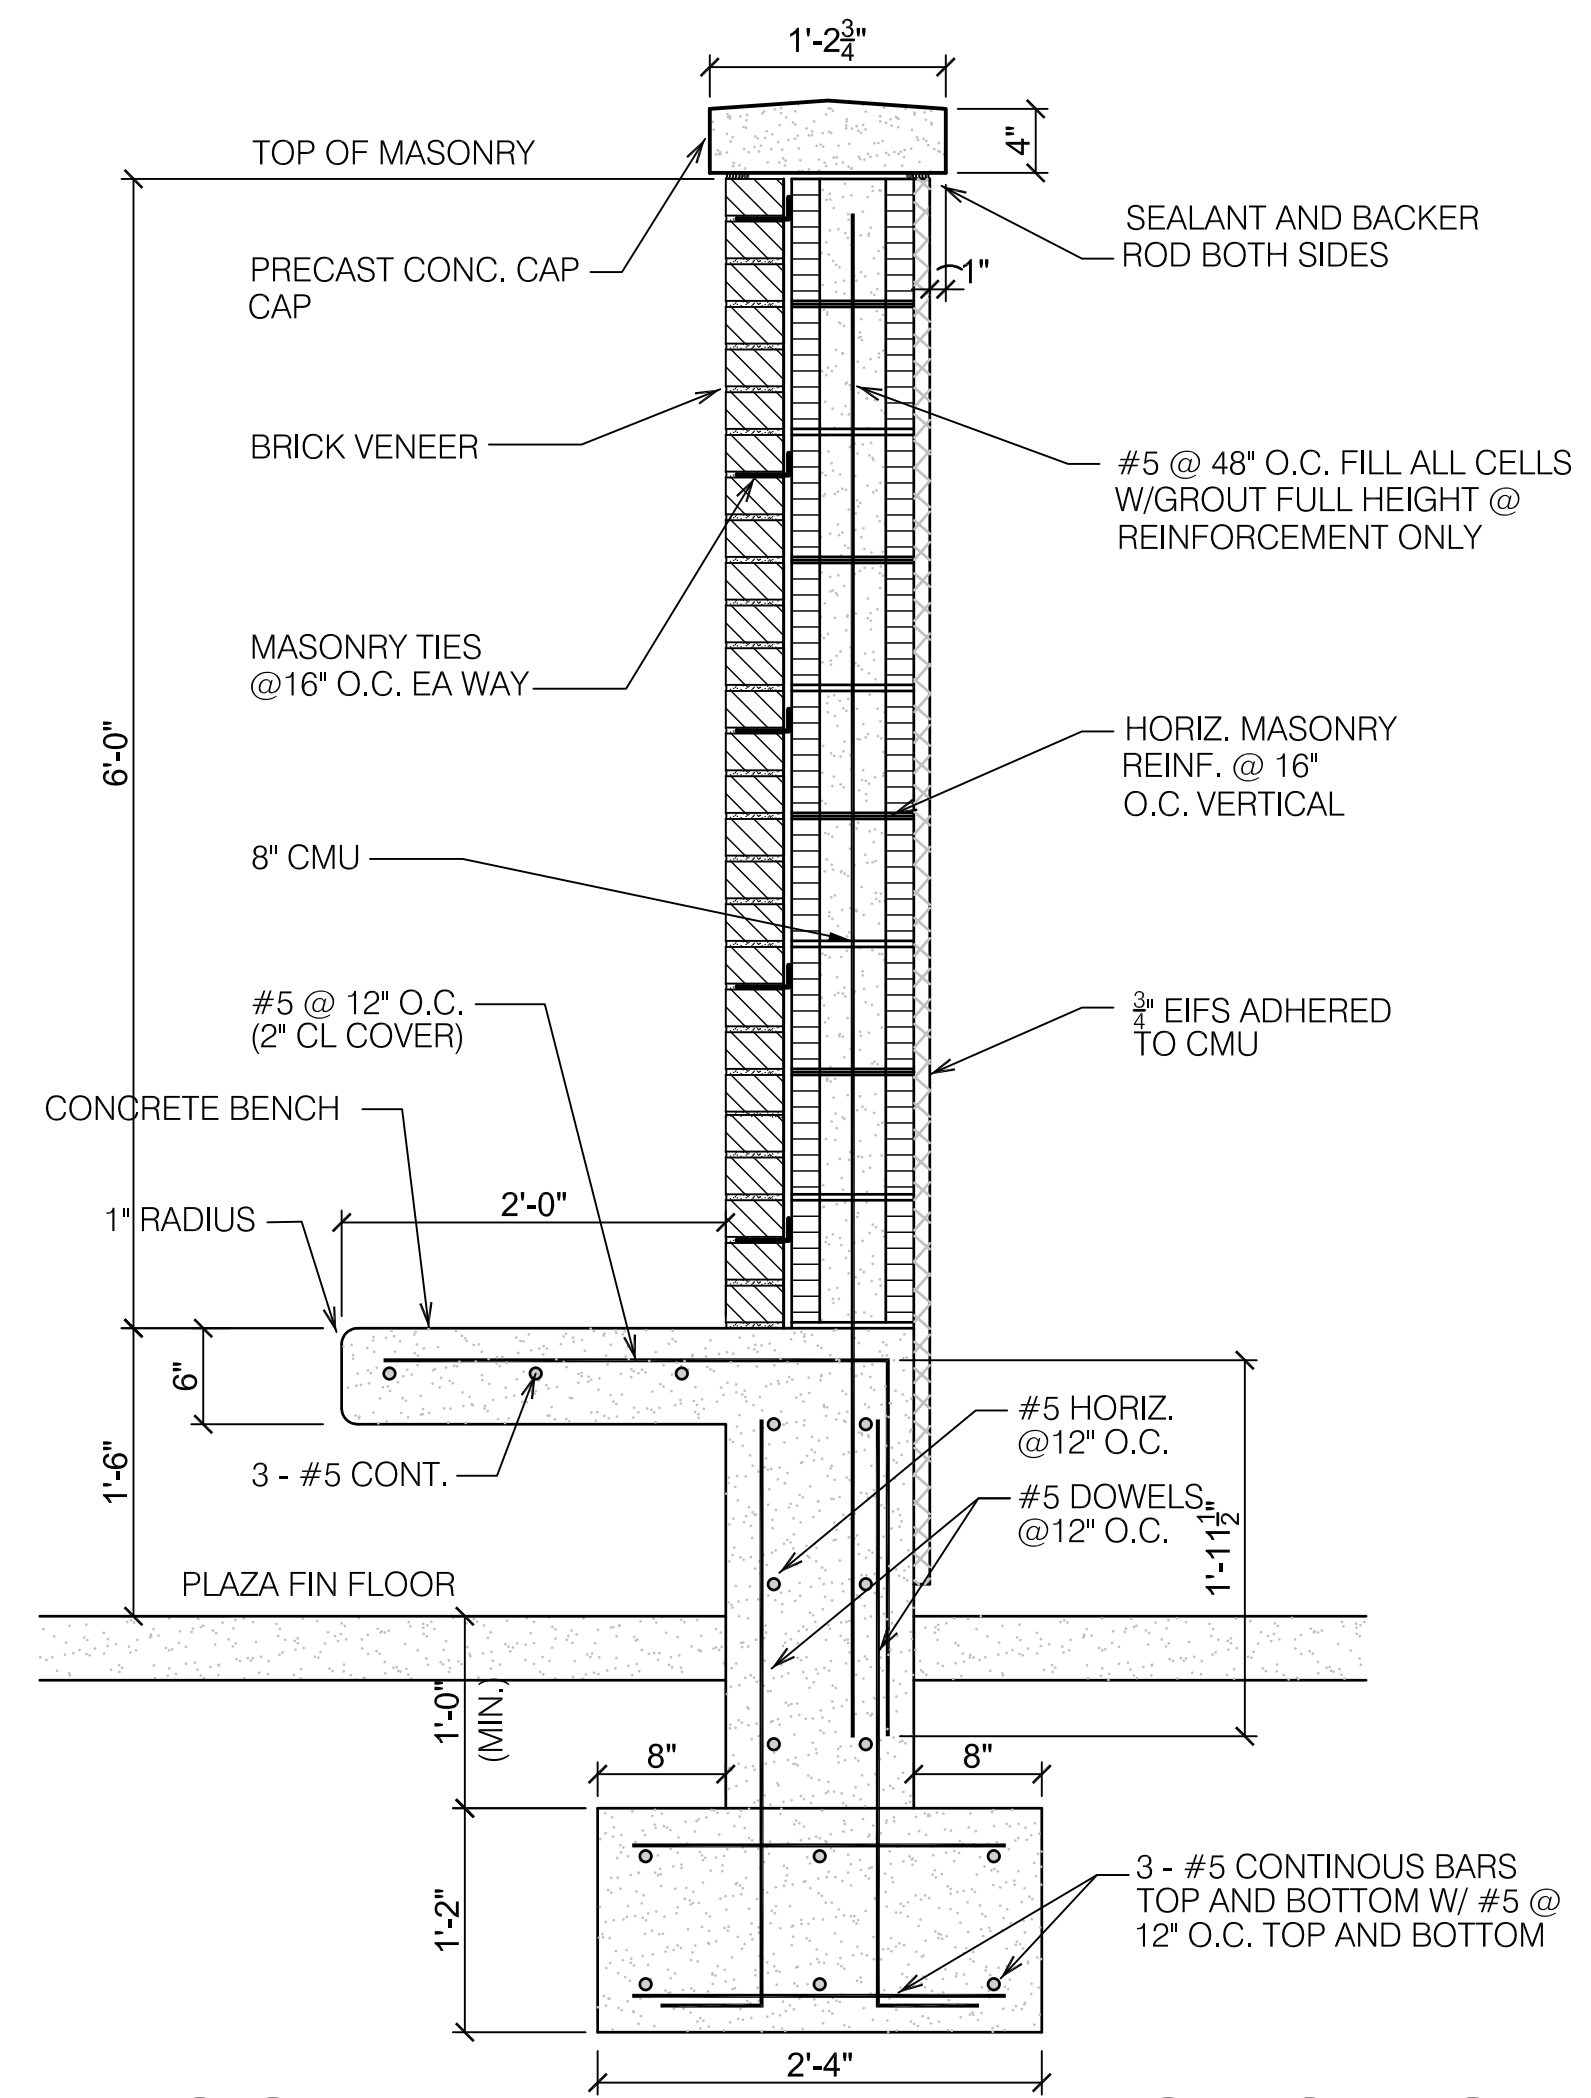

6 COURTYARD WALL SECTION
A5.04 SCALE: 1" = 1'-0"

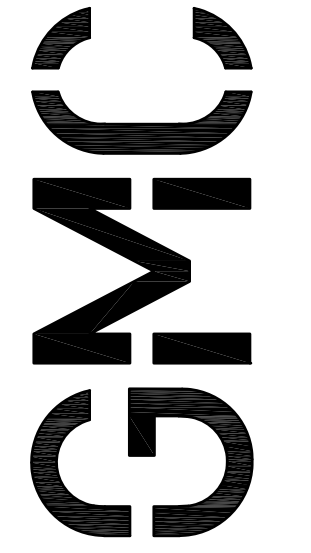


AS-BUILT

2660 East Chase Lane, Suite 200
Montgomery, AL 36117
T 334.271.3200
GMCNETWORK.COM

ISSUE	DATE
75% REVIEW	04/18/19
95% REVIEW	05/30/19
PERMIT SET	10/11/19
DESIGNED BY:	GMC
DRAWN BY:	GMC
CHECKED BY:	GMC


THE EXCHANGE AT HOMEPLACE
PRATTVILLE, AL

GMC PROJECT#AMGM180037

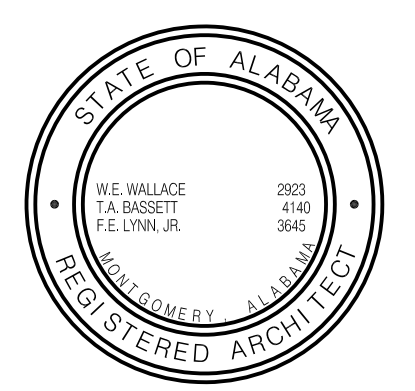


ELEVATION DETAILS

A5.04
Sheet of

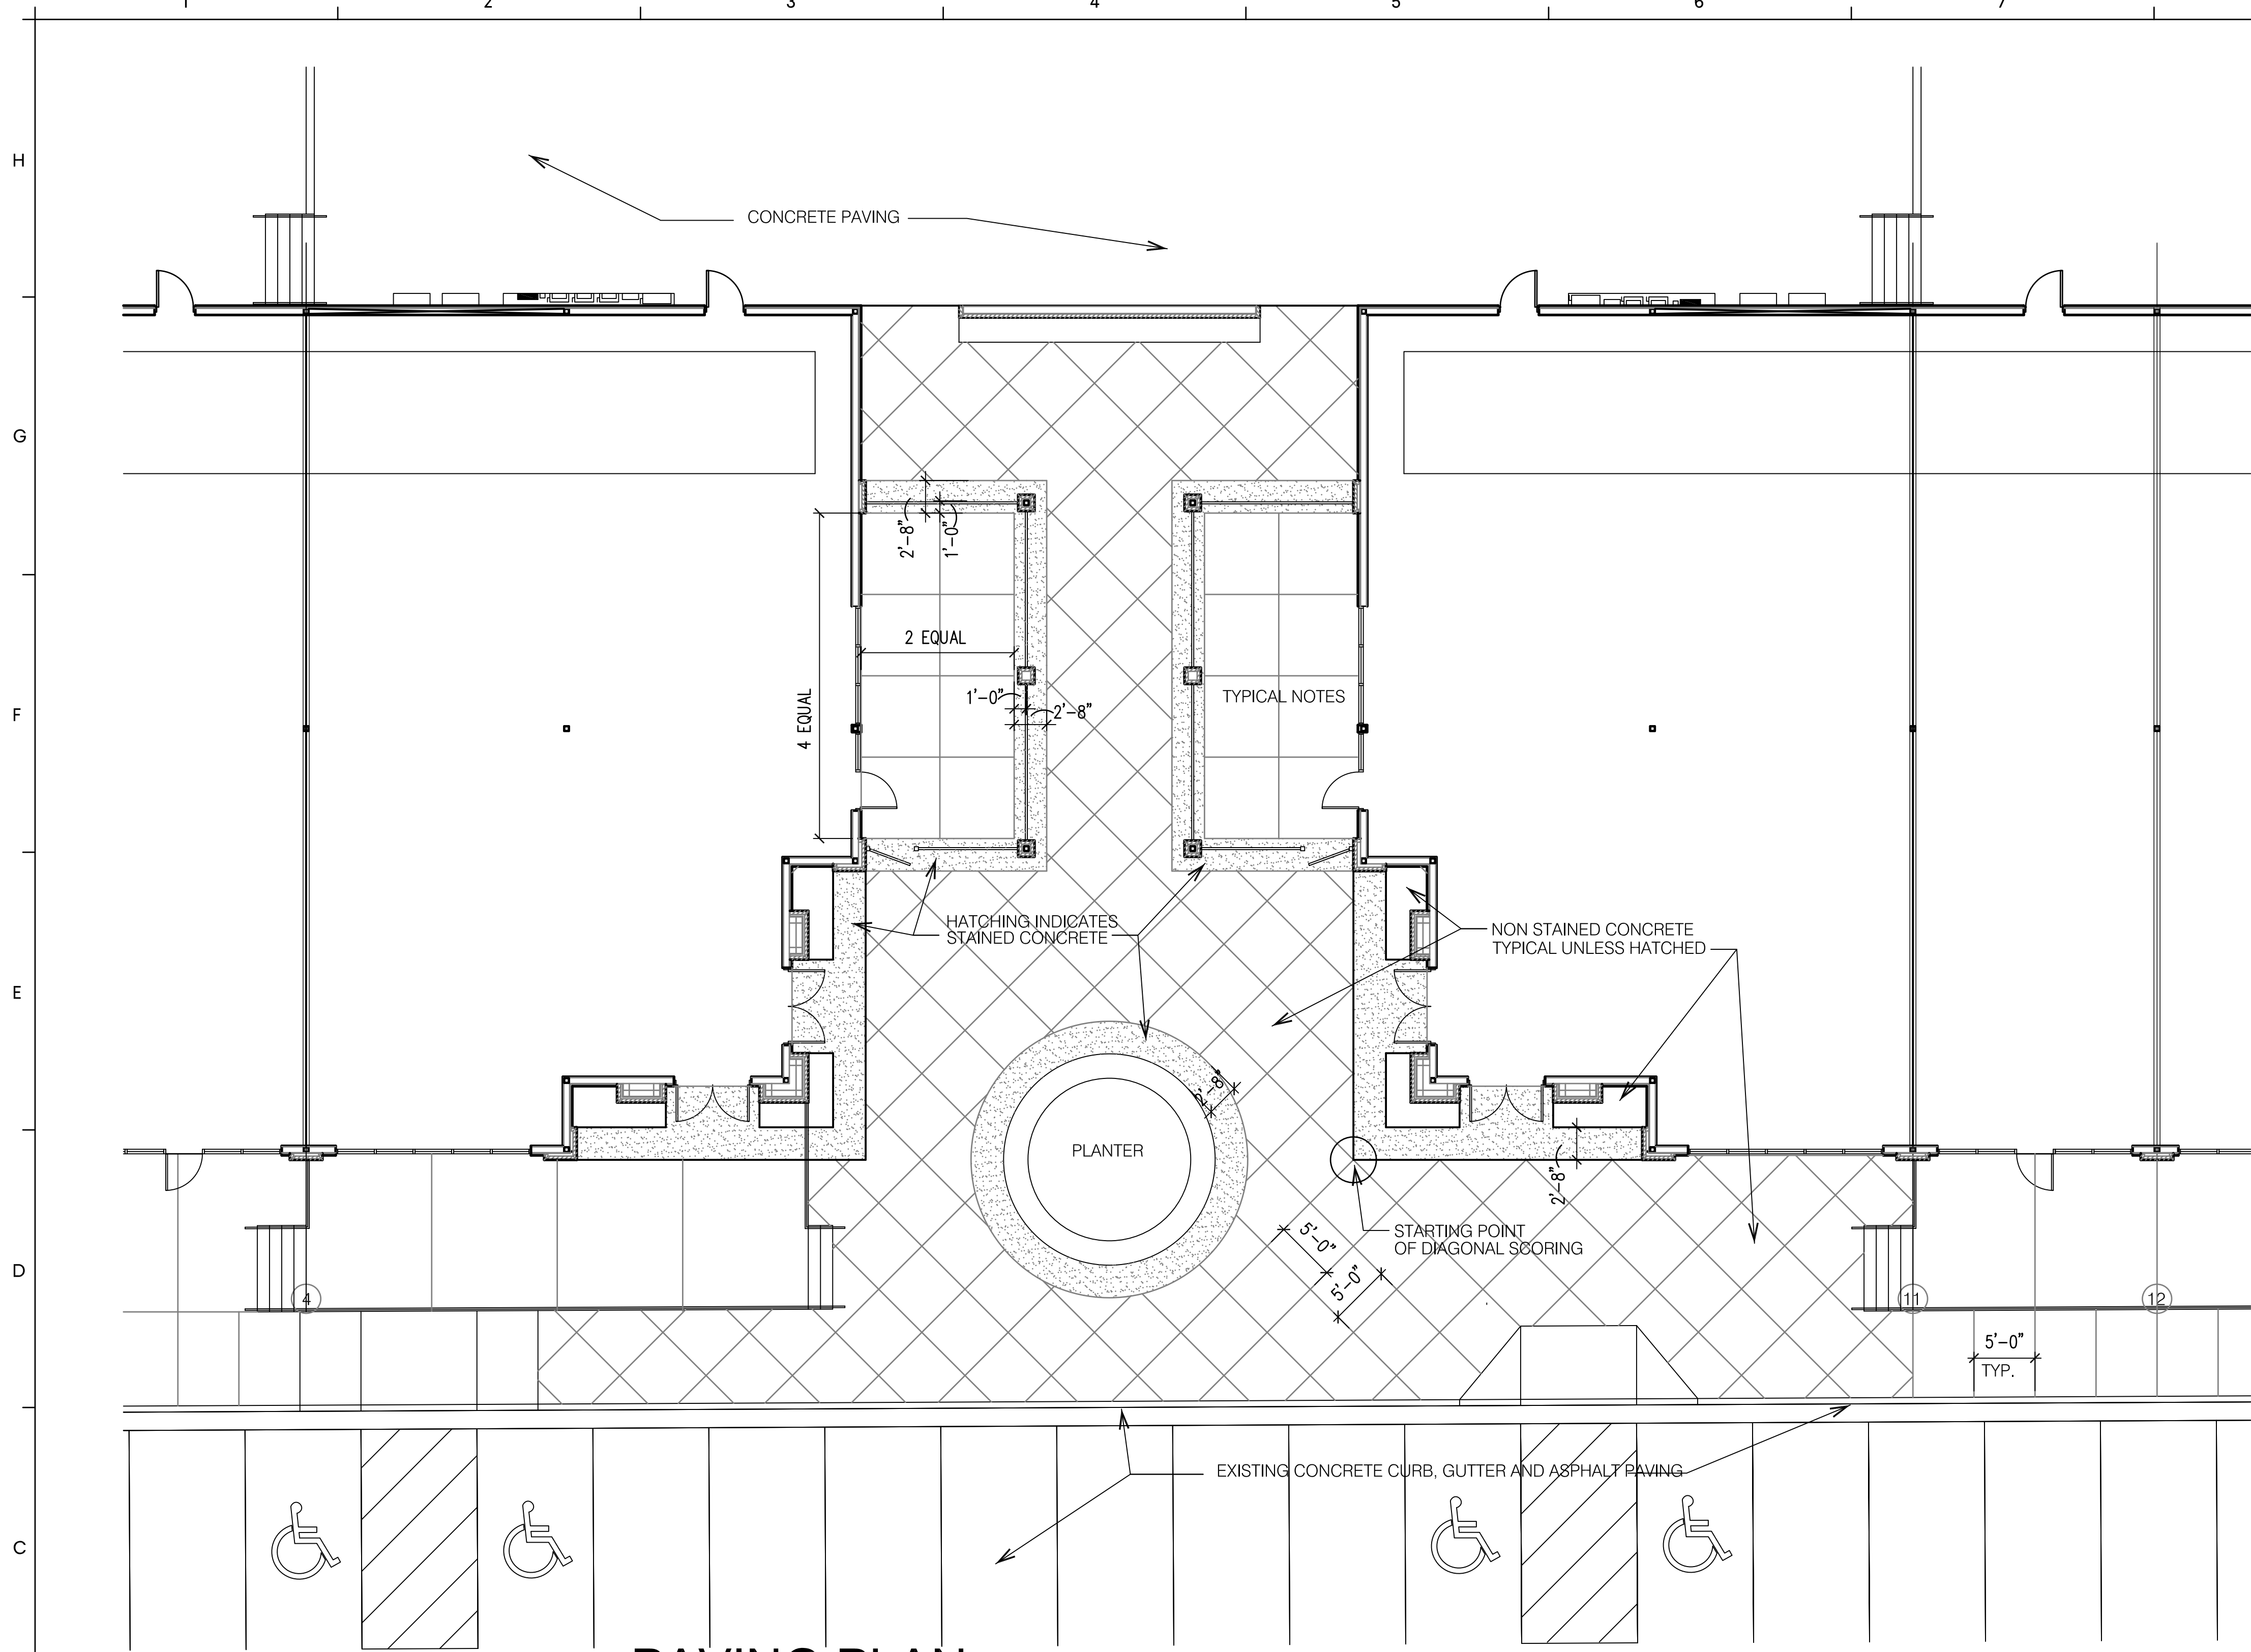

1 PAVING PLAN
 A6.01 SCALE: 1/8" = 1'-0"

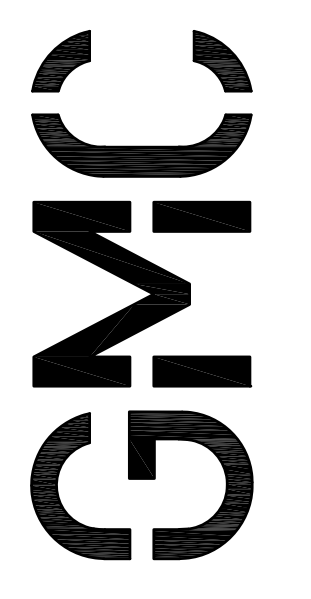


AS-BUILT

2660 East Chase Lane, Suite 200
 Montgomery, AL 36117
 T 334.271.3200
 GMCNETWORK.COM

ISSUE	DATE
75% REVIEW	04/18/19
95% REVIEW	05/30/19
PERMIT SET	10/11/19
DESIGNED BY:	GMC
DRAWN BY:	GMC
CHECKED BY:	GMC


THE EXCHANGE AT HOMEPLACE
 PRATTVILLE, AL

GMC PROJECT#AMGM180037

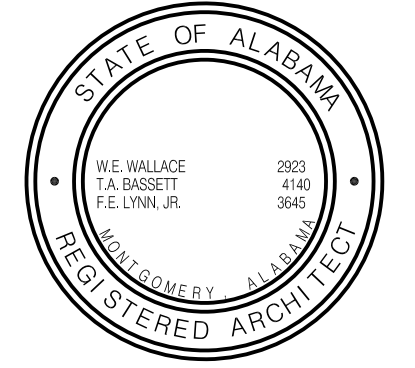

PAVING PLAN

A6.01
 sheet of

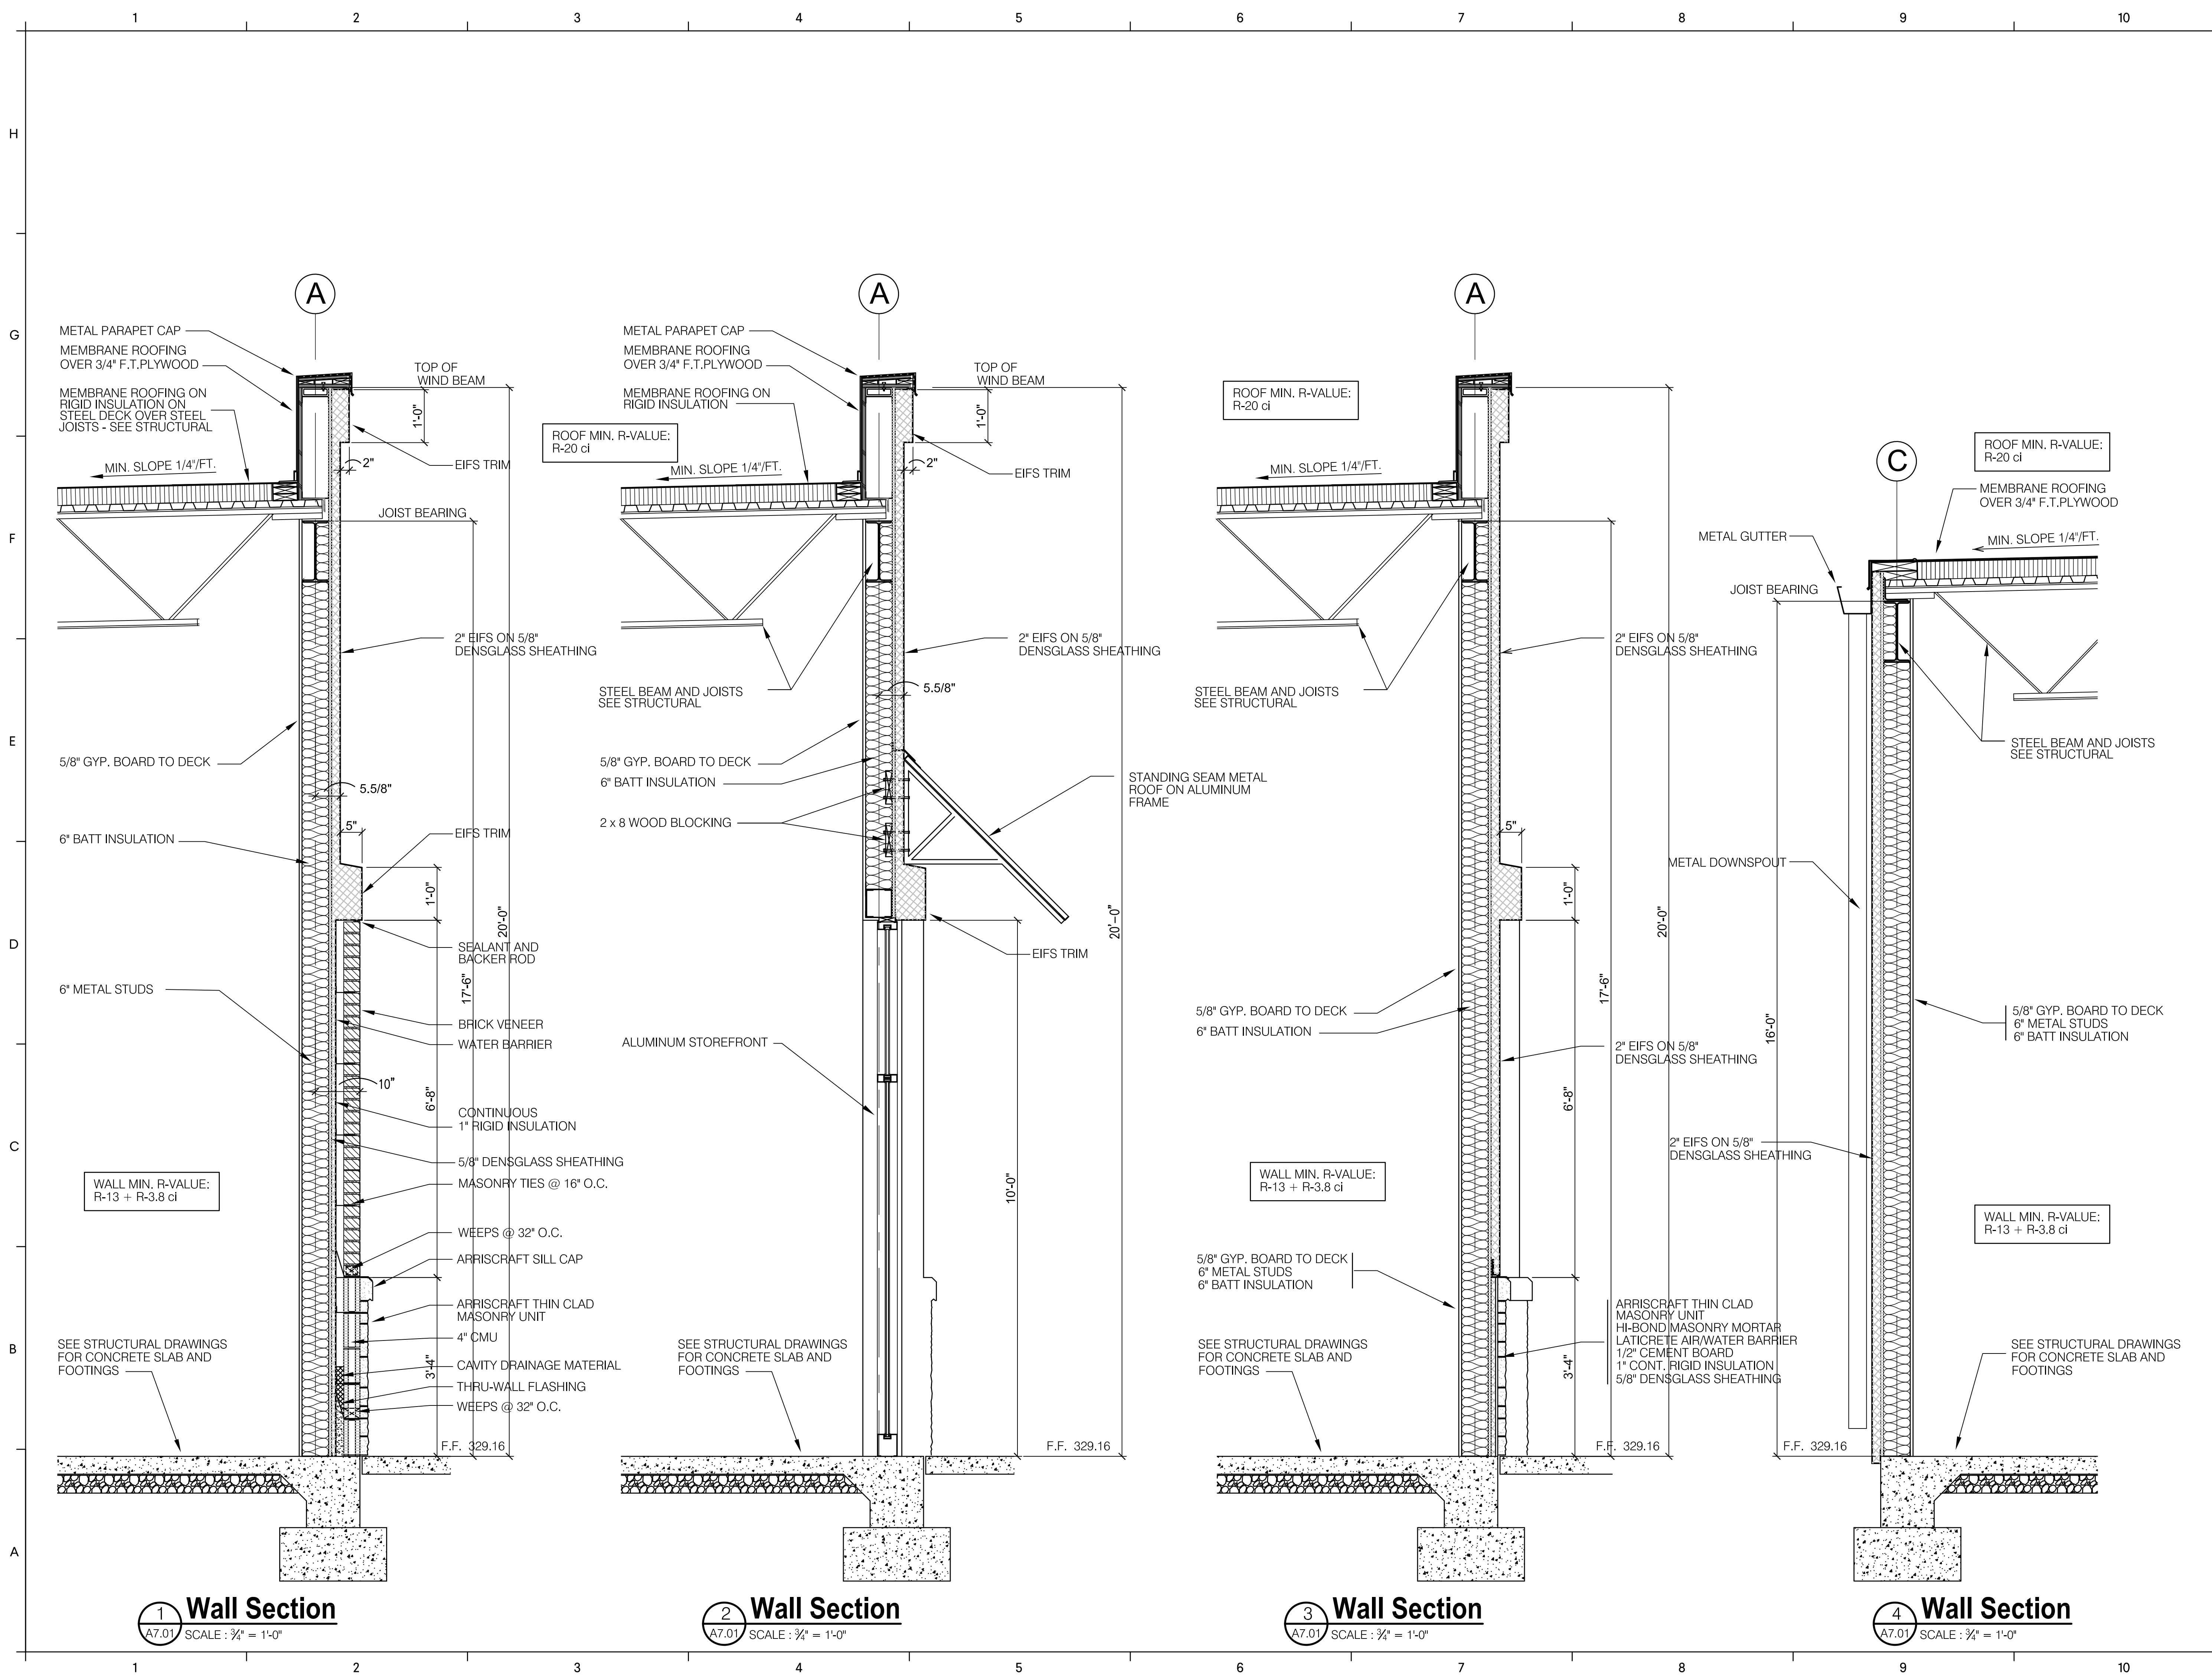

2660 East Chase Lane, Suite 200
 Montgomery, AL 36117
 T 334.271.3200
 GMCNETWORK.COM

ISSUE	DATE
75% REVIEW	04/18/19
95% REVIEW	05/30/19

DESIGNED BY: GMC
 DRAWN BY: GMC
 CHECKED BY: GMC

THE EXCHANGE AT HOMEPLACE
 PRATTVILLE, AL
 GMC PROJECT#AMGM180037




1 Wall Section
 A7.01 SCALE: 3/4" = 1'-0"

2 Wall Section
 A7.01 SCALE: 3/4" = 1'-0"


3 Wall Section
 A7.01 SCALE: 3/4" = 1'-0"

4 Wall Section
 A7.01 SCALE: 3/4" = 1'-0"

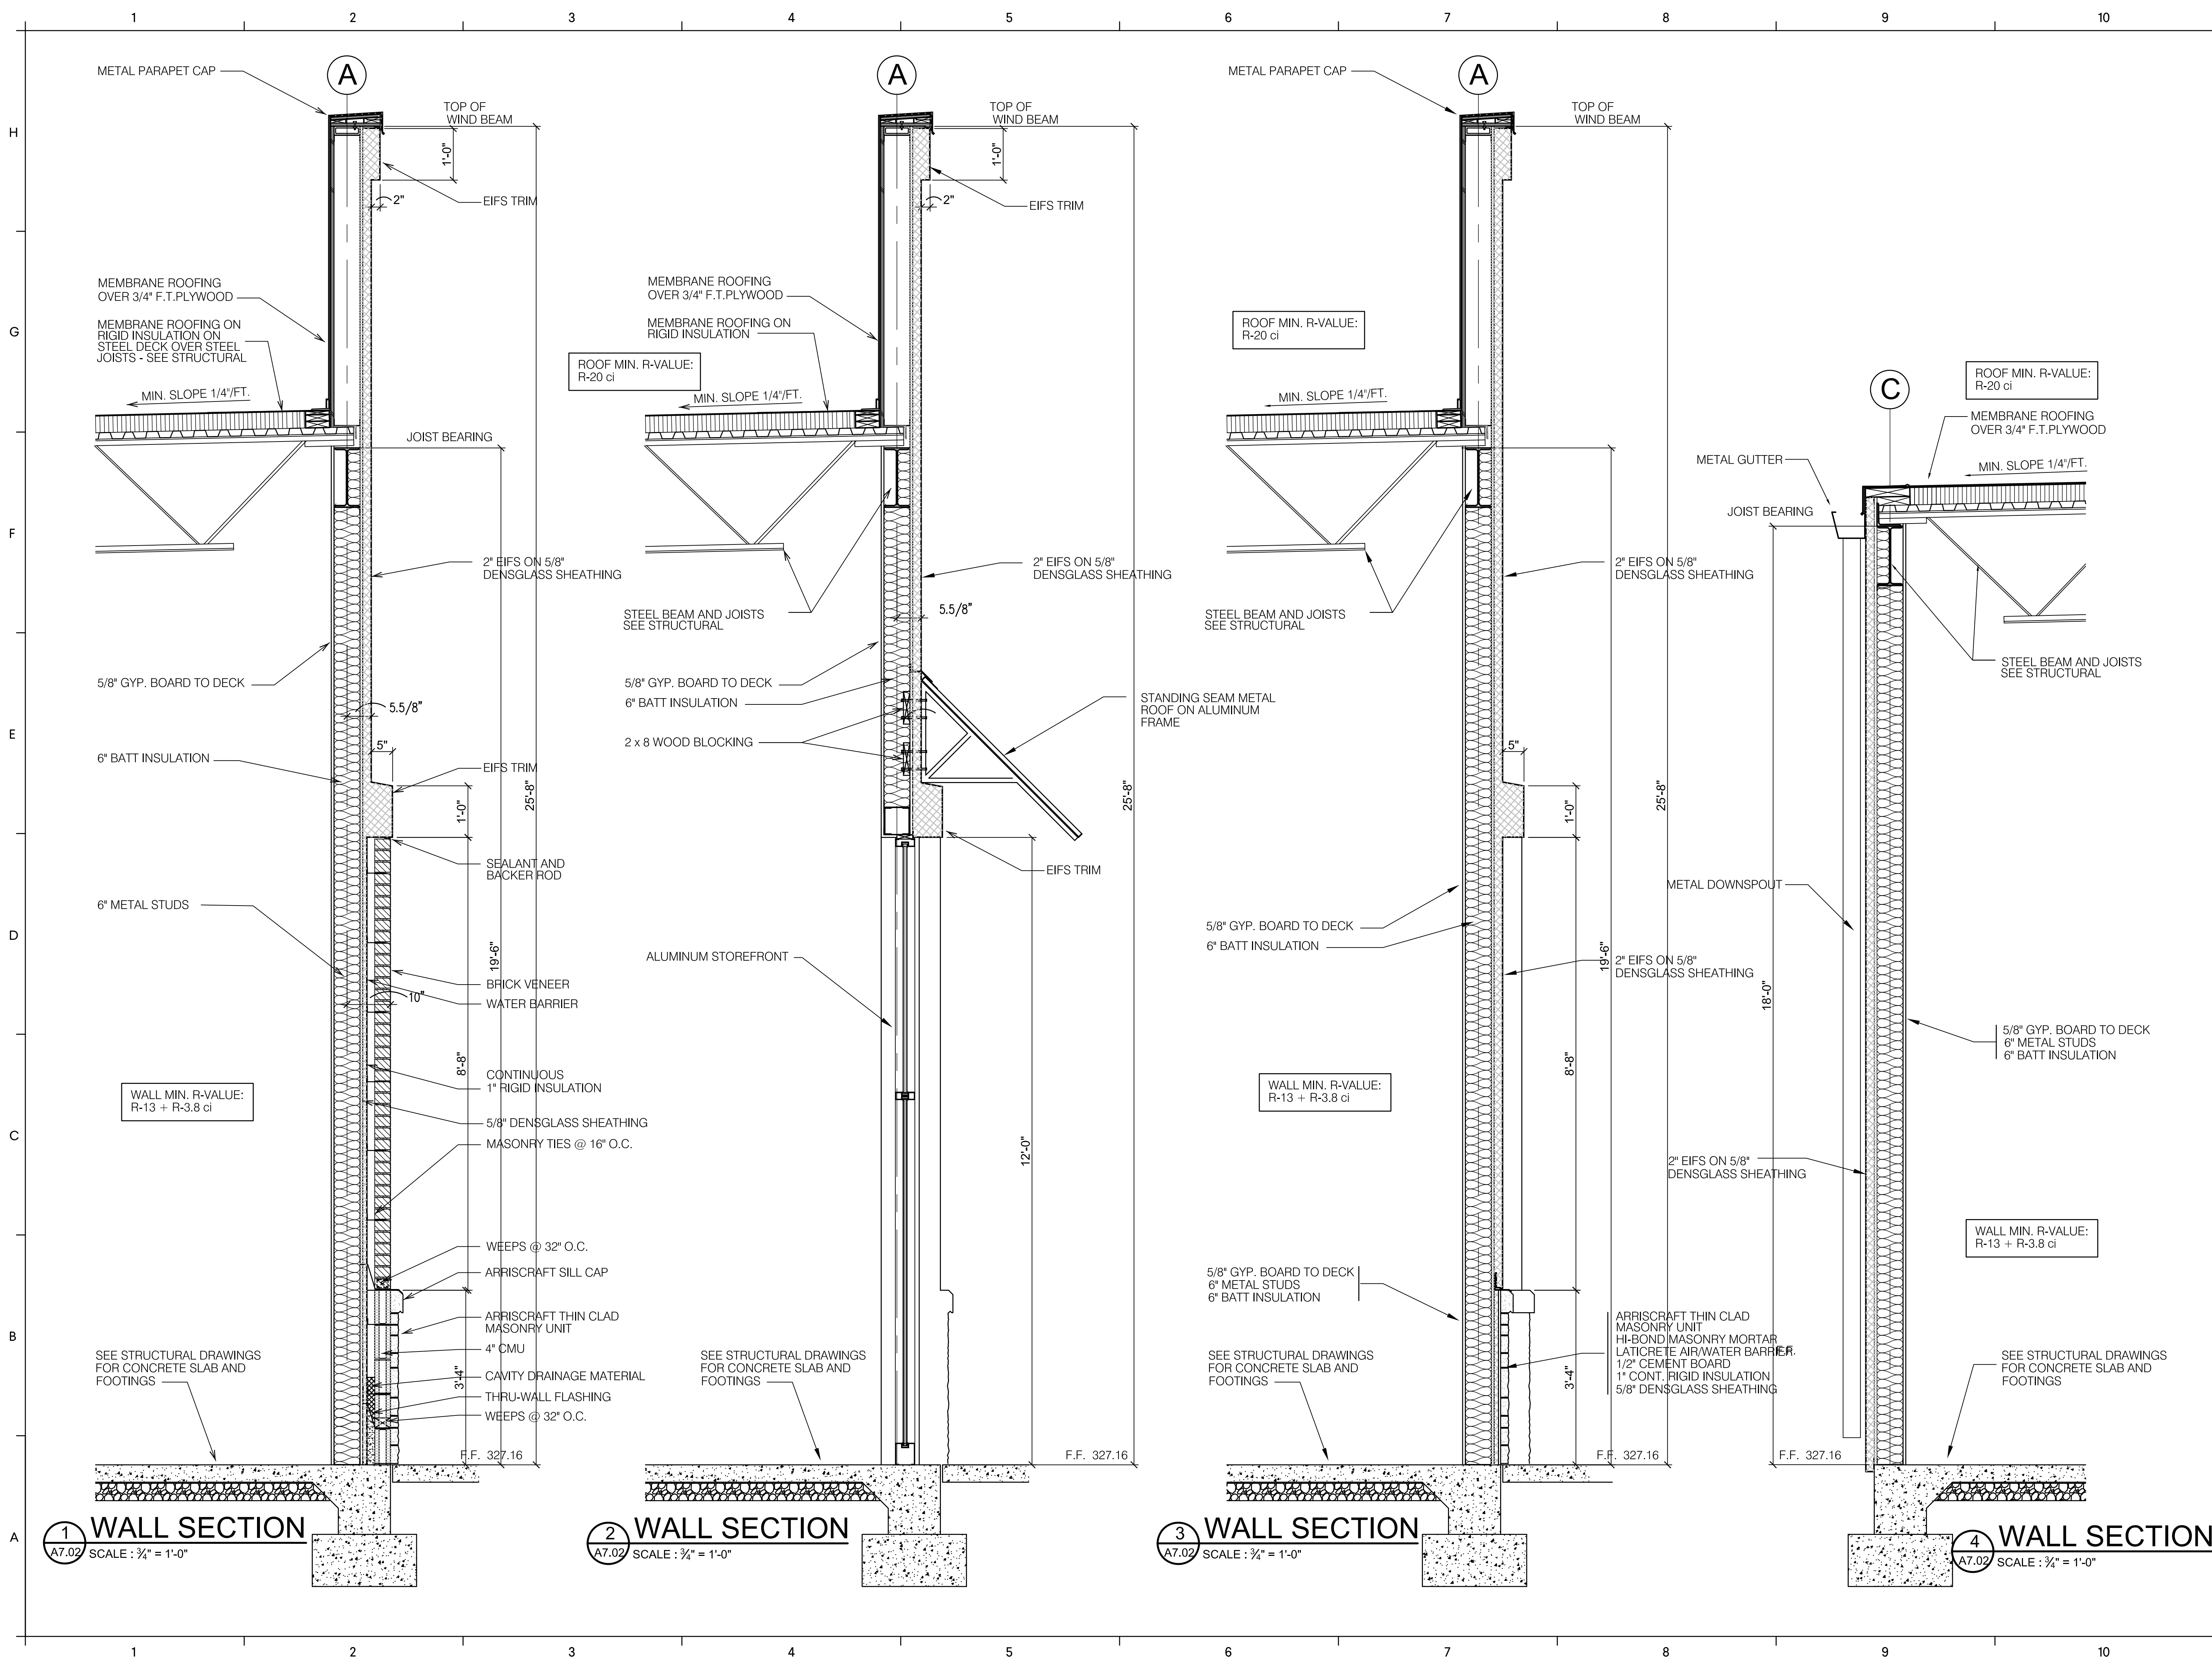


ISSUE	DATE
75% REVIEW	04/18/19
95% REVIEW	05/30/19


DESIGNED BY: GMC
 DRAWN BY: GMC
 CHECKED BY: GMC

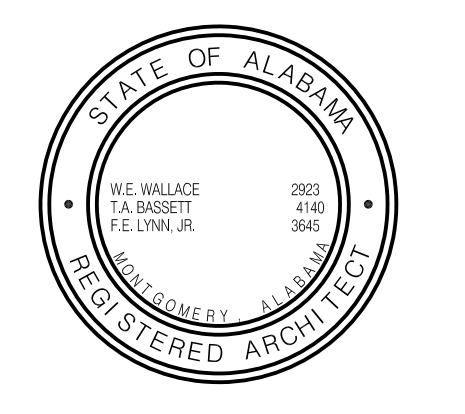


THE EXCHANGE AT HOMEPLACE
 PRATTVILLE, AL
 GMC PROJECT#AMGM180037

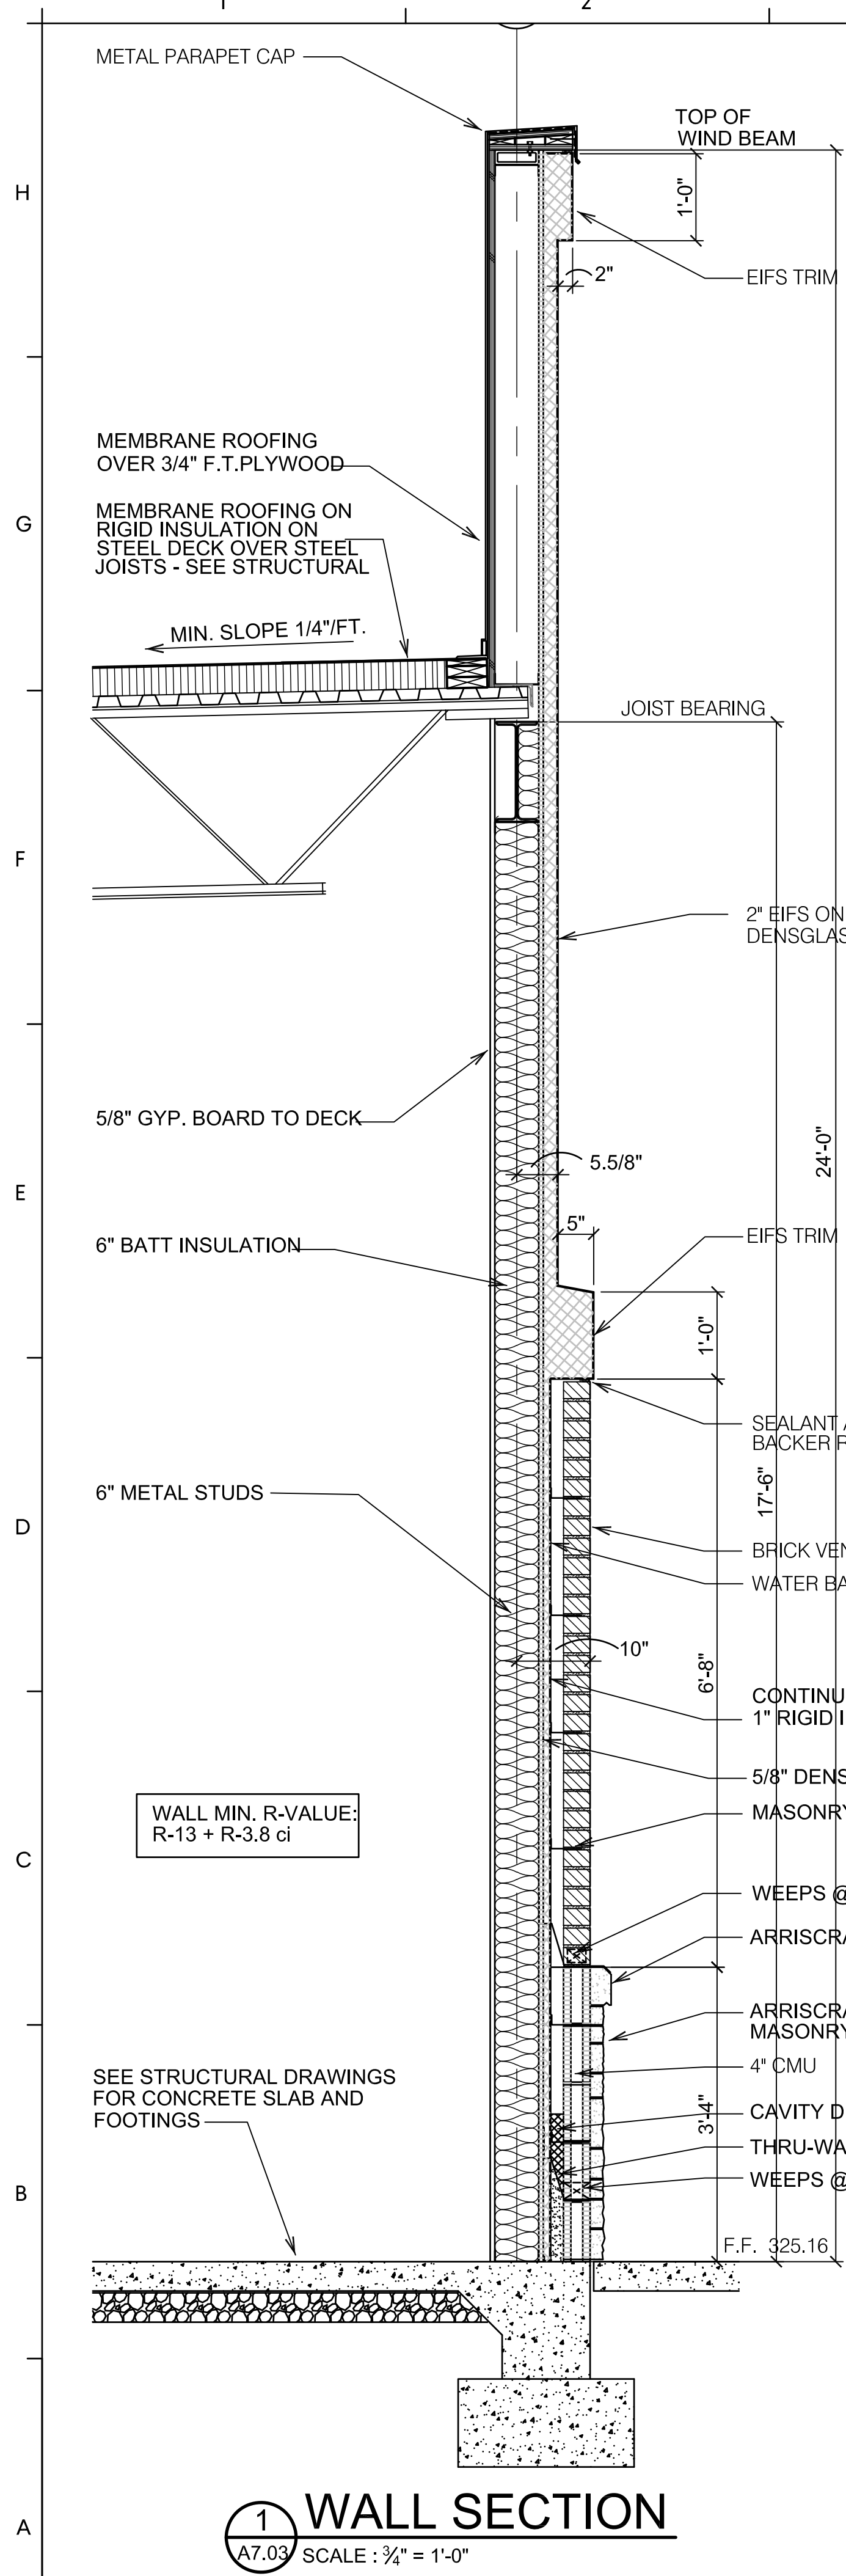


1 WALL SECTION
A7.03 SCALE: 3/4" = 1'-0"

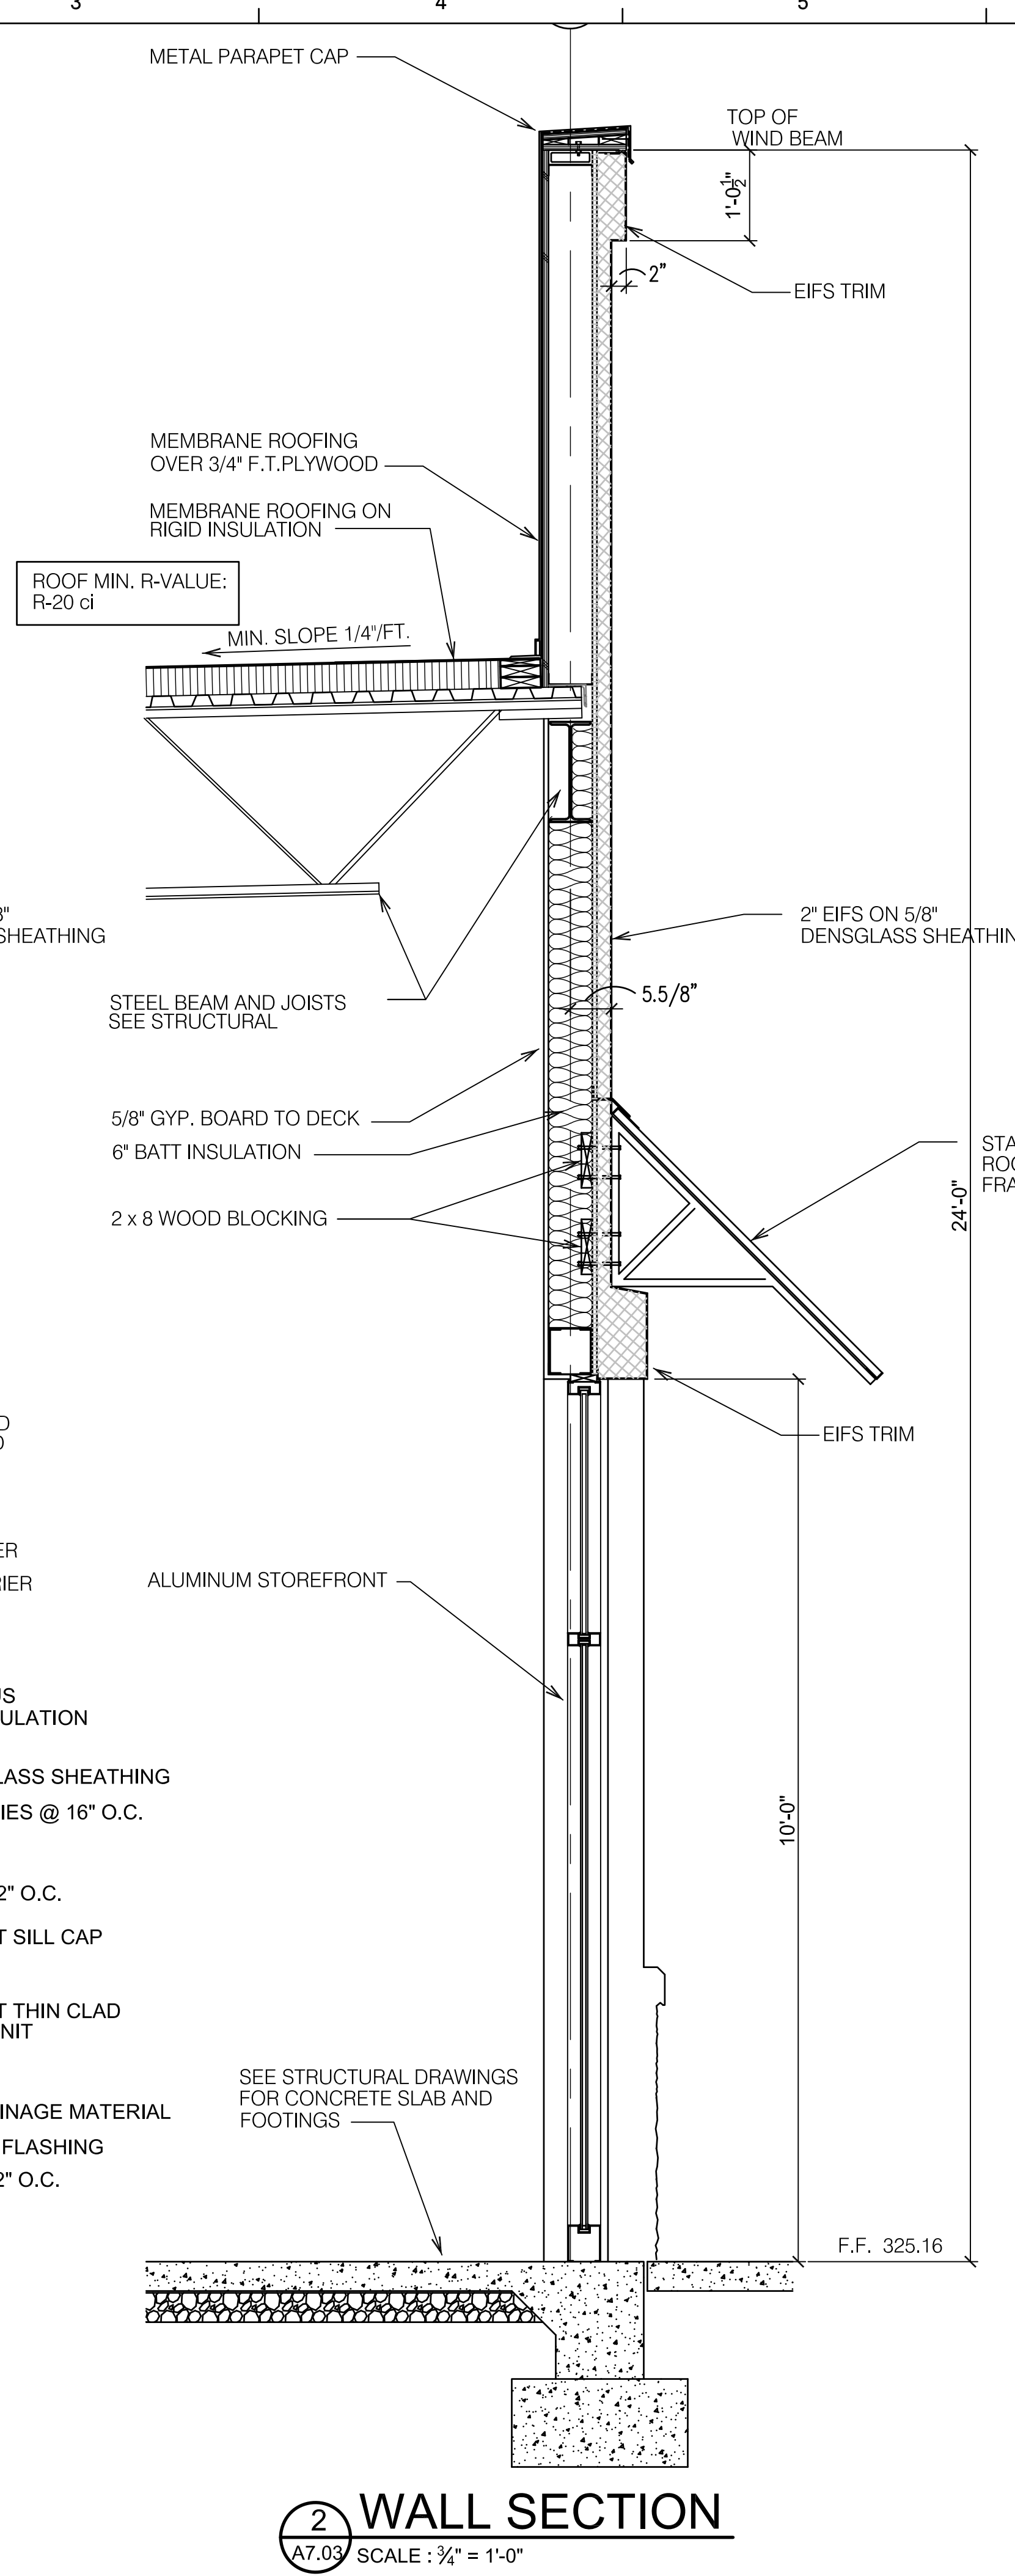


2 WALL SECTION
A7.03 SCALE: 3/4" = 1'-0"

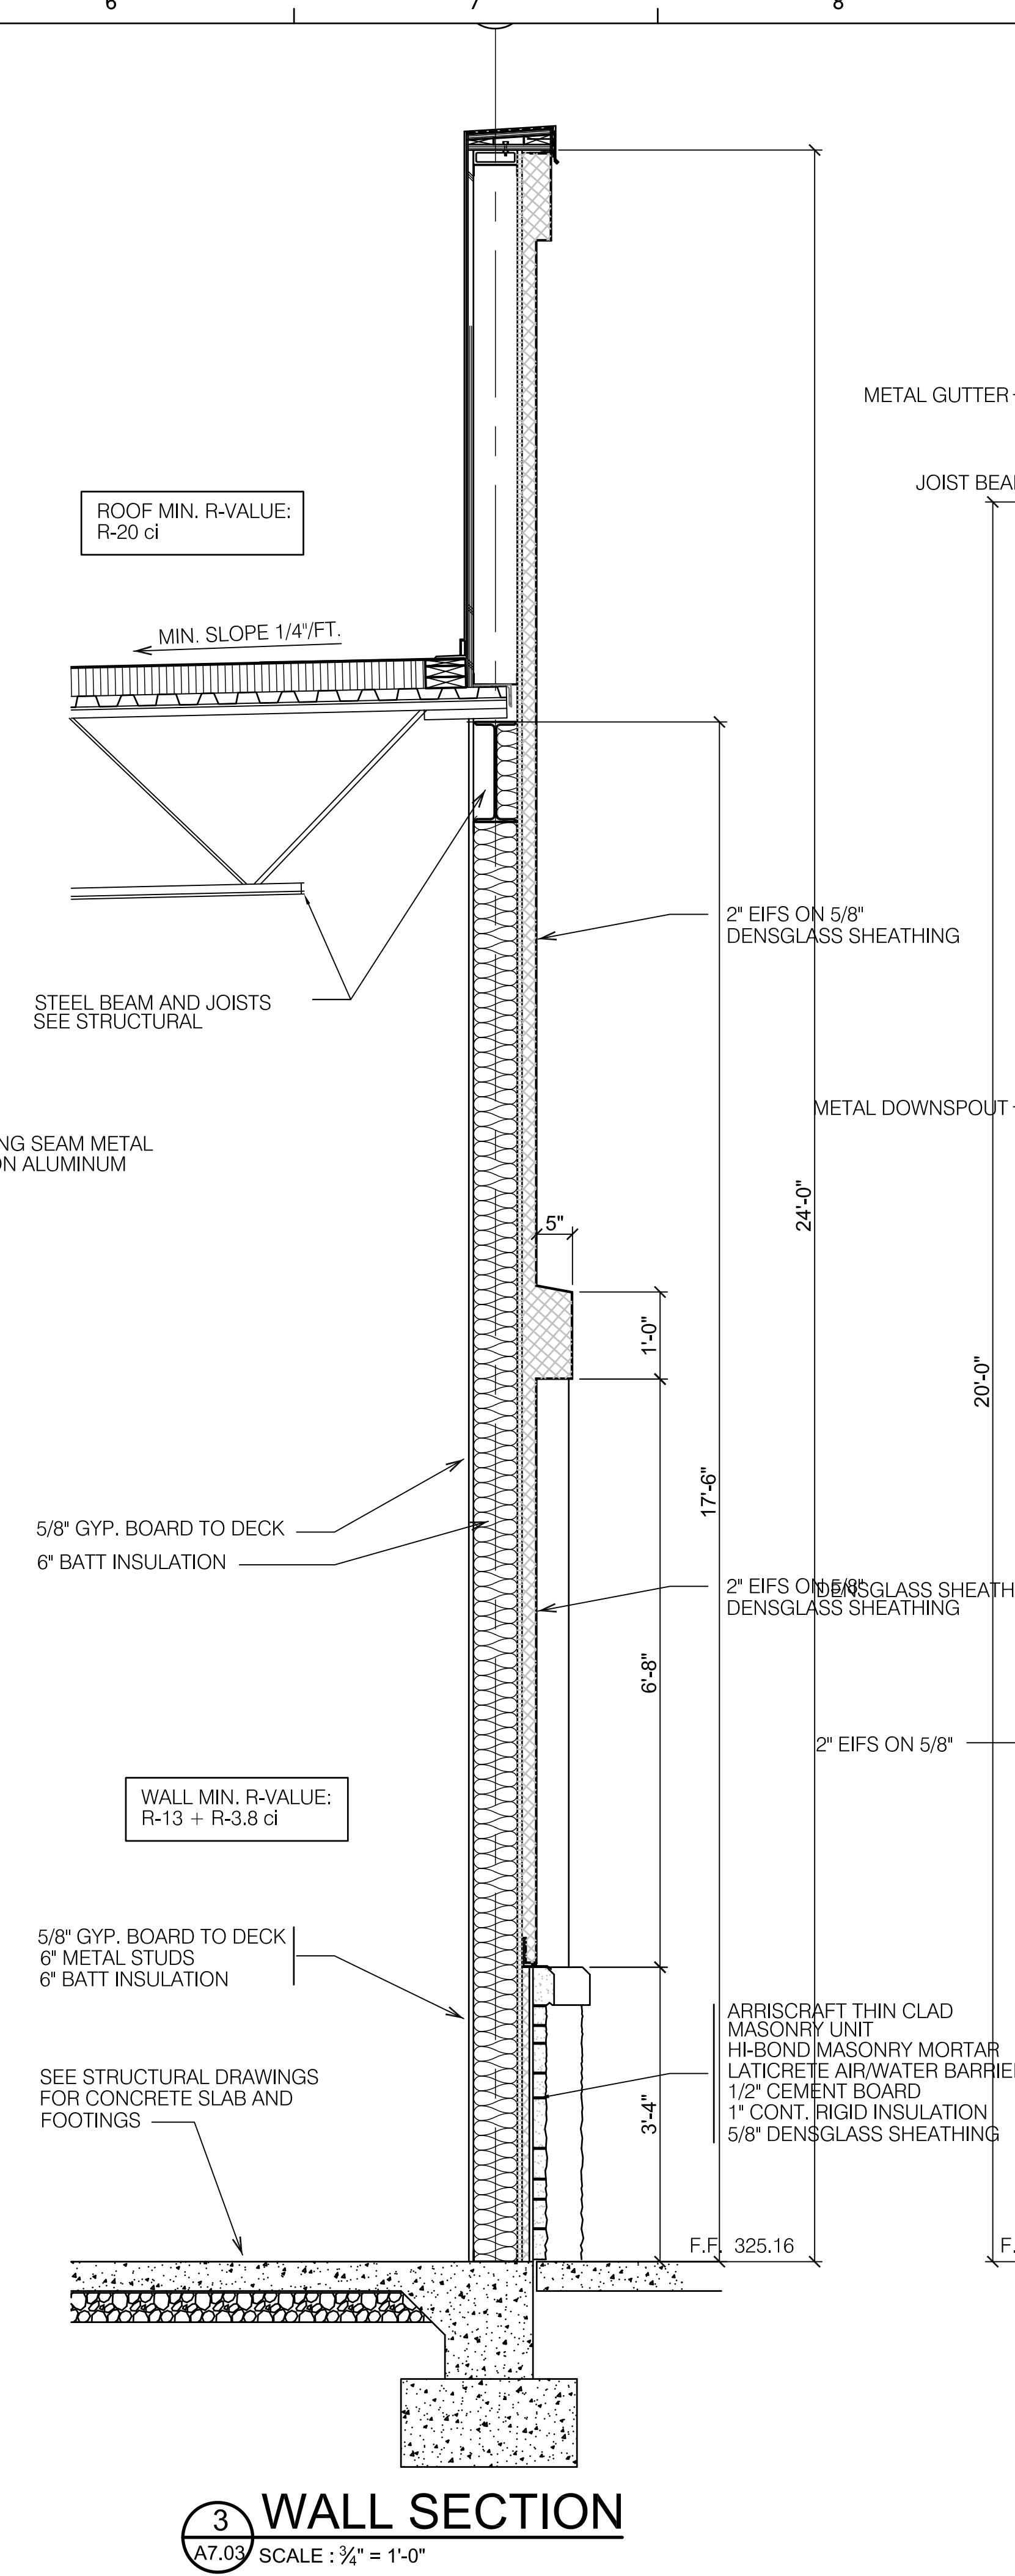

3 WALL SECTION
A7.03 SCALE: 3/4" = 1'-0"

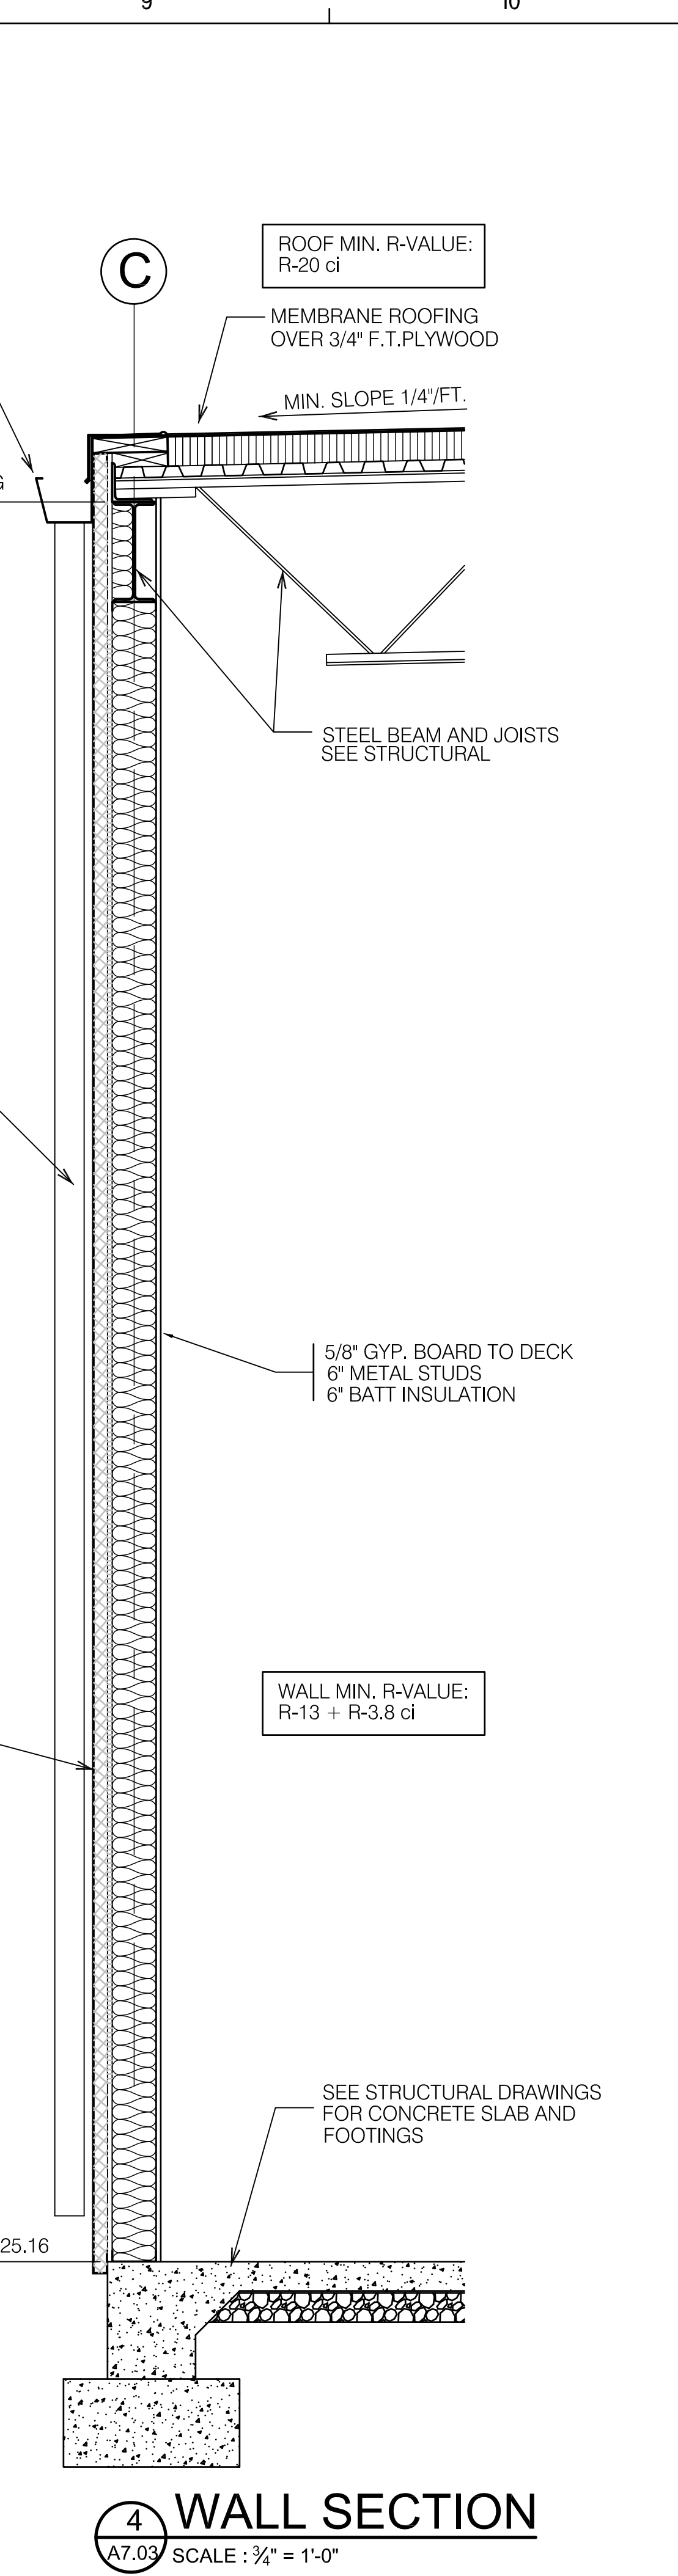

4 WALL SECTION
A7.03 SCALE: 3/4" = 1'-0"

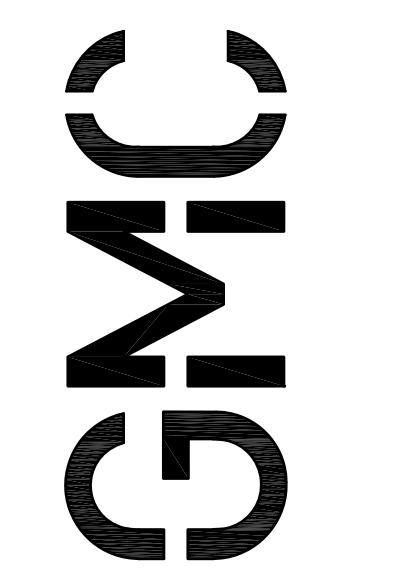


AS-BUILT

2660 East Chase Lane, Suite 200
Montgomery, AL 36117
T 334.271.3200
GMCNETWORK.COM


ISSUE	DATE
75% REVIEW	04/18/19
95% REVIEW	05/30/19

DESIGNED BY: GMC
DRAWN BY: GMC
CHECKED BY: GMC


THE EXCHANGE AT HOMEPLACE
PRATTVILLE, AL
GMC PROJECT#AMGM180037

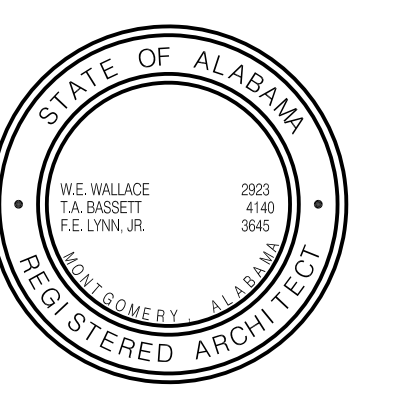

WALL SECTIONS
A7.03
Sheet of

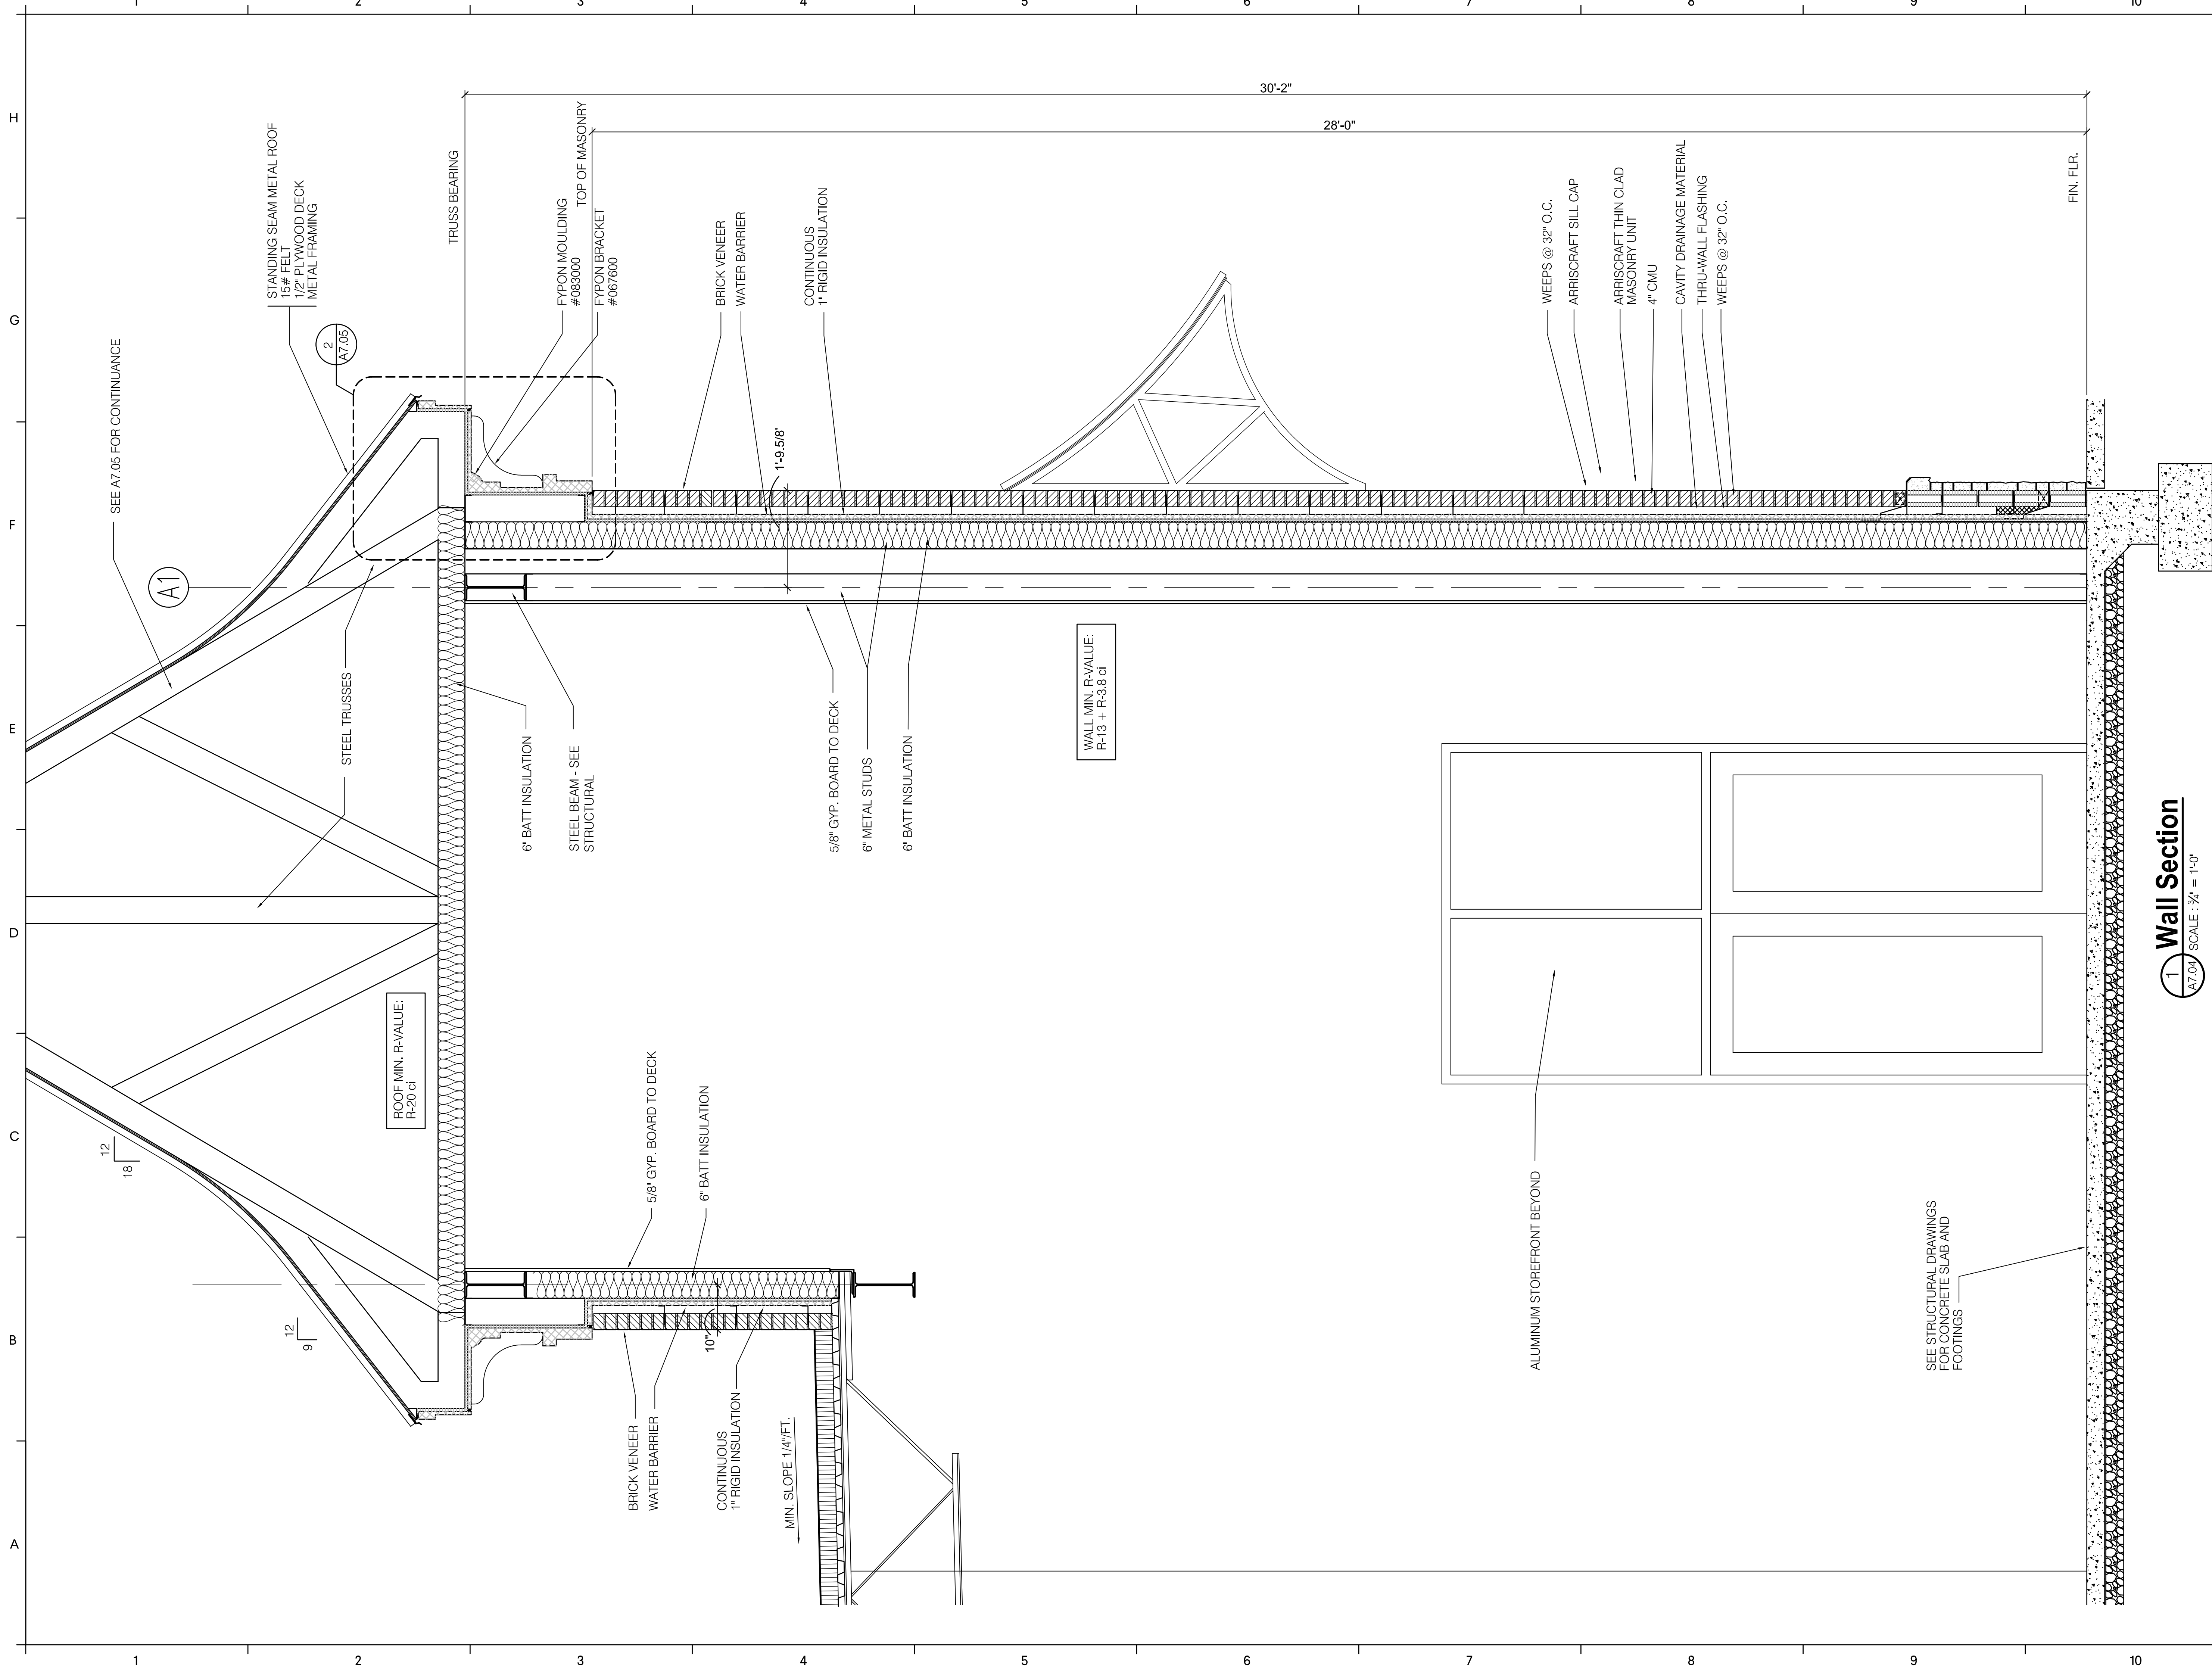

1 Wall Section
 SCALE: 3/4" = 1'-0"

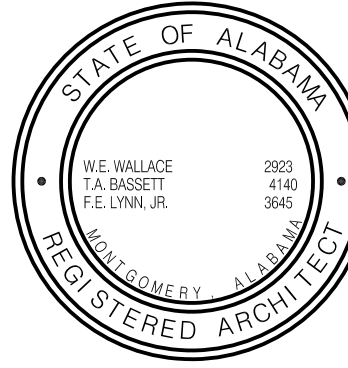

THE EXCHANGE AT HOMEPLACE

PRATTVILLE, AL

GMC PROJECT#AMGM180037

ISSUE DATE


75% REVIEW	04/18/19
95% REVIEW	05/30/19

DESIGNED BY: GMC
 DRAWN BY: GMC
 CHECKED BY: GMC

AS-BUILT

2660 East Chase Lane, Suite 200
 Montgomery, AL 36117
 T 334.271.3200
 GMCNETWORK.COM



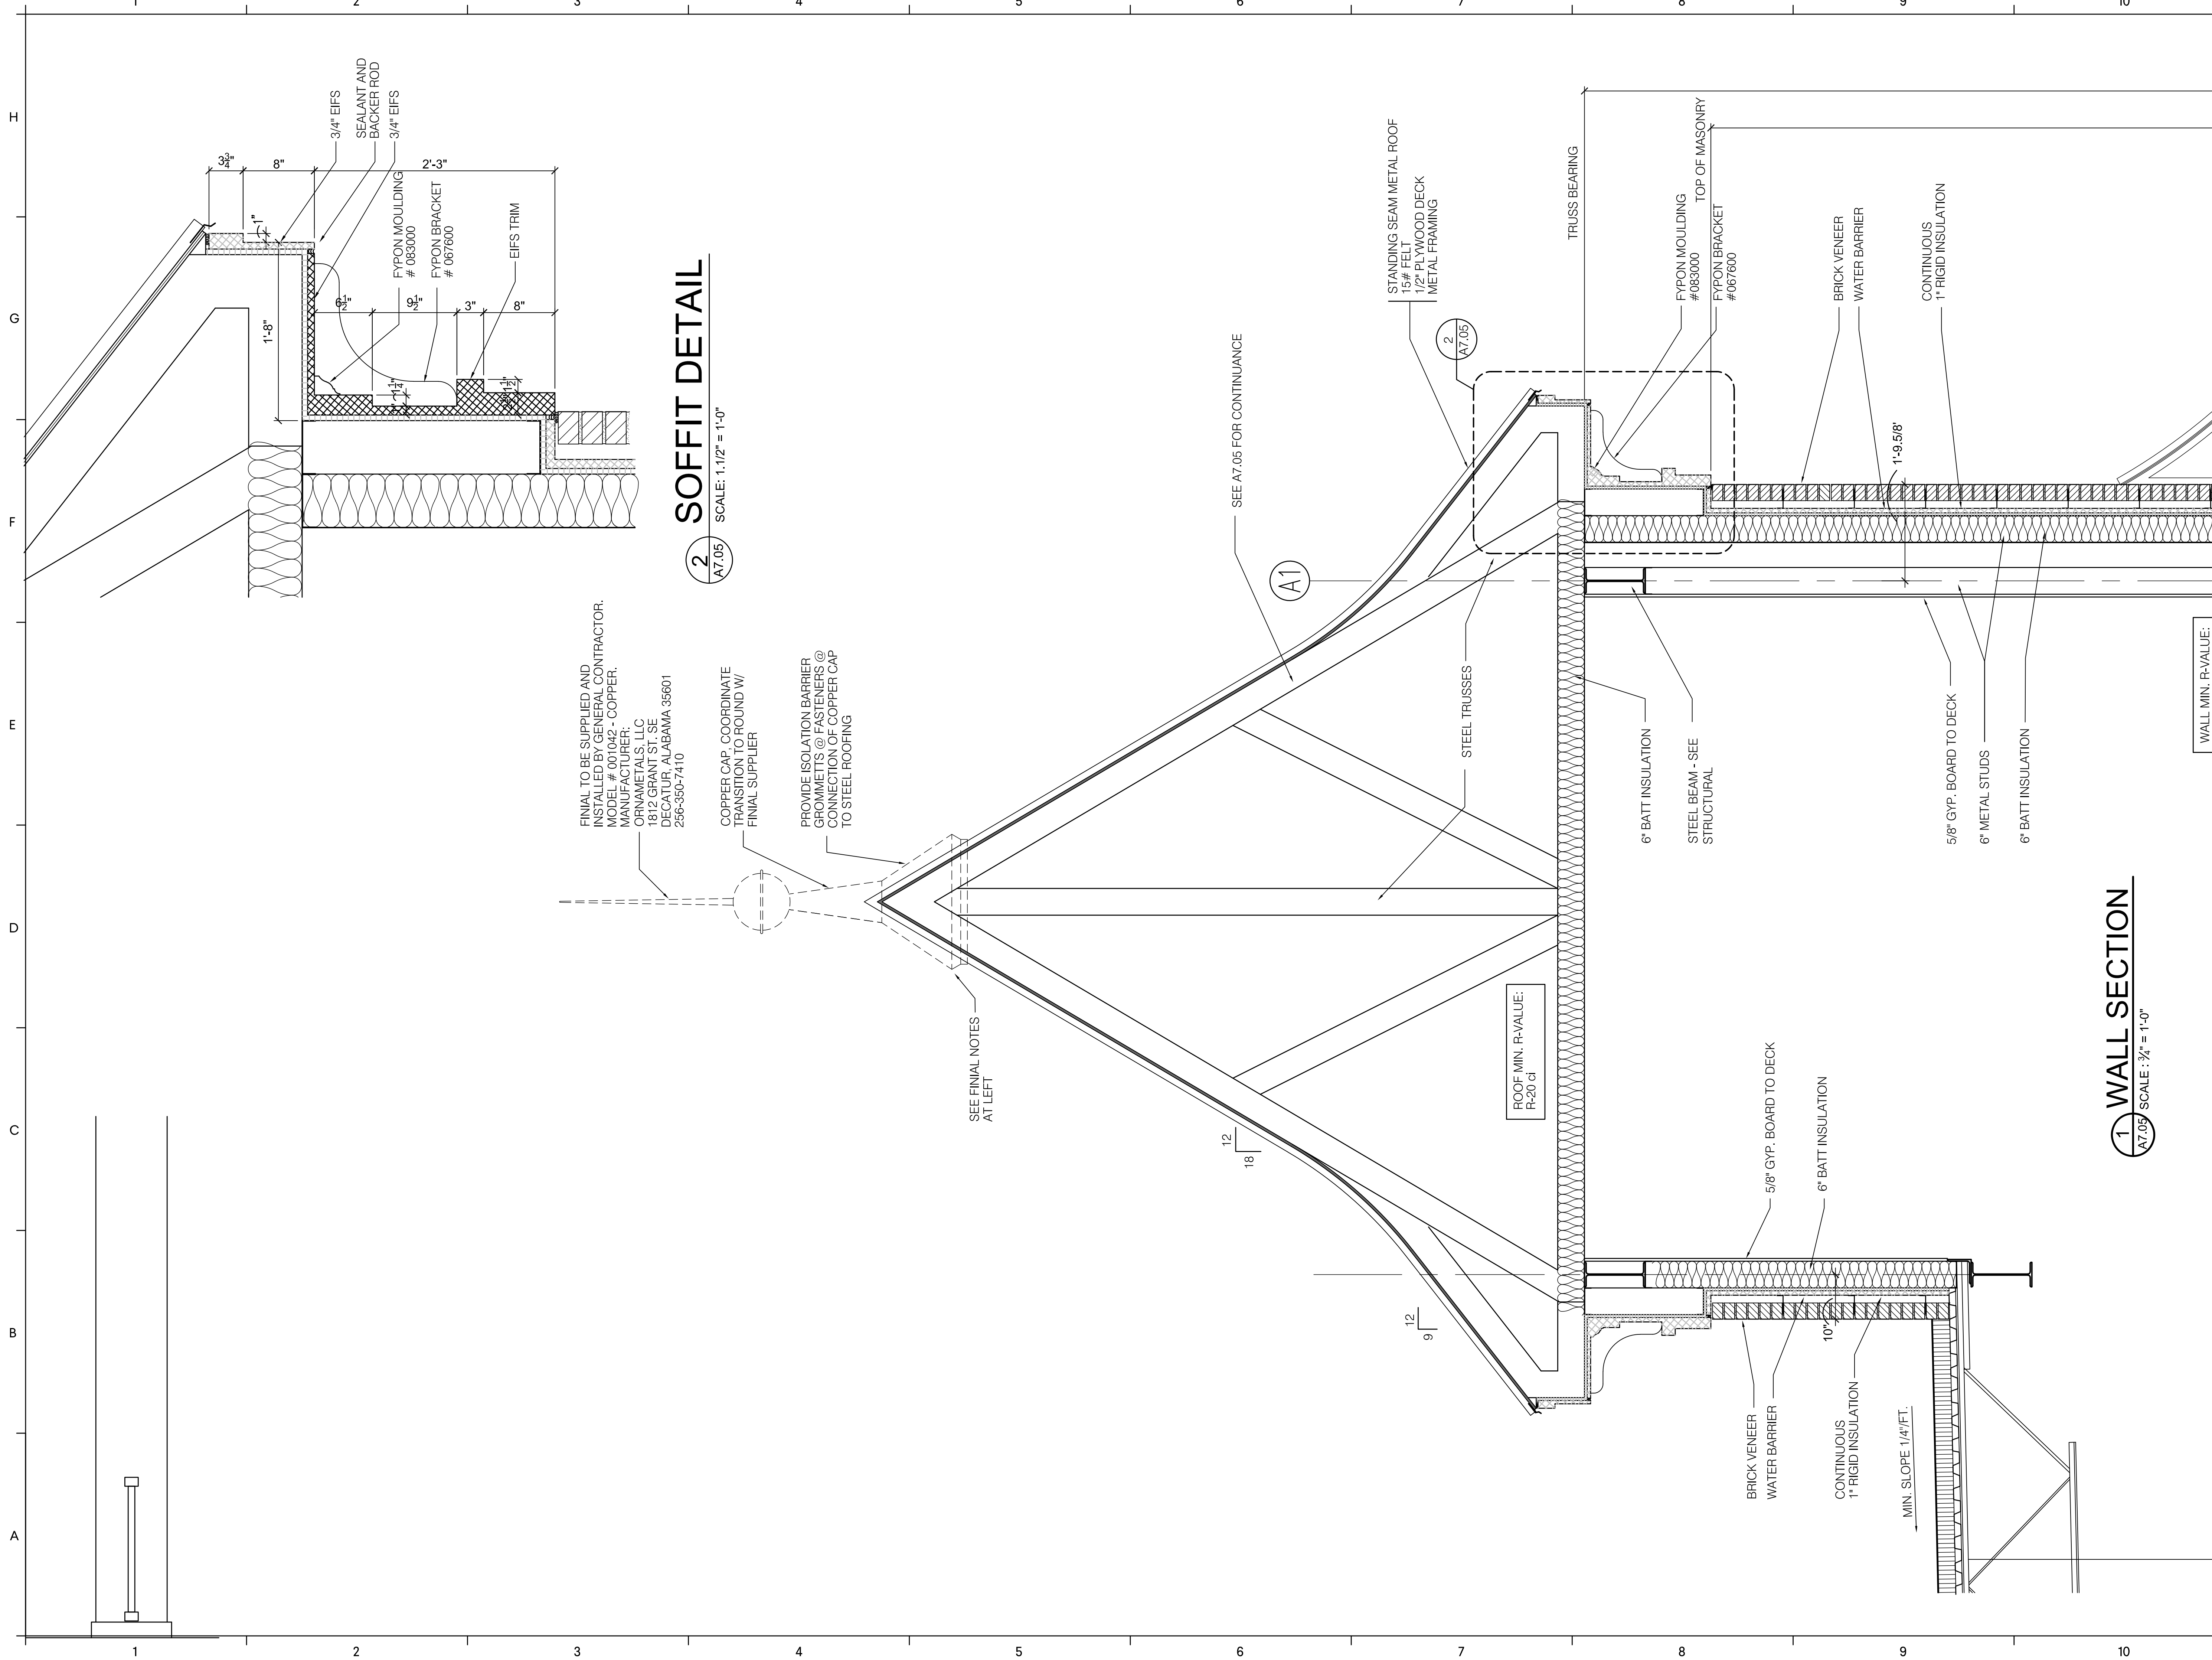

2 SOFFIT DETAIL

SCALE: 1-1/2" = 1'-0"

A2.05

FINIAL TO BE SUPPLIED AND INSTALLED BY GENERAL CONTRACTOR. MODEL # 001042 - COPPER. MANUFACTURER: ORNAMETALS, LLC 1812 GRANT ST. SE DECATUR, ALABAMA 35601 256-350-7410

COPPER CAP COORDINATE TRANSITION TO ROUND W/ FINIAL SUPPLIER

PROVIDE ISOLATION BARRIER GROMMETS @ FASTENERS @ CONNECTION OF COPPER CAP TO STEEL ROOFING

SEE FINIAL NOTES AT LEFT

SEE A7.05 FOR CONTINUANCE

A1

1 WALL SECTION

SCALE: 3/4" = 1'-0"

A7.05

ROOF MIN. R-VALUE: R-20 cl

WALL MIN. R-VALUE:


WALL SECTIONS

THE EXCHANGE AT HOMEPLACE
PRATTVILLE, AL

2660 East Chase Lane, Suite 200
Montgomery, AL 36117
T 334.271.3200
GMCNETWORK.COM


ISSUE DATE
75% REVIEW 04/18/19
95% REVIEW 05/30/19


GMC PROJECT#AMGM180037
DESIGNED BY: GMC
DRAWN BY: GMC
CHECKED BY: GMC

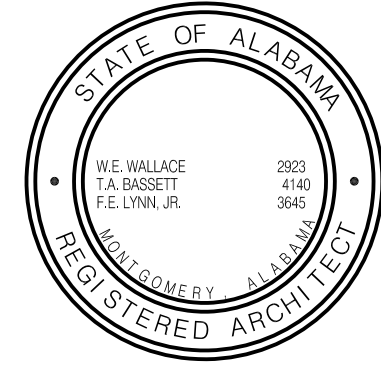


A7.05
sheet of

AS-BUILT

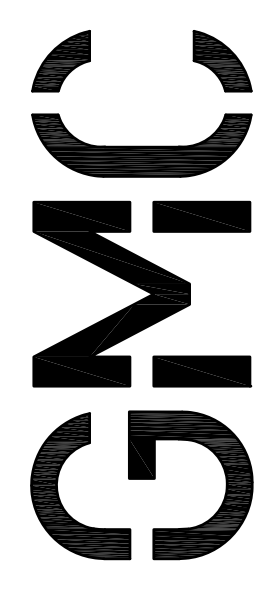


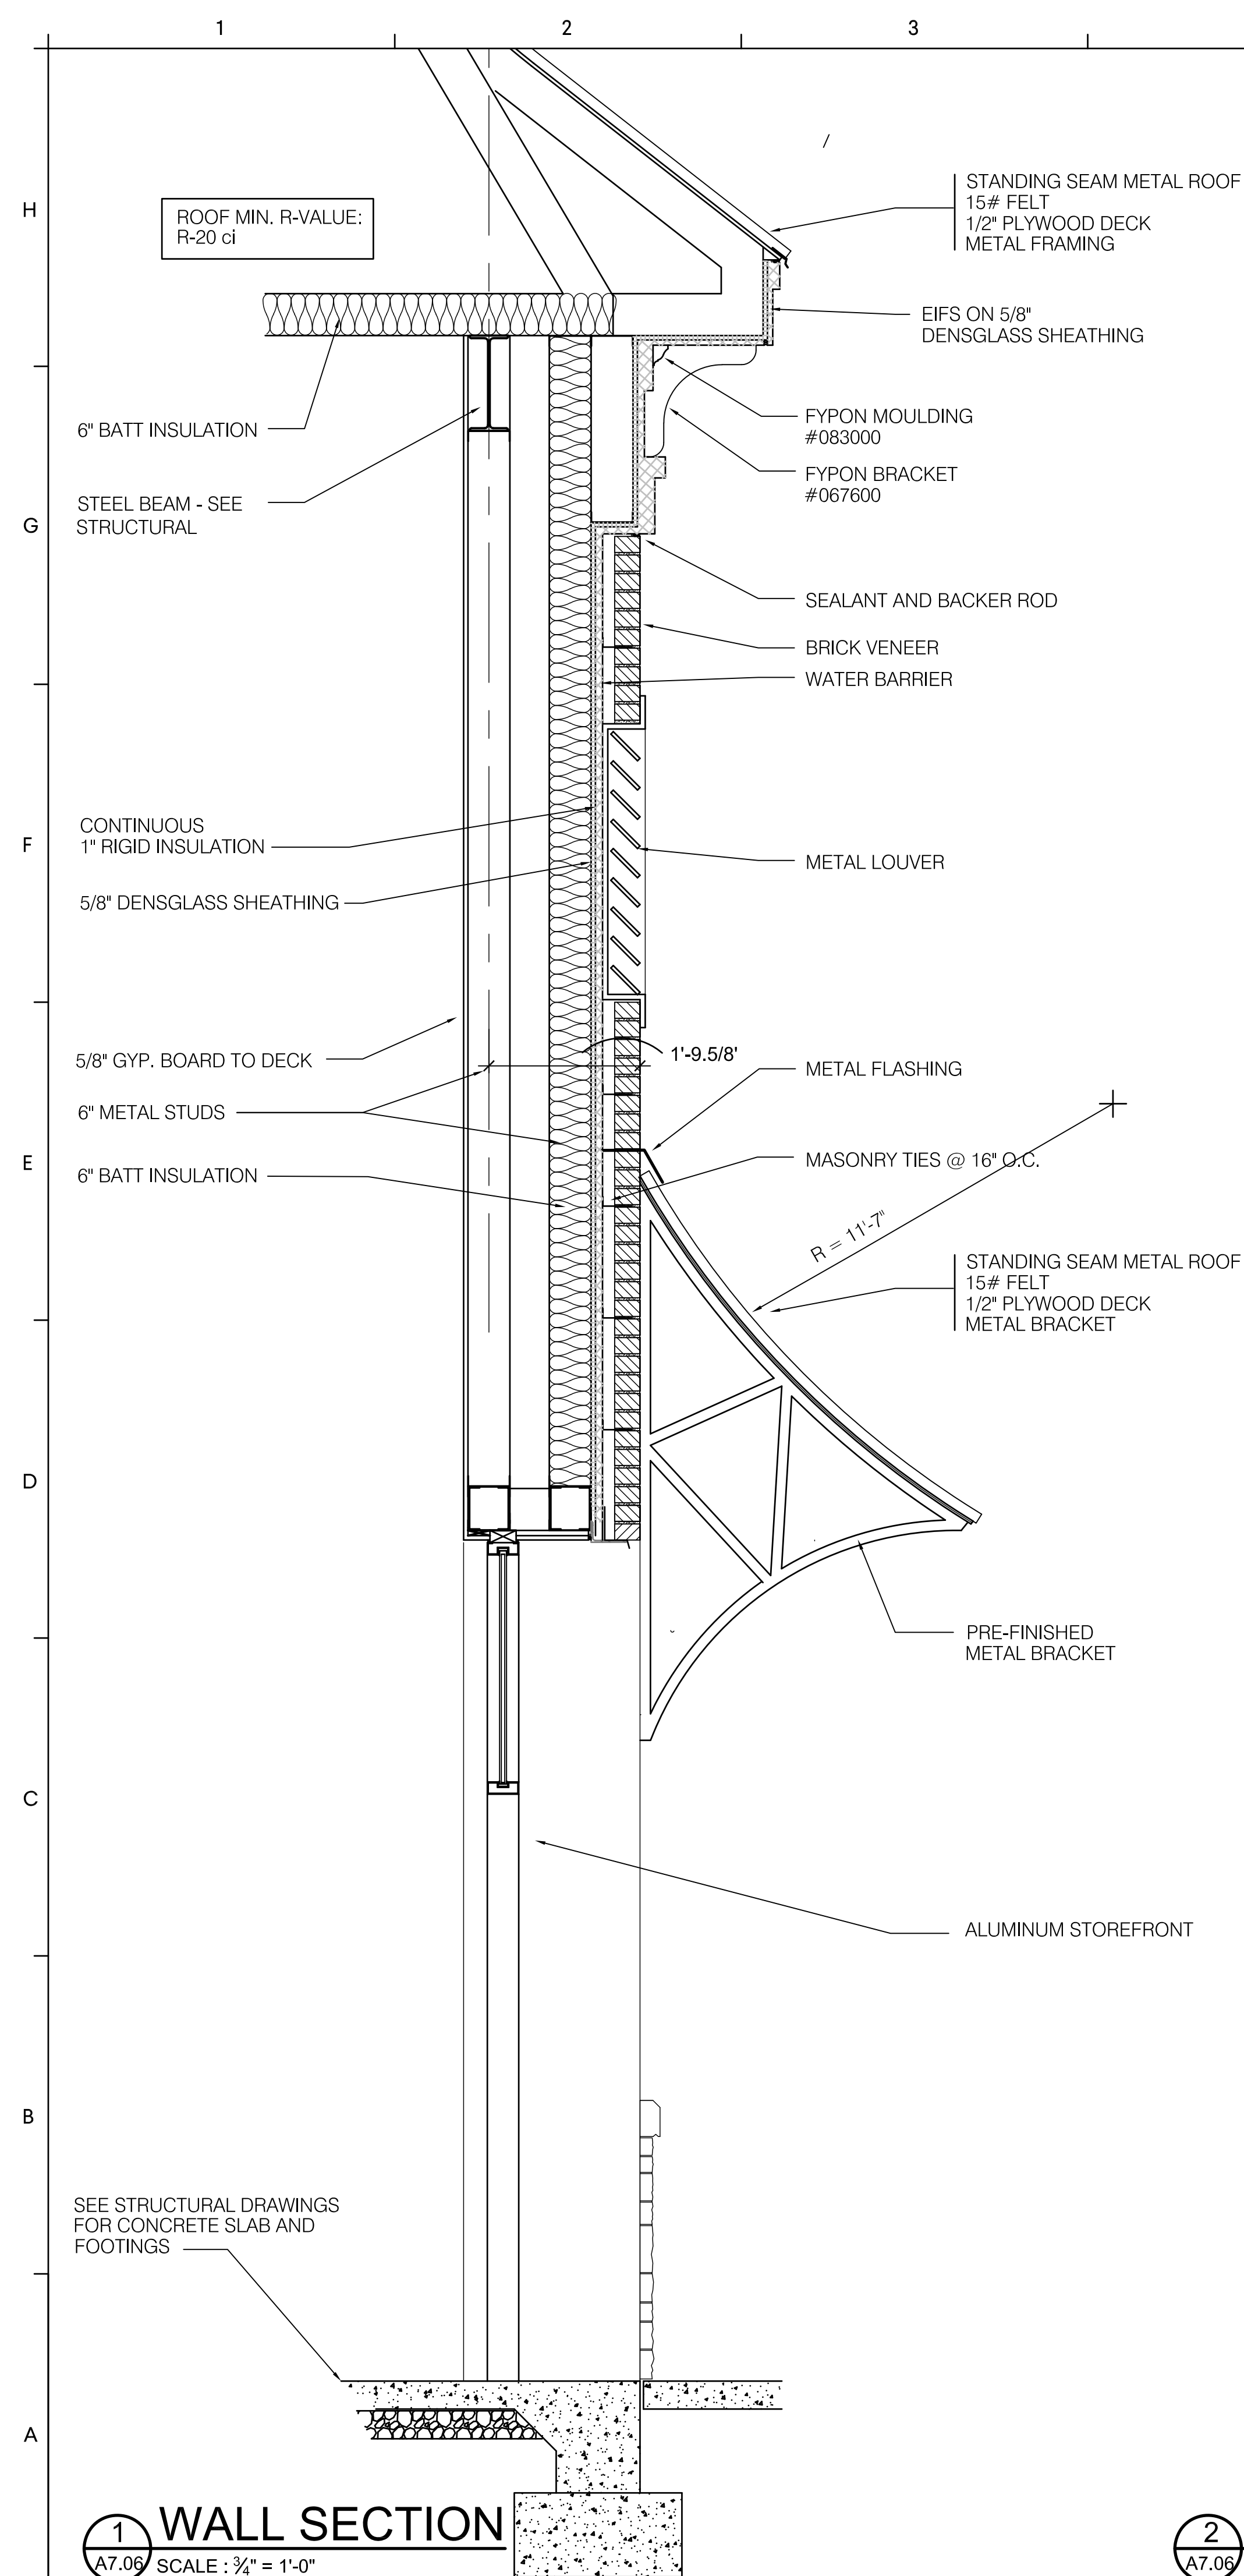

1 WALL SECTION
A7.06 SCALE : 3/8" = 1'-0"

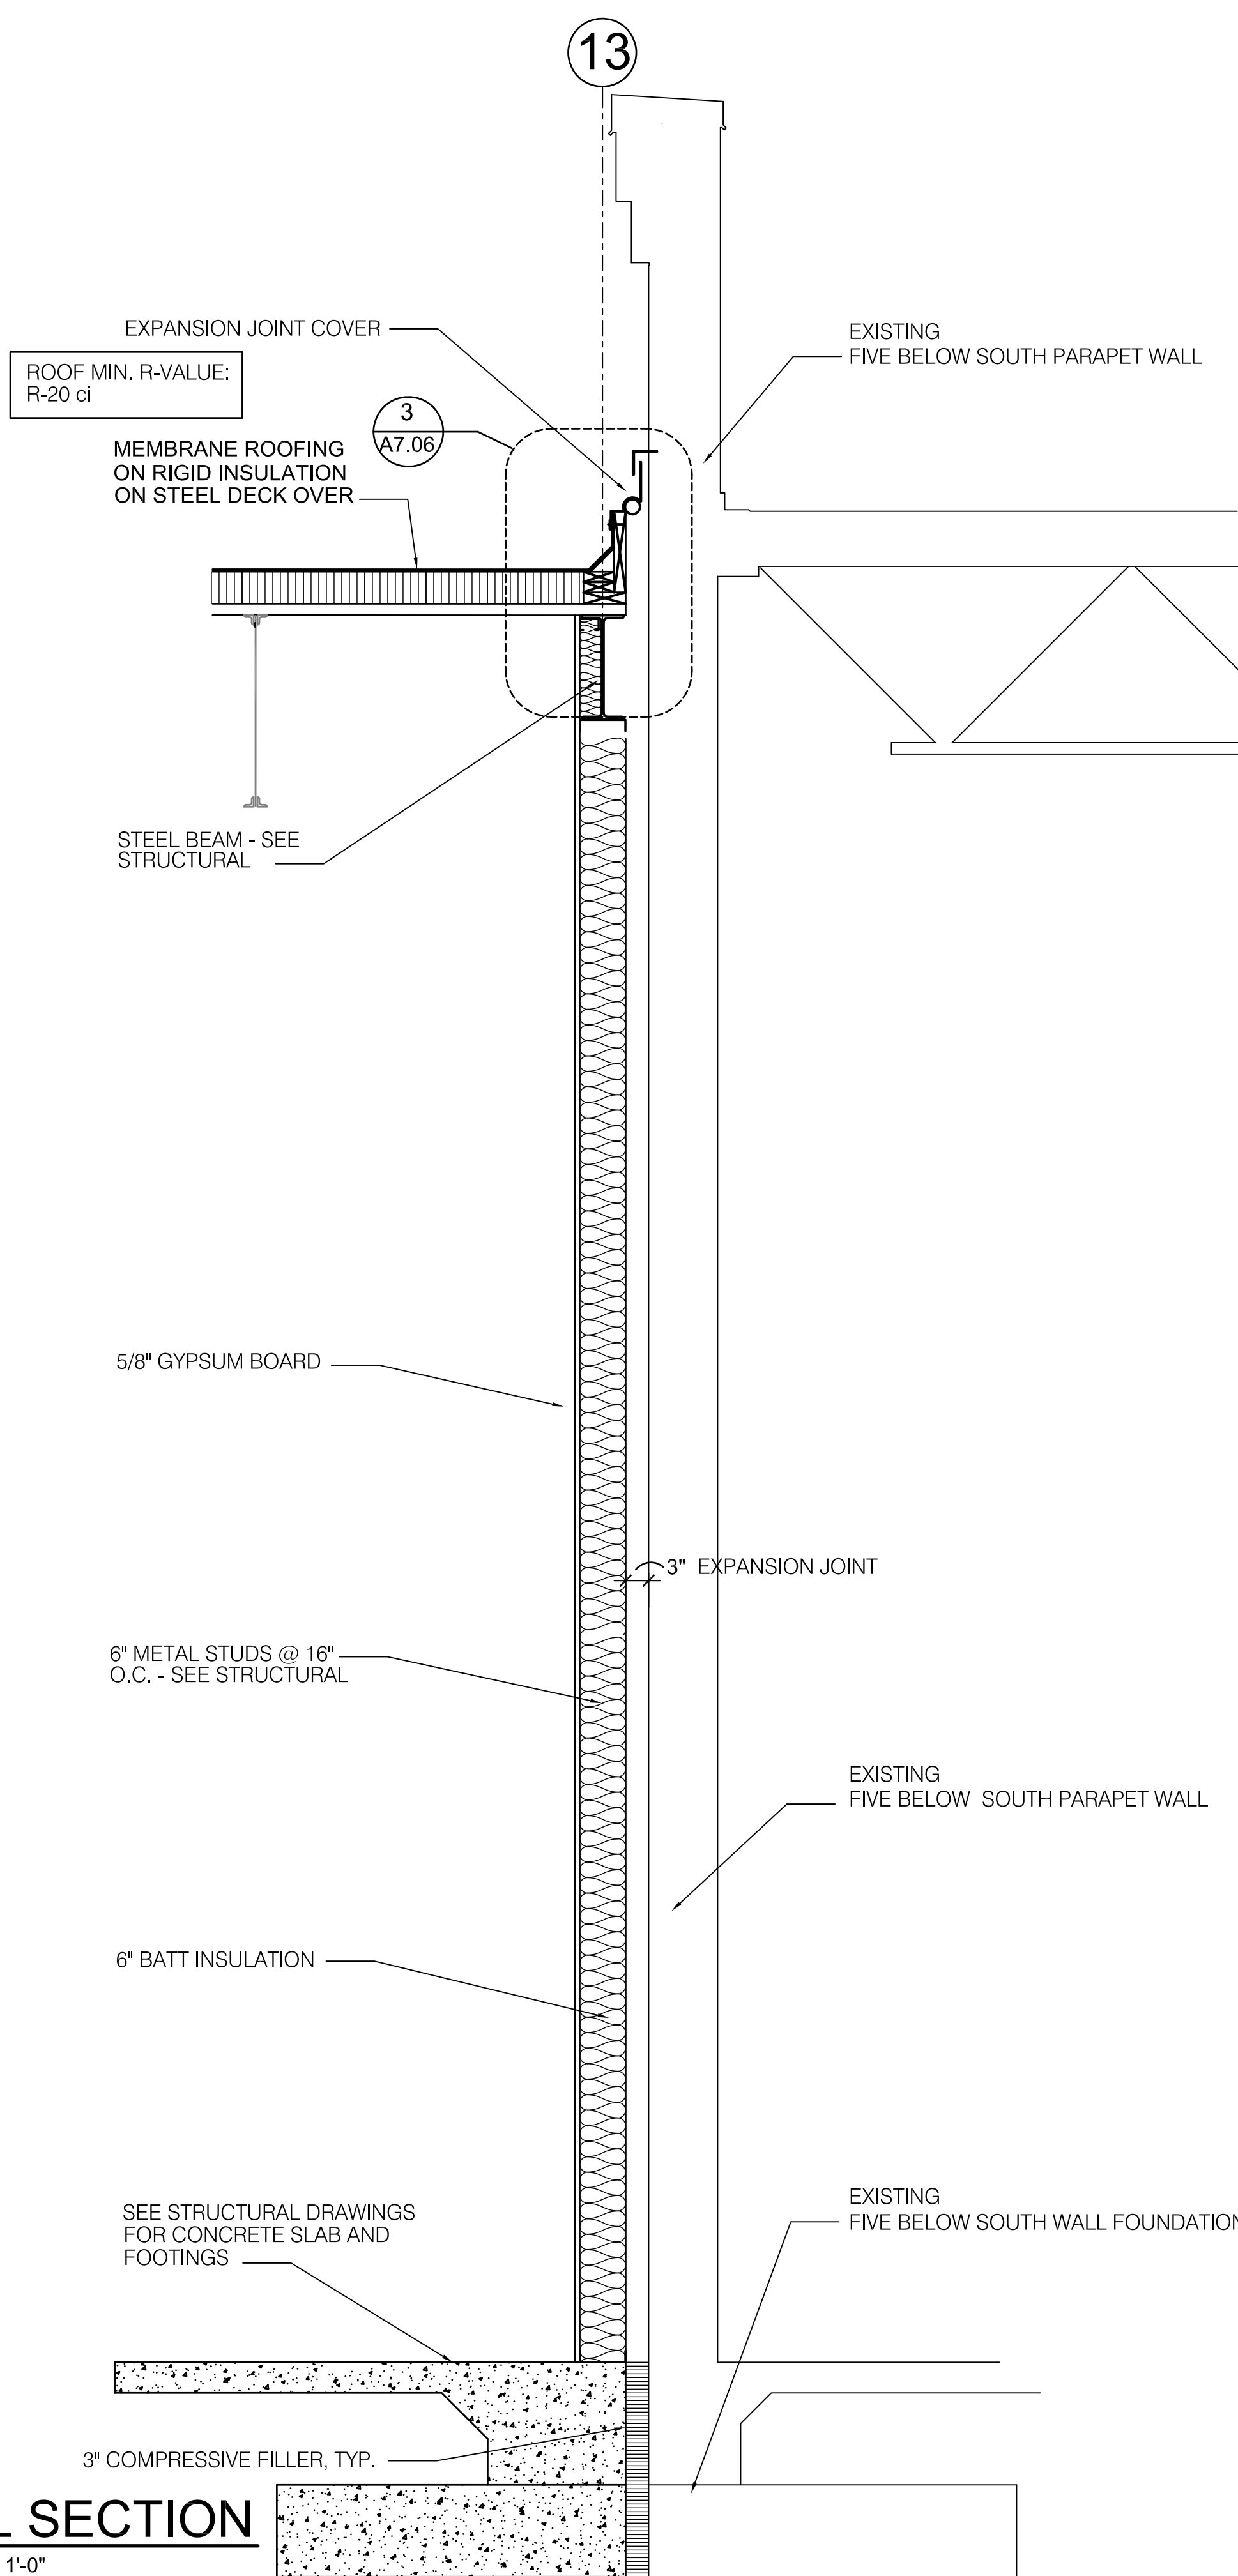

2 WALL SECTION
A7.06 SCALE : 3/8" = 1'-0"

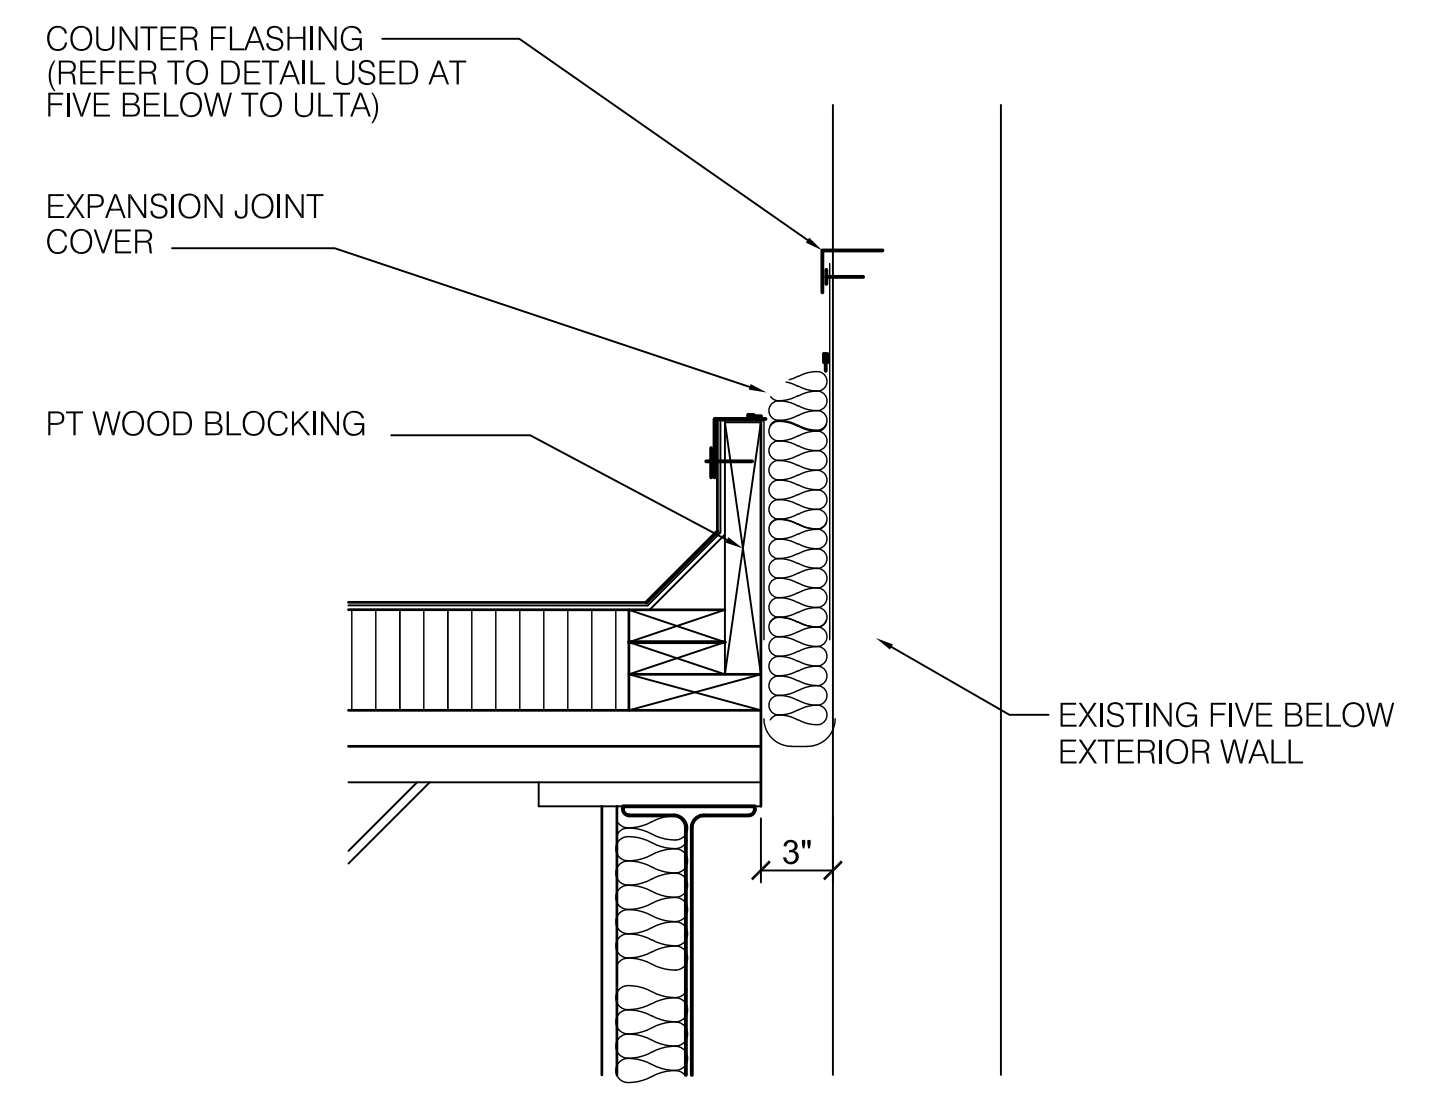

3 DETAIL
A7.06 SCALE : 1.1/2" = 1'-0"


GMC

AS-BUILT

2660 East Chase Lane, Suite 200
Montgomery, AL 36117
T 334.271.3200
GMCNETWORK.COM


ISSUE	DATE
75% REVIEW	04/18/19
95% REVIEW	05/30/19
DESIGNED BY:	GMC
DRAWN BY:	GMC
CHECKED BY:	GMC

THE EXCHANGE AT HOMEPLACE
PRATTVILLE, AL
GMC PROJECT#AMGM180037

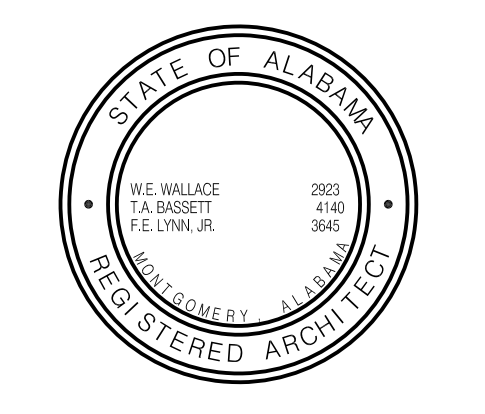

WALL SECTIONS

A7.06
sheet of

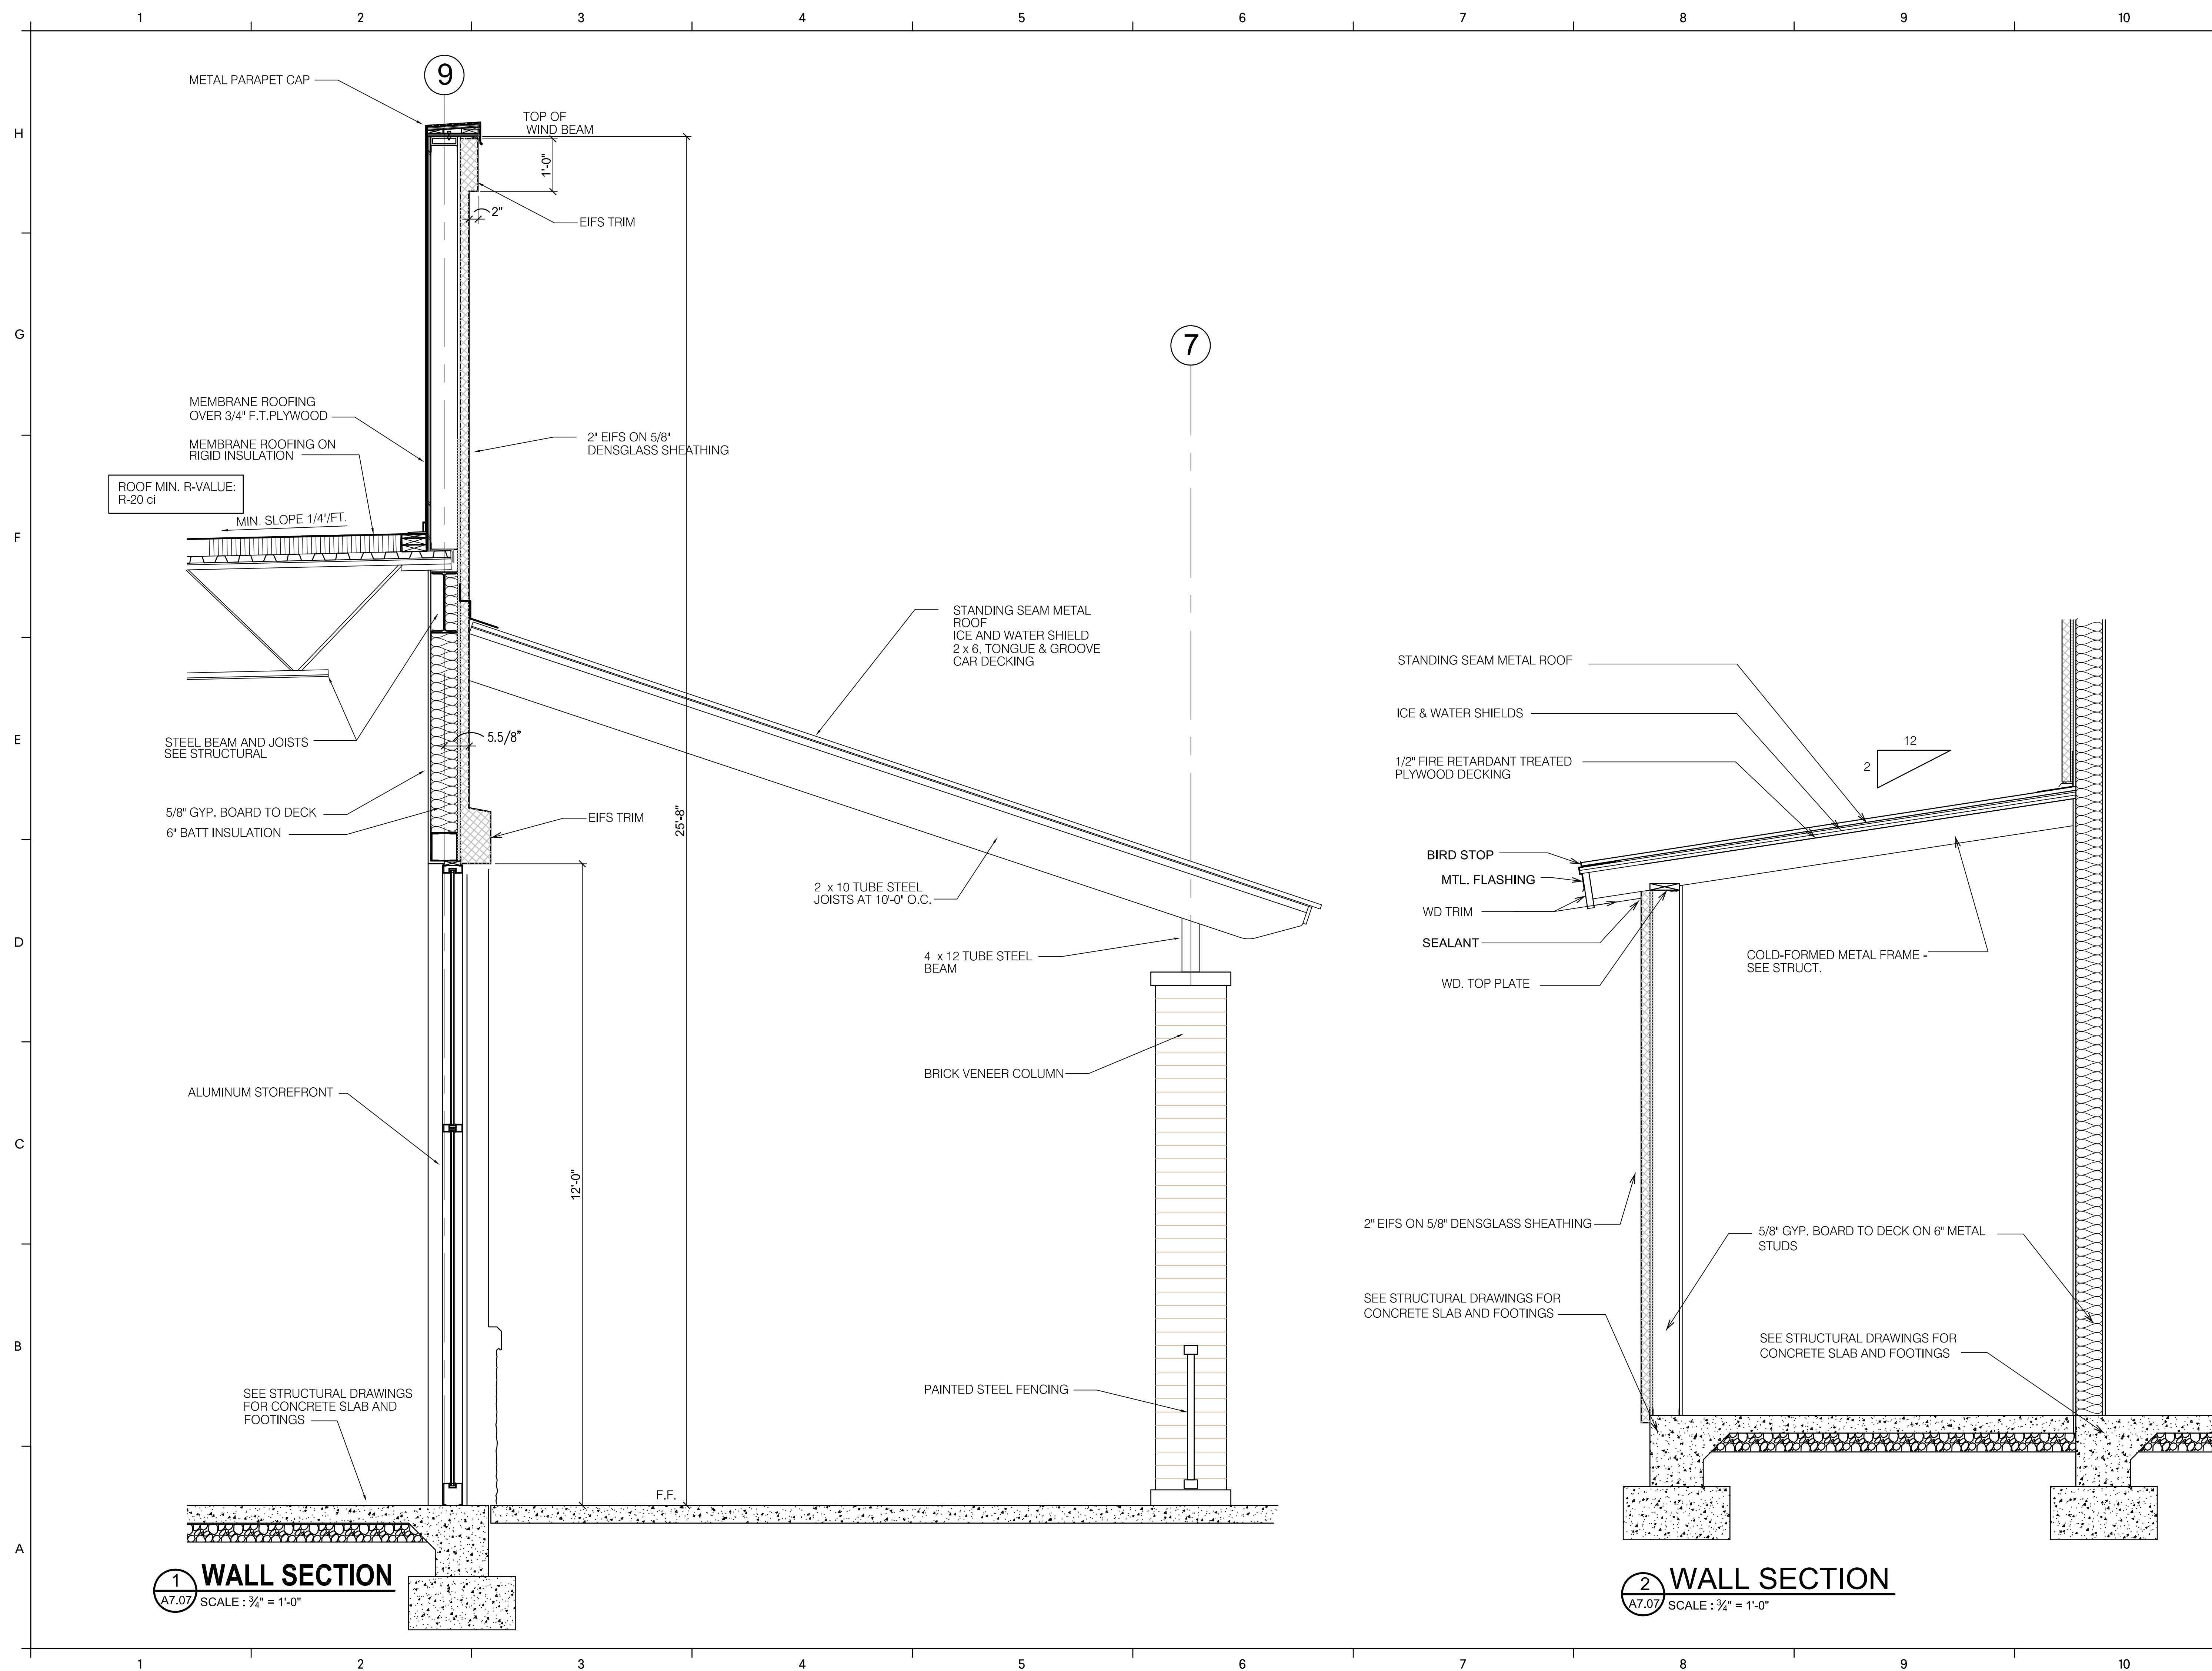

GMC


AS-BUILT

2660 East Chase Lane, Suite 200
 Montgomery, AL 36117
 T 334.271.3200
 GMCNETWORK.COM

ISSUE	DATE
75% REVIEW	04/18/19
95% REVIEW	05/30/19


DESIGNED BY: GMC
 DRAWN BY: GMC
 CHECKED BY: GMC

THE EXCHANGE AT HOMEPLACE
 PRATTVILLE, AL
 GMC PROJECT#AMGM180037

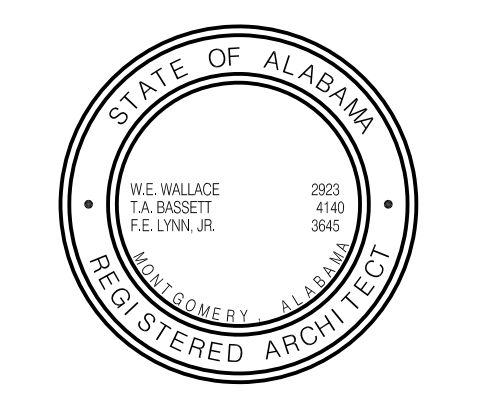


WALL SECTIONS


A7.07
 sheet of

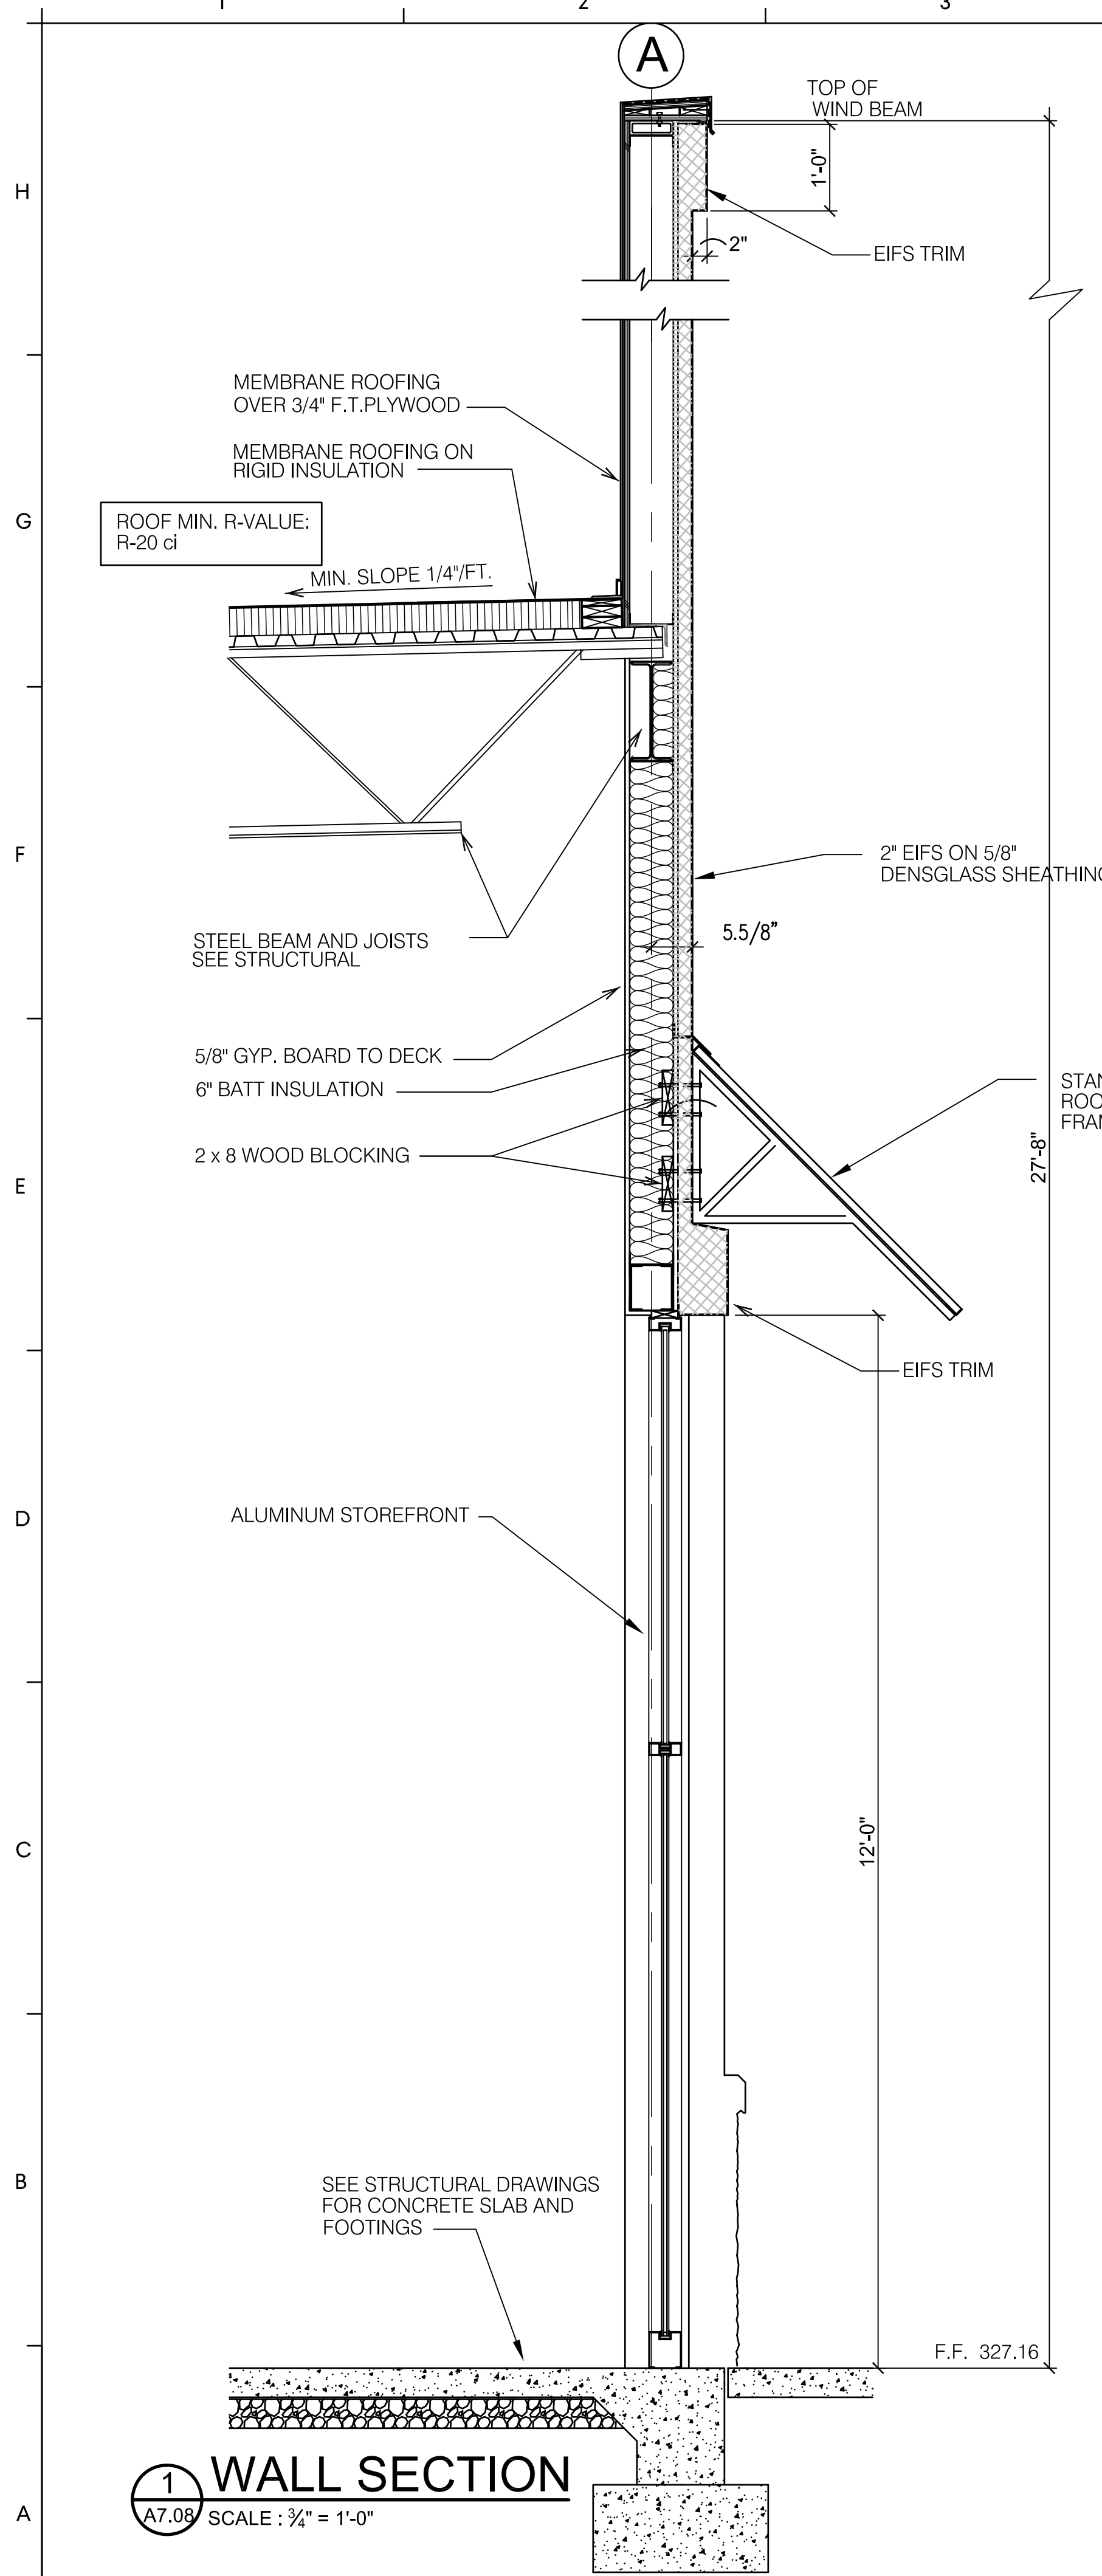

1 WALL SECTION
A7.08 SCALE : 3/4" = 1'-0"

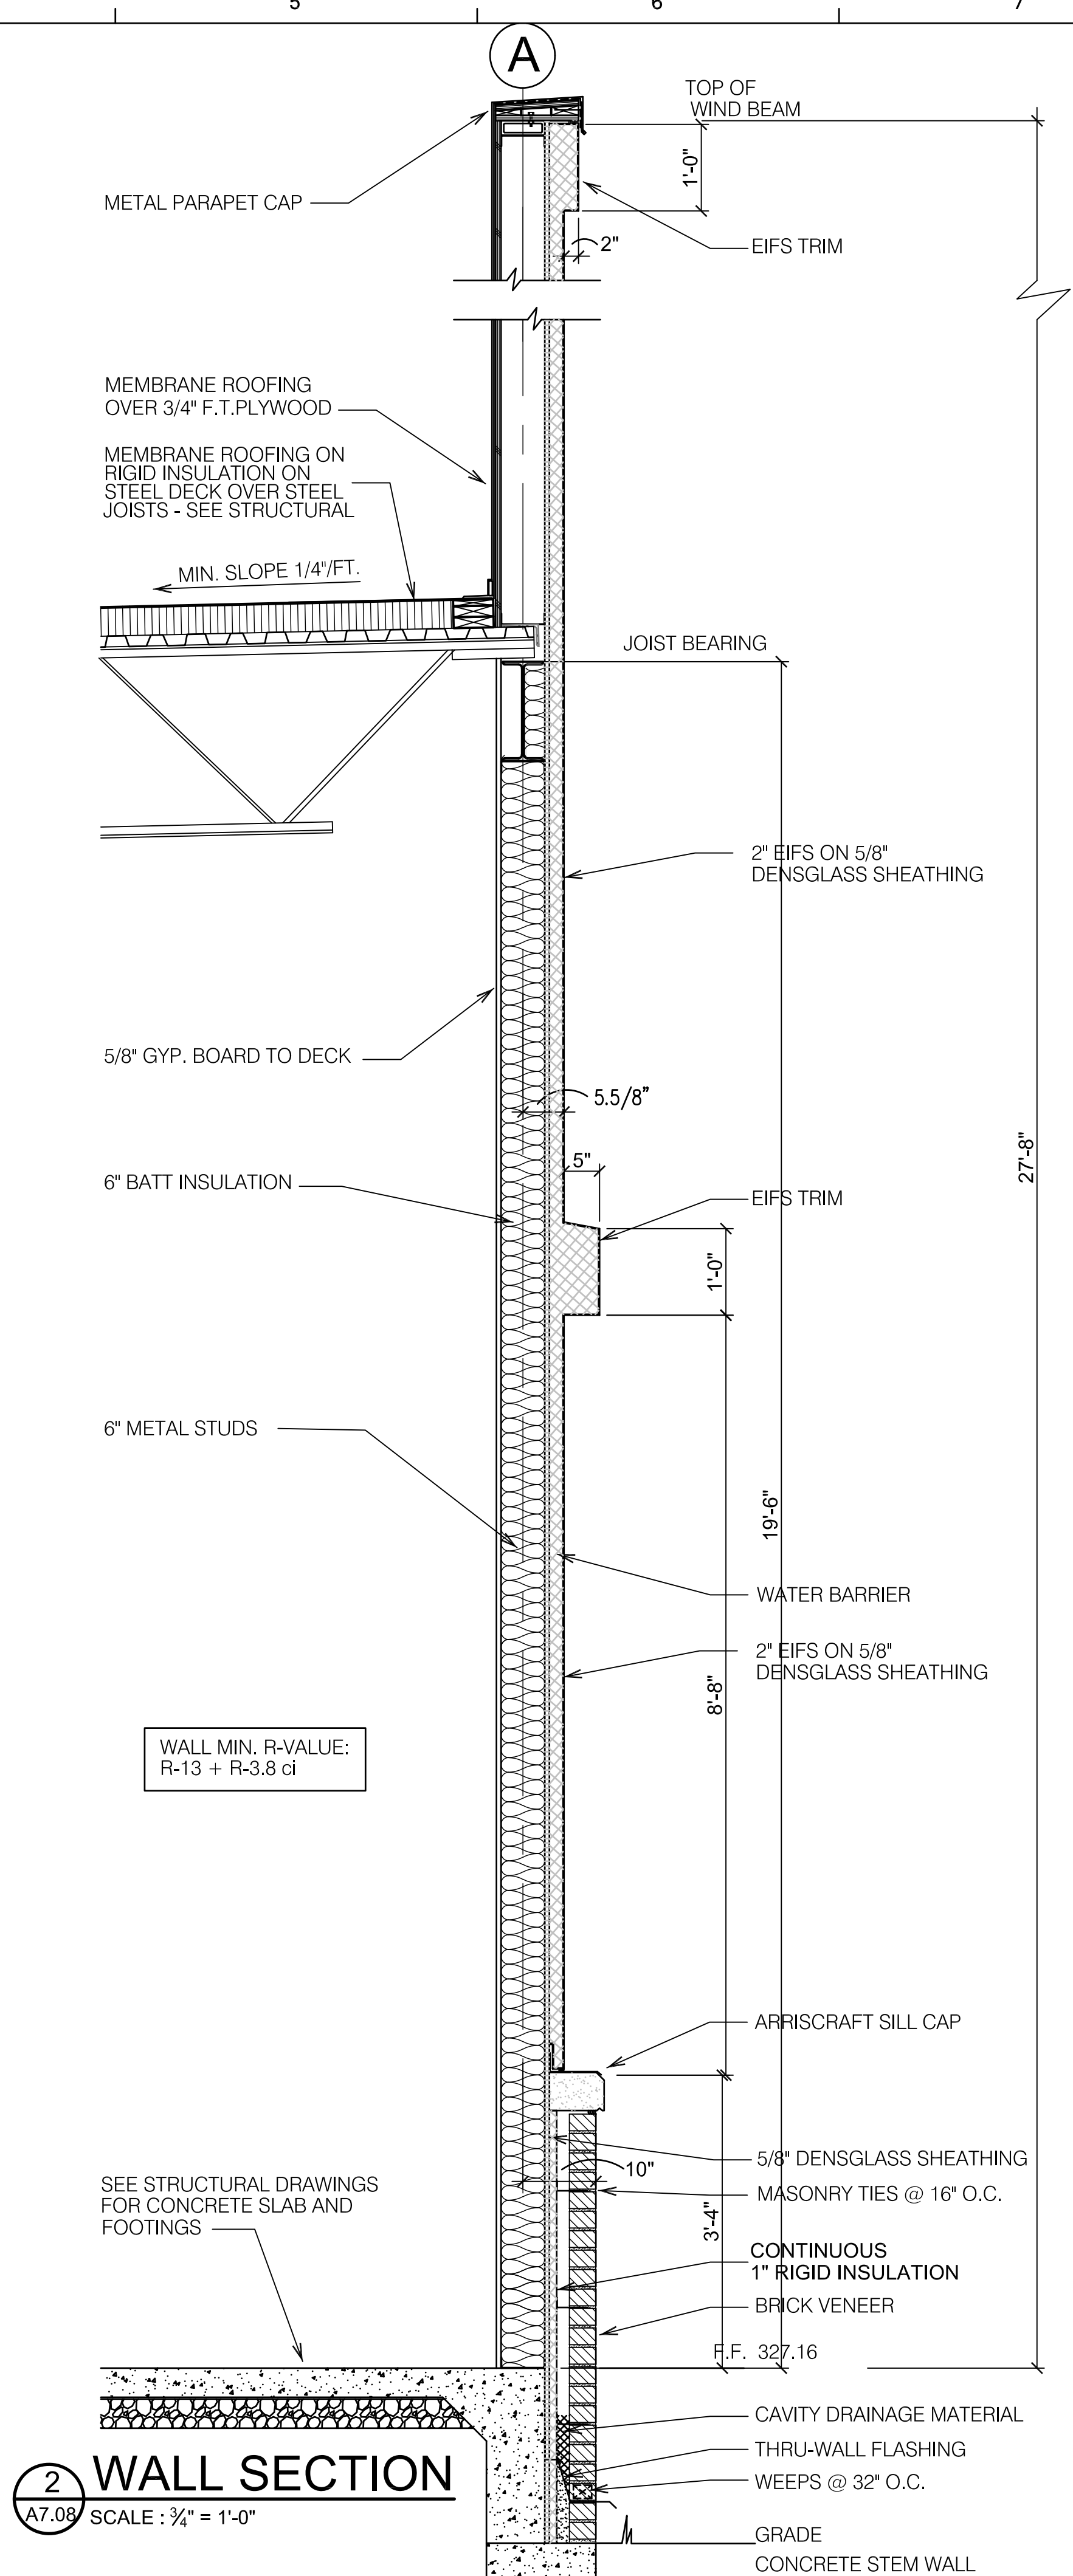


2 WALL SECTION
A7.08 SCALE : 3/4" = 1'-0"

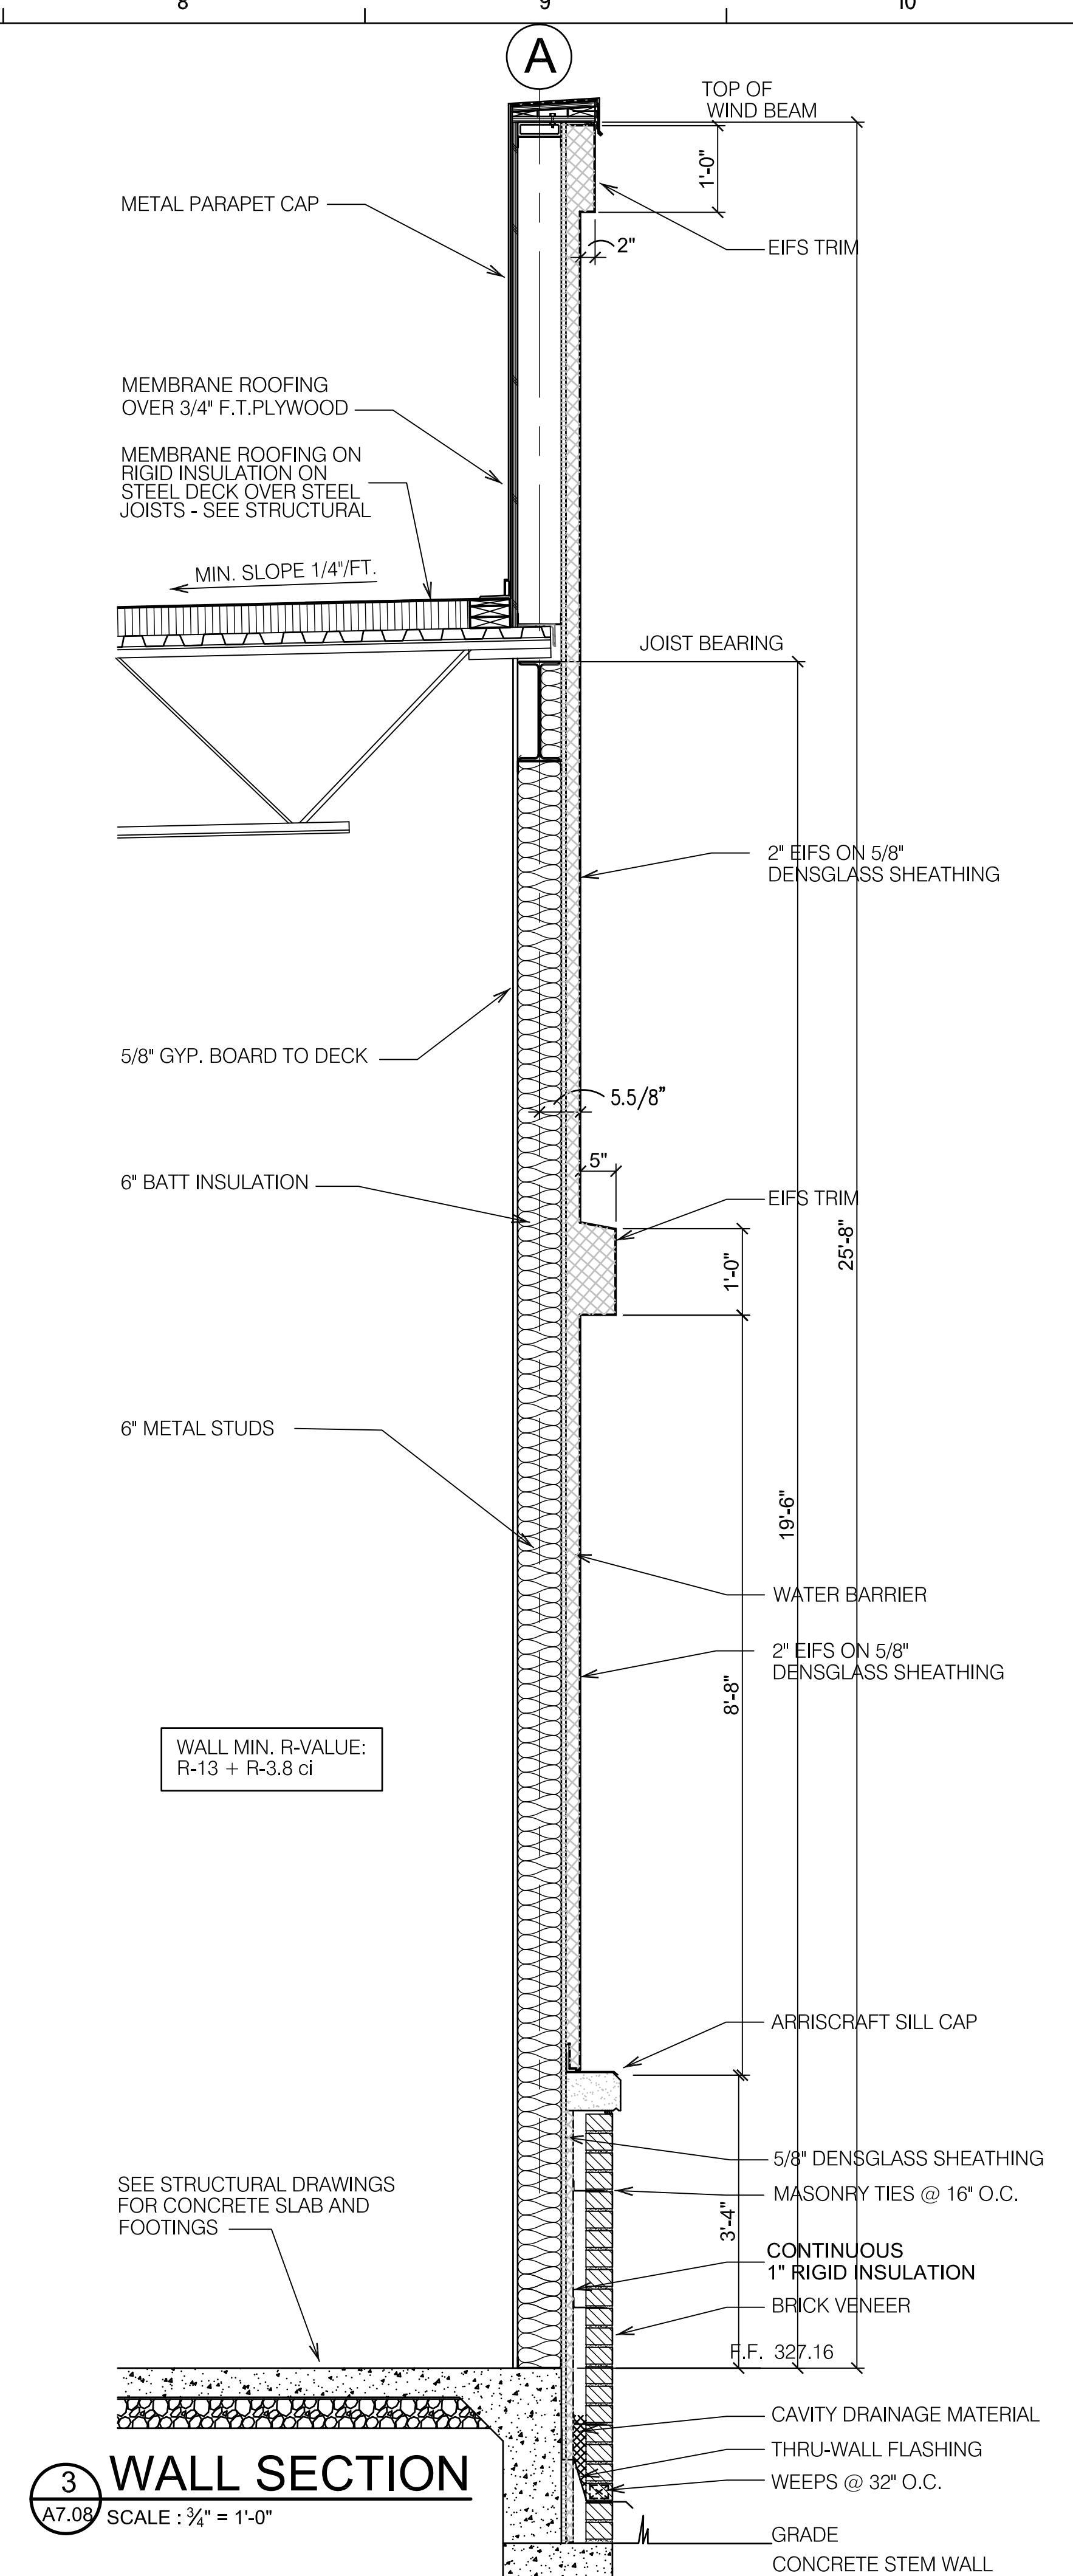

3 WALL SECTION
A7.08 SCALE : 3/4" = 1'-0"

ISSUE	DATE
75% REVIEW	04/18/19
95% REVIEW	05/30/19
DESIGNED BY:	GMC
DRAWN BY:	GMC
CHECKED BY:	GMC

THE EXCHANGE AT HOMEPLACE
PRATTVILLE, AL
GMC PROJECT#AMGM180037

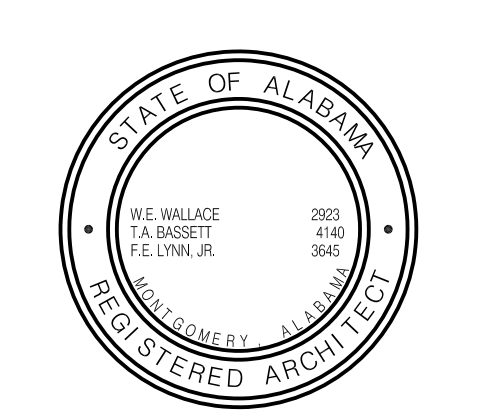


LEGEND - PLUMBING		
SYMBOLS	ABBRV.	DESCRIPTION
---	OW	OILY WASTE PIPING BELOW FLOOR OR GRADE
---	S	SANITARY WASTE PIPING BELOW FLOOR OR GRADE
---	S	SANITARY WASTE PIPING ABOVE FLOOR OR GRADE
---	V	VENT PIPING
---	CW	DOMESTIC COLD WATER
---	HW	DOMESTIC HOT WATER
---	HWR	HOT WATER RECIRCULATE
---	VTR	SANITARY VENT THROUGH ROOF
---	CO / WCO	CLEANOUT / WALL CLEANOUT
---	FCO/GCO	FLOOR/GROUND CLEANOUT
---	FD	FLOOR DRAIN
---	HB	HOSE BIBB OR DRAIN VALVE
---	GV	GATE VALVE
---	CV	CHECK VALVE
---	BFP	BACKFLOW PREVENTER ASSEMBLY
---	RPZ	REDUCED PRESSURE ZONE (BFP)
---	PRV	PRESSURE REDUCING VALVE
---	T & P	TEMPERATURE AND PRESSURE RELIEF VALVE
---	TP	TRAP PRIMER
---		CONTINUE TO DESIGNATED LOCATION
---	A.F.G.	ABOVE FINISHED GRADE
---	B.F.F.	BELOW FINISHED FLOOR
---	B.F.G.	BELOW FINISHED GRADE
---	A/C	ABOVE CEILING
---	A/F	ABOVE FLOOR
---	B/F	BELOW FLOOR
---	B/G	BELOW GRADE
---	A.F.F.	ABOVE FINISHED FLOOR
---	AHJ	AUTHORITY HAVING JURISDICTION

- ### PLUMBING SPECIFICATIONS
- ALL PLUMBING EQUIPMENT AND INSTALLATIONS SHALL CONFORM WITH THE REQUIREMENTS OF THE APPLICABLE INTERNATIONAL PLUMBING CODE, INTERNATIONAL BUILDING CODE, THE STATE ENERGY CODE, NFPA 90A, 101, AND ALL APPLICABLE CODES AND ORDINANCES.
 - PRIOR TO PURCHASING ANY MATERIALS OR STARTING ANY WORK, CONTRACTOR SHALL FIELD VERIFY ALL EXISTING CONDITIONS, PIPE SIZES AND LOCATIONS, EQUIPMENT, ETC. SHOWN ON THE DRAWINGS OR AFFECTING THIS WORK AND SHALL REPORT ANY DEVIATIONS TO THE ARCHITECT. CHANGE ORDERS SHALL NOT BE PERMITTED FOR FAILURE TO EVALUATE EXISTING CONDITIONS PRIOR TO BID.
 - SHOP DRAWINGS SHALL BE SUBMITTED TO AND APPROVED BY THE ARCHITECT PRIOR TO ORDERING, PURCHASING, OR FABRICATING ANY PLUMBING EQUIPMENT. SHOP DRAWINGS SHALL INCLUDE: ALL NEW EQUIPMENT SCHEDULED OR SPECIFIED ON THE DRAWINGS. SHOP DRAWINGS SHALL HAVE THE EQUIPMENT LABELED TO MATCH THE UNIT DESIGNATION SHOWN ON THE DRAWINGS. PROVIDE ALL INFORMATION INDICATED IN THE SCHEDULES OR ON THE DRAWINGS. SUBMIT ALL EQUIPMENT AT THE SAME TIME IN ELECTRONIC FORMAT OR OTHERWISE PAY THE HOURLY ADD-SERVICE FEE TO HAVE THE ENGINEER SCAN THEM.
 - CONTRACTOR SHALL COORDINATE ELECTRICAL CHARACTERISTICS AND REQUIREMENTS OF ALL PLUMBING EQUIPMENT WITH ELECTRICAL DRAWINGS PRIOR TO ORDERING EQUIPMENT OR SUBMITTING SHOP DRAWINGS, AND SHALL FURNISH EQUIPMENT WIRED FOR THE VOLTAGES SHOWN THEREIN.
 - ALL PLUMBING EQUIPMENT REQUIRING ELECTRICAL POWER SHALL BE INSTALLED WITH DISCONNECT SWITCHES AT EACH PIECE OF EQUIPMENT. COORDINATE SWITCH TYPE (FUSED OR NON-FUSED) WITH EQUIPMENT CHARACTERISTICS, MANUFACTURER'S RECOMMENDATIONS AND ELECTRICAL DRAWINGS.
 - ALL REQUIRED CONTROL WIRING NOT SHOWN ON THE ELECTRICAL DRAWINGS SHALL BE INCLUDED AS PART OF THE PLUMBING WORK. ANY CABLE ROUTED IN A RETURN AIR PLENUM SHALL BE PLENUM RATED.
 - ALL PLUMBING EQUIPMENT SHALL BE INSTALLED ACCORDING TO MANUFACTURER'S RECOMMENDATIONS.
 - ALL PLUMBING EQUIPMENT AND SYSTEMS SHALL BE GUARANTEED FOR A PERIOD OF ONE YEAR AFTER ACCEPTANCE BY OWNER.
 - ALL PERMITS SHALL BE OBTAINED AND PAID FOR BY THE PLUMBING CONTRACTOR.
 - PRESSURE TEST ALL PIPING AFTER INSTALLATION. VALVE OFF ANY EQUIPMENT THAT MAY BE SUBJECT TO SEAL FAILURE DUE TO TESTING.
 - ABOVE GROUND DOMESTIC WATER PIPING SHALL BE TYPE "L" COPPER, COMMERCIAL GRADE PEX TYPE PIPING, OR CODE APPROVED ALTERNATIVE. BELOW GROUND DOMESTIC WATER PIPING SHALL BE CODE APPROVED PVC. PEX SHALL BE CONNECTED TO METAL FITTINGS INSIDE WALL.
 - ABOVE GROUND SANITARY PIPING SHALL BE SCHEDULE 40 PVC DWV. BELOW GROUND SANITARY PIPING SHALL BE SCHEDULE 40 PVC DWV. ALL PIPING IN A RETURN AIR PLENUM SHALL BE PLENUM RATED.
 - DOMESTIC HOT WATER PIPING SHALL BE INSULATED WITH 1" ARMSTRONG ARAMFLEX INSULATION, DOMESTIC COLD WATER WITH 3/2" ARMAFLEX. INSTALL INSULATION IN STRICT ACCORDANCE TO THE MANUFACTURER'S INSTRUCTIONS AND RECOMMENDATIONS.
 - PROVIDE ASSE 1070 MIXING VALVE AT EACH HAND SINK.
 - THE ENTIRE DOMESTIC WATER PLUMBING SYSTEM SHALL BE TESTED TO A PRESSURE OF 125 PSI FOR 6 HOURS OR AS REQUIRED BY LOCAL CODE. THE SANITARY SYSTEM SHALL BE TESTED IN ACCORDANCE WITH STATE AND LOCAL CODES WHERE REQUIRED. SUBMIT CERTIFIED TEST REPORT TO ARCHITECT FOR APPROVAL. ALL INSPECTIONS, TESTS, SURVEYS, AND ANY OTHER REQUIREMENTS SHALL BE THE RESPONSIBILITY OF THIS CONTRACTOR.
 - ALL WORK SHALL BE COORDINATED AND PERFORMED WITH PRIOR APPROVAL FROM THE OWNER TO SUIT HIS OPERATING CONDITIONS.
 - ANY EXISTING WALL, FLOOR, OR CEILING SURFACE THAT IS DISTURBED DURING THE COURSE OF THE PLUMBING WORK SHALL BE REPAIRED TO MATCH NEW AND/OR EXISTING CONDITIONS.
 - CONTRACTOR SHALL COORDINATE THE INSTALLATION OF ALL PLUMBING EQUIPMENT, PIPING, ETC. TO FIT WITHIN THE SPACE ALLOWED BY THE ARCHITECTURAL AND STRUCTURAL CONDITIONS. CUTTING OR OTHERWISE ALTERING ANY STRUCTURAL MEMBERS SHALL NOT BE PERMITTED WITHOUT WRITTEN PERMISSION FROM THE ENGINEER/ARCHITECT.
 - PROVIDE ACCESS PANELS IN NON-ACCESSIBLE CEILINGS AND IN WALL STRUCTURE TO ALLOW ADEQUATE ROOM FOR MAINTENANCE OF EQUIPMENT AND BALANCING OF SYSTEM AS WELL AS ACCESS TO VALVES WHERE REQUIRED.
 - PROVIDE WATER HAMMER ARRESTORS AT THE EACH END OF EACH DOMESTIC RUN OF PIPING.
 - COORDINATE ROOF PENETRATIONS WITH STRUCTURAL, ARCHITECTURAL, AND MECHANICAL DRAWINGS. KEEP VENTS A MINIMUM OF 10'-0" FROM BUILDING INTAKES.
 - COORDINATE WATER METERS WITH CIVIL ENGINEER AND CITY WATER AHJ. THIS CONTRACTOR SHALL PAY FOR METER UNLESS COORDINATED OTHERWISE.
 - ALL FLOOR DRAINS WITHOUT CLEAN WATER WASTE SHALL HAVE A TRAP PRIMER OR TRAP GUARD (WHERE APPROVED).
 - PROVIDE INTERIOR PRESSURE REDUCING VALVE FOR ANY SYSTEM ABOVE 80 PSI PER FLOW TEST.
 - THESE DRAWINGS ARE DIAGRAMMATIC IN NATURE AND DO NOT NECESSARILY REFLECT ALL EXISTING CONDITIONS OR ACTUAL ROUTING. CONTRACTOR SHALL HAVE LATITUDE TO ADJUST ROUTING AS REQUIRED WHILE REMAINING CODE COMPLIANT. ENGINEER SHALL REVIEW ANY MAJOR DEVIATIONS FROM PLAN IF REQUIRED BY AHJ.

PLUMBING FIXTURE SCHEDULE

TAG	FIXTURE	CW	HW	WASTE	VENT	SPECIFICATION
FD	FLOOR DRAIN	N/A	N/A	3"	2"	JR SMITH 2005-ASNB-U WITH 6" TYPE A STRAINER ADJUSTABLE STRAINER WITH SEDIMENT BUCKET & SATIN NICKEL BRONZE FINISH. PROVIDE WITH VANDAL PROOF SECURED TOP (PROVIDE TRAP PRIMER OR TRAP GUARD).

NOTES: PROVIDE MODEL SHOWN OR APPROVED EQUAL. SEE P-3.1 FOR OTHER FIXTURES.

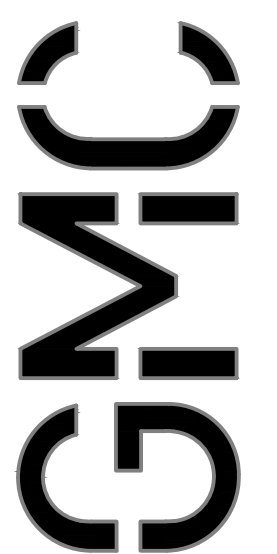


ASBUILT

2660 East Chose Lane, Suite 200
Montgomery, AL 36117
T 334-271-3200
G M C N E T W O R K . C O M

THE EXCHANGE AT HOMEPLACE
PRATTVILLE, AL
GMC PROJECT#AMGM180037



ISSUE	DATE
95% REVIEW	05.30.19
PERMIT SET	10.11.19
DESIGNED BY:	
DRAWN BY:	
CHECKED BY:	



Legend, General Notes, and Specs - Plumbing


P0.1

sheet of

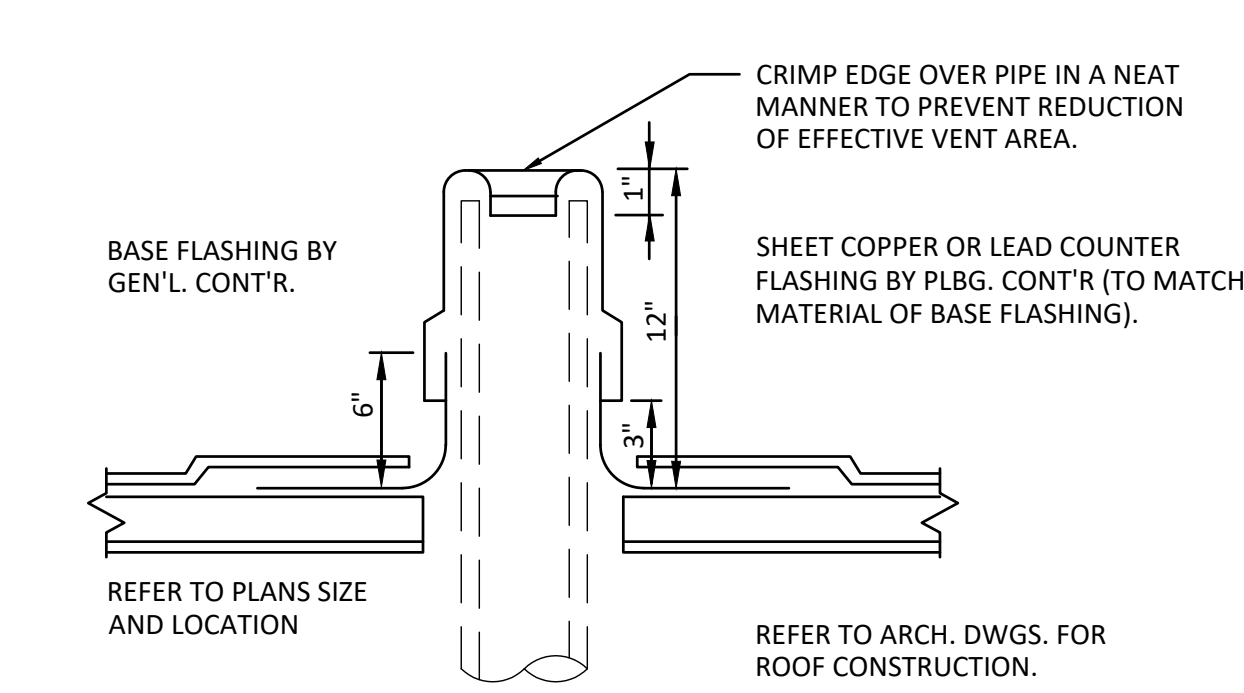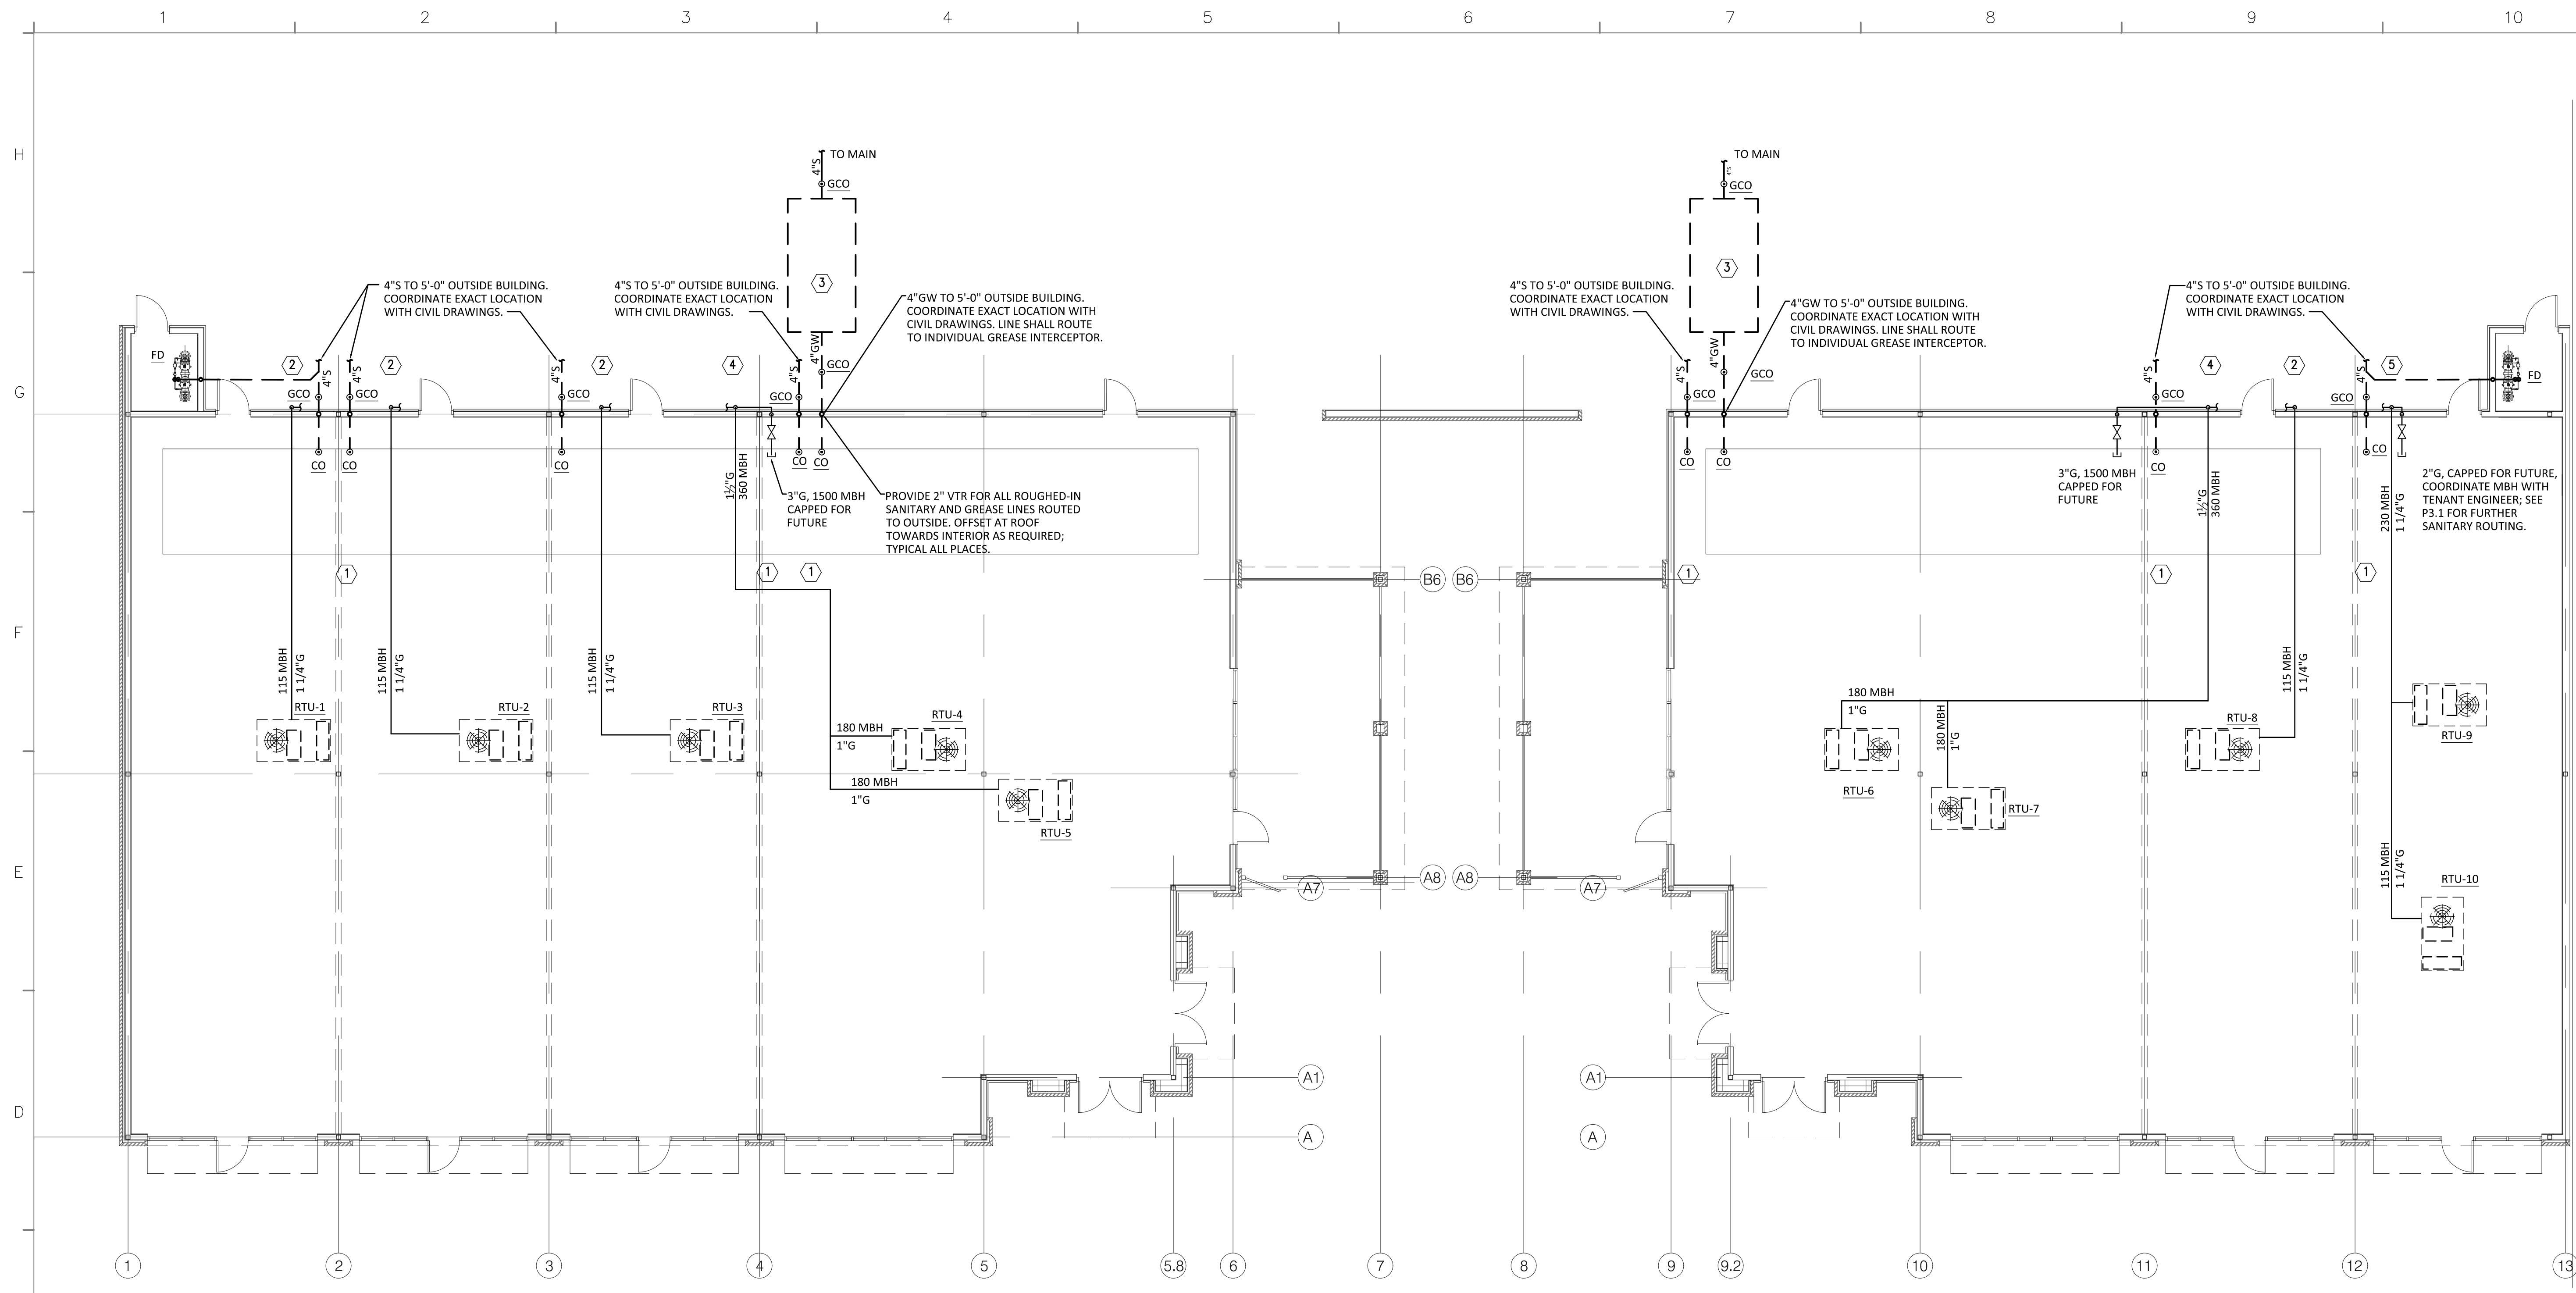

2 PLUMBING VENT THROUGH ROOF DETAIL
NTS


- KEYNOTES (APPLY TO THIS SHEET ONLY):**
- ① STUB IN SEALED 4" S IN WALL FOR FUTURE OWNER PROVIDED FIXTURE. ROUTE SEALED 2" VENT TO 3" VTR. COORDINATE EXACT LOCATION WITH ARCHITECT/OWNER.
 - ② PROVIDE NEW GAS PIPING FOR EACH TENANT SPACE, EACH METERED SEPARATELY. COORDINATE METER INSTALLATION AND LOCATIONS WITH GAS AUTHORITY. ASSUME PIPING IS ROUTED FROM CLOSEST EXISTING METER BANK. LINES SIZED FOR 2#, 1PSI PRESSURE DROP AT 130'. DISTANCE SHALL BE VERIFIED WITH PROVIDER.
 - ③ PROVIDE 1500 GALLON GREASE TRAP. COORDINATE EXACT LOCATION WITH CIVIL.
 - ④ PROVIDE NEW GAS PIPING FOR FUTURE RESTAURANT TENANT SPACE, EACH METERED SEPARATELY. COORDINATE METER INSTALLATION AND LOCATIONS WITH GAS AUTHORITY. ASSUME PIPING IS ROUTED FROM CLOSEST EXISTING METER BANK. LINES SIZED FOR 2#, 1PSI PRESSURE DROP AT 130'. DISTANCE SHALL BE VERIFIED WITH PROVIDER. 1,500 MBH HAS BEEN ESTIMATED FOR GAS LOAD. COORDINATE ACTUAL GAS LOAD WITH TENANT ENGINEER.
 - ⑤ PROVIDE NEW GAS PIPING FOR JERSEY MIKE'S TENANT SPACE, METERED SEPARATELY. COORDINATE METER INSTALLATION AND LOCATIONS WITH GAS AUTHORITY. ASSUME PIPING IS ROUTED FROM CLOSEST EXISTING METER BANK. LINES SIZED FOR 2#, 1PSI PRESSURE DROP AT 130'. DISTANCE SHALL BE VERIFIED WITH PROVIDER. TENANT HAS REQUESTED A 2" LINE FOR THEIR SPACE (SHOWN HERE). COORDINATE ACTUAL GAS LOAD WITH TENANT ENGINEER.


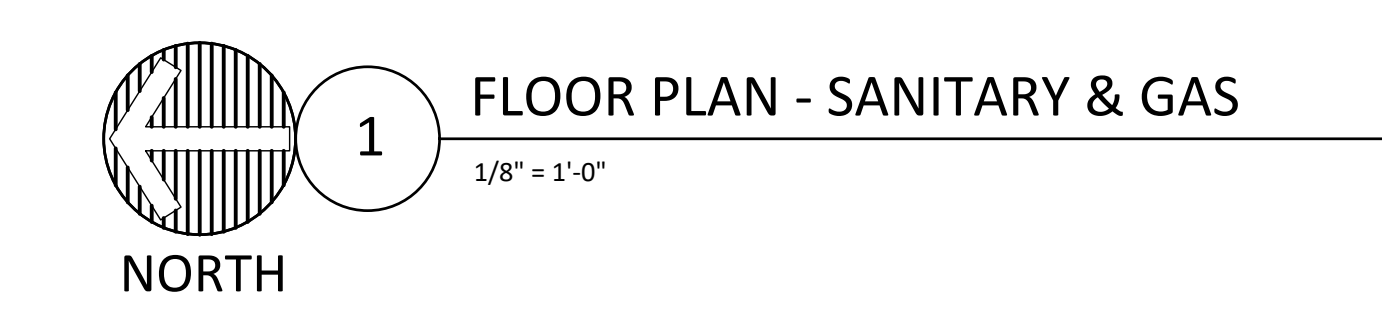


1 FLOOR PLAN - SANITARY & GAS
1/8" = 1'-0"

ISSUE	DATE
95% REVIEW	05.30.19
PERMIT SET	10.11.19
DESIGNED BY:	
DRAWN BY:	
CHECKED BY:	

THE EXCHANGE AT HOMEPPLACE
PRATTVILLE, AL
GMC PROJECT#AMGM180037

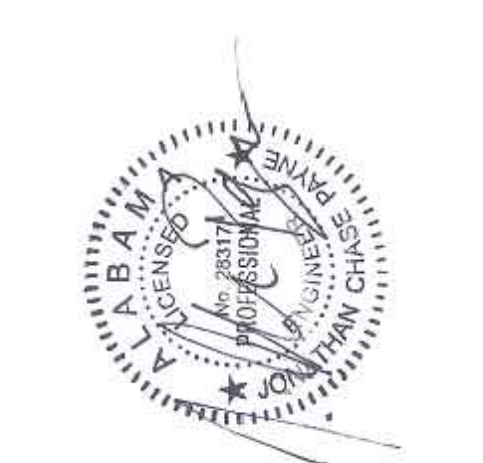

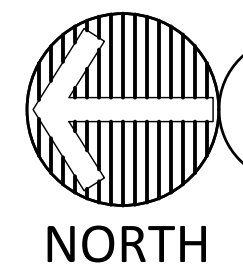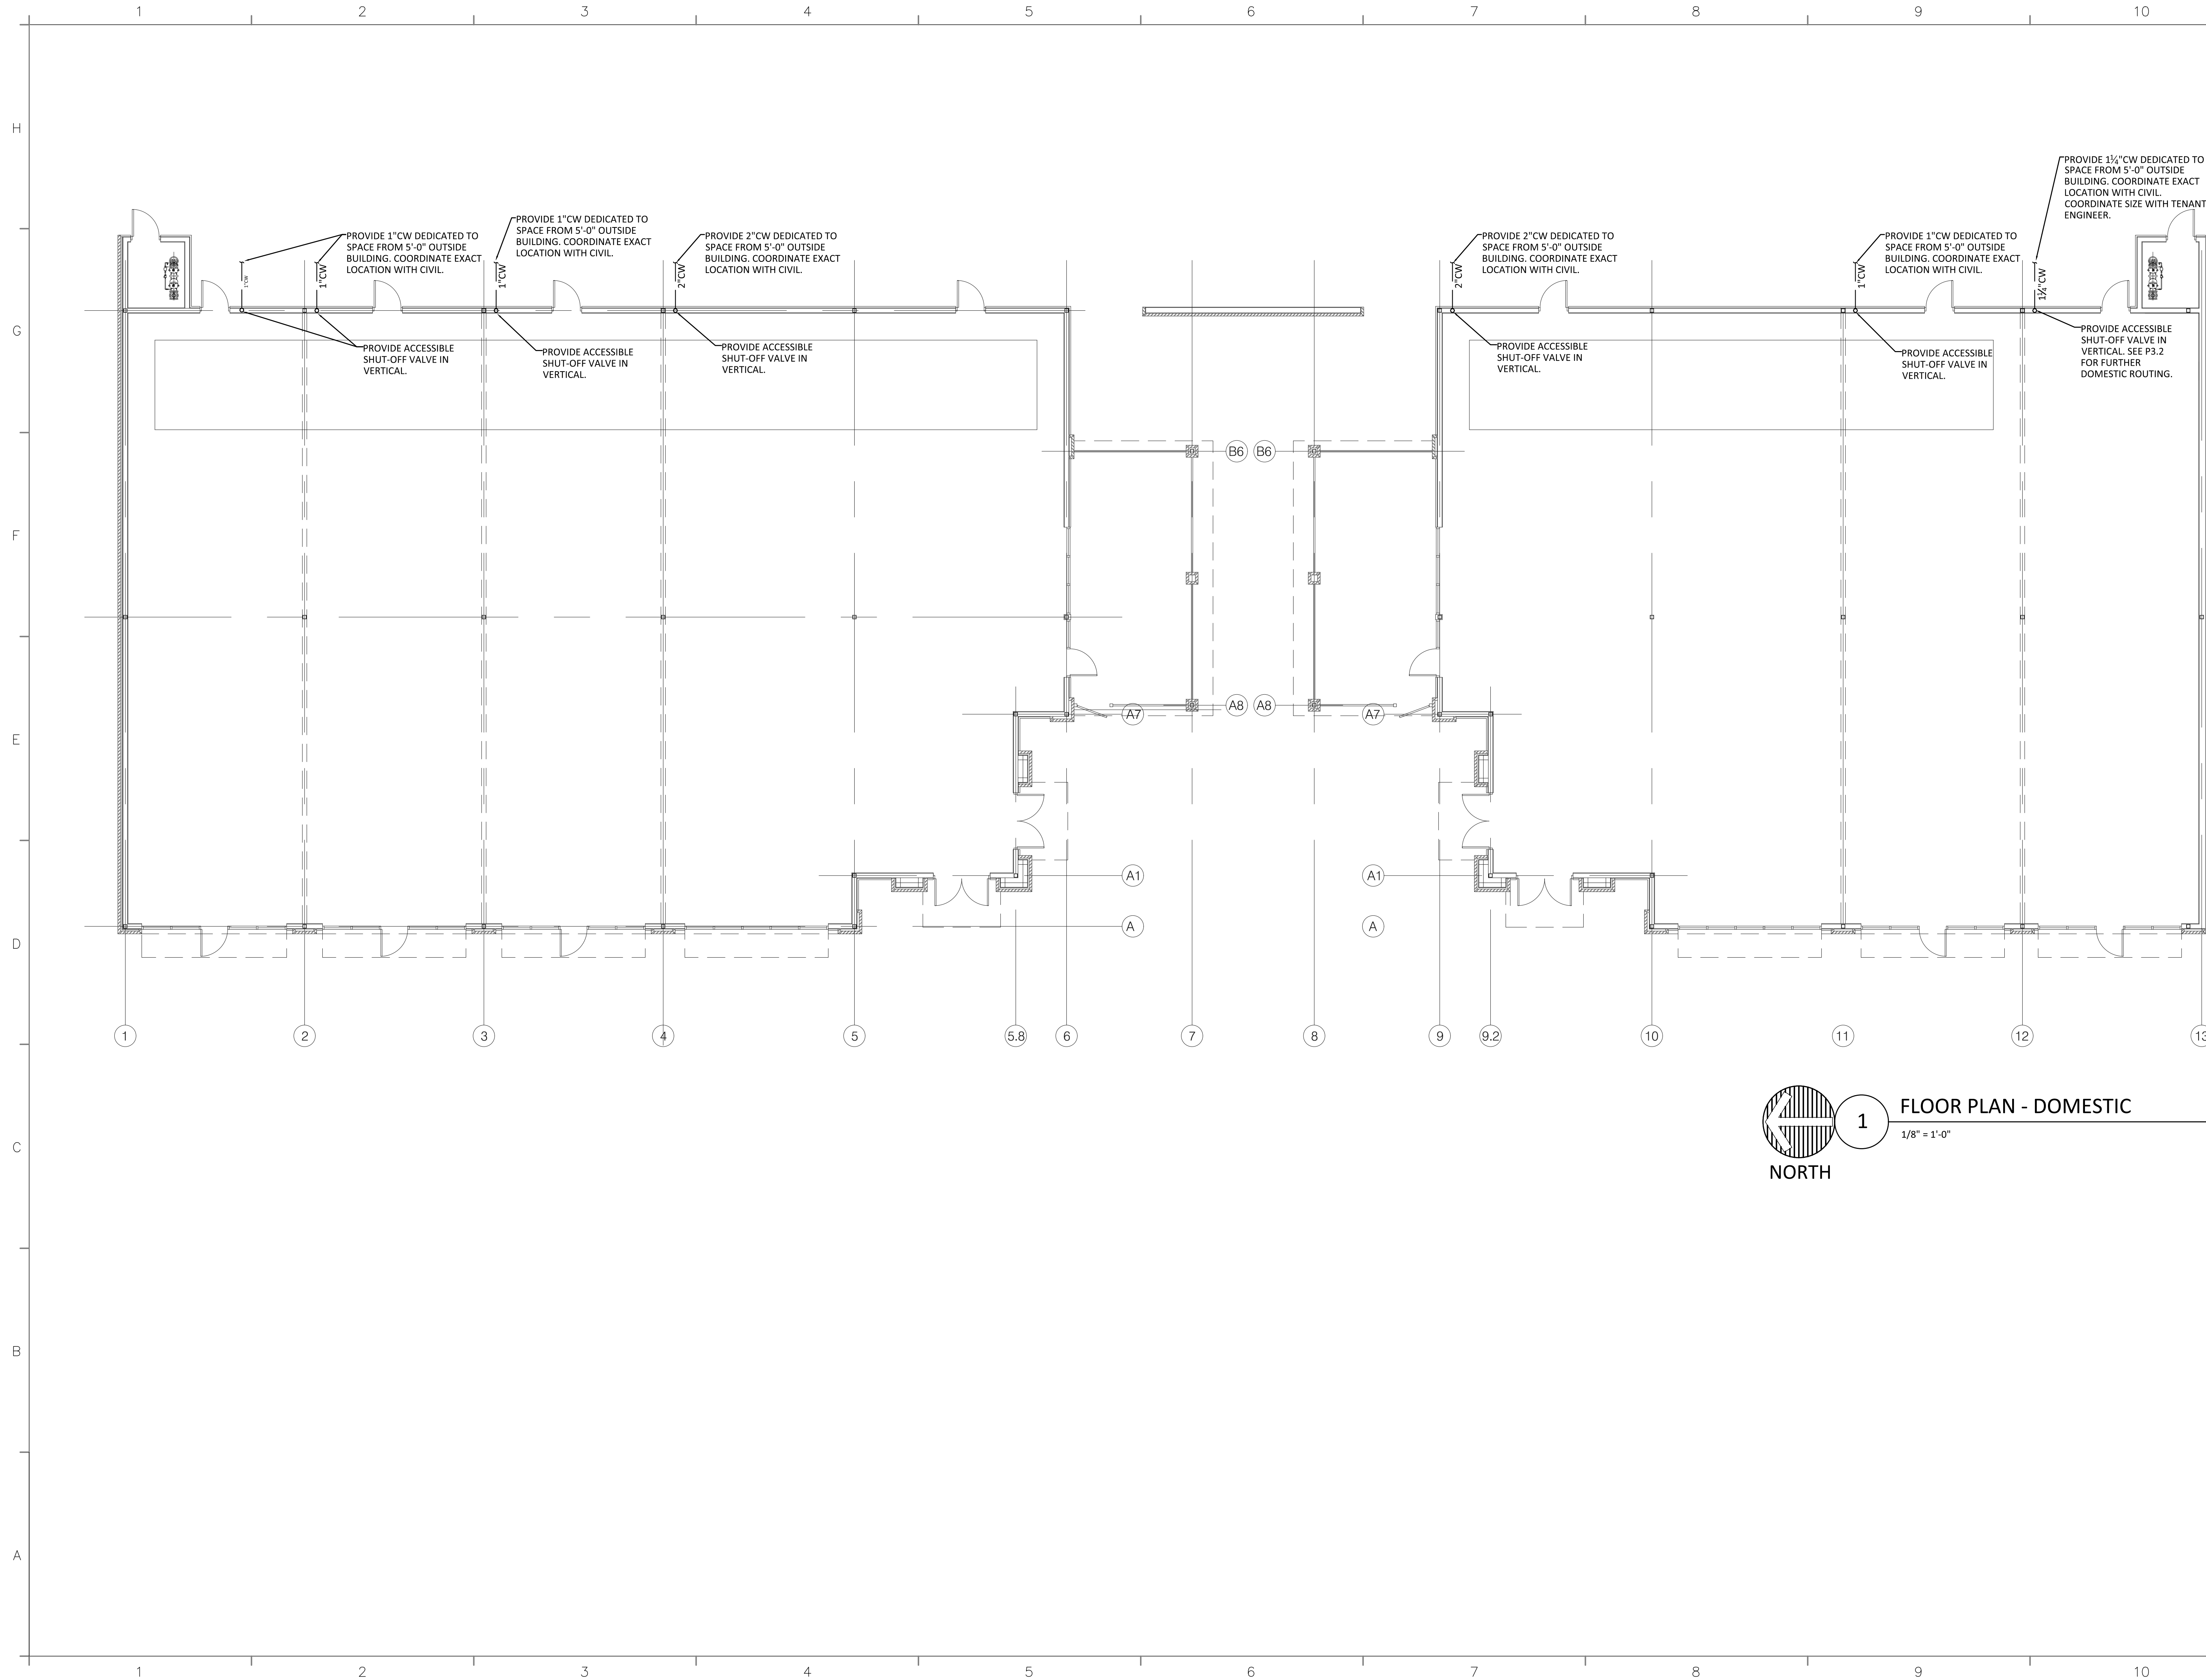

1 FLOOR PLAN - DOMESTIC
1/8" = 1'-0"


Floor Plan - Domestic
P2.2
sheet of




THE EXCHANGE AT HOMELACE
PRATTVILLE, AL
GMC PROJECT#AMGM180037

ISSUE	DATE
95% REVIEW	05.30.19
PERMIT SET	10.11.19
DESIGNED BY:	
DRAWN BY:	
CHECKED BY:	

AS BUILT
2660 East Chose Lane, Suite 200
Montgomery, AL 36117
T 334.271.3200
G M C N E T W O R K . C O M

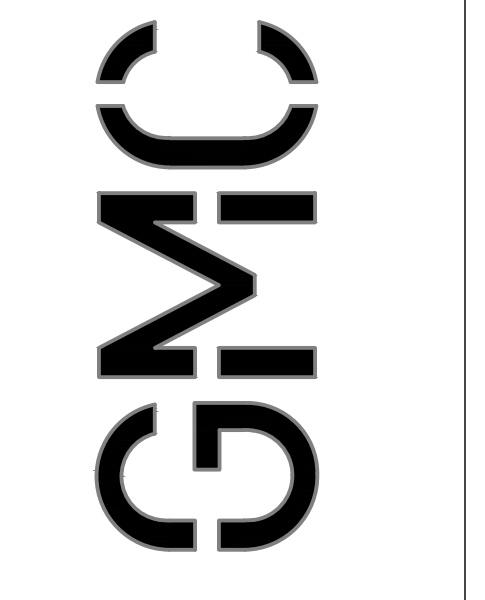

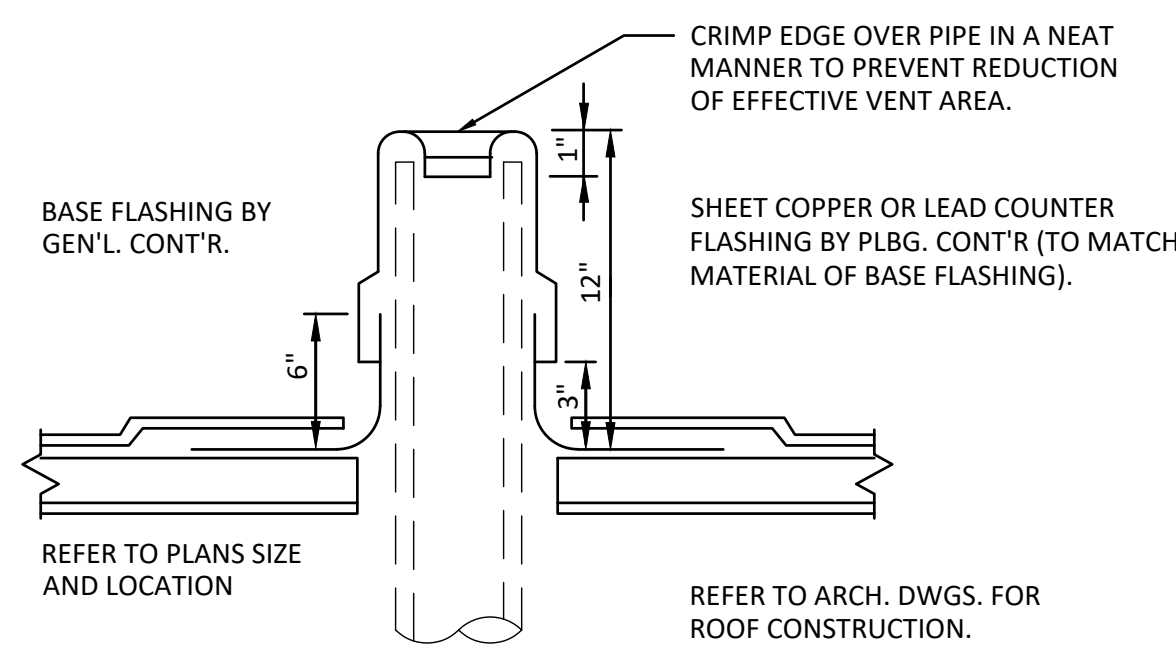


4 PLUMBING VENT THROUGH ROOF DETAIL
NTS


LEGEND - PLUMBING		
SYMBOLS	ABBRV.	DESCRIPTION
---	OW	OILY WASTE PIPING BELOW FLOOR OR GRADE
---	S	SANITARY WASTE PIPING BELOW FLOOR OR GRADE
---	S	SANITARY WASTE PIPING ABOVE FLOOR OR GRADE
---	V	VENT PIPING
---	CW	DOMESTIC COLD WATER
---	HW	DOMESTIC HOT WATER
---	HWR	HOT WATER RECIRCULATE
---	VTR	SANITARY VENT THROUGH ROOF
---	CO / WCO	CLEANOUT / WALL CLEANOUT
---	FCO/GCO	FLOOR/GROUND CLEANOUT
---	FD	FLOOR DRAIN
---	HB	HOSE BIBB OR DRAIN VALVE
---	GV	GATE VALVE
---	CV	CHECK VALVE
---	BFP	BACKFLOW PREVENTER ASSEMBLY
---	RPZ	REDUCED PRESSURE ZONE (BFP)
---	PRV	PRESSURE REDUCING VALVE
---	T & P	TEMPERATURE AND PRESSURE RELIEF VALVE
---	TP	TRAP PRIMER
---		CONTINUE TO DESIGNATED LOCATION
---	A.F.G.	ABOVE FINISHED GRADE
---	B.F.F.	BELOW FINISHED FLOOR
---	B.F.G.	BELOW FINISHED GRADE
---	A/C	ABOVE CEILING
---	A/F	ABOVE FLOOR
---	B/F	BELOW FLOOR
---	B/G	BELOW GRADE
---	A.F.F.	ABOVE FINISHED FLOOR
---	AHJ	AUTHORITY HAVING JURISDICTION

PLUMBING FIXTURE SCHEDULE						
TAG	FIXTURE	CW	HW	WASTE	VENT	SPECIFICATION
P-1A	WATER CLOSET - ADA	1/2"	N/A	4"	2"	TOTO ADA MODEL CST7445F-10#10 FLOOR MOUNTED FLUSH TANK TYPE TOILET, 1.6 GPF, AND TOTO ELONGATED SEAT, WITH ALL REQUIRED ACCESSORIES. ADA COMPLIANT INSTALLATION.
P-2A	LAVATORY - WALL MTD	1/2"	1/2"	1-1/2"	2"	TOTO SELF-RIMMING, MODEL LT401, CHICAGO FAUCETS 802-VE2805-317CP, 0.5 GPM, GRID STRAINER 1-1/4" X 1-1/2" P-TRAP, INSUL. KIT & SUPPLY STOPS, ADA COMPLIANT INSTALLATION. PROVIDE ASSE 1070 MIXING VALVE.
P-3	HAND SINK	1/2"	1/2"	1-1/2"	2"	EQUIPMENT PROVIDED AND INSTALLED BY OTHERS. COORDINATE FIXTURE WITH TENANT ENGINEER. PROVIDE MATERIALS AND LABOR NECESSARY FOR ROUGH-IN.
P-4	3 COMPARTMENT SINK	3/4"	3/4"	2"	2"	EQUIPMENT PROVIDED AND INSTALLED BY OTHERS. COORDINATE FIXTURE WITH TENANT ENGINEER. PROVIDE MATERIALS AND LABOR NECESSARY FOR ROUGH-IN.
P-5	PREP SINK	1/2"	1/2"	1-1/2"	2"	EQUIPMENT PROVIDED AND INSTALLED BY OTHERS. COORDINATE FIXTURE WITH TENANT ENGINEER. PROVIDE MATERIALS AND LABOR NECESSARY FOR ROUGH-IN.
MS-1	MOP SINK	1/2"	1/2"	3"	2"	WILLIAMS SB-902 RECEPTOR W/ T-10-VB (VAC. BRK.) FAUCET, TILING FLANGE, HOSE THREAD SPOUT W/ BUCKET HOOK, 8" ON CENTER, W/ OPTION T-40 MOP HANGER & SPLASH CATCHER PANELS
FS-1	FLOOR SINK	N/A	N/A	SEE PLAN	SEE PLAN	J.R. SMITH FLOOR SINK WITH SEDIMENT BUCKET, MODEL 3100-14, 10-1/2" SQUARE TOP W/ 2-1/2" CENTER HOLE GRATE
FD	FLOOR DRAIN	N/A	N/A	3"	2"	J.R. SMITH 2005-A-B-P050 WITH 6" TYPE B SQUARE ADJUSTABLE STRAINER WITH SATIN NICKEL BRONZE FINISH. PROVIDE WITH VANDAL PROOF SECURED TOP AND TRAP PRIMER.

NOTES: PROVIDE MODEL SHOWN OR APPROVED EQUAL.

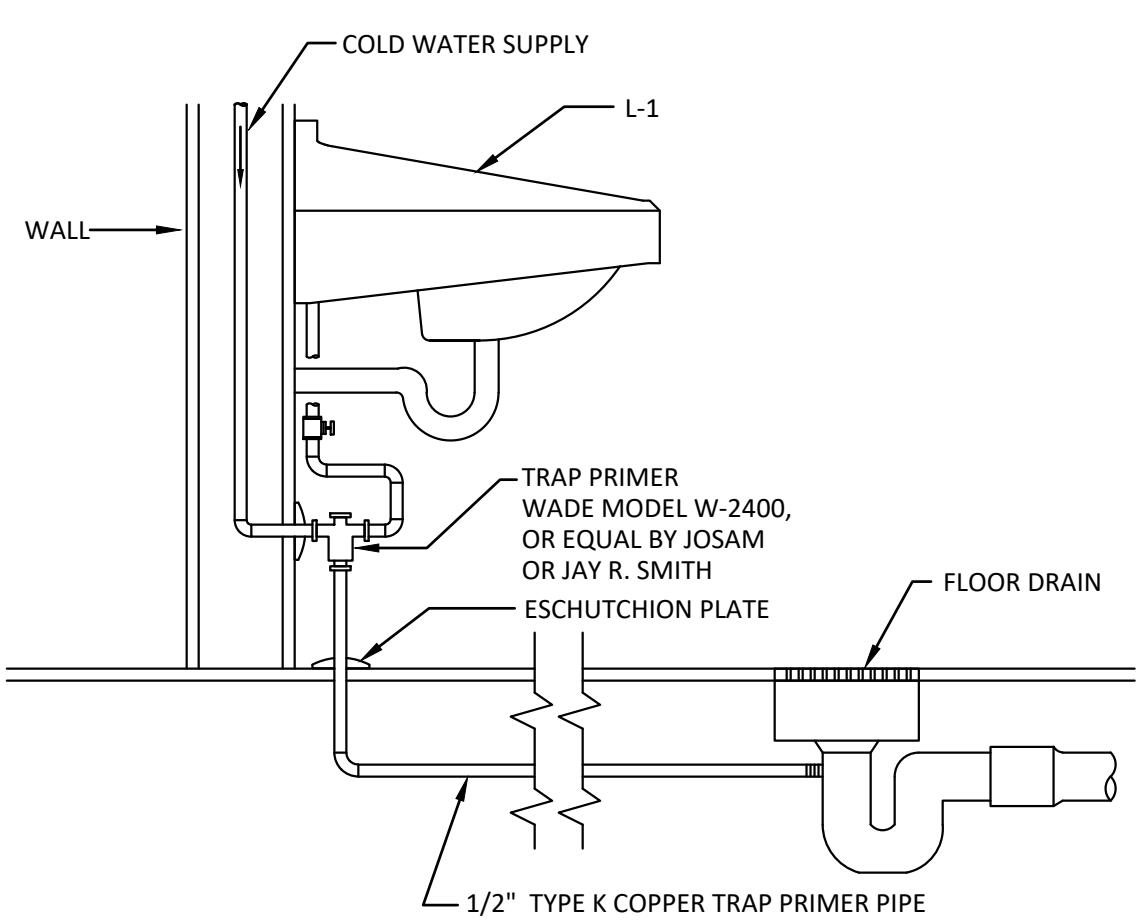


2 TYPICAL TRAP PRIMER DETAIL
NOT TO SCALE

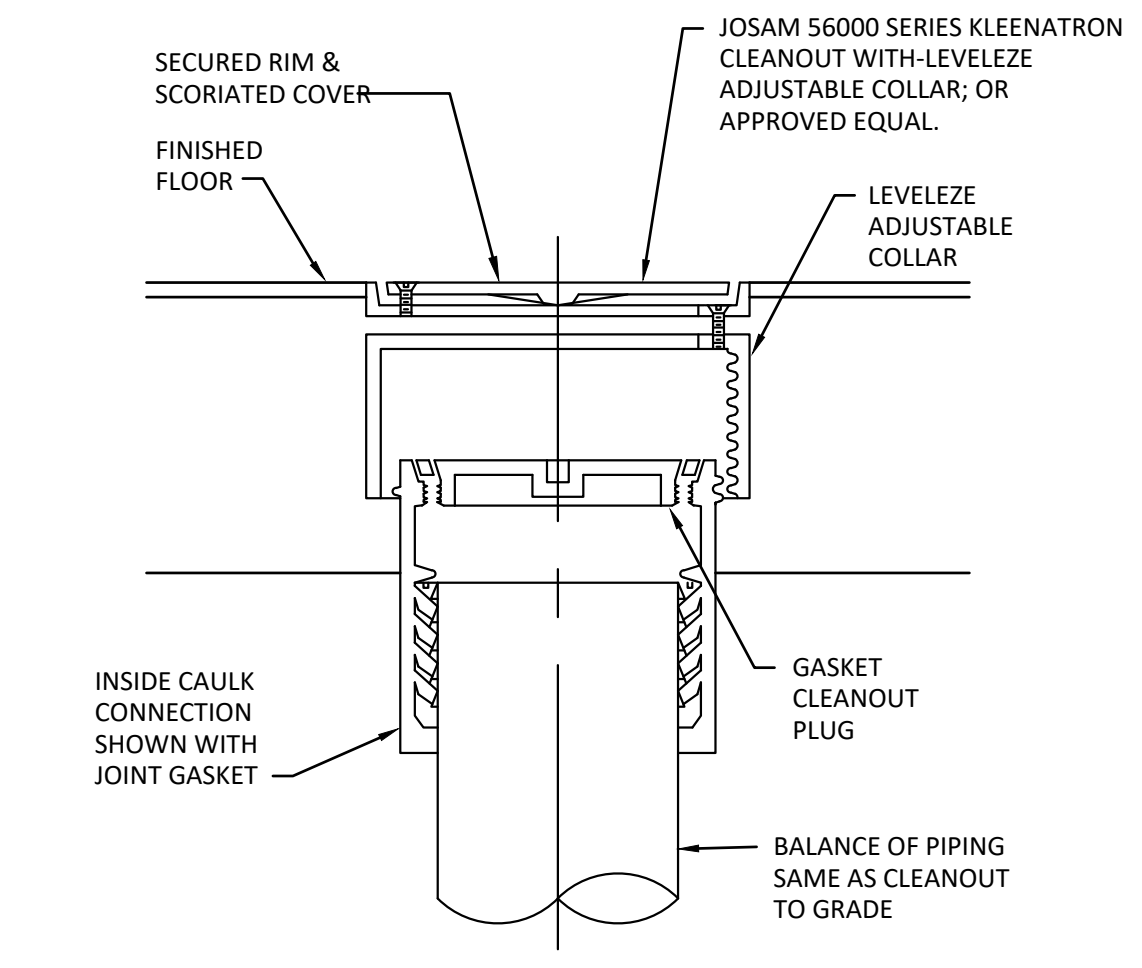


3 FLOOR CLEANOUT DETAIL
NOT TO SCALE

- ### PLUMBING SPECIFICATIONS
- ALL PLUMBING EQUIPMENT AND INSTALLATIONS SHALL CONFORM WITH THE REQUIREMENTS OF THE APPLICABLE INTERNATIONAL PLUMBING CODE, INTERNATIONAL BUILDING CODE, THE STATE ENERGY CODE, NFPA 90A, 101, AND ALL APPLICABLE CODES AND ORDINANCES.
 - PRIOR TO PURCHASING ANY MATERIALS OR STARTING ANY WORK, CONTRACTOR SHALL FIELD VERIFY ALL EXISTING CONDITIONS, PIPE SIZES AND LOCATIONS, EQUIPMENT, ETC. SHOWN ON THE DRAWINGS OR AFFECTING THIS WORK AND SHALL REPORT ANY DEVIATIONS TO THE ARCHITECT. CHANGE ORDERS SHALL NOT BE PERMITTED FOR FAILURE TO EVALUATE EXISTING CONDITIONS PRIOR TO BID.
 - SHOP DRAWINGS SHALL BE SUBMITTED TO AND APPROVED BY THE ARCHITECT PRIOR TO ORDERING, PURCHASING, OR FABRICATING ANY PLUMBING EQUIPMENT. SHOP DRAWINGS SHALL INCLUDE: ALL NEW EQUIPMENT SCHEDULED OR SPECIFIED ON THE DRAWINGS. SHOP DRAWINGS SHALL HAVE THE EQUIPMENT LABELED TO MATCH THE UNIT DESIGNATION SHOWN ON THE DRAWINGS. PROVIDE ALL INFORMATION INDICATED IN THE SCHEDULES OR ON THE DRAWINGS. SUBMIT ALL EQUIPMENT AT THE SAME TIME IN ELECTRONIC FORMAT OR OTHERWISE PAY THE HOURLY ADD-SERVICE FEE TO HAVE THE ENGINEER SCAN THEM.
 - CONTRACTOR SHALL COORDINATE ELECTRICAL CHARACTERISTICS AND REQUIREMENTS OF ALL PLUMBING EQUIPMENT WITH ELECTRICAL DRAWINGS PRIOR TO ORDERING EQUIPMENT OR SUBMITTING SHOP DRAWINGS, AND SHALL FURNISH EQUIPMENT WIRED FOR THE VOLTAGES SHOWN THEREIN.
 - ALL PLUMBING EQUIPMENT REQUIRING ELECTRICAL POWER SHALL BE INSTALLED WITH DISCONNECT SWITCHES AT EACH PIECE OF EQUIPMENT. COORDINATE SWITCH TYPE (FUUSED OR NON-FUUSED) WITH EQUIPMENT CHARACTERISTICS, MANUFACTURER'S RECOMMENDATIONS AND ELECTRICAL DRAWINGS.
 - ALL REQUIRED CONTROL WIRING NOT SHOWN ON THE ELECTRICAL DRAWINGS SHALL BE INCLUDED AS PART OF THE PLUMBING WORK. ANY CABLE ROUTED IN A RETURN AIR PLENUM SHALL BE PLENUM RATED.
 - ALL PLUMBING EQUIPMENT SHALL BE INSTALLED ACCORDING TO MANUFACTURER'S RECOMMENDATIONS.
 - ALL PLUMBING EQUIPMENT AND SYSTEMS SHALL BE GUARANTEED FOR A PERIOD OF ONE YEAR AFTER ACCEPTANCE BY OWNER.
 - ALL PERMITS SHALL BE OBTAINED AND PAID FOR BY THE PLUMBING CONTRACTOR.
 - PRESSURE TEST ALL PIPING AFTER INSTALLATION. VALVE OFF ANY EQUIPMENT THAT MAY BE SUBJECT TO SEAL FAILURE DUE TO TESTING.
 - ABOVE GROUND DOMESTIC WATER PIPING SHALL BE TYPE "L" COPPER, COMMERCIAL GRADE PEX TYPE PIPING, OR CODE APPROVED ALTERNATIVE. BELOW GROUND DOMESTIC WATER PIPING SHALL BE CODE APPROVED PVC. PEX SHALL BE CONNECTED TO METAL FITTINGS INSIDE WALL.
 - ABOVE GROUND SANITARY PIPING SHALL BE SCHEDULE 40 PVC DWV. BELOW GROUND SANITARY PIPING SHALL BE SCHEDULE 40 PVC DWV. ALL PIPING IN A RETURN AIR PLENUM SHALL BE PLENUM RATED.
 - DOMESTIC HOT WATER PIPING SHALL BE INSULATED WITH 1" ARMSTRONG ARAMFLEX INSULATION, DOMESTIC COLD WATER WITH 1/2" ARMAFLEX. INSTALL INSULATION IN STRICT ACCORDANCE TO THE MANUFACTURER'S INSTRUCTIONS AND RECOMMENDATIONS.
 - PROVIDE ASSE 1070 MIXING VALVE AT EACH HAND SINK.
 - THE ENTIRE DOMESTIC WATER PLUMBING SYSTEM SHALL BE TESTED TO A PRESSURE OF 125 PSI FOR 6 HOURS OR AS REQUIRED BY LOCAL CODE. THE SANITARY SYSTEM SHALL BE TESTED IN ACCORDANCE WITH STATE AND LOCAL CODES WHERE REQUIRED. SUBMIT CERTIFIED TEST REPORT TO ARCHITECT FOR APPROVAL. ALL INSPECTIONS, TESTS, SURVEYS, AND ANY OTHER REQUIREMENTS SHALL BE THE RESPONSIBILITY OF THIS CONTRACTOR.
 - ALL WORK SHALL BE COORDINATED AND PERFORMED WITH PRIOR APPROVAL FROM THE OWNER TO SUIT HIS OPERATING CONDITIONS.
 - ANY EXISTING WALL, FLOOR, OR CEILING SURFACE THAT IS DISTURBED DURING THE COURSE OF THE PLUMBING WORK SHALL BE REPAIRED TO MATCH NEW AND/OR EXISTING CONDITIONS.
 - CONTRACTOR SHALL COORDINATE THE INSTALLATION OF ALL PLUMBING EQUIPMENT, PIPING, ETC. TO FIT WITHIN THE SPACE ALLOWED BY THE ARCHITECTURAL AND STRUCTURAL CONDITIONS. CUTTING OR OTHERWISE ALTERING ANY STRUCTURAL MEMBERS SHALL NOT BE PERMITTED WITHOUT WRITTEN PERMISSION FROM THE ENGINEER/ARCHITECT.
 - PROVIDE ACCESS PANELS IN NON-ACCESSIBLE CEILINGS AND IN WALL STRUCTURE TO ALLOW ADEQUATE ROOM FOR MAINTENANCE OF EQUIPMENT AND BALANCING OF SYSTEM AS WELL AS ACCESS TO VALVES WHERE REQUIRED.
 - PROVIDE WATER HAMMER ARRESTORS AT THE EACH END OF EACH DOMESTIC RUN OF PIPING.
 - COORDINATE ROOF PENETRATIONS WITH STRUCTURAL, ARCHITECTURAL, AND MECHANICAL DRAWINGS. KEEP VENTS A MINIMUM OF 10'-0" FROM BUILDING INTAKES.
 - COORDINATE WATER METERS WITH CIVIL ENGINEER AND CITY WATER AHJ. THIS CONTRACTOR SHALL PAY FOR METER UNLESS COORDINATED OTHERWISE.
 - ALL FLOOR DRAINS WITHOUT CLEAN WATER WASTE SHALL HAVE A TRAP PRIMER OR TRAP GUARD (WHERE APPROVED).
 - PROVIDE INTERIOR PRESSURE REDUCING VALVE FOR ANY SYSTEM ABOVE 80 PSI PER FLOW TEST.
 - THESE DRAWINGS ARE DIAGRAMMATIC IN NATURE AND DO NOT NECESSARILY REFLECT ALL EXISTING CONDITIONS OR ACTUAL ROUTING. CONTRACTOR SHALL HAVE LATITUDE TO ADJUST ROUTING AS REQUIRED WHILE REMAINING CODE COMPLIANT. ENGINEER SHALL REVIEW ANY MAJOR DEVIATIONS FROM PLAN IF REQUIRED BY AHJ.

- KEYNOTES (APPLY TO THIS SHEET ONLY):
- 2" G, CAPPED FOR FUTURE. COORDINATE MBH WITH TENANT ENGINEER; SEE P.2.2 FOR GAS LAYOUT. COORDINATE WITH TENANT ENGINEER.
 - PROVIDE IN-SLAB TRAPZILLA TYPE GREASE INTERCEPTOR, 35 GPM MIN. PROVIDE ACCESSORIES REQUIRED FOR FULL INSTALLATION, INCLUDING MOUNTING FLUSH WITH FLOOR AND HEAVY DUTY COVER. INSTALL STRICTLY PER MANUFACTURER'S REQUIREMENTS. ROUTE VENT PIPING BELOW 3-COMP SINK WHERE REQUIRED. APPROVED EQUAL PERMITTED.

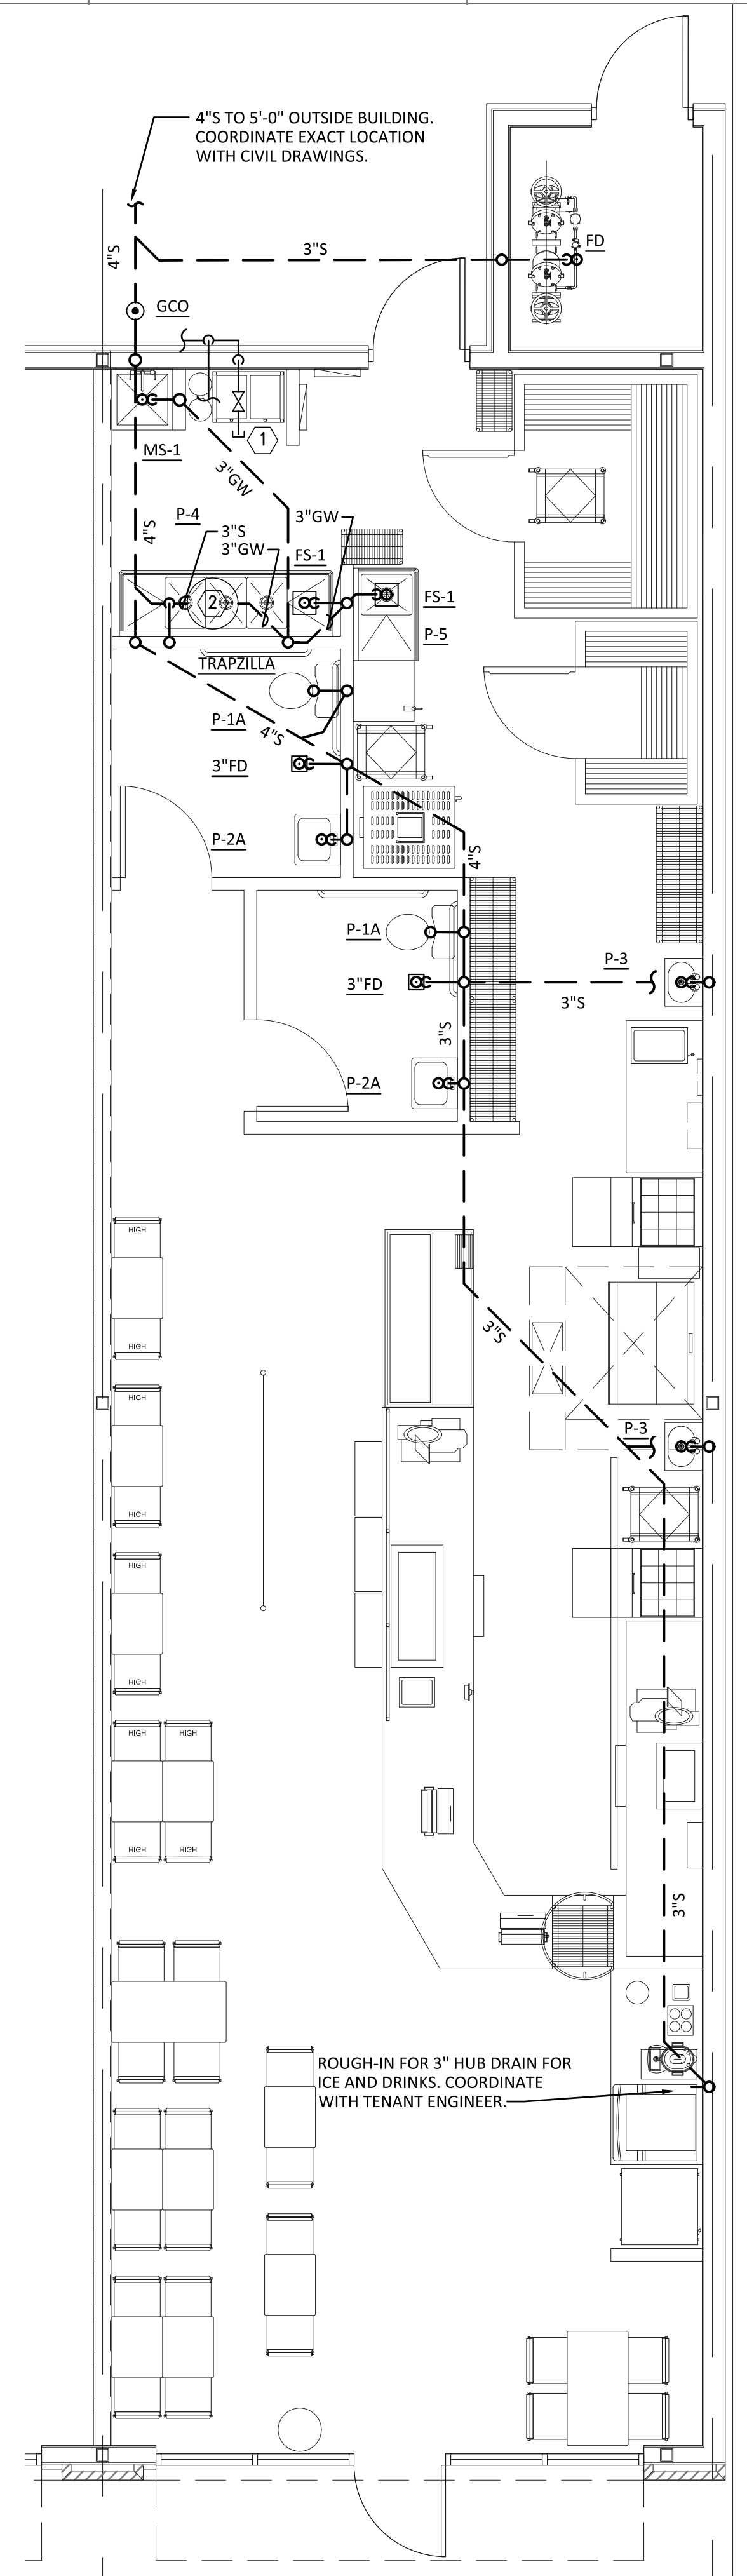

1 FLOOR PLAN - SANITARY
1/4" = 1'-0"
NORTH

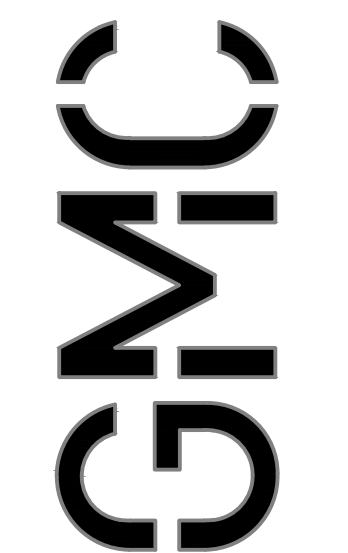


ASBUILT

2660 East Chase Lane, Suite 200
Montgomery, AL 36117
T 334-271-3200
G M C N E T W O R K . C O M

ISSUE	DATE
95% REVIEW	05.30.19
PERMIT SET	10.11.19


THE EXCHANGE AT HOMEPLACE
PRATTVILLE, AL
GMC PROJECT#AMGM180037

DESIGNED BY: _____
DRAWN BY: _____
CHECKED BY: _____




Schedules, Notes, & Floor Plan - Sanitary

P3.1
Sheet of _____

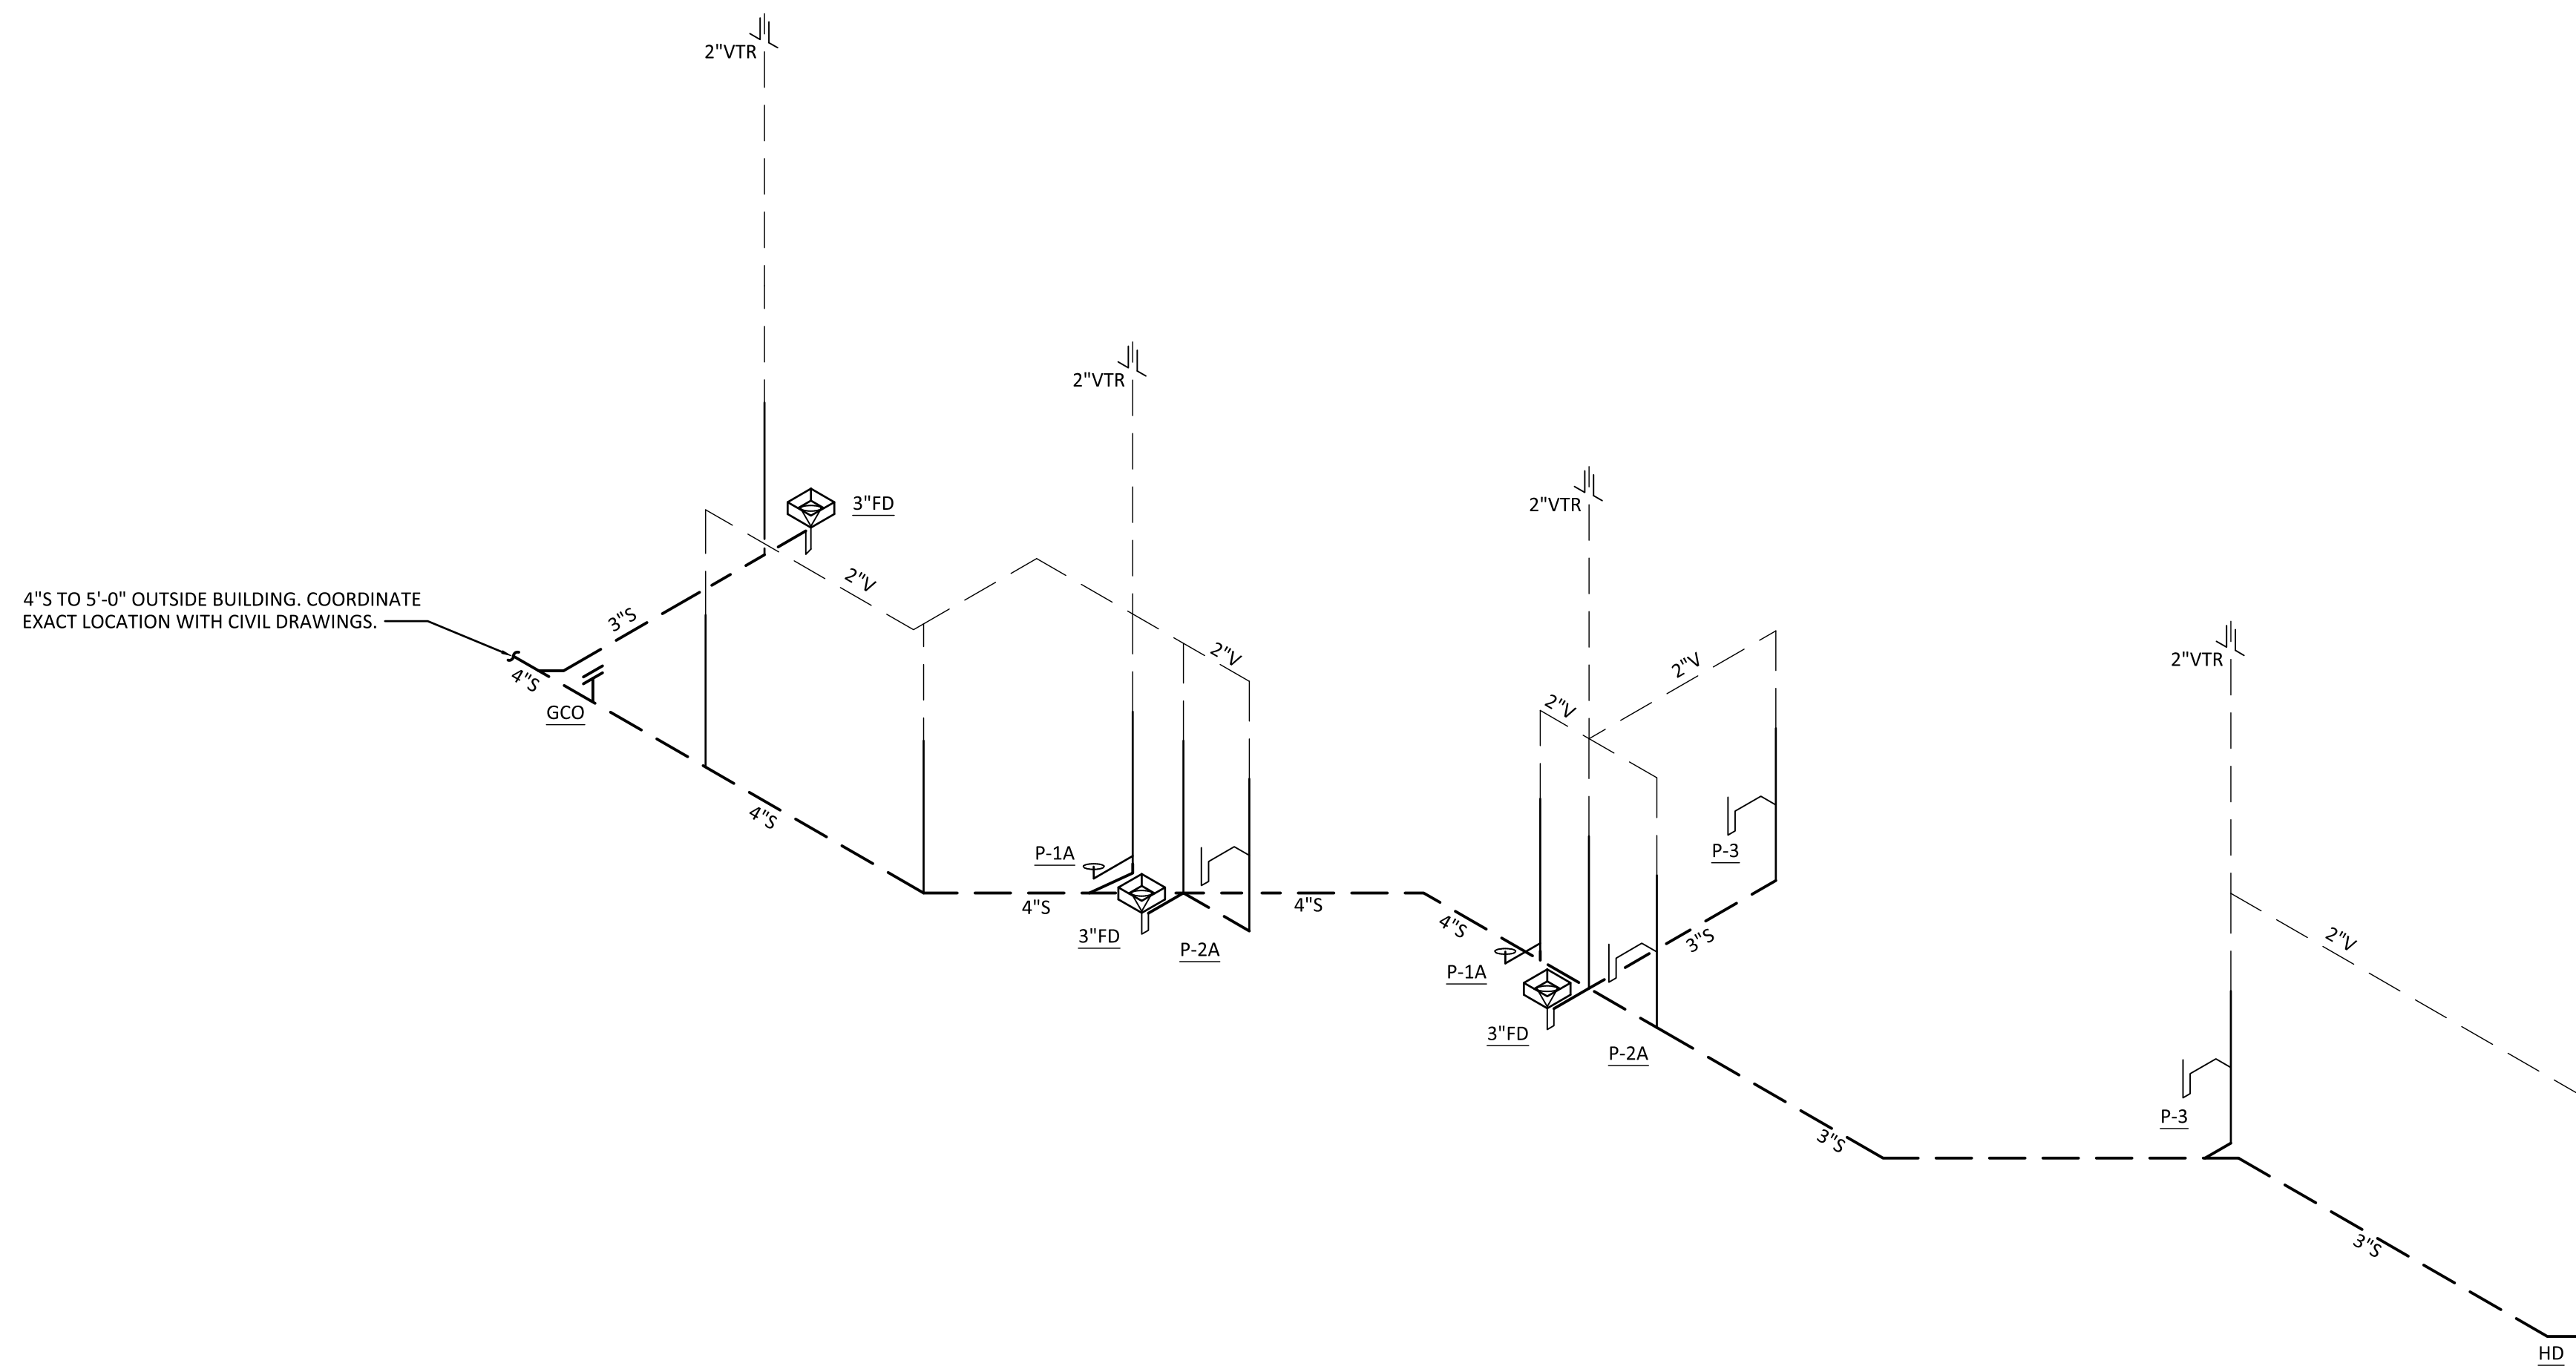


2 TYPICAL RISER DIAGRAM - SANITARY
NTS

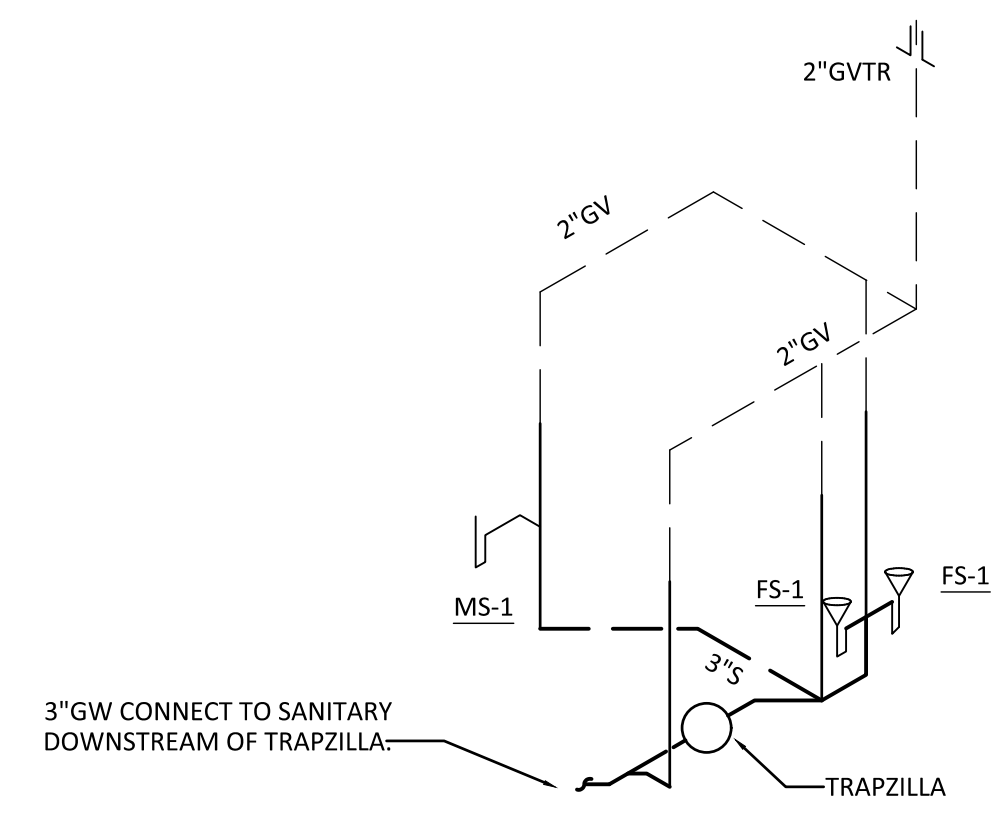

3 TYPICAL RISER DIAGRAM - GREASE
NTS

- KEYNOTES (APPLY TO THIS SHEET ONLY):**
- ① PROVIDE 1½" CW SERVICE TO SPACE (VERIFY SIZE WITH TENANT ENGINEER). COORDINATE EXACT LOCATION WITH CIVIL AND/OR WATER AUTHORITY.
 - ② PROVIDE DOMESTIC ROUGH-IN FOR ALL FIXTURES SHOWN WITH DOMESTIC WATER. VERIFY ALL SIZES WITH TENANT ENGINEER. COORDINATE ALL ROUGH-IN LOCATIONS APPROVED SUBMITTALS FOR FIXTURES FROM TENANT ENGINEER.
 - ③ ROUGH IN HW IN WALL FOR ALL FIXTURES SHOWN WITH DOMESTIC HOT WATER. HW LINES SHALL BE STUBBED UP ABOVE THE CEILING FOR CONNECTION WITH HOT WATER SYSTEM PROVIDED BY TENANT ENGINEER. COORDINATE ALL ROUGH-IN LOCATIONS APPROVED SUBMITTALS FOR FIXTURES FROM TENANT ENGINEER.

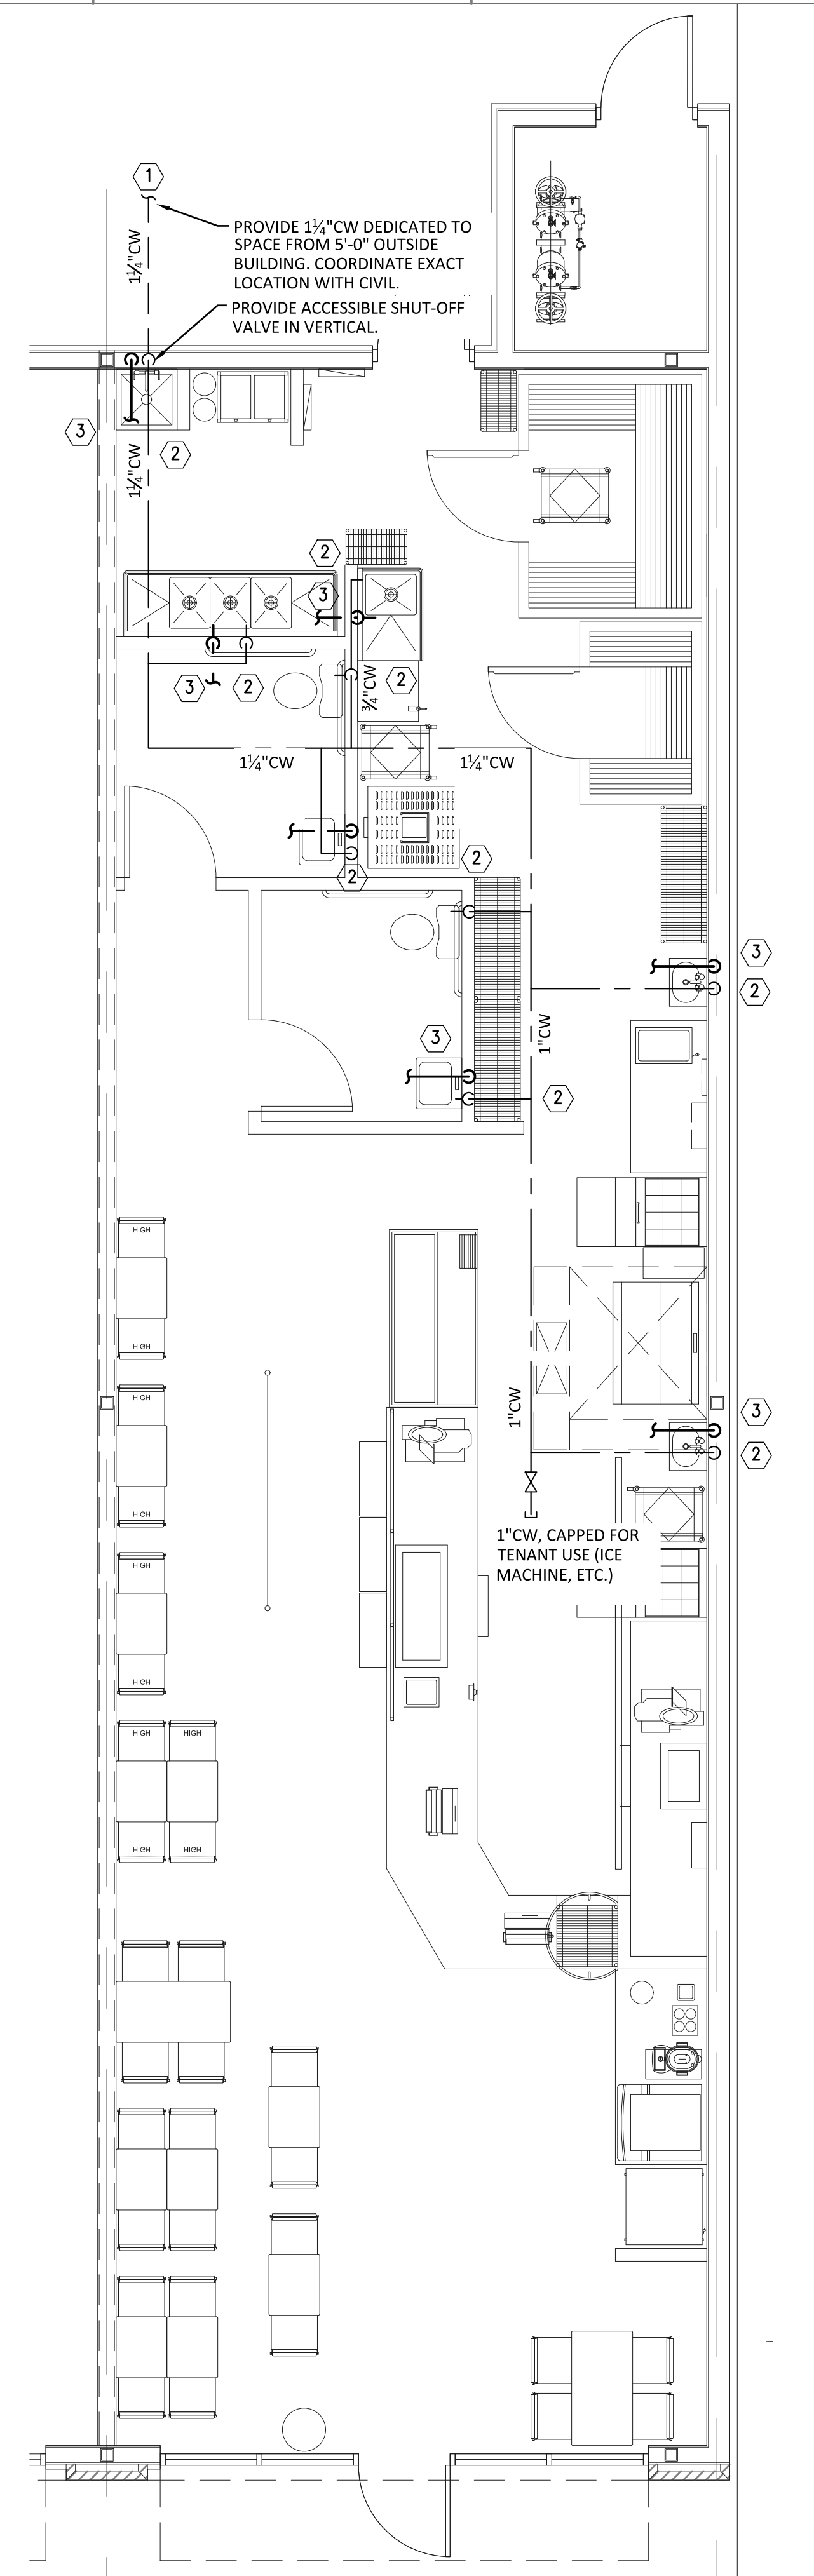

1 FLOOR PLAN - DOMESTIC
1/4" = 1'-0"
NORTH

ISSUE	DATE
95% REVIEW	05.30.19
PERMIT SET	10.11.19
DESIGNED BY:	
DRAWN BY:	
CHECKED BY:	

THE EXCHANGE AT HOMEPLACE
PRATTVILLE, AL
GMC PROJECT#AMGM180037



MECHANICAL SPECIFICATIONS

- ALL MECHANICAL EQUIPMENT AND INSTALLATIONS SHALL CONFORM WITH THE REQUIREMENTS OF THE APPLICABLE INTERNATIONAL MECHANICAL CODE, INTERNATIONAL BUILDING CODE, THE STATE ENERGY CODE, NFPA 90A, 101, AND ALL APPLICABLE CODES AND ORDINANCES.
- PRIOR TO PURCHASING ANY MATERIALS OR STARTING ANY WORK, CONTRACTOR SHALL FIELD VERIFY ALL EXISTING CONDITIONS, DUCTWORK SIZES AND LOCATIONS, EQUIPMENT, ETC. SHOWN ON THE DRAWINGS OR AFFECTING THIS WORK AND SHALL REPORT ANY DEVIATIONS TO THE ARCHITECT. SUBMITTING A BID, THIS CONTRACTOR VERIFIES THAT EXISTING CONDITIONS HAVE BEEN VERIFIED.
- SHOP DRAWINGS SHALL BE SUBMITTED TO AND APPROVED BY THE ARCHITECT PRIOR TO ORDERING, PURCHASING, OR FABRICATING ANY MECHANICAL EQUIPMENT. EQUIPMENT SHALL BE AS SCHEDULED PER MODEL NUMBER GIVEN OR AN APPROVED EQUAL. SHOP DRAWINGS SHALL INCLUDE: ALL NEW EQUIPMENT SCHEDULED OR SPECIFIED ON THE DRAWINGS. SHOP DRAWINGS SHALL HAVE THE EQUIPMENT LABELED TO MATCH THE UNIT DESIGNATION SHOWN ON THE DRAWINGS. PROVIDE ALL INFORMATION INDICATED IN THE SCHEDULES OR ON THE DRAWINGS. SUBMIT ALL EQUIPMENT AT THE SAME TIME IN ELECTRONIC FORMAT OR OTHERWISE PAY THE HOURLY ADD-SERVICE FEE TO HAVE THE ENGINEER SCAN THEM.
- CONTRACTOR SHALL COORDINATE ELECTRICAL CHARACTERISTICS AND REQUIREMENTS OF ALL MECHANICAL EQUIPMENT WITH ELECTRICAL DRAWINGS PRIOR TO ORDERING EQUIPMENT OR SUBMITTING SHOP DRAWINGS, AND SHALL FURNISH EQUIPMENT WIRED FOR THE VOLTAGES SHOWN THEREIN.
- ALL MECHANICAL EQUIPMENT REQUIRING ELECTRICAL POWER SHALL BE INSTALLED WITH DISCONNECT SWITCHES AT EACH PIECE OF EQUIPMENT. COORDINATE SWITCH TYPE (FUUSED OR NON-FUSED) WITH EQUIPMENT CHARACTERISTICS, MANUFACTURER'S RECOMMENDATIONS AND ELECTRICAL DRAWINGS.
- ALL REQUIRED CONTROL WIRING NOT SHOWN ON THE ELECTRICAL DRAWINGS SHALL BE INCLUDED AS PART OF THE MECHANICAL WORK.
- UNLESS NOTED OTHERWISE, DISCONNECTS, SMOKE DETECTORS, TRANSFORMERS, CONTROLS AND CONTROL WIRING REQUIRED FOR ALL MECHANICAL SYSTEMS SHALL BE FURNISHED AND INSTALLED BY THE MECHANICAL CONTRACTOR.
- STARTERS FOR MECHANICAL EQUIPMENT SHALL BE PROVIDED BY MANUFACTURER OR MECHANICAL CONTRACTOR.
- ALL MECHANICAL EQUIPMENT SHALL BE INSTALLED ACCORDING TO MANUFACTURER'S RECOMMENDATIONS.
- ALL MECHANICAL EQUIPMENT AND SYSTEMS SHALL BE GUARANTEED FOR A PERIOD OF ONE YEAR AFTER ACCEPTANCE BY OWNER. ALL HVAC COMPRESSORS SHALL HAVE EXTENDED 5-YEAR MANUFACTURER'S WARRANTY.
- ALL PERMITS SHALL BE OBTAINED AND PAID FOR BY THE MECHANICAL CONTRACTOR.
- ROOFTOP UNITS SHALL BE INSTALLED ON A ROOF CURB WITH 12" MIN CLEARANCE (CURB SHALL BE GREATER THAN 12"). COORDINATE LOCATIONS WITH EXISTING EQUIPMENT, ARCHITECT, AND STRUCTURAL ENGINEER.
- DUCT: SUPPLY, RETURN, OA, TA, AND EXHAUST DUCTWORK SHALL BE CONSTRUCTED OF GALVANIZED SHEET METAL AS RECOMMENDED IN SMACNA HVAC DUCT CONSTRUCTION STANDARDS, LATEST EDITION. ALL JOINTS AND SEAMS IN ALL SHEETMETAL DUCTWORK SHALL BE SEALED WITH DUCT SEALER, UL LISTED 181A OR 181B FOR TAPES AND MASTICS. DO NOT USE DUCT TAPE OR DUCTBOARD. FLEXIBLE DUCTWORK SHALL NOT EXCEED 6'-0" FOR ANY RUN. SHEETMETAL DUCT SHALL BE USED FOR ALL RETURN DUCT, EXCEPT AS REQUIRED FOR CONNECTION TO A UNIT.
- DUCT INSULATION, FIBERGLASS DUCT WRAP, WITH FOIL FACED VAPOR BARRIER INSULATION SHALL BE U.L. LISTED. PROVIDE R-6 MINIMUM (HIGHER IF REQUIRED PER ENERGY CODE) INSULATION BY JOHNS MANVILLE, OWENS CORNING, OR EQUAL. IF DUCTWORK SUPPORT STRAPS ARE ATTACHED TO THE DUCT THEN LOCATE STRAPS INSIDE THE INSULATION AND SEAL WITH MASTIC AT PUNCTURE. ALL PUNCTURES (STARLES) AND PENETRATIONS OF THE FOIL VAPOR BARRIER SHALL BE SEALED AIRTIGHT WITH FOIL TAPE AND/OR MASTIC. MASTIC MUST BE APPLIED THICK ENOUGH TO COMPLETELY COVER STARLES. PERIMETER JOINTS SHALL BE FORMED SUCH THAT THE INSULATION ON THE TOP OF THE DUCT OVERLAPS THE INSULATION ON THE SIDES AND THE SIDES OVERLAP THE BOTTOM. DO NOT COMPRESS THE INSULATION WITH TRAPEZE TYPE HANGERS - WHERE NECESSARY PROVIDE RIGID BOARD INSULATION (6LB DENSITY) THE SAME THICKNESS AS THE INSULATION INSERTED INTO THE INSULATION AT THE HANGER. ALL SUPPLY DUCTS SHALL BE INSULATED. ALL OTHER DUCT SHALL BE INSULATED AS SHOWN OR PER ENERGY CODE.
- ALL DUCTWORK SHALL BE CONSTRUCTED BY THE LATEST GUIDELINES OF SMACNA. DUCT AND EQUIPMENT SHALL BE SUPPORTED BY THE BUILDING STRUCTURE AND SHALL NOT REST ON CEILING TILES OR CEILING STRUCTURE. DUCT SUPPORTS AND ATTACHMENT TO STRUCTURE SHALL BE AS PER SMACNA STANDARDS. ALL EXHAUST DUCT UNDER A NEGATIVE PRESSURE AND ALL RETURN DUCT LOCATED IN CEILING PLenums SHALL BE CONSTRUCTED TO A MINIMUM PRESSURE CLASS OF NEGATIVE 1" AND ALL JOINTS SHALL BE SEALED TO A SEAL CLASS OF "C" AS DEFINED BY SMACNA. SUPPLY (CONDITIONED AIR) DUCT SHALL BE CONSTRUCTED TO A PRESSURE CLASSIFICATION OF 1" AND SEALED TO A CLASS "C".
- FLEXIBLE DUCTWORK SHALL BE THE INSULATED TYPE (AS REQUIRED BY CODE) CLASS I AIR DUCT, UL 181 LISTED, THERMAFLEX OR EQUAL. DUCT SHALL BE SIZED AT 0.08"/100 FT STATIC PRESSURE DROP WHERE A SIZE IS NOT NOTED ON DRAWINGS. FLEXIBLE DUCTWORK SHALL BE INSTALLED AS STRAIGHT AS POSSIBLE, AND SHALL BE ROUTED AND SUPPORTED WITHOUT FORMING CRIMPS OR OTHER AIR FLOW RESTRICTIONS. PROVIDE SQUARE TO ROUND ADAPTERS OR BOOTS TO CONNECT TO AIR DEVICE NECK WHEN REQUIRED. FLEXIBLE DUCT SHALL NOT EXCEED 6'-0" FOR ANY DUCT RUN.
- ROUND AND FLEXIBLE DUCTWORK SHALL BE CONNECTED TO MAIN DUCTS WITH SPIN-IN FITTINGS WITH BALANCING DAMPERS.
- SHEET METAL DUCTWORK SHOWN AS BEING INTERNALLY LINED SHALL BE LINED WITH 1" THICK 1-1/2 LB./CU. FT. DENSITY DUCTLINER, R=4.2 PER INCH, MANVILLE LINACOUSTIC OR EQUAL. DUCT LINER SHALL MEET REQUIREMENTS OF NFPA 90A & 90B, FLAME SPREAD OF 25 AND SMOKE DEVELOPED OF 50, MEET ASTM G-21 AND G-22, A MIN NOISE REDUCTION COEFFICIENT OF 0.70. LINE ALL DUCTWORK MIN. 10'-0" DOWNSTREAM OF ALL AIR HANDLING UNITS UNLESS NOTED OTHERWISE. INSTALL PER MANUFACTURER'S RECOMMENDATIONS. SEAL ALL EDGES, SEAMS, RIPS, TEARS, ETC COMPLETELY (NO OPENINGS ALLOWED) WITH MANUFACTURER RECOMMENDED SEALER. NOTE: LINER IS NOT A SUBSTITUTE FOR INSULATION UNLESS SPECIFICALLY NOTED TO BE.
- PORTIONS OF DUCTWORK VISIBLE THROUGH AIR DISTRIBUTION DEVICES IN FINISHED AREAS SHALL BE PAINTED FLAT BLACK.
- DUCTWORK DIMENSIONS SHOWN ON THE DRAWINGS ARE INSIDE CLEAR DIMENSIONS. INCREASE SIZE TO ACCOMMODATE LINER. ROUND OR RECTANGULAR DUCT MAY BE USED INTERCHANGEABLY IN CONCEALED AREAS AS LONG AS THE STATIC PRESSURE IN THE DUCT IS NOT INCREASED. PERMISSION SHALL BE OBTAINED FOR CHANGING EXPOSED DUCT.
- CONDENSATE PIPING SHALL BE SCHEDULE 40 PVC (EXCEPT INSULATED COPPER IN HVAC PLENUMS). ROUTE CONDENSATE TO BUILDING EXTERIOR AND PROVIDE A DRY WELL WHERE REQUIRED. PROVIDE SPLASH BLOCKS FOR CONDENSATE ON THE ROOF. CONDENSATE SHALL BE PUMPED WHERE REQUIRED.
- AFTER CONSTRUCTION, THE ENTIRE HVAC SYSTEM, INCLUDING THE EXHAUST AND RETURN AIR SYSTEMS SHALL BE TESTED, ADJUSTED, AND BALANCED TO DELIVER THE AIR QUANTITIES SHOWN ON THE DRAWINGS. SUBMIT CERTIFIED TEST AND BALANCE REPORT TO ARCHITECT FOR APPROVAL. TESTING AGENCY SHALL BE AABC OR NEBB CERTIFIED. EXHAUST AND RETURN SYSTEMS UNDER NEGATIVE PRESSURE SHALL NOT EXCEED BY MORE THAN 10% FOR EACH FAN AND BY NO MORE THAN 10% AT EACH INLET OF THE VALVES INDICATED ON THE DRAWINGS.
- ALL WORK SHALL BE COORDINATED AND PERFORMED WITH PRIOR APPROVAL FROM THE OWNER TO SUIT THEIR OPERATING CONDITIONS.
- ANY EXISTING WALL, FLOOR, OR CEILING SURFACE THAT IS DISTURBED DURING THE COURSE OF THE HVAC WORK SHALL BE REPAIRED TO MATCH NEW AND/OR EXISTING CONDITIONS.
- CONTRACTOR SHALL COORDINATE THE INSTALLATION OF ALL MECHANICAL EQUIPMENT, DUCTWORK, ETC. TO FIT WITHIN THE SPACE ALLOWED BY THE ARCHITECTURAL AND STRUCTURAL CONDITIONS. CUTTING OR OTHERWISE ALTERING ANY STRUCTURAL MEMBERS SHALL NOT BE PERMITTED WITHOUT WRITTEN PERMISSION FROM THE ENGINEER/ARCHITECT.
- THERMOSTATS SHALL NOT HAVE MERCURY. MOUNT THERMOSTATS 4" - 4" AFF UNLESS NOTED OTHERWISE.
- LOCATIONS OF GRILLES, REGISTERS, & DIFFUSERS SHOWN ON THE DRAWINGS ARE APPROXIMATE. COORDINATE EXACT LOCATIONS WITH ARCHITECTURAL PLANS AND LIGHTS, CEILING GRID, ETC.
- ALL EQUIPMENT SHALL BE LABELED WITH BAKELITE PLASTIC ENGRAVED NAMEPLATES WITH MINIMUM 1" LETTERING.
- DURING CONSTRUCTION AND PRIOR TO OPERATING AIR EQUIPMENT PROVIDE 2" PLEATED FILTERS IN UNITS. ALSO PROVIDE FILTER MEDIA AT RETURN DUCT INLET. AT TIME OF TEST AND BALANCE REMOVE FILTER MEDIA AND PLEATED FILTERS AND PROVIDE SCHEDULED/SPECIFIED FILTERS FOR UNITS.
- PROVIDE ACCESS PANELS IN NON-ACCESSIBLE CEILINGS AND IN WALL STRUCTURE TO ALLOW ADEQUATE ROOM FOR MAINTENANCE OF EQUIPMENT AND BALANCING OF SYSTEM.
- ACCESS DOORS IN CEILINGS/WALLS SHALL BE A MINIMUM OF 12X12, HINGED, AND FIRE RATED TO MATCH CEILING/WALL RATING. DUCT ACCESS DOORS SHALL BE DOUBLE WALL IF INSTALLED ON SUPPLY DUCT, AND PROVIDED WITH THUMB LATCHES FOR AN AIR TIGHT FIT.
- WHERE INDICATED IN THE SCHEDULES, SPECIFICATIONS, OR DETAILS, PROVIDE MVDs AT SUPPLY TAKE-OFFS, WHERE ACCESSIBLE CEILING (LAY-IN) IS PROVIDED, OF RUNOUTS TO DIFFUSERS AND WHERE SHOWN ON PLANS. IF THE DUCT IS ABOVE AN INACCESSIBLE CEILING, A REMOTE OPERATOR SHALL BE PROVIDED IN A LOCATION APPROVED BY THE ARCHITECT. WHERE BALANCING DAMPERS ARE ALSO PROVIDED AT THE SUPPLY GRILLE/DIFFUSER (SEE SCHEDULE), BALANCE THE SYSTEM WITH THE DAMPER AT THE TAKE-OFF (NOT AT GRILLE). GRILLE DAMPER SHOULD BE 100% OPEN AFTER TEST AND BALANCE.
- DO NOT USE TURNING VANES ON RETURN, EXHAUST, OR OA DUCT ELBOWS UNLESS NOTED OR SHOWN AS INSTALLED. INSTEAD USE STANDARD RADIUS ELBOWS.
- ROUTE DUCT HIGH AS POSSIBLE UNDER JOIST/ROOF SUPPORT.
- FIRESTOPPING ALL PIPE AND DUCT PENETRATIONS OF FIRE AND OR SMOKE-RATED ASSEMBLIES SHALL BE FIRE-STOPPED AS REQUIRED TO RESTORE ASSEMBLY TO THE ORIGINAL INTEGRITY. FIRE BARRIER PRODUCTS SHALL BE AS MANUFACTURED BY 3M CO. CP25 CAULK, CS195 COMPOSITE PANEL, FS195 WRAP/ STRIP, OR PSS 7900 SERIES SYSTEM AS RECOMMENDED BY MFG. FOR PARTICULAR APPLICATION, OR EQUIVALENT SYSTEM AS APPROVED BY LOCAL CODE OFFICIALS.
- DAMAGED BUILDING COMPONENTS (CEILING GRID, CEILING TILES, WALL CEILINGS, LIGHT FIXTURES, ETC.) SHALL BE REPLACED TO AT LEAST THE QUALITY OF THE DAMAGED ITEM OR SURROUNDING AREA.
- THESE DRAWINGS ARE DIAGRAMMATIC IN NATURE AND DO NOT NECESSARILY REFLECT ALL EXISTING CONDITIONS OR ACTUAL ROUTING. CONTRACTOR SHALL HAVE LATITUDE TO ADJUST ROUTING AS REQUIRED WHILE REMAINING CODE COMPLIANT. ENGINEER SHALL REVIEW ANY MAJOR DEVIATIONS FROM PLAN IF REQUIRED BY AHJ.
- CONTROLS:
A. PROVIDE NEW THERMOSTATS WHERE SHOWN ON PLANS. COORDINATE WITH LIGHT SWITCHES AND WITH ARCHITECT.
B. INTERLOCK EXHAUST FANS WITH ASSOCIATED THERMOSTAT.

PACKAGED GAS/ELECTRIC ROOFTOP UNIT SCHEDULE

MARK	SUPPLY AIRFLOW	DESIGN OUTSIDE AIRFLOW	ELECTRICAL DATA					COOLING				HEATING			FAN		MAKE/MODEL	ACCESSORIES
			V/Ø	MCA	MOCP	EDB/EWB	AMBIENT	TOTAL CAP.	SENSIBLE CAP.	COIL LDB	SEER	CAPACITY IN/OUT (MBH)	EDB/LDB	AFUE	SUPPLY FAN HP	EXT. S.P. (IN WG)		
RTU-1	2000 CFM	---	208/3	34	45	80/67	95°F	60.0	48.0	55 °F	14	115/90	65/90 °F	80%	1.0	1/2	CARRIER: 48HC	1 THRU 15
RTU-2	2000 CFM	---	208/3	34	45	80/67	95°F	60.0	48.0	55 °F	14	115/90	65/90 °F	80%	1.0	1/2	CARRIER: 48HC	1 THRU 15
RTU-3	2000 CFM	---	208/3	34	45	80/67	95°F	60.0	48.0	55 °F	14	115/90	65/90 °F	80%	1.0	1/2	CARRIER: 48HC	1 THRU 15
RTU-4	4000 CFM	---	208/3	57	70	80/67	95°F	120.0	96.0	55 °F	14	180/148	65/90 °F	80%	3.0	1/2	CARRIER: 48HC	1 THRU 15
RTU-5	4000 CFM	---	208/3	57	70	80/67	95°F	120.0	96.0	55 °F	14	180/148	65/90 °F	80%	3.0	1/2	CARRIER: 48HC	1 THRU 15
RTU-6	4000 CFM	---	208/3	57	70	80/67	95°F	120.0	96.0	55 °F	14	180/148	65/90 °F	80%	3.0	1/2	CARRIER: 48HC	1 THRU 15
RTU-7	4000 CFM	---	208/3	57	70	80/67	95°F	120.0	96.0	55 °F	14	180/148	65/90 °F	80%	3.0	1/2	CARRIER: 48HC	1 THRU 15
RTU-8	2000 CFM	---	208/3	34	45	80/67	95°F	60.0	48.0	55 °F	14	115/90	65/90 °F	80%	1.0	1/2	CARRIER: 48HC	1 THRU 15
RTU-9	---	---	---	---	---	---	---	---	---	---	---	---	---	---	---	---	SEE JERSEY MIKE'S LL PLANS	---
RTU-10	---	---	---	---	---	---	---	---	---	---	---	---	---	---	---	---	SEE JERSEY MIKE'S LL PLANS	---

ACCESSORIES:
 1. MANUAL OA DAMPER AND BAROMETRIC RELIEF DAMPER.
 2. INSULATED FACTORY ROOF CURB, 14" MIN. PROVIDE EARLY TO JOB SITE.
 3. 7-DAY PROGRAMMABLE THERMOSTAT, AUTOCHANGEOVER
 4. 2 SETS OF FILTERS. REPLACE FILTERS AFTER CONSTRUCTION, BEFORE BUILDING TURNOVER.
 5. SINGLE POINT POWER CONNECTION THRU BASE OF UNIT.
 6. INSULATE UNDERSIDE OF RTU FOR SOUND ATTENUATION.
 7. ANTI-SHORTCYCLE TIMER.
 8. ACCESSORIES FOR LOW AMBIENT OPERATION.
 9. STARTER BY MFR, DISCONNECT BY EC.
 10. HINGED ACCESS PANELS.
 11. UNITS SHALL MEET ASHRAE 90.1 MIN.
 12. SMOKE DETECTOR PROVIDED AND INSTALLED BY MECHANICAL CONTRACTOR.
 13. PROVIDE UNIT SPECIFIED OR TRANE, DAIKIN, LENNOX, JCI/YORK OR APPROVED EQUAL.
 14. PROVIDE GAS PRESSURE REGULATORS WITH BAROMETRIC RELIEF.
 15. PROVIDE ENTHALPY ECONOMIZER

HVAC LEGEND

SYMBOL	ABBREV.	DESCRIPTION
EF-1		EQUIPMENT DESIGNATION (EF-1)
		SUPPLY AIR DISTRIBUTION DEVICE
		RETURN/EXHAUST AIR DEVICE
		DUCTWORK (POSITIVE PRESSURE)
		DUCTWORK (NEGATIVE PRESSURE)
18x12		DUCT SIZE IN INCHES (RECTANGULAR EXAMPLE)
10"Ø		DUCT SIZE IN INCHES (ROUND EXAMPLE)
	EF-1	THERMOSTAT (EQUIPMENT CONTROLLED)
		DUCT MOUNTED SMOKE DETECTOR
	FD	FIRE DAMPER
		RETURN AIR OPENING (SQUARE FEET)
		DUCT TRANSITION
	MVD	MANUAL VOLUME DAMPER
		LINED DUCTWORK
		EQUIPMENT/PIPING ON ROOF
		EQUIPMENT/PIPING UNDER ROOF
	EF	EXHAUST FAN
	SF	SUPPLY FAN
	WL	WALL MOUNTED LOUVER/DAMPER
	RTU	ROOF TOP UNIT
	T.T.S.	TIGHT TO UNDERSIDE OF STRUCTURE
	B.O.	BY OTHERS
	U.N.O.	UNLESS NOTED OTHERWISE
	VTR	VENT THRU ROOF
	A.F.F.	ABOVE FINISHED FLOOR
	OA	OUTSIDE AIR
	MC	MECHANICAL CONTRACTOR
	EC	ELECTRICAL CONTRACTOR
	MFR	MANUFACTURER
	MTD	MOUNTED

ELECTRIC WALL HEATERS

MARK	KW	VOLTAGE/ PHASE	MAX AMPS	MOUNTING HEIGHT	DISCHARGE	SERVES	BASIS OF DESIGN MAKE & MODEL	DISCONNECT PROVIDED AND WIRED BY	ACCESSORIES
EW-1,2	0.5	120/1	4.17	2'-0"	HORIZONTAL	FIRE RISER ROOMS	MARKEL RPH15A	MFR	1-8

① FROM FINISHED FLOOR TO BOTTOM OF HEATER, INCHES.
 ACCESSORIES:
 1. AUTOMATIC LINEAR OVERHEAT CUTOFF FULL LENGTH OF HEAT ELEMENT.
 2. WALL MOUNTING BRACKET AND ALL MOUNTING HARDWARE.
 3. PROVIDE INTEGRAL THERMOSTAT.
 4. STEEL FINNED TUBULAR HEATING ELEMENT.
 5. 24 VOLT LOW VOLTAGE CONTROL TRANSFORMER.
 6. TOTALLY ENCLOSED MOTOR AND FAN.
 7. BAKED ENAMEL FINISH.
 8. U.L. LISTED.

DEHUMIDIFYING UNIT

MARK	CAP. PINTS (MIN)	VOLTAGE/ PHASE	MAX AMPS	MOUNTING HEIGHT	DISCHARGE	SERVES	BASIS OF DESIGN MAKE & MODEL	ACCESS.
DH-1,2	35	120/1	7	FLR MTD	HORIZONTAL	APT FIRE RISER ROOMS	APRILAIRE, KUL, HISENSE, LG, GE	1-6

ACCESSORIES:
 1. UNDUCTED UNIT, PROVIDE 230 CFM.
 2. ALL FLOOR-MOUNTING HARDWARE.
 3. PROVIDE HUMIDISTAT CONTROLLER SET TO 75% RH (ADJUSTABLE).
 4. ROUTE CONDENSATE TO FLOOR DRAIN.
 5. DISCONNECT BY EC
 6. UNIT SHALL BE HARDWIRED

FAN SCHEDULE

Roof Mounted Upblast Fan										MARK: EF-1,2		
Qty	Greenheck Model	Volume (CFM)	SP (in wg)	FRPM	Max Sound Power (dBA)	Weight (Lb.)	Motor Information					
							Size (hp)	V/C/P	Encl:	Motor RPM	Windings	FLA
2	CUE-080-VG	200	0.5	1518	55	70	1/10	115/60/1	ODP	1725	1	NA

OPTIONS AND ACCESSORIES
 Switch, NEMA-1, Toggle
 Roof Curb-Galv., Under Sized 1.5 in. Total
 Foam Curb Seal
 Damper Shipped Loose, Gravity Operated, Not Coated
 Birdscreen: Aluminum

WALL LOUVER

MARK	SERVICE	SIZE	PRESSURE DROP IN.WC.	VELOCITY	BASIS OF DESIGN MAKE & MODEL	ACCESSORIES
WL-1, 2	INTAKE	18"x12"	0.05	650 FPM	GREENHECK EACC-601	ALL

ACCESSORIES:
 1. FLAT EXPANDED ALUMINUM BIRDSCREEN, INTERNAL, MILL FINISH.
 2. 1.67 SQFT FREE AREA
 3. 2.24V ACTUATOR, FAIL "CLOSED"
 4. PROVIDE ALL ACCESSORIES AND HARDWARE FOR WALL-MOUNTING. COORDINATE WITH ARCHITECTURAL DRAWINGS FOR WALL TYPES.



ASBUILT

2660 East Chase Lane, Suite 200
 Montgomery, AL 36117
 T 334-271-3200
 G.M.C.N.E.T.W.O.R.K..C.O.M

ISSUE	DATE
95% REVIEW	05.30.19
PERMIT SET	10.11.19
DESIGNED BY:	
DRAWN BY:	
CHECKED BY:	

THE EXCHANGE AT HOMEPLACE
 PRATTVILLE, AL
 GMC PROJECT#AMGM180037



Schedules, Specs, & Details - Mechanical
M0.1
 sheet of

MECHANICAL SPECIFICATIONS

- ALL MECHANICAL EQUIPMENT AND INSTALLATIONS SHALL CONFORM WITH THE REQUIREMENTS OF THE APPLICABLE INTERNATIONAL MECHANICAL CODE, INTERNATIONAL BUILDING CODE, THE STATE ENERGY CODE, NFPA 90A, 101, AND ALL APPLICABLE CODES AND ORDINANCES.
- PRIOR TO PURCHASING ANY MATERIALS OR STARTING ANY WORK, CONTRACTOR SHALL FIELD VERIFY ALL EXISTING CONDITIONS, DUCTWORK SIZES AND LOCATIONS, EQUIPMENT, ETC. SHOWN ON THE DRAWINGS OR AFFECTING THIS WORK AND SHALL REPORT ANY DEVIATIONS TO THE ARCHITECT. SUBMITTING A BID, THIS CONTRACTOR VERIFIES THAT EXISTING CONDITIONS HAVE BEEN VERIFIED.
- SHOP DRAWINGS SHALL BE SUBMITTED TO AND APPROVED BY THE ARCHITECT PRIOR TO ORDERING, PURCHASING, OR FABRICATING ANY MECHANICAL EQUIPMENT. EQUIPMENT SHALL BE AS SCHEDULED PER MODEL NUMBER GIVEN OR AN APPROVED EQUAL. SHOP DRAWINGS SHALL INCLUDE: ALL NEW EQUIPMENT SCHEDULED OR SPECIFIED ON THE DRAWINGS. SHOP DRAWINGS SHALL HAVE THE EQUIPMENT LABELED TO MATCH THE UNIT DESIGNATION SHOWN ON THE DRAWINGS. PROVIDE ALL INFORMATION INDICATED IN THE SCHEDULES OR ON THE DRAWINGS. SUBMIT ALL EQUIPMENT AT THE SAME TIME IN ELECTRONIC FORMAT OR OTHERWISE PAY THE HOURLY ADD-SERVICE FEE TO HAVE THE ENGINEER SCAN THEM.
- CONTRACTOR SHALL COORDINATE ELECTRICAL CHARACTERISTICS AND REQUIREMENTS OF ALL MECHANICAL EQUIPMENT WITH ELECTRICAL DRAWINGS PRIOR TO ORDERING EQUIPMENT OR SUBMITTING SHOP DRAWINGS, AND SHALL FURNISH EQUIPMENT WIRED FOR THE VOLTAGES SHOWN THEREIN.
- ALL MECHANICAL EQUIPMENT REQUIRING ELECTRICAL POWER SHALL BE INSTALLED WITH DISCONNECT SWITCHES AT EACH PIECE OF EQUIPMENT. COORDINATE SWITCH TYPE (FUDED OR NON-FUDED) WITH EQUIPMENT CHARACTERISTICS, MANUFACTURER'S RECOMMENDATIONS AND ELECTRICAL DRAWINGS.
- ALL REQUIRED CONTROL WIRING NOT SHOWN ON THE ELECTRICAL DRAWINGS SHALL BE INCLUDED AS PART OF THE MECHANICAL WORK.
- UNLESS NOTED OTHERWISE, DISCONNECTS, SMOKE DETECTORS, TRANSFORMERS, CONTROLS AND CONTROL WIRING REQUIRED FOR ALL MECHANICAL SYSTEMS SHALL BE FURNISHED AND INSTALLED BY THE MECHANICAL CONTRACTOR.
- STARTERS FOR MECHANICAL EQUIPMENT SHALL BE PROVIDED BY MANUFACTURER OR MECHANICAL CONTRACTOR.
- ALL MECHANICAL EQUIPMENT SHALL BE INSTALLED ACCORDING TO MANUFACTURER'S RECOMMENDATIONS.
- ALL MECHANICAL EQUIPMENT AND SYSTEMS SHALL BE GUARANTEED FOR A PERIOD OF ONE YEAR AFTER ACCEPTANCE BY OWNER. ALL HVAC COMPRESSORS SHALL HAVE EXTENDED 5-YEAR MANUFACTURER'S WARRANTY.
- ALL PERMITS SHALL BE OBTAINED AND PAID FOR BY THE MECHANICAL CONTRACTOR.
- ROOFTOP UNITS SHALL BE INSTALLED ON A ROOF CURB WITH 12" MIN CLEARANCE (CURB SHALL BE GREATER THAN 12"). COORDINATE LOCATIONS WITH EXISTING EQUIPMENT, ARCHITECT, AND STRUCTURAL ENGINEER.
- DUCT: SUPPLY, RETURN, OA, TA, AND EXHAUST DUCTWORK SHALL BE CONSTRUCTED OF GALVANIZED SHEET METAL AS RECOMMENDED IN SMACNA HVAC DUCT CONSTRUCTION STANDARDS, LATEST EDITION. ALL JOINTS AND SEAMS IN ALL SHEETMETAL DUCTWORK SHALL BE SEALED WITH DUCT SEALER, UL LISTED 181A OR 181B FOR TAPES AND MASTICS. DO NOT USE DUCT TAPE OR DUCTBOARD. FLEXIBLE DUCTWORK SHALL NOT EXCEED 6'-0" FOR ANY RUN. SHEETMETAL DUCT SHALL BE USED FOR ALL RETURN DUCT, EXCEPT AS REQUIRED FOR CONNECTION TO A UNIT.
- DUCT INSULATION, FIBERGLASS DUCT WRAP, WITH FOIL FACED VAPOR BARRIER INSULATION SHALL BE U.L. LISTED. PROVIDE R-6 MINIMUM (HIGHER IF REQUIRED PER ENERGY CODE) INSULATION BY JOHNS MANVILLE, OWENS CORNING, OR EQUAL. IF DUCTWORK SUPPORT STRAPS ARE ATTACHED TO THE DUCT THEN LOCATE STRAPS INSIDE THE INSULATION AND SEAL WITH MASTIC AT PUNCTURE. ALL PUNCTURES (STAPLES) AND PENETRATIONS OF THE FOIL VAPOR BARRIER SHALL BE SEALED AIRTIGHT WITH FOIL TAPE AND/OR MASTIC. MASTIC MUST BE APPLIED THICK ENOUGH TO COMPLETELY COVER STAPLES. PERIMETER JOINTS SHALL BE FORMED SUCH THAT THE INSULATION ON THE TOP OF THE DUCT OVERLAPS THE INSULATION ON THE SIDES AND THE SIDES OVERLAP THE BOTTOM. DO NOT COMPRESS THE INSULATION WITH TRAPEZE TYPE HANGERS - WHERE NECESSARY PROVIDE RIGID BOARD INSULATION (6LB DENSITY) THE SAME THICKNESS AS THE INSULATION INSERTED INTO THE INSULATION AT THE HANGER. ALL SUPPLY DUCTS SHALL BE INSULATED. ALL OTHER DUCT SHALL BE INSULATED AS SHOWN OR PER ENERGY CODE.
- ALL DUCTWORK SHALL BE CONSTRUCTED BY THE LATEST GUIDELINES OF SMACNA. DUCT AND EQUIPMENT SHALL BE SUPPORTED BY THE BUILDING STRUCTURE AND SHALL NOT REST ON CEILING TILES OR CEILING STRUCTURE. DUCT SUPPORTS AND ATTACHMENT TO STRUCTURE SHALL BE AS PER SMACNA STANDARDS. ALL EXHAUST DUCT UNDER A NEGATIVE PRESSURE AND ALL RETURN DUCT LOCATED IN CEILING PLENUMS SHALL BE CONSTRUCTED TO A MINIMUM PRESSURE CLASS OF NEGATIVE 1" AND ALL JOINTS SHALL BE SEALED TO A SEAL CLASS OF "C" AS DEFINED BY SMACNA. SUPPLY (CONDITIONED AIR) DUCT SHALL BE CONSTRUCTED TO A PRESSURE CLASSIFICATION OF 1" AND SEALED TO A CLASS "C".
- FLEXIBLE DUCTWORK SHALL BE THE INSULATED TYPE (AS REQUIRED BY CODE) CLASS I AIR DUCT, UL 181 LISTED, THERMAFLEX OR EQUAL. DUCT SHALL BE SIZED AT 0.08"/100 FT STATIC PRESSURE DROP WHERE A SIZE IS NOT NOTED ON DRAWINGS. FLEXIBLE DUCTWORK SHALL BE INSTALLED AS STRAIGHT AS POSSIBLE, AND SHALL BE ROUTED AND SUPPORTED WITHOUT FORMING CRIMPS OR OTHER AIR FLOW RESTRICTIONS. PROVIDE SQUARE TO ROUND ADAPTERS OR BOOTS TO CONNECT TO AIR DEVICE NECK WHEN REQUIRED. FLEXIBLE DUCT SHALL NOT EXCEED 6'-0" FOR ANY DUCT RUN.
- ROUND AND FLEXIBLE DUCTWORK SHALL BE CONNECTED TO MAIN DUCTS WITH SPIN-IN FITTINGS WITH BALANCING DAMPERS.
- SHEET METAL DUCTWORK SHOWN AS BEING INTERNALLY LINED SHALL BE LINED WITH 1" THICK 1-1/2 LB./CU. FT. DENSITY DUCTLINER, R=4.2 PER INCH, MANVILLE LINACOUSTIC OR EQUAL. DUCT LINER SHALL MEET REQUIREMENTS OF NFPA 90A & 90B, FLAME SPREAD OF 25 AND SMOKE DEVELOPED OF 50, MEET ASTM G-21 AND G-22, A MIN NOISE REDUCTION COEFFICIENT OF 0.70. LINE ALL DUCTWORK MIN. 10'-0" DOWNSTREAM OF ALL AIR HANDLING UNITS UNLESS NOTED OTHERWISE. INSTALL PER MANUFACTURER'S RECOMMENDATIONS. SEAL ALL EDGES, SEAMS, RIPS, TEARS, ETC COMPLETELY (NO OPENINGS ALLOWED) WITH MANUFACTURER RECOMMENDED SEALER. NOTE: LINER IS NOT A SUBSTITUTE FOR INSULATION UNLESS SPECIFICALLY NOTED TO BE.
- PORTIONS OF DUCTWORK VISIBLE THROUGH AIR DISTRIBUTION DEVICES IN FINISHED AREAS SHALL BE PAINTED FLAT BLACK.
- DUCTWORK DIMENSIONS SHOWN ON THE DRAWINGS ARE INSIDE CLEAR DIMENSIONS. INCREASE SIZE TO ACCOMMODATE LINER. ROUND OR RECTANGULAR DUCT MAY BE USED INTERCHANGEABLY IN CONCEALED AREAS AS LONG AS THE STATIC PRESSURE IN THE DUCT IS NOT INCREASED. PERMISSION SHALL BE OBTAINED FOR CHANGING EXPOSED DUCT.
- CONDENSATE PIPING SHALL BE SCHEDULE 40 PVC (EXCEPT INSULATED COPPER IN HVAC PLENUMS), ROUTE CONDENSATE TO BUILDING EXTERIOR AND PROVIDE A DRY WELL WHERE REQUIRED. PROVIDE SPLASH BLOCKS FOR CONDENSATE ON THE ROOF. CONDENSATE SHALL BE PUMPED WHERE REQUIRED.
- AFTER CONSTRUCTION, THE ENTIRE HVAC SYSTEM, INCLUDING THE EXHAUST AND RETURN AIR SYSTEMS SHALL BE TESTED, ADJUSTED, AND BALANCED TO DELIVER THE AIR QUANTITIES SHOWN ON THE DRAWINGS. SUBMIT CERTIFIED TEST AND BALANCE REPORT TO ARCHITECT FOR APPROVAL. TESTING AGENCY SHALL BE AABC OR NEBB CERTIFIED. EXHAUST AND RETURN SYSTEMS UNDER NEGATIVE PRESSURE SHALL NOT EXCEED BY MORE THAN 10% FOR EACH FAN AND BY NO MORE THAN 10% AT EACH INLET OF THE VALUES INDICATED ON THE DRAWINGS.
- ALL WORK SHALL BE COORDINATED AND PERFORMED WITH PRIOR APPROVAL FROM THE OWNER TO SUIT THEIR OPERATING CONDITIONS.
- ANY EXISTING WALL, FLOOR, OR CEILING SURFACE THAT IS DISTURBED DURING THE COURSE OF THE HVAC WORK SHALL BE REPAIRED TO MATCH NEW AND/OR EXISTING CONDITIONS.
- CONTRACTOR SHALL COORDINATE THE INSTALLATION OF ALL MECHANICAL EQUIPMENT, DUCTWORK, ETC. TO FIT WITHIN THE SPACE ALLOWED BY THE ARCHITECTURAL AND STRUCTURAL CONDITIONS. CUTTING OR OTHERWISE ALTERING ANY STRUCTURAL MEMBERS SHALL NOT BE PERMITTED WITHOUT WRITTEN PERMISSION FROM THE ENGINEER/ARCHITECT.
- THERMOSTATS SHALL NOT HAVE MERCURY. MOUNT THERMOSTATS 4' - 4" AFF UNLESS NOTED OTHERWISE.
- LOCATIONS OF GRILLES, REGISTERS, & DIFFUSERS SHOWN ON THE DRAWINGS ARE APPROXIMATE. COORDINATE EXACT LOCATIONS WITH ARCHITECTURAL PLANS AND LIGHTS, CEILING GRID, ETC.
- ALL EQUIPMENT SHALL BE LABELED WITH BAKELITE PLASTIC ENGRAVED NAMEPLATES WITH MINIMUM 1" LETTERING.
- DURING CONSTRUCTION AND PRIOR TO OPERATING AIR EQUIPMENT PROVIDE 2" PLEATED FILTERS IN UNITS. ALSO PROVIDE FILTER MEDIA AT RETURN DUCT INLET. AT TIME OF TEST AND BALANCE REMOVE FILTER MEDIA AND PLEATED FILTERS AND PROVIDE SCHEDULED/SPECIFIED FILTERS FOR UNITS.
- PROVIDE ACCESS PANELS IN NON-ACCESSIBLE CEILINGS AND IN WALL STRUCTURE TO ALLOW ADEQUATE ROOM FOR MAINTENANCE OF EQUIPMENT AND BALANCING OF SYSTEM.
- ACCESS DOORS IN CEILINGS/WALLS SHALL BE A MINIMUM OF 12X12, HINGED, AND FIRE RATED TO MATCH CEILING/WALL RATING. DUCT ACCESS DOORS SHALL BE DOUBLE WALL IF INSTALLED ON SUPPLY DUCT, AND PROVIDED WITH THUMB LATCHES FOR AN AIR TIGHT FIT.
- WHERE INDICATED IN THE SCHEDULES, SPECIFICATIONS, OR DETAILS, PROVIDE MVDs AT SUPPLY TAKE-OFFS, WHERE ACCESSIBLE CEILING (LAY-IN) IS PROVIDED, OR RUNOUTS TO DIFFUSERS AND WHERE SHOWN ON PLANS. IF THE DUCT IS ABOVE AN INACCESSIBLE CEILING, A REMOTE OPERATOR SHALL BE PROVIDED IN A LOCATION APPROVED BY THE ARCHITECT. WHERE BALANCING DAMPERS ARE ALSO PROVIDED AT THE SUPPLY GRILLE/DIFFUSER (SEE SCHEDULE), BALANCE THE SYSTEM WITH THE DAMPER AT THE TAKE-OFF (NOT AT GRILLE). GRILLE DAMPER SHOULD BE 100% OPEN AFTER TEST AND BALANCE.
- DO NOT USE TURNING VANES ON RETURN, EXHAUST, OR OA DUCT ELBOWS UNLESS NOTED OR SHOWN AS INSTALLED. INSTEAD USE STANDARD RADIUS ELBOWS.
- ROUTE DUCT HIGH AS POSSIBLE UNDER JOIST/ROOF SUPPORT.
- FIRESTOPPING ALL PIPE AND DUCT PENETRATIONS OF FIRE AND OR SMOKE-RATED ASSEMBLIES SHALL BE FIRE-STOPPED AS REQUIRED TO RESTORE ASSEMBLY TO THE ORIGINAL INTEGRITY. FIRE BARRIER PRODUCTS SHALL BE AS MANUFACTURED BY 3M CO. CP25 CAULK, CS195 COMPOSITE PANEL, FS195 WRAP/STRIP, OR PSS 7900 SERIES SYSTEM AS RECOMMENDED BY MFG. FOR PARTICULAR APPLICATION, OR EQUIVALENT SYSTEM AS APPROVED BY LOCAL CODE OFFICIALS.
- DAMAGED BUILDING COMPONENTS (CEILING GRID, CEILING TILES, WALL CEILINGS, LIGHT FIXTURES, ETC.) SHALL BE REPLACED TO AT LEAST THE QUALITY OF THE DAMAGED ITEM OR SURROUNDING AREA.
- THESE DRAWINGS ARE DIAGRAMMATIC IN NATURE AND DO NOT NECESSARILY REFLECT ALL EXISTING CONDITIONS OR ACTUAL ROUTING. CONTRACTOR SHALL HAVE LATITUDE TO ADJUST ROUTING AS REQUIRED WHILE REMAINING CODE COMPLIANT. ENGINEER SHALL REVIEW ANY MAJOR DEVIATIONS FROM PLAN IF REQUIRED BY AHJ.
- CONTROLS:
A. PROVIDE NEW THERMOSTATS WHERE SHOWN ON PLANS. COORDINATE WITH LIGHT SWITCHES AND WITH ARCHITECT.
B. INTERLOCK EXHAUST FANS WITH ASSOCIATED LIGHT SWITCH.

PACKAGED GAS/ELECTRIC ROOFTOP UNIT SCHEDULE

MARK	SUPPLY AIRFLOW	DESIGN OUTSIDE AIRFLOW	ELECTRICAL DATA					COOLING					HEATING			FAN		MAKE/MODEL	ACCESSORIES
			V/Ø	MCA	MOCP	EDB/EWB	AMBIENT	TOTAL CAP.	SENSIBLE CAP.	COIL LDB	MIN SEER	CAPACITY IN/OUT (MBH)	EDB/LDB	AFUE	SUPPLY FAN HP	EXT. S.P. (IN WG)			
RTU-9	2000 CFM	---	208/3	34	45	80/67	95°F	60.0	48.0	55 °F	14	115/90	65/90 °F	80%	1.0	1/2	CARRIER: 48HC	1 THRU 15	
RTU-10	2000 CFM	---	208/3	34	45	80/67	95°F	60.0	48.0	55 °F	14	115/90	65/90 °F	80%	1.0	1/2	CARRIER: 48HC	1 THRU 15	

ACCESSORIES:
 1. MANUAL OA DAMPER AND BAROMETRIC RELIEF DAMPER.
 2. INSULATED FACTORY ROOF CURB, 14" MIN. PROVIDE EARLY TO JOB SITE.
 3. 7-DAY PROGRAMMABLE THERMOSTAT, AUTOCHANGEOVER
 4. 2 SETS OF FILTERS. REPLACE FILTERS AFTER CONSTRUCTION, BEFORE BUILDING TURNOVER.
 5. SINGLE POINT POWER CONNECTION THRU BASE OF UNIT.
 6. INSULATE UNDERSIDE OF RTU FOR SOUND ATTENUATION.
 7. ANTI-SHORTCYCLE TIMER.
 8. ACCESSORIES FOR LOW AMBIENT OPERATION.
 9. STARTER BY MFR, DISCONNECT BY EC.
 10. HINGED ACCESS PANELS.
 11. UNITS SHALL MEET ASHRAE 90.1 MIN.
 12. SMOKE DETECTOR PROVIDED AND INSTALLED BY MECHANICAL CONTRACTOR.
 13. PROVIDE UNIT SPECIFIED OR TRANE, DAIKIN, LENOX, JCI/YORK OR APPROVED EQUAL.
 14. PROVIDE GAS PRESSURE REGULATORS WITH BAROMETRIC RELIEF.
 15. PROVIDE ENTHALPY ECONOMIZER

HVAC LEGEND

SYMBOL	ABBREV.	DESCRIPTION
EF-1		EQUIPMENT DESIGNATION (EF-1)
		SUPPLY AIR DISTRIBUTION DEVICE
		RETURN/EXHAUST AIR DEVICE
		DUCTWORK (POSITIVE PRESSURE)
		DUCTWORK (NEGATIVE PRESSURE)
18x12		DUCT SIZE IN INCHES (RECTANGULAR EXAMPLE)
10"Ø		DUCT SIZE IN INCHES (ROUND EXAMPLE)
	EF-1	THERMOSTAT (EQUIPMENT CONTROLLED)
		DUCT MOUNTED SMOKE DETECTOR
FD	FD	FIRE DAMPER
	2	RETURN AIR OPENING (SQUARE FEET)
		DUCT TRANSITION
	MVD	MANUAL VOLUME DAMPER
		LINED DUCTWORK
		EQUIPMENT/PIPING ON ROOF
		EQUIPMENT/PIPING UNDER ROOF
	EF	EXHAUST FAN
	SF	SUPPLY FAN
	WL	WALL MOUNTED LOUVER/DAMPER
	RTU	ROOF TOP UNIT
	T.T.S.	TIGHT TO UNDERSIDE OF STRUCTURE
	B.O.	BY OTHERS
	U.N.O.	UNLESS NOTED OTHERWISE
	VTR	VENT THRU ROOF
	A.F.F.	ABOVE FINISHED FLOOR
	OA	OUTSIDE AIR
	MC	MECHANICAL CONTRACTOR
	EC	ELECTRICAL CONTRACTOR
	MFR	MANUFACTURER
	MTD	MOUNTED

FAN SCHEDULE

Ceiling Exhaust Fan												MARK: EF-1,2
Qty	Greenheck Model	Volume (CFM)	External SP Total SP (in wg)	FRPM	Max Sound	Weight (Lb.)	Motor Information					
							Size (hp)	V/C/P	Encl:	Motor RPM	Windings	FLA
2	SP-A200	70	0.5 0.5	770	42 dB	22	28W	115/60/1	OP	900	1	NA

OPTIONS AND ACCESSORIES

UL/cUL 507 Listed - Electric Fan
 Solid State Speed Control
 Wall Cap, Paintable
 Designer Grille
 Round Duct Connector
 Polypropylene Wheel Material
 Energy Star Rated

AIR DISTRIBUTION DEVICE SCHEDULE

MARK	TYPE OF SERVICE	FACE SIZE	NECK SIZE	MAX ROOM NC	MAX SP (IN WG)	INTEGRAL DAMPER	BASIS OF DESIGN
A	SA	24"x24"	SEE PLANS	35	0.10	Y	TITUS: TMSA
B	RA	24"x24"	SEE PLANS	35	0.10	N	TITUS: 50F

① RUN OUT SIZE SHALL BE EQUAL TO NECK SIZE UNLESS NOTED OTHERWISE ON DRAWINGS.
 ② FINISH FOR ALL DEVICES SHALL BE NO. 26 WHITE, UNLESS OTHERWISE INDICATED ON ARCHITECTURAL DRAWINGS
 ③ IN GENERAL, ADD 2" IN BOTH DIMENSIONS ON FACE SIZE FOR BORDER.
 ④ MFR SHALL BE AS ABOVE OR BY PRICE, KRUEGER, ANEMOSTAT, TUTTLE & BAILEY



AS BUILT


2660 East Chase Lane, Suite 200
 Montgomery, AL 36117
 T 334-271-3200
 G.M.C.N.E.T.W.O.R.K..C.O.M

ISSUE	DATE
95% REVIEW	05.30.19
PERMIT SET	10.11.19
DESIGNED BY:	
DRAWN BY:	
CHECKED BY:	

THE EXCHANGE AT HOMEPLACE
 PRATTVILLE, AL
 GMC PROJECT#AMGM180037




Schedules, Specs, & Details - Mechanical
M3.0
 sheet of

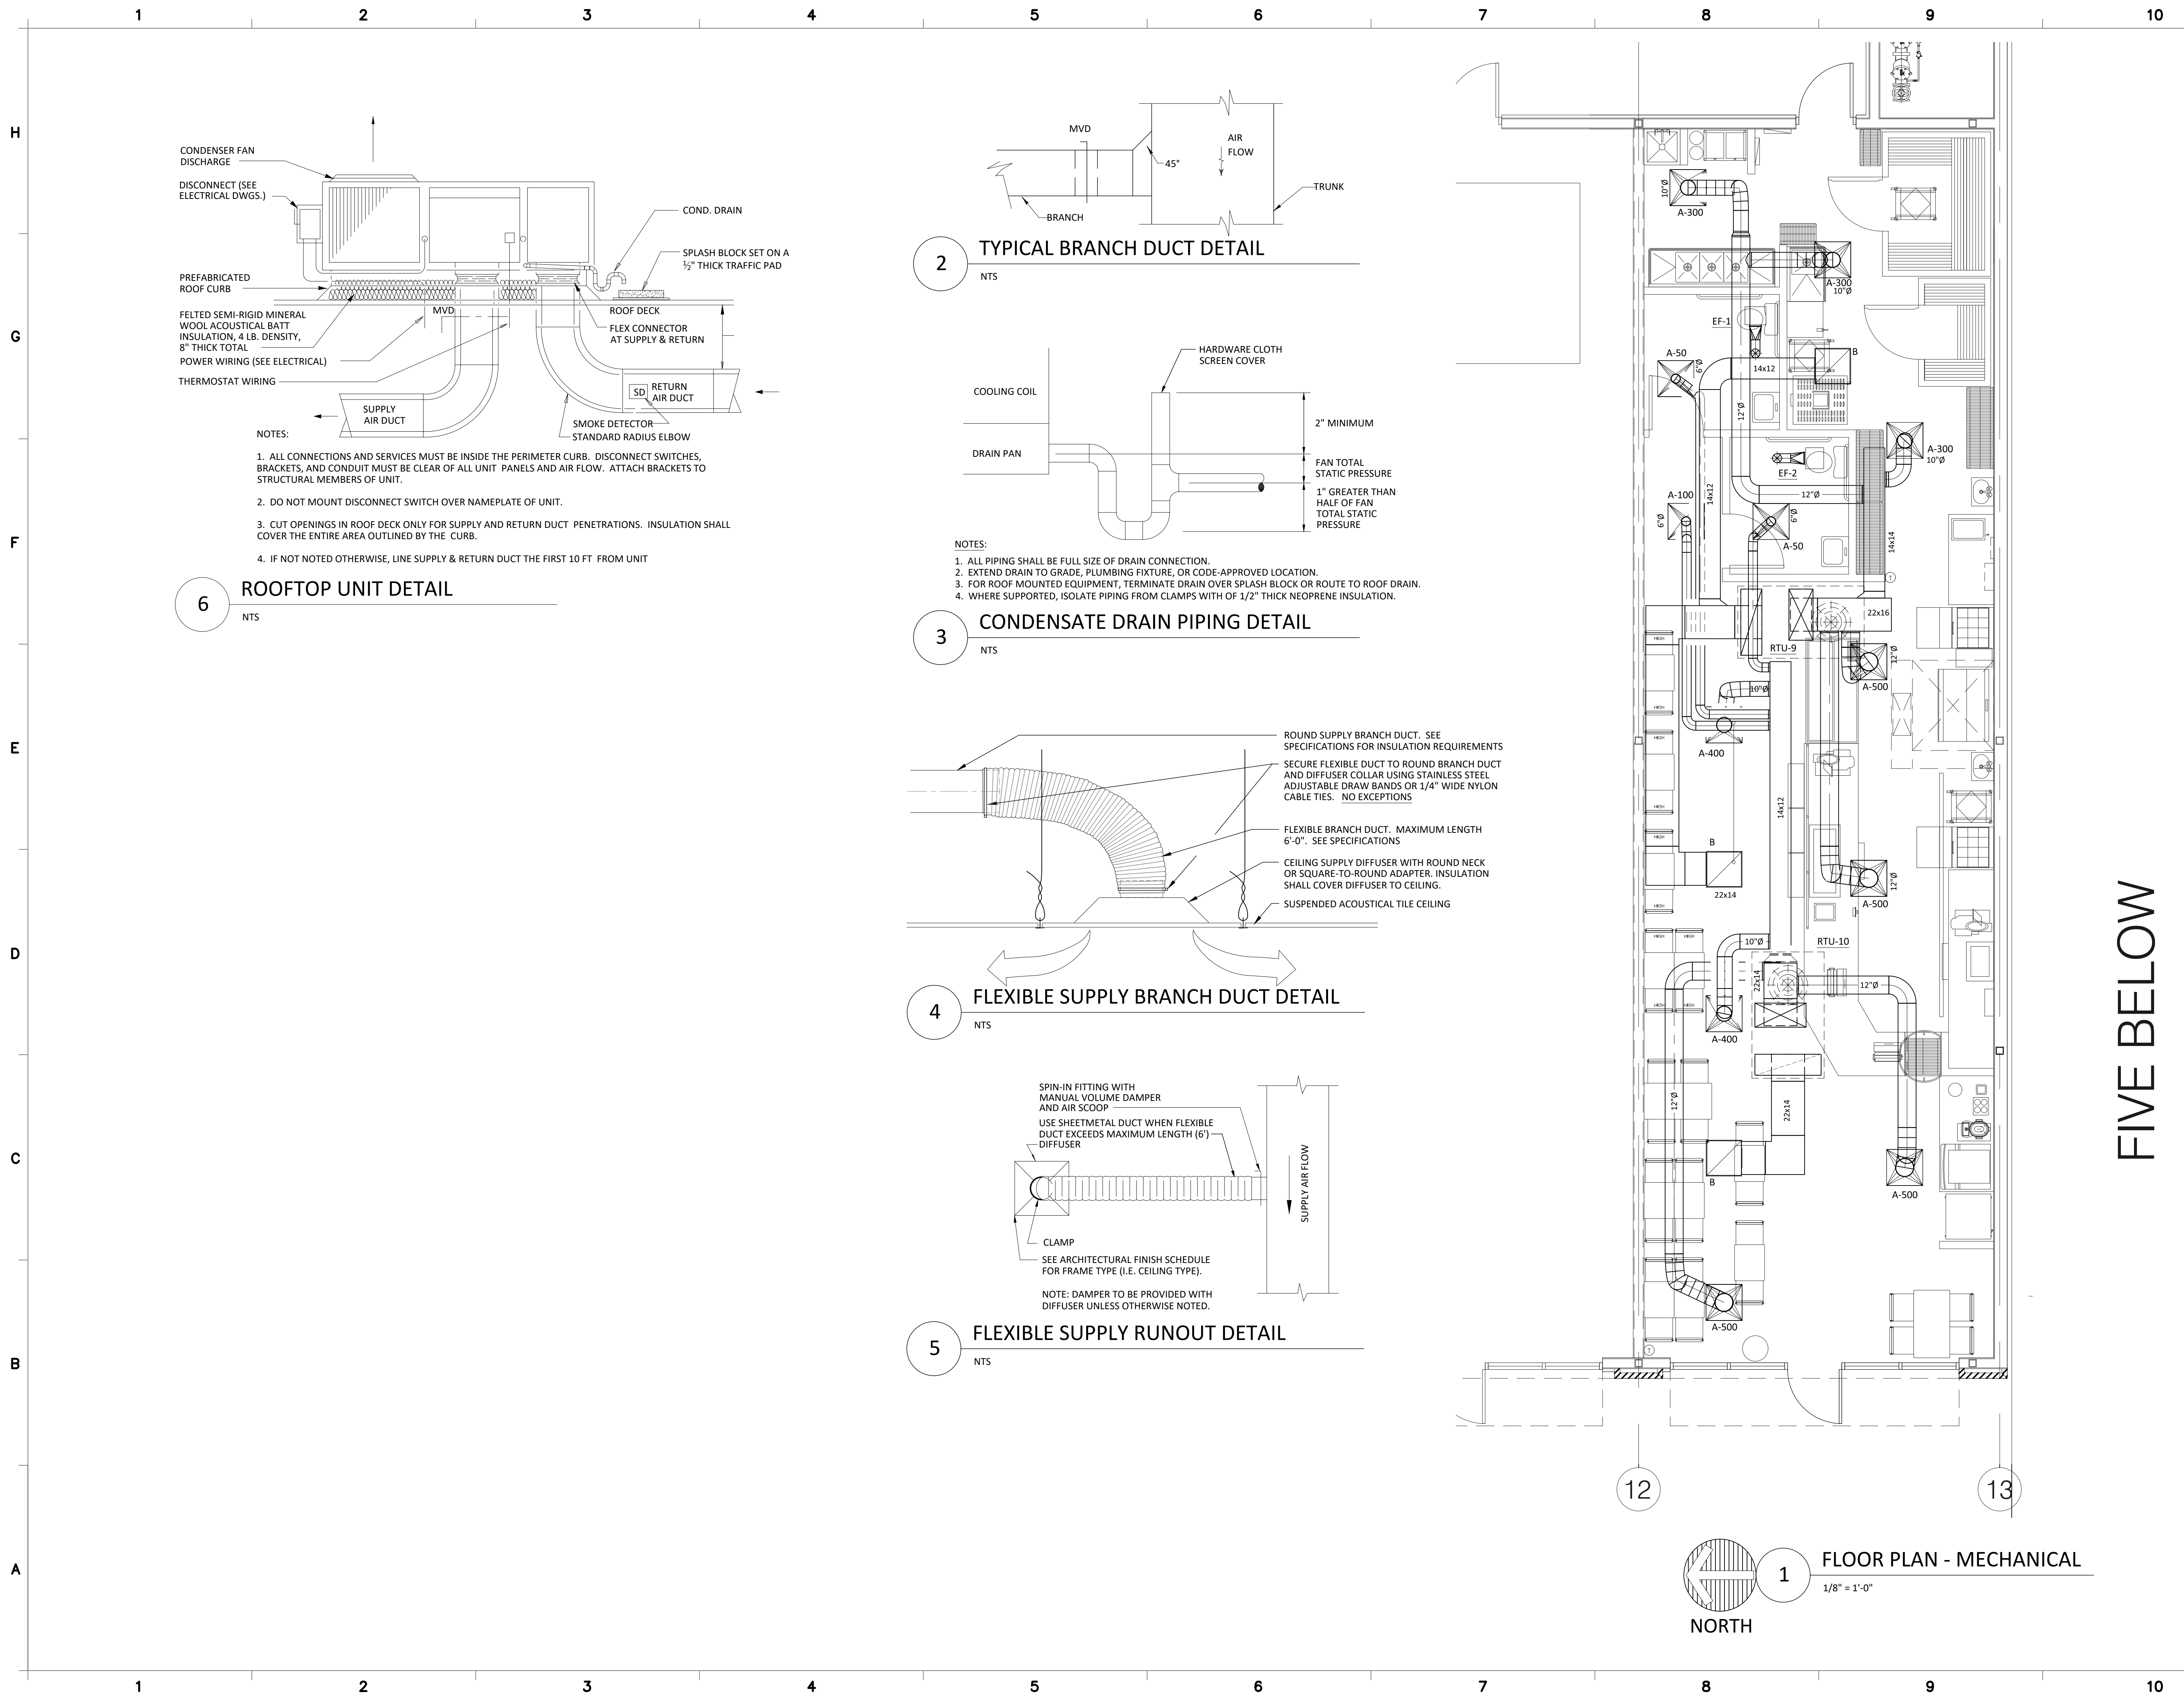

6 ROOFTOP UNIT DETAIL
NTS


- NOTES:
1. ALL CONNECTIONS AND SERVICES MUST BE INSIDE THE PERIMETER CURB. DISCONNECT SWITCHES, BRACKETS, AND CONDUIT MUST BE CLEAR OF ALL UNIT PANELS AND AIR FLOW. ATTACH BRACKETS TO STRUCTURAL MEMBERS OF UNIT.
 2. DO NOT MOUNT DISCONNECT SWITCH OVER NAMEPLATE OF UNIT.
 3. CUT OPENINGS IN ROOF DECK ONLY FOR SUPPLY AND RETURN DUCT PENETRATIONS. INSULATION SHALL COVER THE ENTIRE AREA OUTLINED BY THE CURB.
 4. IF NOT NOTED OTHERWISE, LINE SUPPLY & RETURN DUCT THE FIRST 10 FT FROM UNIT

2 TYPICAL BRANCH DUCT DETAIL
NTS

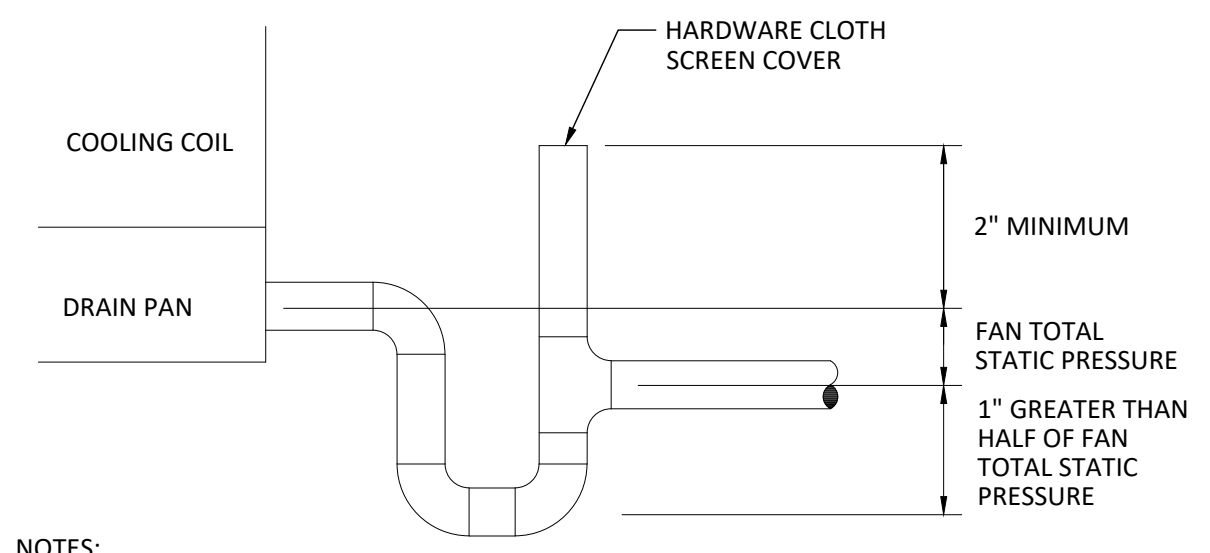


- NOTES:
1. ALL PIPING SHALL BE FULL SIZE OF DRAIN CONNECTION.
 2. EXTEND DRAIN TO GRADE, PLUMBING FIXTURE, OR CODE-APPROVED LOCATION.
 3. FOR ROOF MOUNTED EQUIPMENT, TERMINATE DRAIN OVER SPLASH BLOCK OR ROUTE TO ROOF DRAIN.
 4. WHERE SUPPORTED, ISOLATE PIPING FROM CLAMPS WITH 1/2" THICK NEOPRENE INSULATION.


3 CONDENSATE DRAIN PIPING DETAIL
NTS

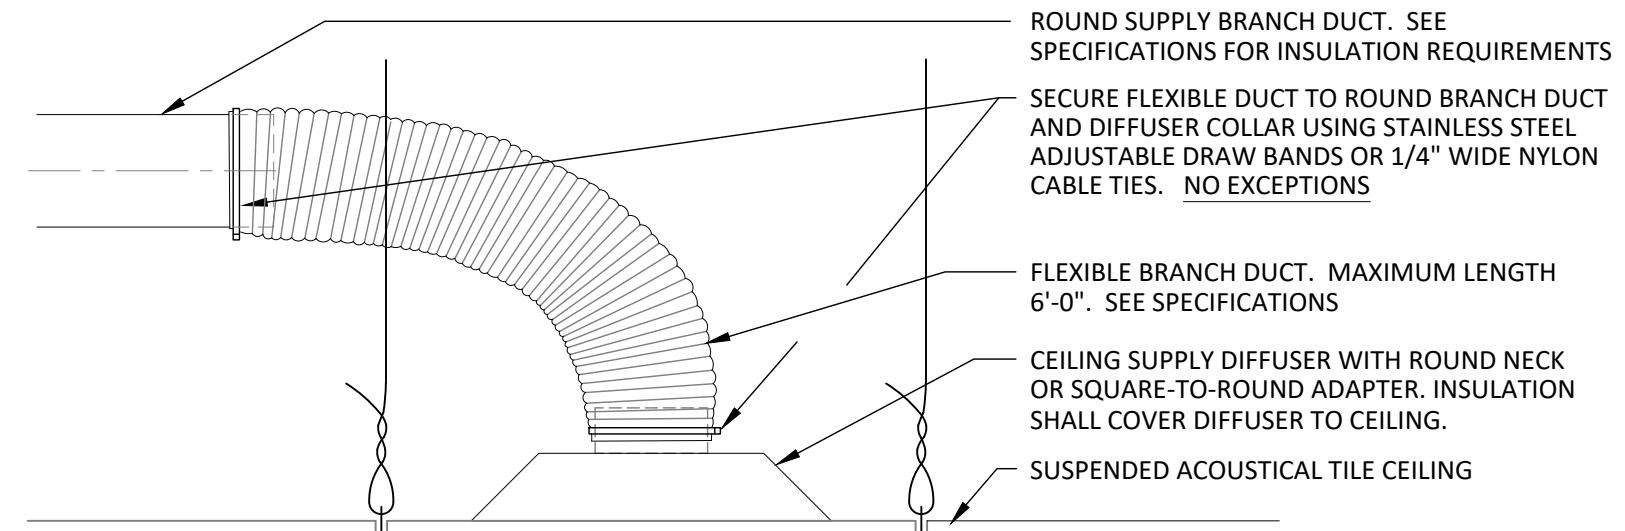

4 FLEXIBLE SUPPLY BRANCH DUCT DETAIL
NTS

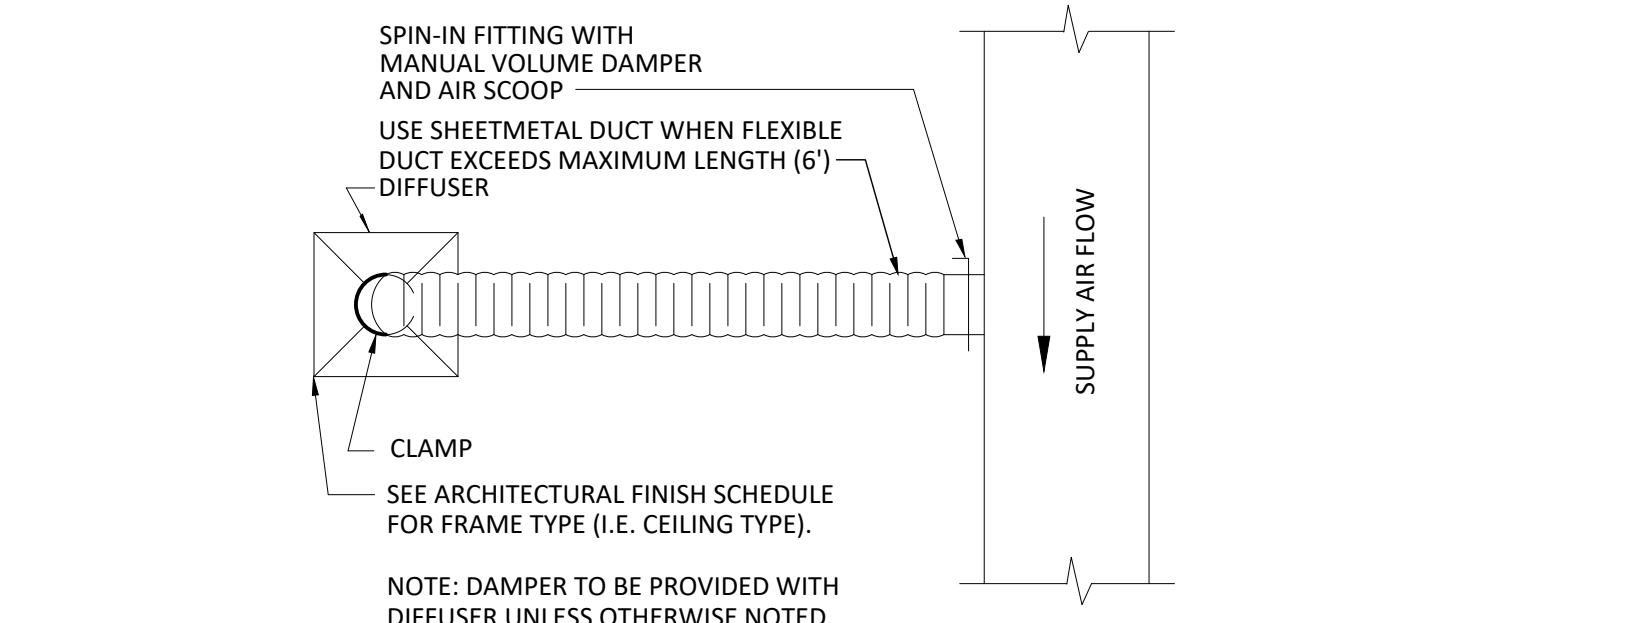

5 FLEXIBLE SUPPLY RUNOUT DETAIL
NTS

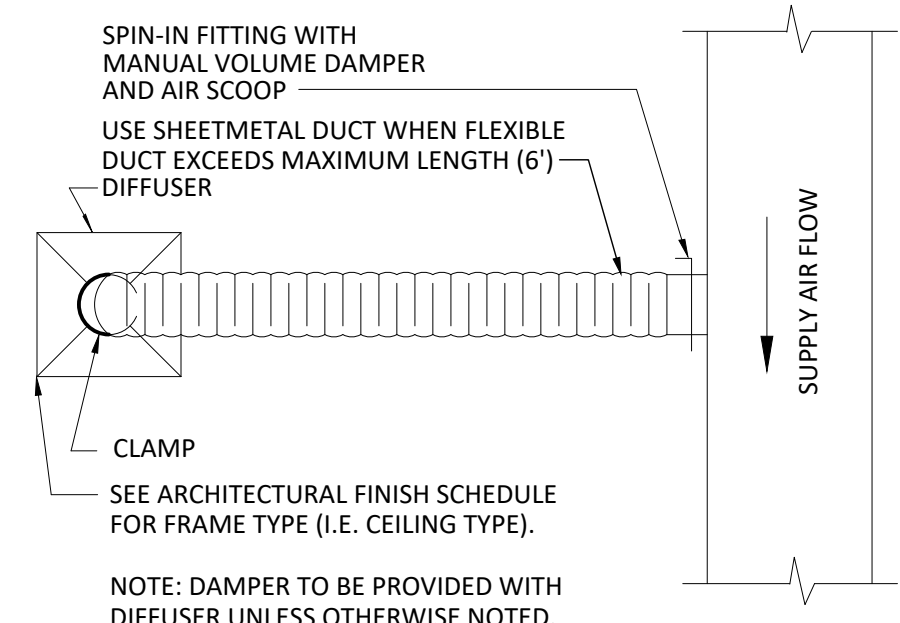

1 FLOOR PLAN - MECHANICAL
1/8" = 1'-0"
NORTH

FIVE BELOW



ASBUILT

2660 East Chase Lane, Suite 200
Montgomery, AL 36117
T 334-271-3200
G.M.C.NETWORK.COM

ISSUE	DATE
95% REVIEW	05.30.19
PERMIT SET	10.11.19
DESIGNED BY:	
DRAWN BY:	
CHECKED BY:	

THE EXCHANGE AT HOMEPPLACE
PRATTVILLE, AL
GMC PROJECT#AMGM180037



Details & Floor
Plan - Mechanical
M3.1
sheet of

FIRE ALARM NOTES AND SPECIFICATIONS:

1. PROVIDE A UL 864 LISTED FIRE ALARM SPRINKLER MONITORING SYSTEM PER IBC 903.4 INCLUDING, BUT NOT EXCLUSIVE TO: UL 864 LISTED SPRINKLER MONITORING PANEL W/DIALER, SPRINKLER TAMPER/FLOW SWITCH CONNECTIONS, RELAYS, DETECTION AND NOTIFICATION DEVICES, ETC. CONFIRM FA SYSTEM REQUIREMENTS FOR BOTH BUILDINGS WITH FIRE MARSHALL PRIOR TO BID.
2. ACCEPTABLE MANUFACTURER'S ARE NOTIFIER, EST, SIMPLEX, OR GAMEWELL.
3. PROVIDE MONITOR AND ALARM CONNECTION TO SPRINKLER FLOW AND TAMPER SWITCHES. COORDINATE WITH FIRE PROTECTION SUBCONTRACTOR FOR LOCATIONS AND QUANTITY.
4. THE DRAWINGS ARE DIAGRAMMATIC. THE DEVICES SHOWN ON THE PLANS ARE FOR GENERAL ARCHITECTURAL AND OWNER COORDINATION AND SHALL BE CONSIDERED A MINIMUM. ADDITIONAL DEVICES MAY NEED TO BE PROVIDED AS REQUIRED AS PART OF THIS CONTRACT. THE CONTRACTOR SHALL PROVIDE ALL COMPONENTS, DEVICES, AND CONNECTIONS NECESSARY TO PROVIDE A COMPLETE AND OPERATING SYSTEM AS REQUIRED BY NFPA AND THE AUTHORITY HAVING JURISDICTION. THE CONTRACTOR SHALL COORDINATE WITH ALL TRADES AND PROVIDE THE NECESSARY DEVICES, CONNECTIONS AND ZONES REQUIRED. PROVIDE QUANTITY OF AUDIO/VISUAL DEVICES AND POWER SUPPLIES AS REQUIRED BY NFPA AND THE AUTHORITY HAVING JURISDICTION. PROVIDE POWER AS REQUIRED FOR POWER SUPPLIES, ETC FROM NEAREST 120/208V PANEL. ALL BREAKERS CONNECTING TO FIRE ALARM SYSTEM EQUIPMENT SHALL BE PROVIDED WITH A LOCK-ON DEVICE.

ELECTRICAL GENERAL NOTES AND SPECIFICATIONS:

1. ALL WORK SHALL COMPLY WITH ALL LOCAL BUILDING CODES, LAWS, REGULATIONS, ORDINANCES AND 2014 NATIONAL ELECTRICAL CODE WITH ALABAMA AMENDMENTS (AS APPLICABLE).
2. THE ELECTRICAL WORK SHALL CONSIST OF ALL LABOR AND MATERIAL TO COMPLETELY INSTALL ALL ELECTRICAL WORKS AS SHOWN ON THESE DRAWINGS.
3. COORDINATE LOCATION OF LIGHT FIXTURES IN AREAS OF MECHANICAL DUCTWORK AND PIPING WITH MECHANICAL CONTRACTOR. RELOCATE LIGHT FIXTURES, WIRING AND CONDUIT IF NECESSARY AS DIRECTED BY THE ARCHITECT/ENGINEER.
4. ALL WORK ASSOCIATED WITH THE SCOPE OF THIS PROJECT INCLUDING EQUIPMENT, ACCESSORIES, DEVICES, SYSTEMS, ETC. SHALL BE COVERED BY A ONE YEAR GUARANTEE WHICH SHALL START AT THE TIME OF FINAL ACCEPTANCE BY THE OWNER. ANY DEFECTS IN PRODUCTS, INSTALLATION, OR WORKMANSHIP SHALL BE CORRECTED AT NO ADDITIONAL CHARGE AND SHALL INCLUDE ANY NECESSARY REPAIRS TO WALLS, FLOORS, MILLWORK, ETC. WHICH SHALL BE REPAIRED BACK TO NEW AND FINISHED CONDITION.
5. THE CONTRACTOR SHALL KEEP A RECORD OF THE CHANGES WHICH ARE IN CONFLICT WITH THESE DRAWINGS AND SPECIFICATIONS. AT THE COMPLETION OF THIS WORK THE CONTRACTOR SHALL SUBMIT "AS BUILT" PRINTS TO THE OWNER.
6. THE DRAWINGS ARE DIAGRAMMATIC AND DO NOT NECESSARILY SHOW THE EXACT ROUTING OR DETAILED FITTINGS. ALL WORK SHALL BE INSTALLED AS A COMPLETE SYSTEM WITH NECESSARY COMPONENTS, FITTINGS, STRAPS, ETC. ALL JUNCTION BOXES AND COMPONENTS SHALL BE INSTALLED SO THAT THEY ARE ACCESSIBLE.
7. REFER TO THE ENTIRE CONTRACTED DRAWING SET AND SPECIFICATIONS FOR GUIDANCE ON DIMENSIONS, CEILING HEIGHTS, DOOR SWINGS, ROOM FINISHES, STRUCTURAL DETAILS, LOCATIONS OF DUCTWORK, PIPING AND STRUCTURAL MEMBERS. INSTALL THE ELECTRICAL SYSTEMS SO AS NOT TO INTERFERE WITH THE INSTALLATION OR FUNCTION OF ANOTHER DISCIPLINES WORK.
8. ALL CONDUIT MUST BE CONCEALED ABOVE THE CEILING OR IN THE WALLS UNLESS OTHERWISE NOTED.
9. COORDINATE RECEPTACLE NEMA TYPE AND VOLTAGE WITH ALL EQUIPMENT.
10. THE CONTRACTOR SHALL INSTALL ALL WORK IN A NEAT AND WORKMANLIKE MANNER AND ACCORDING TO GENERALLY ACCEPTED PRACTICES OF FIRST CLASS WORKMANSHIP.
11. LABEL ALL PANELS, CIRCUITS, SPACES AND SPARES PER NEC 408.4. PROVIDE A NEW DIRECTORY FOR ALL PANELS.
12. ALL RECESSED LIGHTING FIXTURES SHALL BE FASTENED TO STRUCTURE OR GRID PER NEC 410.
13. ALL PENETRATIONS THROUGH FIRE WALL AND FLOORS SHALL BE FIRE STOPPED WITH 3M FIRE BARRIER OR EQUAL PRODUCT MEETING UL 1479 OR ASTM E814 FIRE RATING IN ACCORDANCE WITH NEC ARTICLE 300.21.
14. MOUNTING HEIGHTS FOR DEVICES ARE TO BE MEASURED TO THE DEVICE CENTERLINE.
15. ALL BRANCH CIRCUITS SHALL BE WIRED 1/2" C, 2#12, 1#12G MINIMUM, UNLESS OTHERWISE NOTED ON THE PLANS. ALL HOMERUNS SHALL BE A MINIMUM 3/4" CONDUIT.
16. UNLESS NOTED OTHERWISE, MULTI-WIRE BRANCH CIRCUITS MAY BE USED WHERE APPLICABLE FOR THE SAME LOAD TYPE UTILIZING A COMMON NEUTRAL FOR UP TO THREE (3) CIRCUITS OF A DIFFERENT PHASE EXCEPT FOR CIRCUITS RATED MORE THAN 20 AMPS, MULTI-PHASE CIRCUITS, CIRCUITS DEDICATED TO COMPUTER EQUIPMENT AND CIRCUITS SERVING ONLY ONE OUTLET OR DEVICE. OVERCURRENT PROTECTION SHALL COMPLY WITH NEC 210.4.
17. PROVIDE A SEPARATE GREEN, INSULATED, #12AWG EQUIPMENT GROUNDING CONDUCTOR ROUTED WITH THE BRANCH CIRCUIT HOMERUN CONDUCTORS. PROVIDE GROUND THROUGH ENTIRE CONDUIT RUN TO THE LAST DEVICE. ALL EQUIPMENT SHALL BE GROUNDED AT THE PANEL WHICH FEEDS THE EQUIPMENT. PROVIDE GROUNDING PER NEC 250.
18. ALL SWITCHES FOR LIGHTS, FANS, ETC., WHICH ARE SHOWN TO BE MOUNTED IN THE SAME GENERAL AREA, SHALL SHARE A MULTI-GANG COVER PLATE AS REQUIRED.
19. ARMORED CABLE MAY BE USED IN WALLS AND MILLWORK ONLY (WHERE ACCEPTABLE BY AHJ) AND MUST BE MC TYPE (WITH GROUND). ALL CONDUIT TO AND ABOVE THE PLENUM SHALL BE EMT. ALL HOMERUNS SHALL BE IN CONDUIT RAN FROM THE FIRST DEVICE OR LIGHT FIXTURE TO THE PANEL.
20. THE CONTRACTOR SHALL REFER TO ARCHITECTURAL PLANS FOR EXACT LOCATIONS OF OUTLETS, LIGHT FIXTURES, AND PARTITIONS. FINISHES FOR DEVICES AND COVERPLATES SHALL BE AS SELECTED BY ARCHITECT.
21. LIGHT FIXTURES SHALL BE AS SCHEDULED, WITH ONLY PRE-APPROVED EQUAL FIXTURES ACCEPTABLE.
22. FLUORESCENT BALLASTS SHALL BE ELECTRONIC WITH A MAXIMUM OF 10% THD AND AS MANUFACTURED BY ADVANCE, OSRAM/SYLVANIA, GE/MAGNETEK, OR MOTOROLA.
23. RACEWAYS: RIGID GALVANIZED STEEL FOR ALL EXPOSED LOCATIONS WHERE SUBJECT TO DAMAGE OR THE ELEMENTS; EMT FOR CONCEALED, DRY LOCATIONS UNLESS NOTED OTHERWISE; SCHEDULE 40 PVC BELOW GRADE.
24. ALL CONDUCTORS SHALL BE COPPER UNLESS NOTED OTHERWISE ON PLANS. CONDUCTORS FOR SIZES NO. 10 AND SMALLER SHALL BE TYPE "THHN" OR "THHN/THWN". CONDUCTORS FOR SIZES NO. 8 AND LARGER SHALL BE TYPE "XHHW". SOLID CONDUCTORS TERMINATING IN A BREAKER OR DEVICE SHALL BE UTILIZED FOR WIRE SIZE NO. 12. MINIMUM WIRE SIZE SHALL BE NO. 12.
25. ALL BOXES SHALL BE PRESSED STEEL, SINGLE PIECE (NON-GANGABLE) TYPE. PROVIDE WITH STAINLESS STEEL COVER PLATES.
26. ALL COVER PLATES FOR DEVICES AND JUNCTION BOXES SHALL HAVE CIRCUIT NUMBERS LABELED WITH INDELIBLE INK MARKER. DEVICE COVERS SHALL BE LABELED ON THE BACK, JUNCTION BOX COVERS SHALL BE LABELED ON THE FRONT.
27. RECEPTACLES SHALL BE 120 VOLT, 20A, WITH PARTS NUMBERS AS LISTED BY HUBBELL OR EQUAL BY ARROWHART, P&S, OR LEVITON. COLOR FOR DEVICES AND COVER PLATES SHALL BE AS SELECTED BY THE ARCHITECT.

SINGLE RECEPTACLE	#HBL5361X
DUPLEX RECEPTACLE	#HBL5352X
GFCI RECEPTACLE	#GF5352X
28. SWITCHES SHALL BE 120/277V, 20A, WITH PARTS NUMBERS AS LISTED BY HUBBELL OR EQUAL BY ARROWHART, P&S, OR EAGLE. COLOR FOR DEVICES AND COVER PLATES SHALL BE AS SELECTED BY THE ARCHITECT.

SINGLE POLE	#HBL1221X
THREE WAY	#HBL1223X
FOUR WAY	#HBL1224X

 (ADD "L" SUFFIX FOR KEYED LOCKING TYPE)
29. PANELBOARDS, MOTOR STARTERS, SAFETY SWITCHES (HEAVY DUTY), ETC. SHALL BE AS MANUFACTURED BY GENERAL ELECTRIC, SQUARE D, SIEMENS, OR CUTLER HAMMER. ALL BREAKERS SHALL BE "BOLT-ON" TYPE.
30. FUSED DISCONNECT SWITCHES SHALL HAVE REJECTION TYPE FUSE CLIPS WITH DUAL ELEMENT CURRENT LIMITING FUSES AT RATINGS SHOWN ON PLANS. THE UL SHORT CIRCUIT RATING SHALL BE 200,000 AMPS RMS SYS. USE CLASS J FUSES FOR 1 TO 600 AMPS AND CLASS L FUSES ABOVE 600 AMPS.
31. FOR EQUIPMENT THAT IS TO BE WIRED BY ELECTRICAL CONTRACTOR AND FURNISHED BY OTHERS, ELECTRICAL CONTRACTOR SHALL REVIEW ALL SPECIFICATION SECTIONS, EQUIPMENT SCHEDULES, AND/OR DETAILS THROUGHOUT DOCUMENTS THAT PERTAIN TO THIS EQUIPMENT AND INCLUDE ALL WIRING AND DEVICES REFERENCED IN THEIR BIDS. ELECTRICAL CONTRACTOR SHALL COORDINATE EXACT LOCATION OF THIS EQUIPMENT WITH RESPECTIVE CONTRACTOR PRIOR TO ROUGH-IN.
32. CONTRACTOR SHALL INSTALL CONDUCTORS SIZED FOR VOLTAGE DROP BASED ON TOTAL DEVELOPED LENGTH OF CIRCUIT. VOLTAGE DROP SHALL NOT EXCEED 3%.
33. DO NOT MOUNT DEVICES BACK TO BACK. OFFSET ONE SIDE TO THE NEXT STUD SPACE.
34. ALL CEILING MOUNTED RECEPTACLES AND VOICE/DATA OR CATV OUTLETS ARE NOT TO BE SUPPORTED BY THE CEILING TILES. THE OUTLET BOXES SHOULD HAVE VERTICAL AND HORIZONTAL SUPPORT FROM THE STRUCTURE ABOVE.
35. ALL MATERIALS WITHIN PLENUMS ARE REQUIRED TO BE NONCOMBUSTIBLE OR SHALL HAVE A FLAME SPREAD INDEX OF NOT MORE THAN 25 AND A SMOKE DEVELOPED INDEX SPEED OF NOT MORE THAN 50 AS DETERMINED IN ACCORDANCE WITH ASTM E84.
36. COORDINATE SETTINGS OF OCCUPANCY SENSORS AND TIMECLOCKS WITH OWNER PRIOR TO PROJECT COMPLETION.

ELECTRICAL LEGEND

SYMBOL	DESCRIPTION	MOUNTING HEIGHT ON CENTER (COORD. WITH ARCH.)
	FLUORESCENT OR LED LIGHT FIXTURE	
	EMERGENCY EGRESS LIGHT FIXTURE	
	EXIT SIGN (PROVIDE FACES AND ARROWS AS SHOWN)	
	CONDUIT RUN CONCEALED IN WALL OR CEILING (IF POSSIBLE). IF CONDUIT IS REQUIRED TO BE EXPOSED, ROUTE PARALLEL/PERPENDICULAR TO WALLS AND STRUCTURE.	
	CONDUIT RUN CONCEALED IN THE FLOOR, UNDERGROUND, OR UNDER THE ELEVATED SLAB	
	CIRCUITS HOMERUN TO THE PANEL	
	NUMBER OF CONDUCTORS (GROUND NOT SHOWN)	
	FLEXIBLE CONDUIT OR CORD	
	PLYWOOD BACKBOARD	
	DUPLEX RECEPTACLE - WALL MOUNTED	18" UNO
	ISOLATED GROUND DUPLEX RECEPTACLE - WALL MOUNTED	18" UNO
	GFCI DUPLEX RECEPTACLE OR RECEPTACLE CONNECTED TO GFCI BREAKER (IF SHOWN IN PB SCHEDS) - WALL MTD	18" UNO
	OUTLET ABOVE THE COUNTER OR OUTLET MOUNTED ABOVE NORMAL MOUNTING HEIGHT	6" AC UNO/AS NOTED
	QUADRIPOLE RECEPTACLE - WALL MOUNTED	18" UNO
	SWITCHED DUPLEX RECEPTACLE. SWITCH THE BOTTOM HALF.	18"
	SPECIAL AMP/VOLT RECEPTACLE - WALL MOUNTED - NEMA TYPE AS INDICATED ON PLANS.	18" UNO
	FLOOR MOUNTED RECEPTACLE	
	VOICE AND DATA OUTLET - WALL MOUNTED	18" UNO
	TELEVISION CABLE OUTLET - WALL MOUNTED UNLESS NOTED OTHERWISE	18" UNO
	FLOOR MOUNTED VOICE AND DATA OUTLET	
	JUNCTION BOX	
	JUNCTION BOX - WALL MOUNTED	
	SPST SWITCH - WALL MOUNTED	48"
	3-WAY SWITCH - WALL MOUNTED	48"
	4-WAY SWITCH - WALL MOUNTED	48"
	DIMMER SWITCH - WALL MOUNTED - PROVIDE WATTAGE/TYPE TO MATCH FIXTURE DIMMING DRIVER/BALLAST TYPE	48"
	KEYED SWITCH - WALL MOUNTED	48"
	TIMER SWITCH - WALL MOUNTED - WATTSTOPPER TS-400 OR EQUAL	48"
	ADJUSTABLE FAN SPEED CONTROLLER - WALL MOUNTED	
	WALL MOUNTED OCCUPANCY SENSOR (SINGLE RELAY UNO) - WATTSTOPPER PW-100 OR EQUAL	48"
	WALL MOUNTED OCCUPANCY SENSOR AND 0-10V DIMMER - LSI WS10-OS-XX OR EQUAL	48"
	CEILING MOUNTED OCCUPANCY SENSOR - WATTSTOPPER DT-300 OR EQUAL	
	OCCUPANCY SENSOR POWER PACK	
	120/208 VOLT PANELBOARD OR DISTRIBUTION PANEL - FLUSH OR SURFACE MOUNTED AS INDICATED IN SCHEDULE	
	DISCONNECT (FRAME AND POLES TO MATCH OCP OR AS NOTED)	
	FIRE ALARM PULL STATION - WALL MOUNTED	48"
	FIRE ALARM ADA APPROVED AUDIO/VISUAL (110cd)	80"
	FIRE ALARM ADA APPROVED VISUAL ONLY (110cd)	80"
	FIRE ALARM PULL STATION AT 48" AND AUDIO/VISUAL AT 80" AFF	
	SMOKE DETECTOR - CEILING MOUNTED	
	DUCT MOUNTED SMOKE DETECTOR	
	HEAT DETECTOR - CEILING MOUNTED, WALL MOUNTED	
	PROVIDE FIRE ALARM CONNECTION TO SPRINKLER FLOW AND TAMPER SWITCHES/VALVES. COORDINATE QUANTITY AND LOCATIONS WITH SPRINKLER CONTRACTOR.	
AC	ABOVE COUNTER	
AFF	ABOVE FINISHED FLOOR	
AFG	ABOVE FINISHED GRADE	
EC / MC / PC	ELECTRICAL CONTRACTOR / MECHANICAL CONTRACTOR / PLUMBING CONTRACTOR	
NL	NIGHT LIGHT (ON 24 HRS A DAY)	
UNO	UNLESS NOTED OTHERWISE	
XFMR	TRANSFORMER	
WP	WEATHER PROOF	



AS BUILT




2660 East Chose Lane, Suite 200
 Montgomery, AL 36117
 T 334-271-3200
 G M C N E T W O R K . C O M

ISSUE	DATE
95% REVIEW	05.30.19
PERMIT SET	10.11.19
DESIGNED BY:	CG
DRAWN BY:	CG
CHECKED BY:	JBH

THE EXCHANGE AT HOMEPLACE
 PRATTVILLE, AL
 GMC PROJECT#AMGM180037



Electrical General Notes and Legend
E0.1
 sheet of

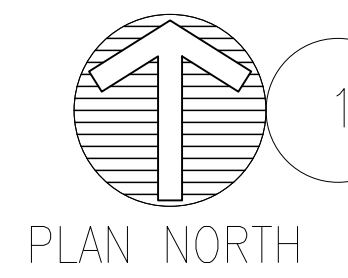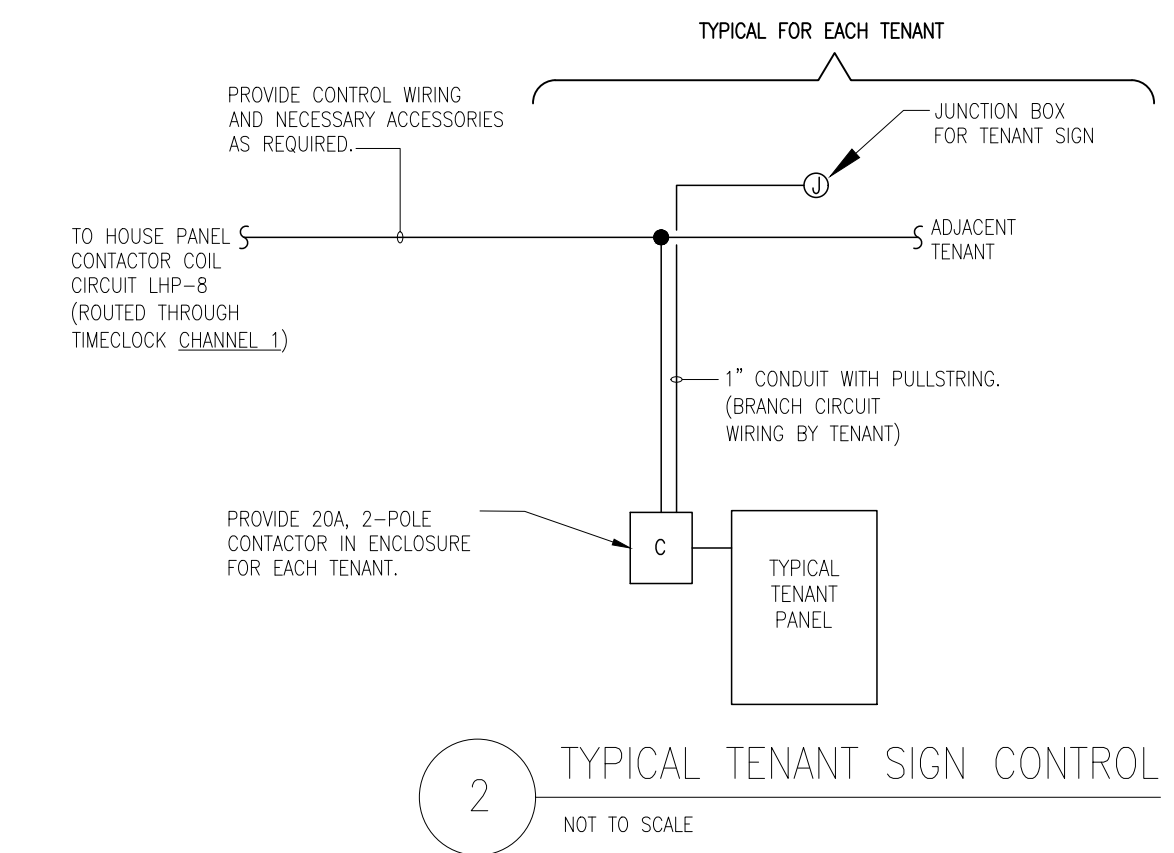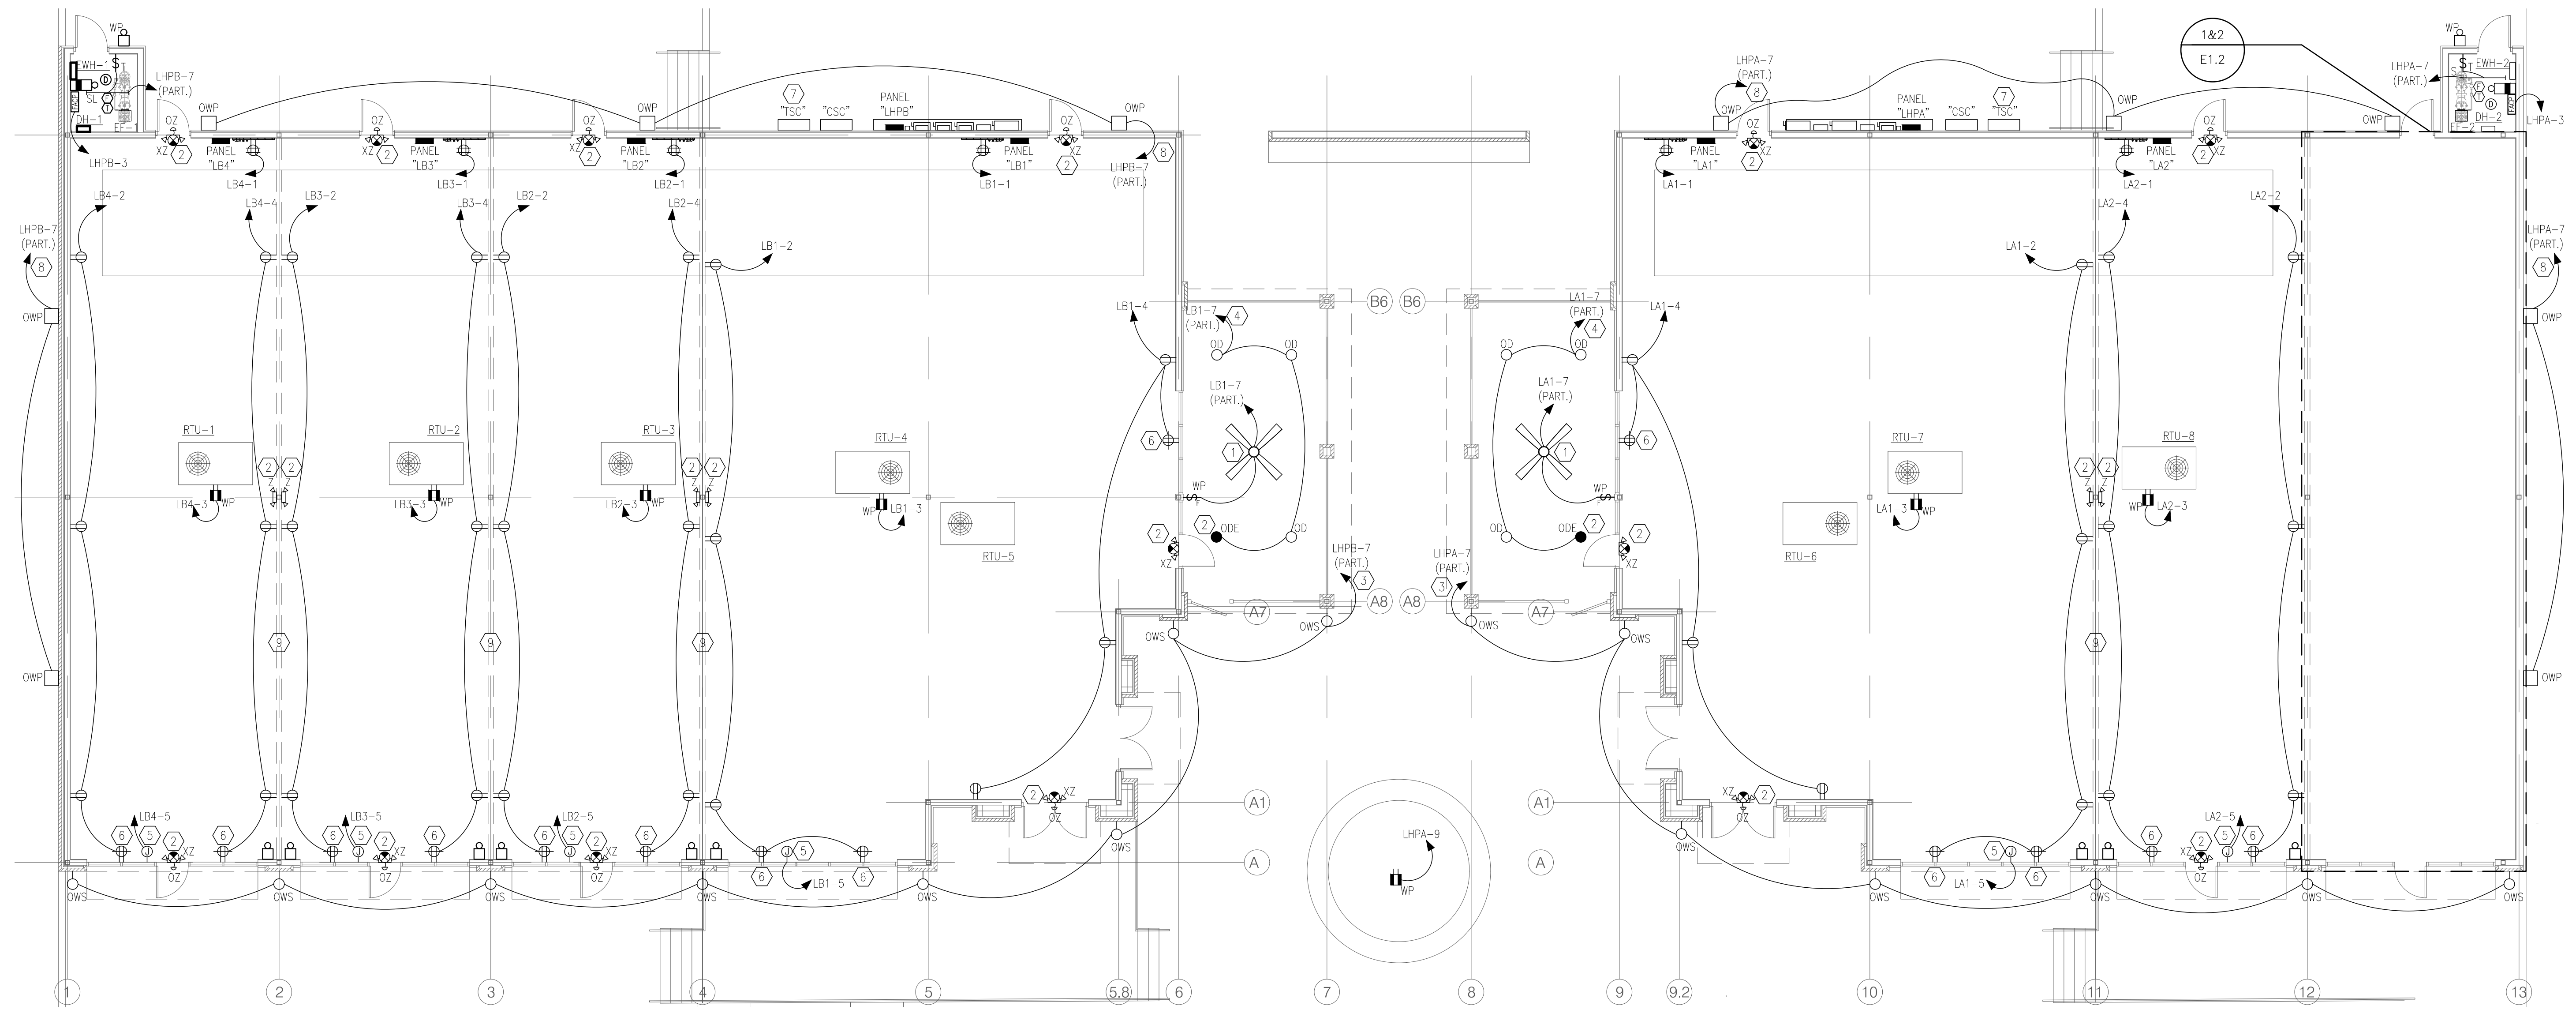

ELECTRICAL FLOOR PLAN - POWER AND LIGHTING

1/8" = 1'-0"

GENERAL NOTES (APPLY TO THIS SHEET ONLY):

- DO NOT MOUNT DEVICES BACK TO BACK. OFFSET ONE TO THE NEXT STUD SPACE.
- COORDINATE/CONFIRM EXACT LOCATION AND MOUNTING HEIGHTS OF ALL LIGHT FIXTURES SHOWN ON THIS SHEET WITH ARCHITECT PRIOR TO ROUGH-IN.
- COORDINATE EXACT DESIRED SWITCHING ARRANGEMENT AND SWITCH LOCATIONS WITH OWNER/TENANTS PRIOR TO ROUGH-IN.

KEYNOTES (APPLY TO THIS SHEET ONLY):

- OUTDOOR RATED CEILING FAN WITHOUT LIGHT KIT.
- CONNECT TO UNSWITCHED "HOT" FROM LIGHTING CIRCUIT FEEDING THIS AREA.
- ROUTE THROUGH HOUSE TIMECLOCK CHANNEL 2.
- ROUTE THROUGH TIMECLOCK CHANNEL 1 OF ASSOCIATED TENANT SPACE. SEE E2.1 & E2.2 FOR MORE INFO.
- FOR TENANT SIGN, COORDINATE EXACT LOCATION AND POWER REQUIREMENTS WITH SIGN PROVIDER PRIOR TO ROUGH-IN. SEE DETAIL 2 ON THIS SHEET FOR MORE INFORMATION ON CONTROLS.
- WALL OR CEILING MOUNT RECEPTACLE CENTERED ABOVE WINDOW IN ACCORDANCE WITH NEC 210.62.
- PROVIDE GFCI QUADRUPLX RECEPTACLE MOUNTED IN TELEPHONE SERVICE CABINET FED FROM DEDICATED CIRCUIT LHPB-1 FOR BUILDING B AND LHPA-1 FOR BUILDING A VIA 2#12, 1#12G, 3/4\"C.
- ROUTE THROUGH HOUSE TIMECLOCK CHANNEL 3.
- INSTALL DEVICES SHOWN ON DASHED WALLS ONLY IF WALLS ARE INSTALLED.

LIGHTING FIXTURE SCHEDULE

FIXTURE ID	DESCRIPTION	LAMP TYPE	MANUFACTURER/MODEL	NOTES
OWP	LED WALL PACK FIXTURE WITH TYPE IV_F4 DISTRIBUTION. FINISH TO BE SELECTED BY ARCHITECT.	LED - 125W [4000K]	GE LIGHTING EWNB SERIES OR EQUAL	
OWS	LED EXTERIOR WALL SCONCE TO MATCH SITE STANDARD WALL SCONCE.	LED - 20W [4000K]	MATCH EXISTING BUILDING STANDARD	
OD	4" APERTURE LED DOWNLIGHT WITH 2000 LUMEN OUTPUT, SEMI-SPECULAR REFLECTOR, MEDIUM DISTRIBUTION, WHITE FLANGE, AND ELECTRONIC DRIVER.	LED - 23.5W [4000K]	GOTHAM EVO SERIES OR EQUAL	
ODE	SAME AS "OD" EXCEPT WITH EMERGENCY EGRESS BATTERY PACK.			
OZ	EXTERIOR ARCHITECTURAL EMERGENCY FIXTURE WITH BATTERY.	LED	EVENLITE WLEM SERIES OR EQUAL	
A	2'x4', 3" NOMINAL DEEP, 18 CELL STATIC PARABOLIC LOUVER WITH 3 LAMPS AND ELECTRONIC MAX 10% THD BALLAST.	(3) T8 32W [4100K]	LITHONIA 2PM3N SERIES OR EQUAL	
A2	2'x2', 3" NOMINAL DEEP, 9 CELL STATIC PARABOLIC LOUVER WITH 2 LAMPS AND ELECTRONIC MAX 10% THD BALLAST.	(2) T8 31W [4100K]	LITHONIA 2PM3N SERIES OR EQUAL	
B	2'x4' STATIC LENS FRAME TROFFER WITH PRISMATIC VIRGIN ACRYLIC LENS (0.125" MIN. THICKNESS), FULLY GASKETED HOUSING, 3 LAMPS, AND ELECTRONIC MAX 10% THD BALLAST.	(3) T8 32W [4100K]	LSI WL SERIES OR EQUAL	
SL	4", LED LENSED STRIP FIXTURE WITH SS DRIVE CURRENT AND ELECTRONIC DRIVER.	LED - 30.1W [4000K]	LSI SDL SERIES OR EQUAL	
XZ	COMBO EMERGENCY/EXIT FIXTURE WITH BATTERY, WHITE WITH RED LETTERS, PROVIDE NUMBER OF FACES AND DIRECTIONAL ARROWS AS SHOWN, WALL OR CEILING MOUNT AS REQUIRED.	LED	EVENLITE TLP SERIES OR EQUAL	
Z	2-HEAD EMERGENCY FIXTURE WITH BATTERY.	LED	LSI LEM SERIES OR EQUAL	

LIGHTING FIXTURE SCHEDULE NOTES:

- CONFIRM VOLTAGE WITH DRAWINGS AND COORDINATE/CONFIRM ALL MOUNTING HEIGHTS AND FINISHES WITH ARCHITECT PRIOR TO ORDERING AND INSTALLATION. ARCHITECT TO PROVIDE ALL FINISHES AND MOUNTING HEIGHTS OF WALL MOUNTED FIXTURE TYPES.
- PROVIDE MOUNTING OPTION(S) NECESSARY TO ACCOMMODATE CEILING TYPES SPECIFIED BY ARCHITECTURAL DOCUMENTS FOR ALL RECESSED FIXTURES.
- THE COLOR TEMPERATURE FOR ALL FIXTURE LIGHT SOURCES SHALL BE AS NOTED IN LIGHTING FIXTURE SCHEDULE ABOVE.

HVAC EQUIPMENT ELECTRICAL CONNECTION SCHEDULE

TAG	LOAD	VOLT./~	CIRCUIT DESIGNATION	BREAKER	BRANCH CIRCUIT	NOTE
RTU-1	34.0 MCA	208/3	SEE PANEL SCHEDULES ON E3.1	45/3	3#6 1#10G, 1-1/4\"C.	WP DISCONNECT BY EC
RTU-2	34.0 MCA	208/3	SEE PANEL SCHEDULES ON E3.1	45/3	3#6 1#10G, 1-1/4\"C.	WP DISCONNECT BY EC
RTU-3	34.0 MCA	208/3	SEE PANEL SCHEDULES ON E3.1	45/3	3#6 1#10G, 1-1/4\"C.	WP DISCONNECT BY EC
RTU-4	57.0 MCA	208/3	SEE PANEL SCHEDULES ON E3.1	70/3	3#4, 1#8G, 1-1/4\"C.	WP DISCONNECT BY EC
RTU-5	57.0 MCA	208/3	SEE PANEL SCHEDULES ON E3.1	70/3	3#4, 1#8G, 1-1/4\"C.	WP DISCONNECT BY EC
RTU-6	57.0 MCA	208/3	SEE PANEL SCHEDULES ON E3.1	70/3	3#4, 1#8G, 1-1/4\"C.	WP DISCONNECT BY EC
RTU-7	57.0 MCA	208/3	SEE PANEL SCHEDULES ON E3.1	70/3	3#4, 1#8G, 1-1/4\"C.	WP DISCONNECT BY EC
RTU-8	34.0 MCA	208/3	SEE PANEL SCHEDULES ON E3.1	45/3	3#6 1#10G, 1-1/4\"C.	WP DISCONNECT BY EC
RTU-9	34.0 MCA	208/3	SEE PANEL SCHEDULES ON E3.1	45/3	3#6 1#10G, 1-1/4\"C.	WP DISCONNECT BY EC
RTU-10	34.0 MCA	208/3	SEE PANEL SCHEDULES ON E3.1	45/3	3#6 1#10G, 1-1/4\"C.	WP DISCONNECT BY EC
EW-1,2	0.5 KW	120/1	LHPB-5; LHPA-5	20/1	2#12 1#12G, 3/4\"C.	DISCONNECT BY EC
DH-1,2	0.92 MCA	120/1	LHPB-11 (PART.); LHPA-11 (PART.)	20/1	2#12 1#12G, 3/4\"C.	DISCONNECT BY EC
EF-1,2	35 W	120/1	LHPB-11 (PART.); LHPA-11 (PART.)	20/1	2#12 1#12G, 3/4\"C.	DISCONNECT BY EC


- CONFIRM EXACT ELEC. REQUIREMENTS AND LOCATIONS OF MC/PC PROVIDED HVAC/PLUMBING EQUIPMENT PRIOR TO ROUGH-IN.
- ALL DISCONNECTS LOCATED OUTSIDE SHALL BE WEATHERPROOF.
- PROVIDE HACR TYPE BREAKERS FOR CIRCUITS FEEDING HACR TYPE EQUIPMENT.

AS BUILT

2660 East Chose Lane, Suite 200
Montgomery, AL 36117
T 334-271-3200
G M C N E T W O R K . C O M

ISSUE	DATE
95% REVIEW	05.30.19
PERMIT SET	10.11.19
DESIGNED BY:	JBH
DRAWN BY:	CG
CHECKED BY:	JBH

THE EXCHANGE AT HOMEPLACE
PRATTVILLE, AL
GMC PROJECT#AMGM180037

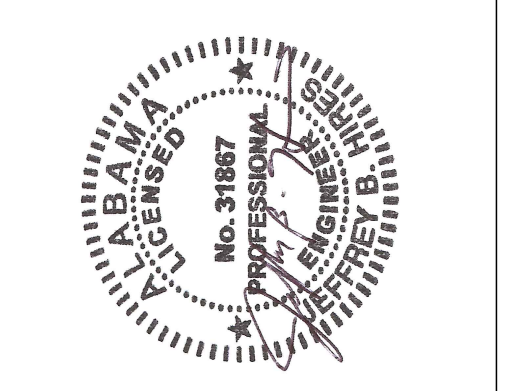


Electrical Overall Building Plan - Power and Lighting
E1.1
Sheet of


GENERAL NOTES (APPLY TO THIS SHEET ONLY):

1. DO NOT MOUNT DEVICES BACK TO BACK. OFFSET ONE TO THE NEXT STUD SPACE.
2. COORDINATE/CONFIRM EXACT LOCATION AND MOUNTING HEIGHTS OF ALL LIGHT FIXTURES SHOWN ON THIS SHEET WITH ARCHITECT PRIOR TO ROUGH-IN.
3. COORDINATE EXACT DESIRED SWITCHING ARRANGEMENT AND SWITCH LOCATIONS WITH OWNER/TENANTS PRIOR TO ROUGH-IN.
4. ALL RECEPTACLES SHOWN SHALL BE MOUNTED AT 15" AFF UNLESS NOTED OTHERWISE .

KEYNOTES (APPLY TO THIS SHEET ONLY):

- ① CONNECT TO UNSWITCHED "HOT" FROM LIGHTING CIRCUIT FEEDING THIS AREA.
- ② ROUTE THROUGH TIMECLOCK CHANNEL 1 OF THIS TENANT SPACE. SEE E2.1 FOR MORE INFO.
- ③ ROUTE THROUGH TIMECLOCK CHANNEL 2 OF THIS TENANT SPACE. SEE E2.1 FOR MORE INFO.
- ④ FOR TENANT SIGN, COORDINATE EXACT LOCATION AND POWER REQUIREMENTS WITH SIGN PROVIDER PRIOR TO ROUGH-IN. SEE DETAIL 2 ON SHEET E1.1 FOR MORE INFORMATION ON CONTROLS.
- ⑤ WALL OR CEILING MOUNT RECEPTACLE CENTERED ABOVE WINDOW IN ACCORDANCE WITH NEC 210.62.
- ⑥ CONFIRM DESIRED LOCATION OF TBB WITH TENANT PRIOR TO INSTALLATION.

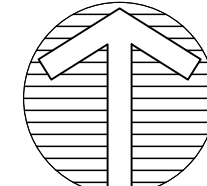
1 ELECTRICAL FLOOR PLAN - POWER
 1/4" = 1'-0"
 PLAN NORTH

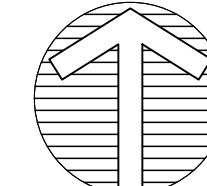
2 ELECTRICAL FLOOR PLAN - LIGHTING
 1/4" = 1'-0"
 PLAN NORTH




2660 East Chose Lane, Suite 200
 Montgomery, AL 36117
 T 334-271-3200
 G M C N E T W O R K . C O M

ISSUE	DATE
95% REVIEW	05.30.19
PERMIT SET	10.11.19
DESIGNED BY:	JBH
DRAWN BY:	CG
CHECKED BY:	JBH

THE EXCHANGE AT HOMEPLACE
 PRATTVILLE, AL
 GMC PROJECT#AMGM180037



**Electrical Tenant
 Plan - Power and
 Lighting
 E1.2**
 sheet ___ of ___

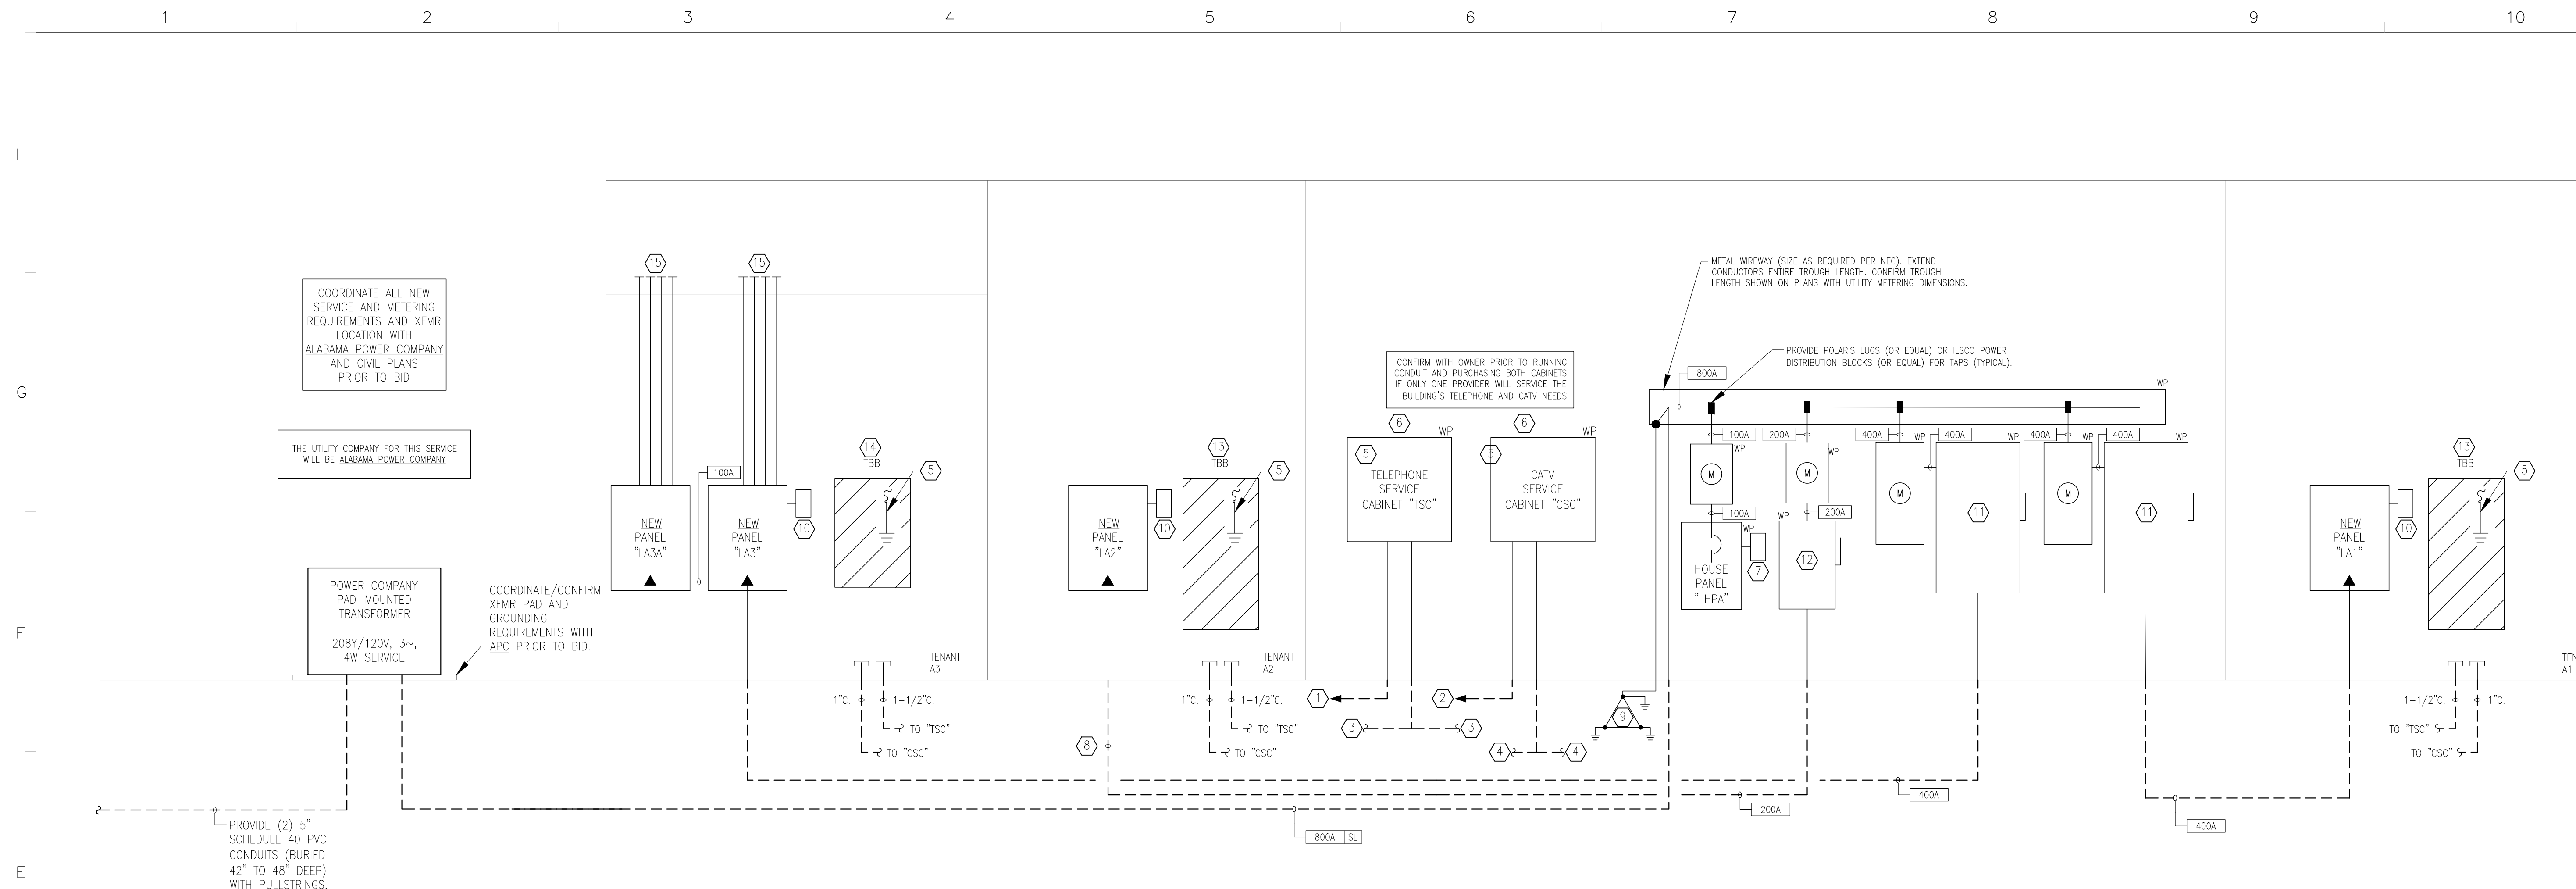

1 ELECTRICAL RISER DIAGRAM - BLDG. A
NOT TO SCALE

- KEYNOTES (APPLY TO THIS SHEET ONLY):**
- ① TELEPHONE SERVICE - PROVIDE (1) 4" CONDUIT WITH PULLSTRING EXTENDED TO RIGHT OF WAY (PROPERTY LINE). COORDINATE EXACT LOCATION WITH TELEPHONE COMPANY. PROVIDE LONG SWEEP ELBOWS.
 - ② CATV SERVICE - PROVIDE (1) 2" CONDUIT WITH PULLSTRING EXTENDED TO RIGHT OF WAY (PROPERTY LINE). COORDINATE EXACT LOCATION WITH SELECTED CATV COMPANY. PROVIDE LONG SWEEP ELBOWS.
 - ③ FOR FUTURE TENANT TELEPHONE SERVICE - PROVIDE 1-1/2" CONDUIT WITH PULLSTRING TO EACH TENANT SPACE. SEE E1.1 FOR PROPOSED STUB-UP LOCATIONS.
 - ④ FOR FUTURE TENANT CATV SERVICE - PROVIDE 1" CONDUIT WITH PULLSTRING TO EACH TENANT SPACE. SEE E1.1 FOR PROPOSED STUB-UP LOCATIONS.
 - ⑤ PROVIDE GROUND BUS BAR AND 1#6 INSULATED GROUND TO BUILDING GROUND.
 - ⑥ PROVIDE NEMA 3R LOCKABLE BOX FOR SERVICE CABINET. COORDINATE MINIMUM CABINET SIZE WITH RESPECTIVE SERVICE PROVIDER PRIOR TO PURCHASING CABINET. PROVIDE 3/4" GRADE A PLYWOOD BACKBOARD - PAINT WITH FIRE RETARDANT PAINT.
 - ⑦ 4-CHANNEL HOUSE TIMECLOCK IN NEMA 3R ENCLOSURE (TORK DTS400B OR EQUAL). PROVIDE POWER AS NEEDED FROM LHPA-1 VIA 2#12, 1#12G, 3/4"C.
 - ⑧ PROVIDE ADDITIONAL SPARE 2-1/2" C. WITH PULLSTRING STUBBED UP AND CAPPED FOR POTENTIAL FUTURE USE.
 - ⑨ PROVIDE GROUNDING SYSTEM PER NEC 250. SEE DETAIL 2 ON THIS SHEET. PROVIDE ALL APPLICABLE CONNECTIONS SHOWN ON DETAIL.
 - ⑩ 2-CHANNEL TIMECLOCK (TORK DGLC200A-NC OR EQUAL) WITH COMPATIBLE MANUAL OVERRIDE SWITCH AND POWER PACK (TORK SS410 AND TORK TRP-24B, RESPECTIVELY, OR EQUAL). PROVIDE WITH PHOTO SENSOR. PROVIDE WIRING AS REQUIRED FOR OVERRIDE SWITCH AND PHOTO SENSOR. PROVIDE POWER AS INDICATED ON ASSOCIATED TENANT PANEL SCHEDULE ON SHEET E3.1, VIA 2#12, 1#12G, 3/4"C.
 - ⑪ 400A/3P/400A FUSED, HEAVY DUTY AC DISCONNECT OR ENCLOSED CIRCUIT BREAKER.
 - ⑫ 200A/3P/200A FUSED, HEAVY DUTY AC DISCONNECT OR ENCLOSED CIRCUIT BREAKER.
 - ⑬ PROVIDE 3/4" x 4'W x 8'H GRADE A PLYWOOD BACKBOARD - PAINT WITH FIRE RETARDANT PAINT.
 - ⑭ PROVIDE 3/4" x 2'W x 2'H GRADE A PLYWOOD BACKBOARD - PAINT WITH FIRE RETARDANT PAINT.
 - ⑮ PROVIDE (4) SPARE 1" CONDUITS (WITH PULLSTRINGS) FROM TOP OF PANEL TO ABOVE CEILING FOR FUTURE USE.


RISER DIAGRAM FEEDER SCHEDULE

NOTE: ALL CONDUCTORS SIZES IN THIS SCHEDULE ARE SIZED FOR COPPER.

TAG	NUMBER OF SETS	CONFIG.	PANEL/NEUTRAL SIZE PER SET	EQUIP. GROUND PER SET	CONDUIT SIZE PER SET	NOTES
800A SL	2	3-PH, 4W	4 # 600 kcmil	N/A	4"	SERVICE LATERAL
800A	2	3-PH, 4W+G	4 # 600 kcmil	1 # 1/0	4"	
400A	2	3-PH, 4W+G	4 # 3/0	1 # 3	2-1/2"	
200A	1	3-PH, 4W+G	4 # 3/0	1 # 6	2-1/2"	
100A	1	3-PH, 4W+G	4 # 2	1 # 8	1-1/2"	

HI-COMPRESSION ("COMPACT") TYPE ALUMINUM CONDUCTORS MAY BE USED FOR THE FOLLOWING IF THE SAME OR LARGER CAPACITY OF THOSE COPPER CONDUCTORS AND CONDUIT SIZES SHOWN ARE ADJUSTED ACCORDINGLY:
 1. SERVICE LATERALS
 2. FEEDERS 100A CAPACITY OR GREATER

NOTE: COPPER CONDUCTORS SHALL BE USED FOR ALL BRANCH CIRCUITS (INCLUDING HVAC).

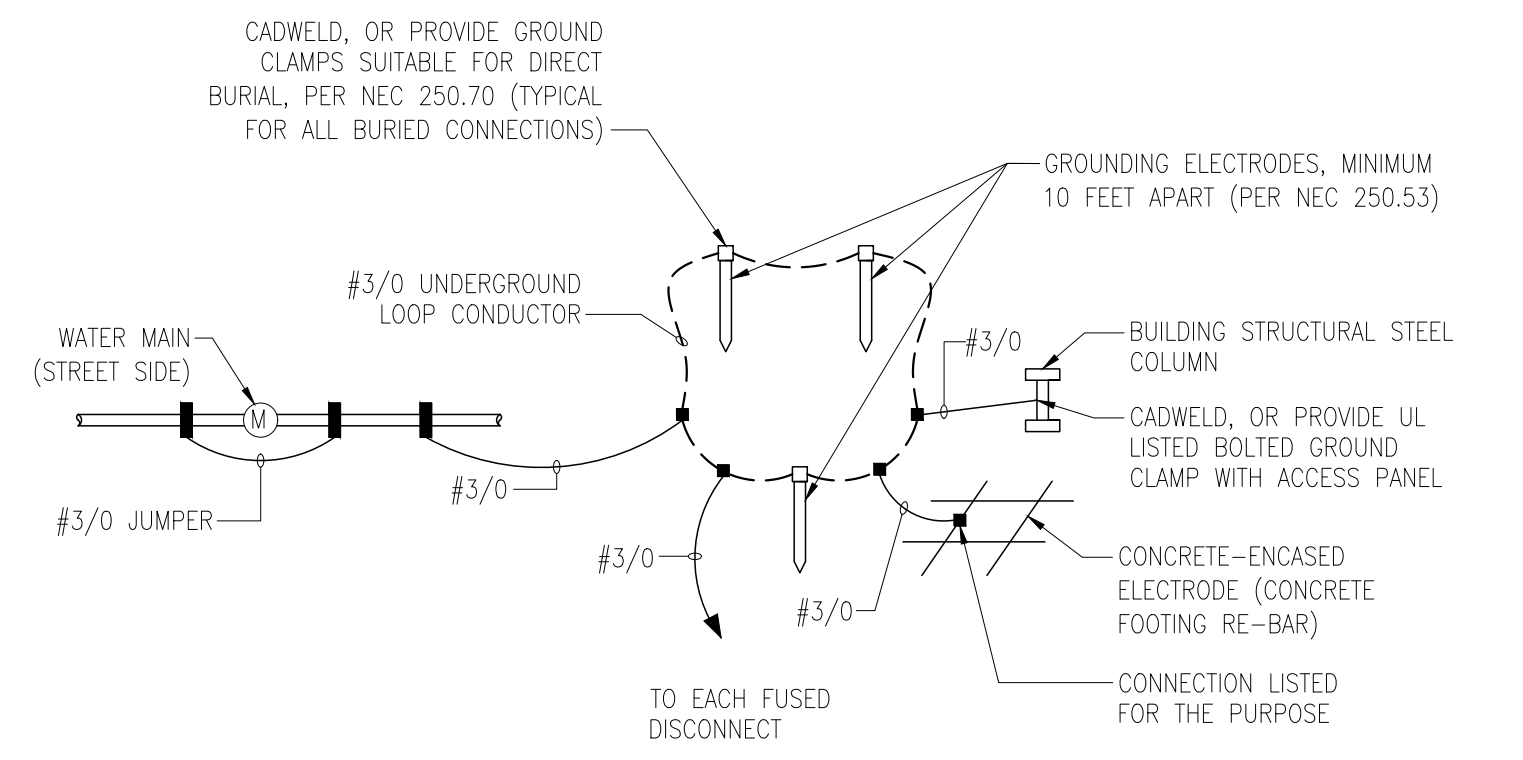

2 MAIN GROUNDING DETAIL
NOT TO SCALE


GMC

AS BUILT

2660 East Chose Lane, Suite 200
Montgomery, AL 36117
T 334-271-3200
G M C N E T W O R K . C O M


ISSUE	DATE
95% REVIEW	06.30.19
PERMIT SET	10.11.19
DESIGNED BY:	JBH
DRAWN BY:	CG
CHECKED BY:	JBH

THE EXCHANGE AT HOMEPLACE
PRATTVILLE, AL
GMC PROJECT#AMGM180037

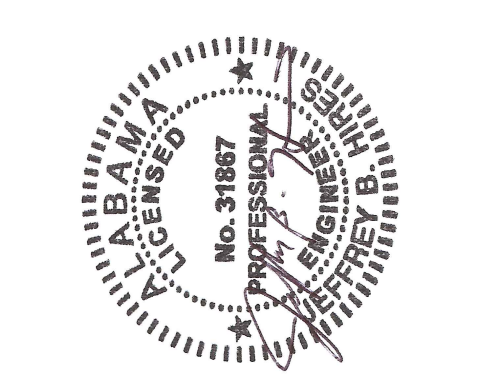

Electrical Riser Diagram - BLDG. A

E2.1
sheet of

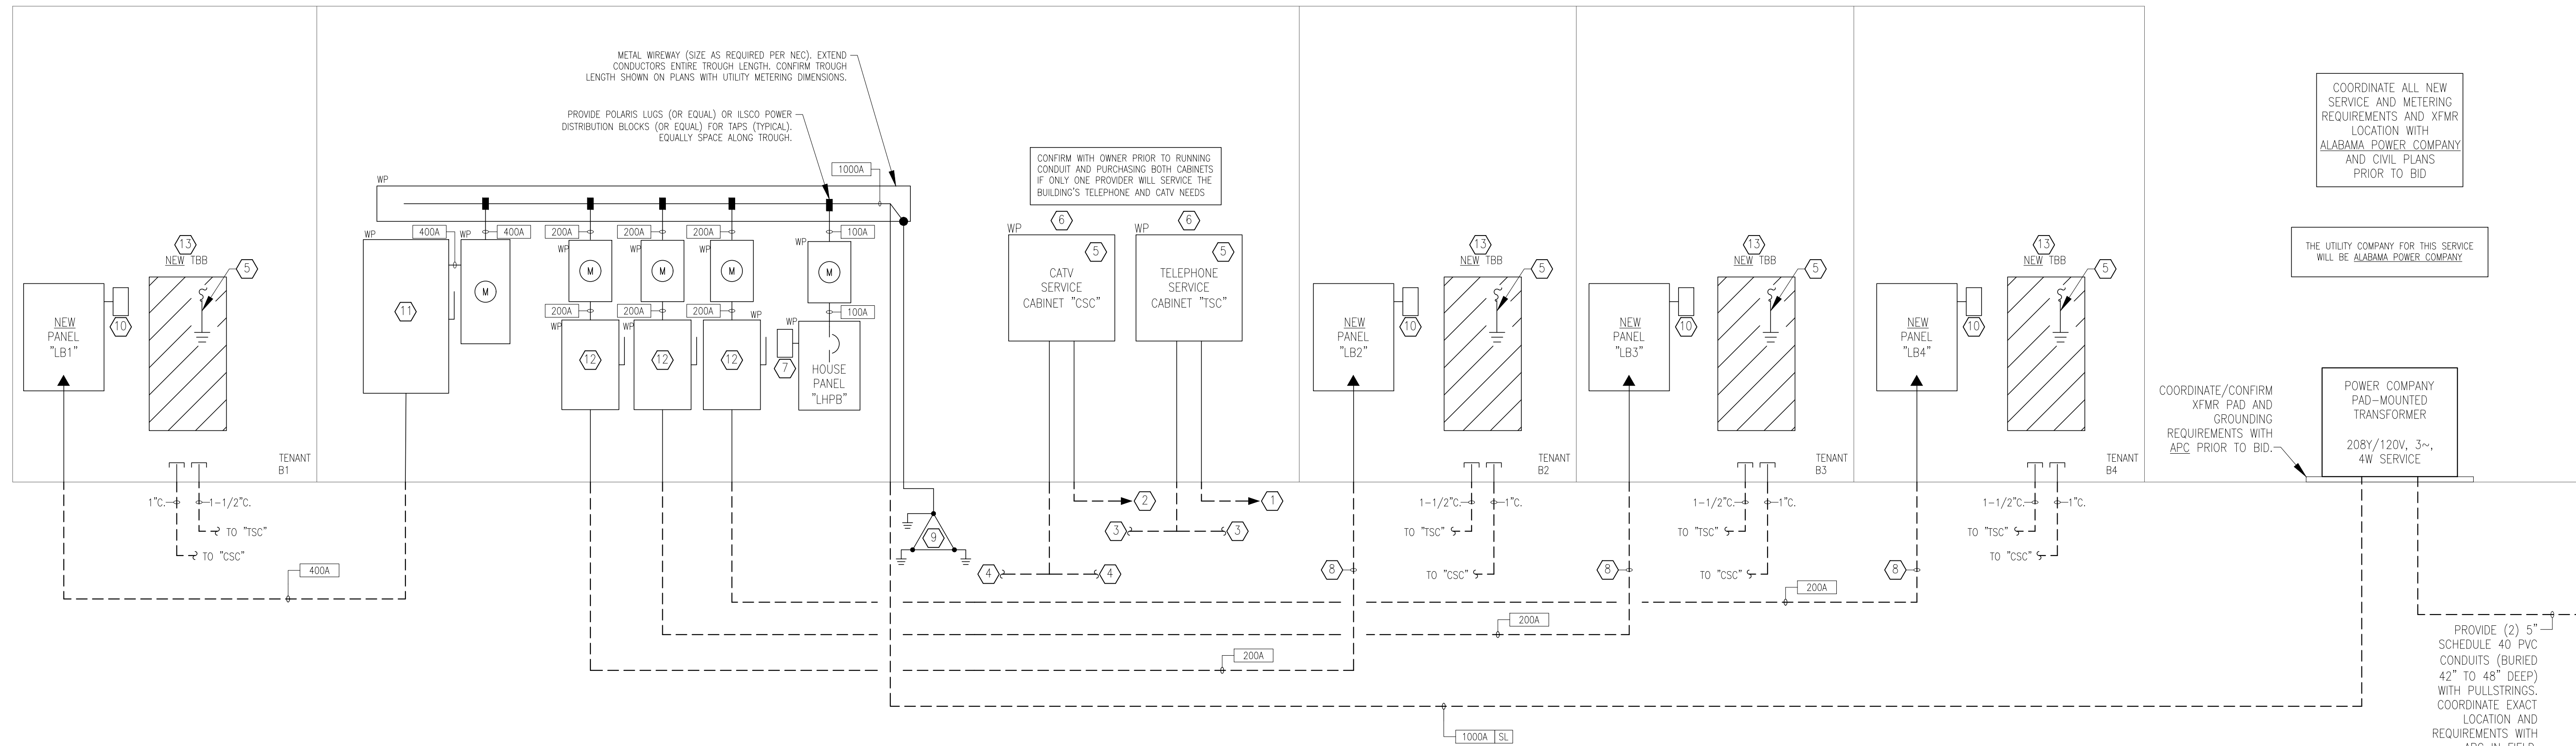

1 ELECTRICAL RISER DIAGRAM - BLDG. B
NOT TO SCALE

KEYNOTES (APPLY TO THIS SHEET ONLY):

- ① TELEPHONE SERVICE - PROVIDE (1) 4" CONDUIT WITH PULLSTRING EXTENDED TO RIGHT OF WAY (PROPERTY LINE). COORDINATE EXACT LOCATION WITH TELEPHONE COMPANY. PROVIDE LONG SWEEP ELBOWS.
- ② CATV SERVICE - PROVIDE (1) 2" CONDUIT WITH PULLSTRING EXTENDED TO RIGHT OF WAY (PROPERTY LINE). COORDINATE EXACT LOCATION WITH SELECTED CATV COMPANY. PROVIDE LONG SWEEP ELBOWS.
- ③ FOR NEW AND FUTURE TENANT TELEPHONE SERVICE - PROVIDE 1-1/2" CONDUIT WITH PULLSTRING TO EACH TENANT SPACE. SEE E2.1 AND E2.2 FOR PROPOSED STUB-UP LOCATIONS.
- ④ FOR NEW AND FUTURE TENANT CATV SERVICE - PROVIDE 1" CONDUIT WITH PULLSTRING TO EACH TENANT SPACE. SEE E2.1 AND E2.2 FOR PROPOSED STUB-UP LOCATIONS.
- ⑤ PROVIDE GROUND BUS BAR AND 1#6 INSULATED GROUND TO BUILDING GROUND.
- ⑥ PROVIDE NEMA 3R LOCKABLE BOX FOR SERVICE CABINET. COORDINATE MINIMUM CABINET SIZE WITH RESPECTIVE SERVICE PROVIDER PRIOR TO PURCHASING CABINET. PROVIDE 3/4" GRADE A PLYWOOD BACKBOARD - PAINT WITH FIRE RETARDANT PAINT.
- ⑦ 4-CHANNEL HOUSE TIMECLOCK IN NEMA 3R ENCLOSURE (TORK DTS400B OR EQUAL). PROVIDE POWER AS NEEDED FROM LHPA-1 OR LHPB-1 VIA 2#12, 1#12G, 3/4"C.
- ⑧ PROVIDE ADDITIONAL SPARE 2-1/2" C. WITH PULLSTRING STUBBED UP AND CAPPED FOR POTENTIAL FUTURE USE.
- ⑨ PROVIDE GROUNDING SYSTEM PER NEC 250. SEE DETAIL 2 ON THIS SHEET. PROVIDE ALL APPLICABLE CONNECTIONS SHOWN ON DETAIL.
- ⑩ 2-CHANNEL TIMECLOCK (TORK DGLC200A-NC OR EQUAL) WITH COMPATIBLE MANUAL OVERRIDE SWITCH AND POWER PACK (TORK SS410 AND TORK TRP-24B, RESPECTIVELY, OR EQUAL). PROVIDE WITH PHOTO SENSOR. PROVIDE WIRING AS REQUIRED FOR OVERRIDE SWITCH AND PHOTO SENSOR. PROVIDE POWER AS INDICATED ON ASSOCIATED TENANT PANEL SCHEDULE ON SHEET E4.1, VIA 2#12, 1#12G, 3/4"C.
- ⑪ 400A/3P/400A FUSED, HEAVY DUTY AC DISCONNECT OR ENCLOSED CIRCUIT BREAKER.
- ⑫ 200A/3P/200A FUSED, HEAVY DUTY AC DISCONNECT OR ENCLOSED CIRCUIT BREAKER.
- ⑬ PROVIDE 3/4" x 4"W x 8"H GRADE A PLYWOOD BACKBOARD - PAINT WITH FIRE RETARDANT PAINT.

RISER DIAGRAM FEEDER SCHEDULE


NOTE: ALL CONDUCTORS SIZES IN THIS SCHEDULE ARE SIZED FOR COPPER.

TAG	NUMBER OF SETS	CONFIG.	PANEL/NEUTRAL SIZE PER SET	EQUIP. GROUND PER SET	CONDUIT SIZE PER SET	NOTES
[1000A SL]	3	3-PH, 4W	4 # 400 kcmil	N/A	4"	SERVICE LATERAL
[1000A]	3	3-PH, 4W+G	4 # 400 kcmil	1 # 2/0	4"	
[400A]	2	3-PH, 4W+G	4 # 3/0	1 # 3	2-1/2"	
[200A]	1	3-PH, 4W+G	4 # 3/0	1 # 6	2-1/2"	
[100A]	1	3-PH, 4W+G	4 # 2	1 # 8	1-1/2"	

HI-COMPRESSION ("COMPACT") TYPE ALUMINUM CONDUCTORS MAY BE USED FOR THE FOLLOWING IF THE SAME OR LARGER CAPACITY OF THOSE COPPER CONDUCTORS AND CONDUIT SIZES SHOWN ARE ADJUSTED ACCORDINGLY:

- SERVICE LATERALS
- FEEDERS 100A CAPACITY OR GREATER

NOTE: COPPER CONDUCTORS SHALL BE USED FOR ALL BRANCH CIRCUITS (INCLUDING HVAC).

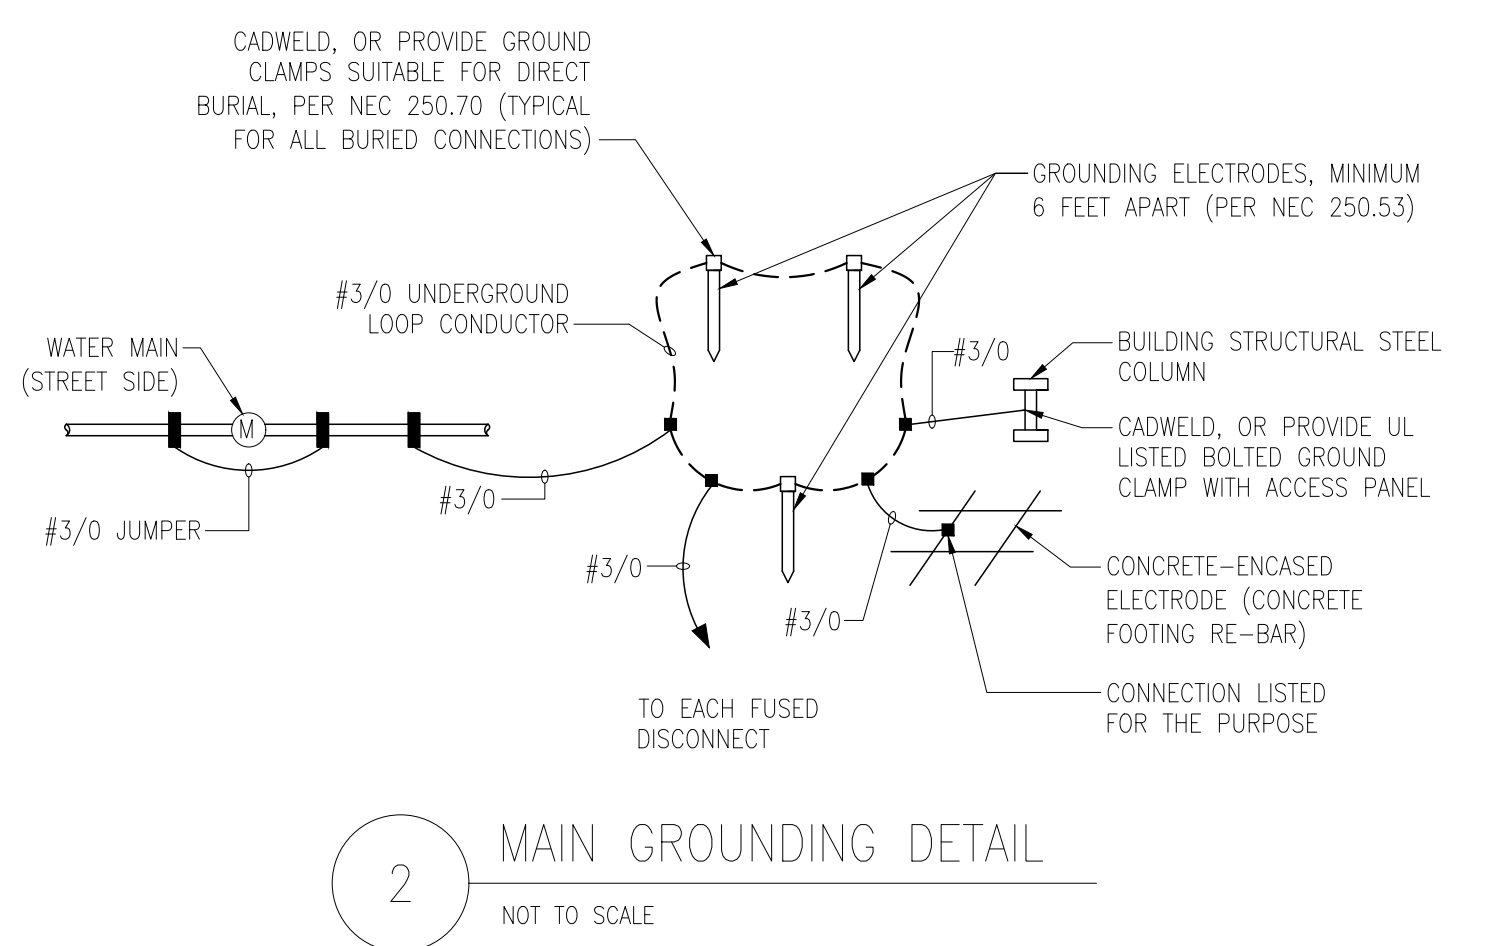

2 MAIN GROUNDING DETAIL
NOT TO SCALE


GMC

AS BUILT

2660 East Chose Lane, Suite 200
Montgomery, AL 36117
T 334-271-3200
G M C N E T W O R K . C O M

ISSUE	DATE
95% REVIEW	05.30.19
PERMIT SET	10.11.19
DESIGNED BY:	JBH
DRAWN BY:	CG
CHECKED BY:	JBH

THE EXCHANGE AT HOMEPAGE
PRATTVILLE, AL
GMC PROJECT#AMGM180037

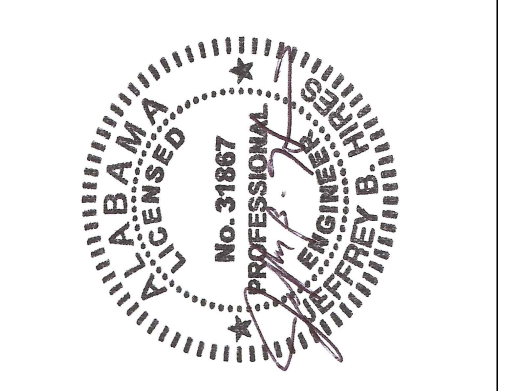

Electrical Riser Diagram - B
E2.2
sheet of

HOUSE PANEL LHPB		AIC RATING: 22,000A	
MOUNTING: SURFACE		NEMA 3R	
VOLTAGE: 120/208V		3 PHASE / 4 WIRE	
AMP RATING: 100A		MAIN: MCB # - PROVIDE BKR LOCK-ON DEVICE	
CKT NO.	BKR	DESCRIPTION	BKR
1	20/1	TSC	SPARE 20/1
3	# 20/1	FACP	SPARE 20/1
5	20/1	EWB-1	SPARE 20/1
7	20/1	EXTERIOR LIGHTING	SPARE 20/1
9	20/1	SPARE	SPARE 20/1
11	20/1	DH-2/EF-1	SPARE 20/1
13	20/1	TIMECLOCK	SPARE 20/1
15	20/1	SPARE	SPARE 20/1
17	20/1	SPARE	SPARE 20/1
19	20/1	SPACE	SPACE 20/1
21	20/1	SPACE	SPACE 20/1
23	20/1	SPACE	SPACE 20/1

LOAD SUMMARY
 PHASE A 1.66 KVA 208 VOLTS PHASE-TO-PHASE
 PHASE B 0.25 KVA
 PHASE C 0.65 KVA
 TOTAL CONNECTED 2.56 KVA 7.1 AMPS

PANEL LBL		AIC RATING: 22,000A	
MOUNTING: SURFACE		NEMA 3R	
VOLTAGE: 120/208V		3 PHASE / 4 WIRE	
AMP RATING: 400A		MAIN: MLO PROVIDE FEED THROUGH LUGS FOR FUTURE 2ND SECTION	
CKT NO.	BKR	DESCRIPTION	BKR
1	20/1	TBB	REC 20/1
3	20/1	ROOF REC.	REC 20/1
5	20/1	SIGN LIGHTING	RTU-4 70/3
7	20/1	PORCH FAN/LIGHTS	RTU-4 70/3
9	20/1	TIMECLOCK	RTU-4 70/3
11	20/1	LTG	RTU-4 70/3
13	20/1	SPARE	SPARE 20/1
15	20/1	SPARE	SPARE 20/1
17	20/1	SPARE	SPARE 20/1
19	20/1	SPARE	SPARE 20/1
21	20/1	SPARE	SPARE 20/1
23	20/1	SPARE	SPARE 20/1
25	20/1	SPARE	SPARE 20/1
27	20/1	SPARE	SPARE 20/1
29	20/1	SPARE	SPARE 20/1
31	20/1	SPARE	SPARE 20/1
33	20/1	SPARE	SPARE 20/1
35	20/1	SPARE	SPARE 20/1
37	20/1	SPACE	SPACE 20/1
39	20/1	SPACE	SPACE 20/1
41	20/1	SPACE	SPACE 20/1

LOAD SUMMARY
 PHASE A 12.36 KVA 208 VOLTS PHASE-TO-PHASE
 PHASE B 11.92 KVA
 PHASE C 11.67 KVA
 TOTAL CONNECTED 35.95 KVA 99.8 AMPS

PANEL LBL2		AIC RATING: 22,000A	
MOUNTING: SURFACE		NEMA 3R	
VOLTAGE: 120/208V		3 PHASE / 4 WIRE	
AMP RATING: 200A		MAIN: MLO PROVIDE FEED THROUGH LUGS FOR FUTURE 2ND SECTION	
CKT NO.	BKR	DESCRIPTION	BKR
1	20/1	TBB	REC 20/1
3	20/1	ROOF REC.	REC 20/1
5	20/1	SIGN LIGHTING	RTU-3 45/3
7	20/1	TIMECLOCK	RTU-3 45/3
9	20/1	LTG	RTU-3 45/3
11	20/1	SPARE	SPARE 20/1
13	20/1	SPARE	SPARE 20/1
37	20/1	SPACE	SPACE 20/1
39	20/1	SPACE	SPACE 20/1
41	20/1	SPACE	SPACE 20/1

LOAD SUMMARY
 PHASE A 4.44 KVA 208 VOLTS PHASE-TO-PHASE
 PHASE B 4.66 KVA
 PHASE C 3.51 KVA
 TOTAL CONNECTED 12.61 KVA 35.0 AMPS

PANEL LBL3		AIC RATING: 22,000A	
MOUNTING: SURFACE		NEMA 3R	
VOLTAGE: 120/208V		3 PHASE / 4 WIRE	
AMP RATING: 200A		MAIN: MLO PROVIDE FEED THROUGH LUGS FOR FUTURE 2ND SECTION	
CKT NO.	BKR	DESCRIPTION	BKR
1	20/1	TBB	REC 20/1
3	20/1	ROOF REC.	REC 20/1
5	20/1	SIGN LIGHTING	RTU-2 45/3
7	20/1	TIMECLOCK	RTU-2 45/3
9	20/1	LTG	RTU-2 45/3
11	20/1	SPARE	SPARE 20/1
13	20/1	SPARE	SPARE 20/1
37	20/1	SPACE	SPACE 20/1
39	20/1	SPACE	SPACE 20/1
41	20/1	SPACE	SPACE 20/1

LOAD SUMMARY
 PHASE A 4.44 KVA 208 VOLTS PHASE-TO-PHASE
 PHASE B 4.66 KVA
 PHASE C 3.51 KVA
 TOTAL CONNECTED 12.61 KVA 35.0 AMPS

PANEL LBL4		AIC RATING: 22,000A	
MOUNTING: SURFACE		NEMA 3R	
VOLTAGE: 120/208V		3 PHASE / 4 WIRE	
AMP RATING: 200A		MAIN: MLO PROVIDE FEED THROUGH LUGS FOR FUTURE 2ND SECTION	
CKT NO.	BKR	DESCRIPTION	BKR
1	20/1	TBB	REC 20/1
3	20/1	ROOF REC.	REC 20/1
5	20/1	SIGN LIGHTING	RTU-1 45/3
7	20/1	TIMECLOCK	RTU-1 45/3
9	20/1	LTG	RTU-1 45/3
11	20/1	SPARE	SPARE 20/1
13	20/1	SPARE	SPARE 20/1
37	20/1	SPACE	SPACE 20/1
39	20/1	SPACE	SPACE 20/1
41	20/1	SPACE	SPACE 20/1

LOAD SUMMARY
 PHASE A 4.44 KVA 208 VOLTS PHASE-TO-PHASE
 PHASE B 4.66 KVA
 PHASE C 3.51 KVA
 TOTAL CONNECTED 12.61 KVA 35.0 AMPS

PANEL LA3S		AIC RATING: 22,000A	
MOUNTING: FLUSH		NEMA 3R	
VOLTAGE: 120/208V		3 PHASE / 4 WIRE	
AMP RATING: 100A		MAIN: MLO	
CKT NO.	BKR	DESCRIPTION	BKR
1	20/1	SPARE	SPARE 20/1
3	20/1	SPARE	SPARE 20/1
5	20/1	SPARE	SPARE 20/1
7	20/1	SPARE	SPARE 20/1
9	20/1	SPARE	SPARE 20/1
11	20/1	SPARE	SPARE 20/1
13	20/1	SPARE	SPARE 20/1
15	20/1	SPARE	SPARE 20/1
17	20/1	SPARE	SPARE 20/1
19	20/1	SPARE	SPARE 20/1
21	20/1	SPARE	SPARE 20/1
23	20/1	SPARE	SPARE 20/1

LOAD SUMMARY
 PHASE A 0.00 KVA 208 VOLTS PHASE-TO-PHASE
 PHASE B 0.00 KVA
 PHASE C 0.00 KVA
 TOTAL CONNECTED 0 KVA 0.0 AMPS

HOUSE PANEL LHPA		AIC RATING: 22,000A	
MOUNTING: SURFACE		NEMA 3R	
VOLTAGE: 120/208V		3 PHASE / 4 WIRE	
AMP RATING: 100A		MAIN: MCB # - PROVIDE BKR LOCK-ON DEVICE	
CKT NO.	BKR	DESCRIPTION	BKR
1	20/1	TSC	SPARE 20/1
3	# 20/1	FACP	SPARE 20/1
5	20/1	EWB-2	SPARE 20/1
7	20/1	EXTERIOR LIGHTING	SPARE 20/1
9	20/1	EXT. REC	SPARE 20/1
11	20/1	DH-2/EF-2	SPARE 20/1
13	20/1	TIMECLOCK	SPARE 20/1
15	20/1	SPARE	SPARE 20/1
17	20/1	SPARE	SPARE 20/1
19	20/1	SPACE	SPACE 20/1
21	20/1	SPACE	SPACE 20/1
23	20/1	SPACE	SPACE 20/1

LOAD SUMMARY
 PHASE A 1.25 KVA 208 VOLTS PHASE-TO-PHASE
 PHASE B 0.97 KVA
 PHASE C 0.65 KVA
 TOTAL CONNECTED 2.865 KVA 8.0 AMPS

PANEL LAL		AIC RATING: 22,000A	
MOUNTING: SURFACE		NEMA 3R	
VOLTAGE: 120/208V		3 PHASE / 4 WIRE	
AMP RATING: 400A		MAIN: MLO PROVIDE FEED THROUGH LUGS FOR FUTURE 2ND SECTION	
CKT NO.	BKR	DESCRIPTION	BKR
1	20/1	TBB	REC 20/1
3	20/1	ROOF REC.	REC 20/1
5	20/1	SIGN LIGHTING	RTU-6 70/3
7	20/1	PORCH FAN/LIGHTS	RTU-6 70/3
9	20/1	TIMECLOCK	RTU-6 70/3
11	20/1	LTG	RTU-6 70/3
13	20/1	SPARE	SPARE 20/1
15	20/1	SPARE	SPARE 20/1
17	20/1	SPARE	SPARE 20/1
19	20/1	SPARE	SPARE 20/1
21	20/1	SPARE	SPARE 20/1
23	20/1	SPARE	SPARE 20/1
25	20/1	SPARE	SPARE 20/1
27	20/1	SPARE	SPARE 20/1
29	20/1	SPARE	SPARE 20/1
31	20/1	SPARE	SPARE 20/1
33	20/1	SPARE	SPARE 20/1
35	20/1	SPARE	SPARE 20/1
37	20/1	SPACE	SPACE 20/1
39	20/1	SPACE	SPACE 20/1
41	20/1	SPACE	SPACE 20/1

LOAD SUMMARY
 PHASE A 12.36 KVA 208 VOLTS PHASE-TO-PHASE
 PHASE B 11.92 KVA
 PHASE C 11.67 KVA
 TOTAL CONNECTED 35.95 KVA 99.8 AMPS

PANEL LA2		AIC RATING: 22,000A	
MOUNTING: SURFACE		NEMA 3R	
VOLTAGE: 120/208V		3 PHASE / 4 WIRE	
AMP RATING: 200A		MAIN: MLO PROVIDE FEED THROUGH LUGS FOR FUTURE 2ND SECTION	
CKT NO.	BKR	DESCRIPTION	BKR
1	20/1	TBB	REC 20/1
3	20/1	ROOF REC.	REC 20/1
5	20/1	SIGN LIGHTING	RTU-8 45/3
7	20/1	TIMECLOCK	RTU-8 45/3
9	20/1	LTG	RTU-8 45/3
11	20/1	SPARE	SPARE 20/1
13	20/1	SPARE	SPARE 20/1
37	20/1	SPACE	SPACE 20/1
39	20/1	SPACE	SPACE 20/1
41	20/1	SPACE	SPACE 20/1

LOAD SUMMARY
 PHASE A 4.44 KVA 208 VOLTS PHASE-TO-PHASE
 PHASE B 4.66 KVA
 PHASE C 3.51 KVA
 TOTAL CONNECTED 12.61 KVA 35.0 AMPS

PANEL LA3		AIC RATING: 22,000A	
MOUNTING: FLUSH		NEMA 3R	
VOLTAGE: 120/208V		3 PHASE / 4 WIRE	
AMP RATING: 400A		MAIN: MLO	
CKT NO.	BKR	DESCRIPTION	BKR
1	20/1	TBB	REC 20/1
3	20/1	ROOF REC.	REC 20/1
5	20/1	SIGN LIGHTING	RTU-9 45/3
7	20/1	TIMECLOCK	RTU-9 45/3
9	20/1	INTERIOR LIGHTING	RTU-9 45/3
11	20/1	SPARE	SPARE 20/1
13	100/3	PANEL "LA3S"	RTU-10 14
15	20/1	SPARE	SPARE 20/1
17	20/1	SPARE	SPARE 20/1
19	20/1	SPARE	SPARE 20/1
21	20/1	SPARE	SPARE 20/1
23	20/1	SPARE	SPARE 20/1
25	20/1	SPARE	SPARE 20/1
27	20/1	SPARE	SPARE 20/1
29	20/1	SPARE	SPARE 20/1
31	20/1	SPARE	SPARE 20/1
33	20/1	SPARE	SPARE 20/1
35	20/1	SPARE	SPARE 20/1
37	20/1	SPACE	SPACE 20/1
39	20/1	SPACE	SPACE 20/1
41	20/1	SPACE	SPACE 20/1

LOAD SUMMARY
 PHASE A 7.70 KVA 208 VOLTS PHASE-TO-PHASE
 PHASE B 8.92 KVA
 PHASE C 6.77 KVA
 TOTAL CONNECTED 23.393 KVA 64.9 AMPS




AS BUILT

2660 East Chase Lane, Suite 200
 Montgomery, AL 36117
 T 334.271.3200
 GMCNETWORK.COM

ISSUE	DATE
95% REVIEW	05.30.19
PERMIT SET	10.11.19
DESIGNED BY:	JBH
DRAWN BY:	CG
CHECKED BY:	JBH

THE EXCHANGE AT HOMEPAGE
 PRATTVILLE, AL
 GMC PROJECT#AMGM180037

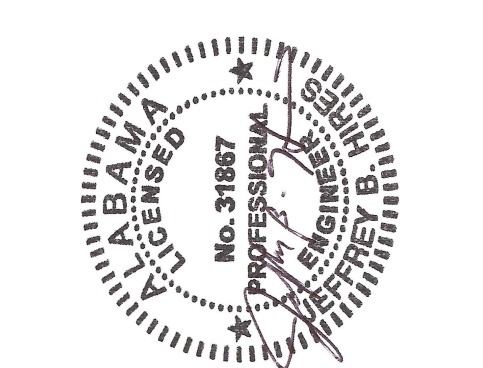

Electrical Panel Schedules
 E3.1
 sheet of

FIRE PROTECTION SPECIFICATIONS

PART 1 - GENERAL

1.1 SUMMARY

- A. The General Provisions, Supplemental General Provisions, apply to all work specified in these specifications.
- B. The Fire Protection Specifications shown on this drawing describes the basic materials and installation methods for the fire protection system.
- C. Furnish and install all components of the fire protection system specified herein, as indicated on the drawings, and as required to provide complete and operating systems.

1.2 DESCRIPTION OF WORK

- A. Work Included: Provide a complete fire sprinkler system, including pipe, tube fittings, and appurtenances as indicated, in compliance with these Specifications and as required by local code agencies.
- B. Related Work by Others: The following work shall be provided by the Contractor:
 1. The Sprinkler Contractor shall pipe the discharge of the sprinkler piping main drain(s) to the exterior of the building or other location approved by the Architect.
 2. The Electrical/Fire Alarm Contractor will provide a complete fire alarm system and will make connections to flow switches and gate supervisory switches from the fire panel.
- C. Applications: Application of the fire protection system shall include, but are not limited to, the systems as listed below:
 1. Supply mains, valves, risers, and drains.
 2. Standard pattern Siamese connections per local Fire Department Regulations.
 3. Flow switches.
 4. Hydraulically designed sprinkler system.
- D. Quality Assurance:
 1. Materials shall be installed in accordance with NFPA. Valves, fittings, sprinkler heads, and equipment shall be UL and FM labeled.
 2. Hose threads shall conform to local fire department requirements.
 3. Coordination Drawings:
 - a. Before starting fabrication or installation of equipment, the Contractor shall submit to Architect, for his consideration, Shop Drawings noted as reviewed by the ISO for insurance rate making purposes only via electronic format (e.g. PDF).
 - b. After Contract award and prior to releasing any equipment orders for fabrication, Shop Drawings showing dimensions, weights, performance data, structural details, valves, and controls, along with hydraulic calculations, shall be submitted to the Architect for review and approval via electronic format (e.g. PDF).
 4. Acceptable Manufacturers: The model numbers listed in the Specifications establish a level of quality and material. The following manufacturers are acceptable subject to compliance with the requirements of these Specifications:
 - 1) Viking Corporation
 - 2) Grinnell Fire Protection Systems Co., Inc.
 - 3) Automatic Sprinkler Corporation
 - 4) Central Sprinkler Corporation
 - 5) Reliable Automatic Sprinkler Company
- E. Pipe Hangers and Supports: Support fire protection pipe with UL listed and approved hangers and support devices. Provide any special hangers or supports that may be required. The design, selection, spacing, and application of horizontal pipe hangers, supports, restraints, anchors, and guides shall be in accordance with the NFPA 13..
- F. Sprinkler System:
 1. Sprinklers will be provided for units and spaces as shown on drawings.
 2. System piping shall be hydraulically designed throughout areas in accordance with the rules and regulations of NFPA 13, using design densities as scheduled on plans.
 3. System shall include required drain lines, drum drip (for maintenance), test connections, spare heads, tools, fire department inlet connections, water motor alarms, circuit closers, monitor switches, alarm valves, isolation valves and similar items.
 4. Sprinkler heads, valves, alarms, and similar items shall be as manufactured by Viking, or Grinnell. Material and equipment used in the installation of the sprinkler systems and standpipes shall be listed and approved by the Underwriters' Laboratories, Inc., and shall be the latest design of the manufacturer.
- G. Valves: Valves shall be UL listed and approved for the pressures at which they are installed.
 1. Check valves shall be swing type with iron body, bronze trim, cast iron disc, bolted cover, and screwed or flanged ends. Swing check valves may be installed in horizontal pipe only.
 2. Gate valves 2" and smaller shall be bronze body, OS&Y, and screwed ends. 150 psig valves shall have bronze trim, single disc, screwed bonnet, and bronze seats. 300 and 400 psig valves shall have bronze wedge disc, union bonnet, and bronze body seat rings.
 3. Gate valves over 2" shall be iron body, OS&Y, bolted bonnet, bronze seats, ANSI 16.1, flanged ends. 150 psig valves shall have double or single disc, and bronze trim. 300 and 400 psig valves shall have wedge disc and brass stem.
 4. Supervised valves shall include valve tamper switches. Valve tamper switches shall be double-pole single-throw type with cast aluminum housing and tamperproof cover. Switch rating shall be at least 7 amperes at 125/250 volts.

PART 2 - PRODUCTS

2.1 PIPING

- A. Pipe: Standpipe and sprinkler piping larger than 2" shall be ASTM A135, Schedule 40 black steel. Thin-wall pipe, ASTM A135, may be used for sprinkler piping where permitted by local codes. Sprinkler piping 2" and smaller shall be schedule 40 black steel. Installation shall be in accordance with the manufacturer's instructions and the UL listing which includes installation limitations. All code approvals shall be secured before shop drawing submittal to Architect.

- B. Fittings: Fittings shall be: Cast iron threaded sprinkler fittings ANSI B16.4 or grooved ends fittings joined by Victaulic Firelock System. Flanges shall be screwed or welded neck type ANSI B16.5. Fittings smaller than 2" shall be Blazemaster schd 40 CPVC and shall meet ASTM D1784.

2.2 EQUIPMENT

- A. Fire Department Connection (Siamese): Wall Siamese fire department connection with chains and caps shall be polished brass or polished chrome. Verify actual material and finish with the Architect.
- B. Water Flow Switch: Include water flow switch, with adjustable retard feature in supply pipe to each riser for remote alarm. Switch shall be double-pole single-throw type and shall be rated at least 7 amperes at 125/250 volts.
- C. Sight Flow Connection: Sight flow connection in test lines.
- D. Sprinkler Heads: Sprinkler heads shall be quick response type, 155°F - 170°F, UL listed. Concealed sprinklers are not permitted. Furnish spare heads equal to 1% of total number of heads installed. The heads shall be representative of, and in proportion to, the number of each type and temperature rating of heads installed. Furnish spare head cabinet and wrench for each riser. Locate cabinets in riser rooms.
- E. Water Motor Gong: Viking model F-2 or equal. An electric alarm may be used, but must be coordinated with EC.

PART 3 - EXECUTION

3.1 INSTALLATION OF PIPING SYSTEMS

- A. General: Comply with the requirements of the piping section of this Specification, NFPA 13 for installation and testing of piping system, and per local code.
 1. Piping shall be concealed, except in mechanical equipment rooms, stairwells, or where otherwise required.
 2. Grade piping to eliminate traps and pockets. Where air pockets or water traps cannot be avoided, provide hose bibs for drainage.
 3. The Sprinkler Contractor shall arrange with the General Contractor to notch or pre-drill the occasional beam in order to maintain the sprinkler mains as high as possible.
 4. All required sprinkler heads shall be individually dropped from the main to the ceiling.
 5. Sprinkler piping shall be installed and coordinated with the duct and other mechanical and electrical services in the ceiling cavities by this Contractor, to provide the clearances for lighting fixtures as required.
 6. Sprinkler piping shall be installed so as not to impede access to mechanical, electrical, or plumbing equipment.
 7. Sprinkler piping shall be flushed to remove excess oils and contaminants that support the growth of microorganisms.
 8. Sprinkler systems shall not be drained/flushed on finished surfaces such as sidewalks and parking lots.
 9. Install a ½" Weld-o-let with plug in the main sprinkler line, on the down stream side (building side) of the flow switch for introduction of micro biocides by the Owner at a later date.
- B. Inspections and Tests: All inspections, examinations, and tests required by the authorities and/or agencies specified hereinbefore shall be arranged and paid for by this Contractor, as necessary, to obtain complete and final acceptance of the system as installed. The certificates of inspection shall be in quadruplicate, and shall be delivered to the Architect for distribution.
- C. Underground Fire Protection Piping: Material for pipe cushion shall comply with local codes and or the geo-technical report. In absence of local code requirements or geo-technical report, the cushion shall be bank sand or select backfill material approved by the Architect. Any material used shall pass a one-inch screen.

FIRE PROTECTION SPRINKLER SYSTEMS SCHEDULE

AREA DESIGNATION	DESCRIPTION	BASIS OF DESIGN	CEILING SPRINKLER SYSTEM						NOTES
			SYSTEM NUMBER	SYSTEM TYPE	DENSITY (GPM/SQ.FT)	REMOTE AREA (SQ.FEET)	HEAD TYPE	HEAD SPACING (MAX SQ.FEET)	
A	RETAIL SPACE	ORDINARY HAZARD GROUP 2	1	WET	0.20	1500	165° CHROME PENDENT SEMI-RECESSED	130	1, 2, 3, 4

NOTES:

1. PROVIDE 500 GPM FOR INSIDE AND OUTSIDE HOSE STREAMS.
2. CONTRACTOR SHALL VERIFY OCCUPANCY.
3. PROVIDE LIGHT HAZARD IN DINING AREAS, IF APPLICABLE.
4. PROVIDE DRY-TYPE SYSTEM FOR ANY AREAS REQUIRED. COORDINATE WITH ARCHITECTURAL DRAWINGS PRIOR TO BID.

FIRE PROTECTION NOTES:

1. A COMPLETE SPRINKLER SYSTEM SHALL BE INSTALLED PER NFPA STANDARDS, STATE AND LOCAL CODES.
2. THE CONTRACTOR FOR THE FIRE PROTECTION INSTALLATION SHALL BE A QUALIFIED FIRE PROTECTION CONTRACTOR, REGULARLY ENGAGED IN THE INSTALLATION OF AUTOMATIC FIRE SPRINKLER SYSTEMS AND OTHER FIRE PROTECTION EQUIPMENT.
3. EACH AREA SHALL HAVE A ZONE VALVE W/TAMPER SWITCH, PRESSURE GAGE, AND FLOW SWITCH. COORDINATE AREAS WITH ARCHITECT.
4. ALL TAMPER AND FLOW SWITCHES TO BE TIED INTO BUILDING FIRE ALARM SYSTEM.
5. REFER TO ARCHITECTURAL DRAWINGS FOR LOCATIONS, AND CONFIGURATION FOR EXTINGUISHERS.
6. SHOP DRAWINGS SHALL BE PREPARED AND SUBMITTED TO THE ARCHITECT/ENGINEER FOR THEIR REVIEW AND COMMENTS PRIOR TO ORDERING, PURCHASING, OR FABRICATING ANY FIRE SPRINKLER EQUIPMENT. THE SHOP DRAWINGS SHALL BE DRAWN AT 1/8" SCALE AS A MINIMUM AND SHALL INCLUDE ALL ITEMS LISTED IN NFPA 13. THE SHOP DRAWINGS SHALL BEAR THE SEAL OF A REGISTERED PROFESSIONAL ENGINEER OR EQUIVALENT CONTRACTOR'S REGISTERED LICENSE HOLDER. SHOP DRAWINGS TO BE SUBMITTED TO THE LOCAL FIRE DEPARTMENT'S NEW CONSTRUCTION DIVISION FOR REVIEW, APPROVAL, AND PERMITTING.
7. PROVIDE A 10% HYDRAULIC SAFETY FACTOR UP TO A MAXIMUM OF 10 PSI.
8. INSTALL SPRINKLERS WITH THE MANUFACTURER'S MINIMUM ALLOWABLE PROTECTION FROM THE WALL OR CEILING. COORDINATE LOCATIONS OF SPRINKLERS AT PUBLIC AREAS TO AVOID LOCATION CONFLICTS (SUCH AS CROWN MOLDINGS, HVAC GRILLES, CEILING FANS). IN CORRIDOR CEILINGS, GENERALLY, POSITION SPRINKLERS ALONG CENTERLINE OF CORRIDOR WIDTH. IN CEILINGS WITH ACOUSTICAL TILES, POSITION SPRINKLERS IN CENTER OF TILES.
9. PROVIDE DRY TYPE SYSTEM IN ANY LOCATION REQUIRED. COORDINATE WITH ARCHITECT & EC.

MASTER FIRE PROTECTION LEGEND


SYMBOL	ABBREVIATION	DESCRIPTION
FIRE / SPRINKLER MAIN		
UNDERGROUND FIRE MAIN		
— —	CV	CHECK VALVE
— — —	BFLY	BUTTERFLY VALVE
— — —	GV	GATE VALVE
— — —		STRAINER
— — —		UNION
— — —	PG	PRESSURE GAUGE
— — —		2-WAY WALL SIAMESE
— — —	WMG	WATER MOTOR GONG
— — —		FIRE EXTINGUISHER
— — —		WET ALARM VALVE RISER
— — —		SPRINKLER ZONE = 'X'
— — —	PIV	POST INDICATOR VALVE

WATER SUPPLY SCHEDULE

FLOW TEST DATA	TEST #1	TEST #2
DATE OF FLOW TEST:	NA	NA
LOCATION OF FLOW TEST:		
ELEVATION AT TEST HYDRANT:		
STATIC TEST PRESSURE:	NA	NA
RESIDUAL TEST PRESSURE:	NA	NA
TEST FLOW MEASURED:	NA	NA
CALCULATED FLOW AT 20 PSIG	NA	NA
TEST PERFORMED/SUPPLIED BY:	NA	NA


NOTES:

NO FLOW TEST HAS BEEN MADE AVAILABLE TO ENGINEERS. CONTRACTOR SHALL PERFORM FIRE FLOW TEST PRIOR TO PROVIDING CALCULATIONS.

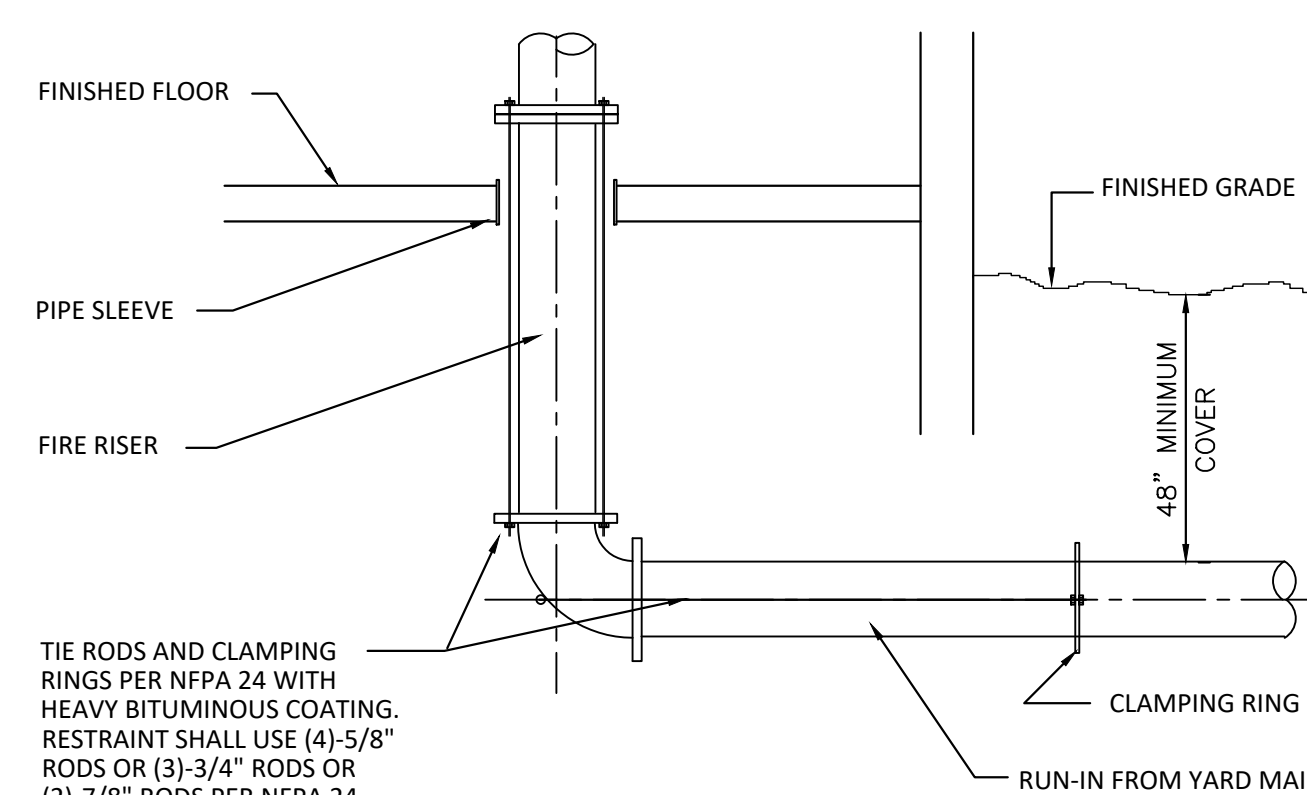

2 TYPICAL FLOOR SLAB PENETRATION DETAIL

NTS

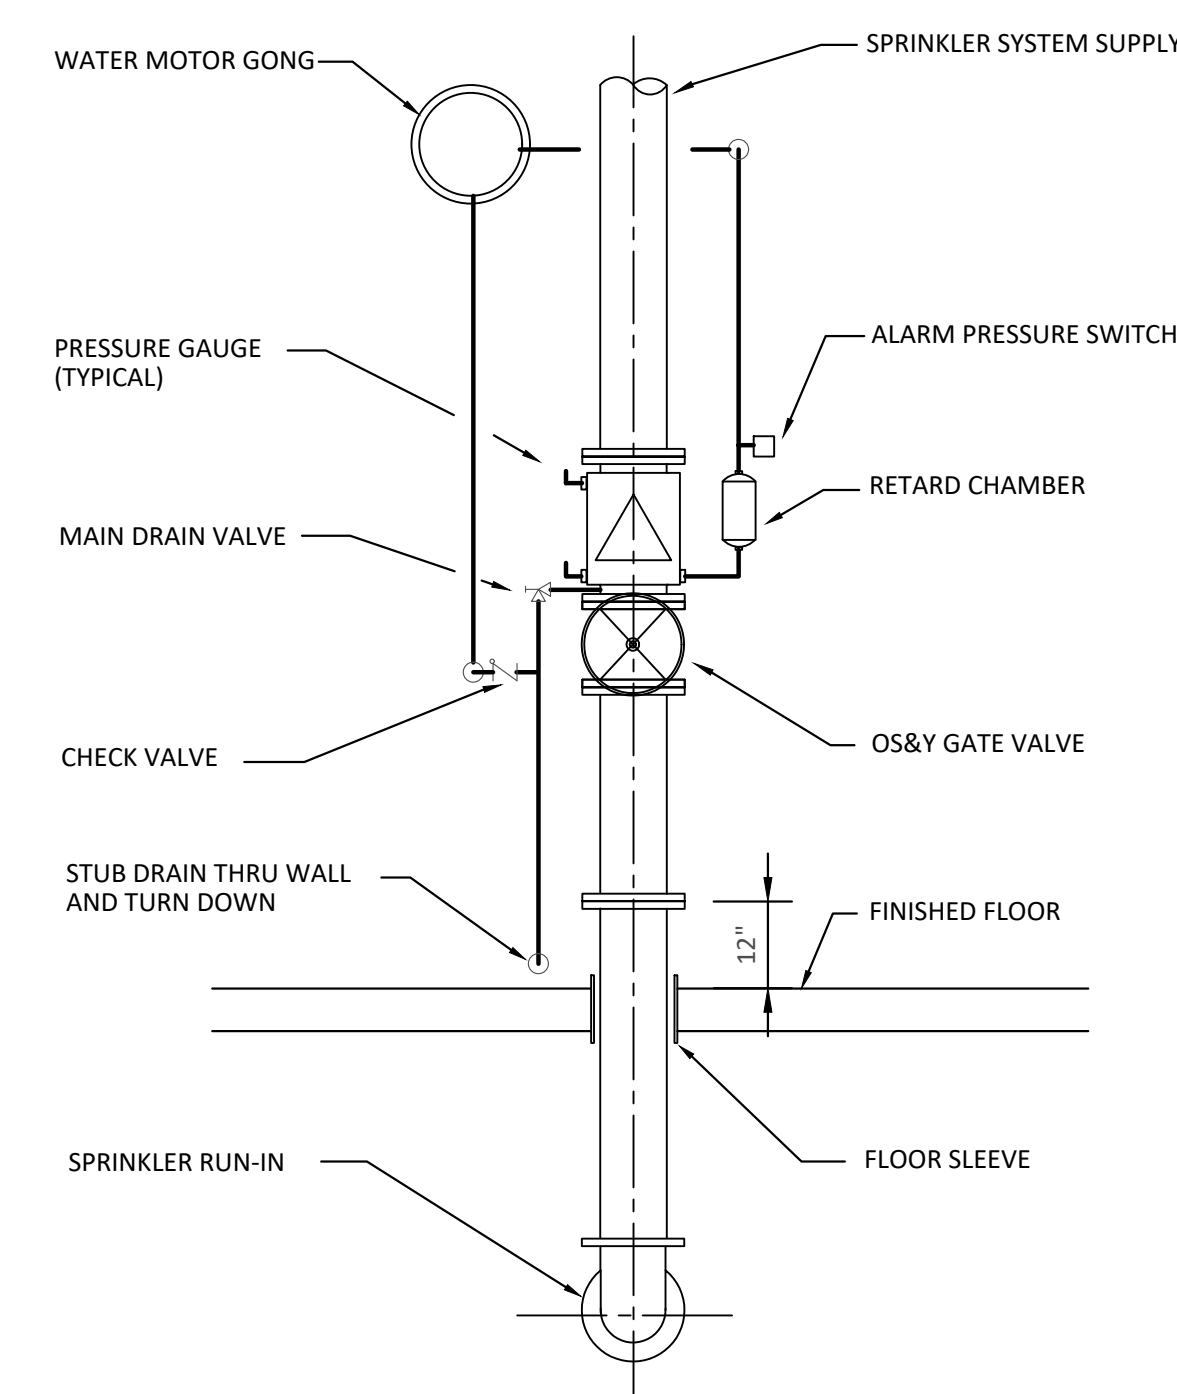

1 FIRE RISER ALARM VALVE DETAIL

NTS

GMC

AS BUILT

2660 East Chase Lane, Suite 200
Montgomery, AL 36117
T 334-271-3200
G M C N E T W O R K . C O M



ISSUE	DATE
95% REVIEW	05.30.19
PERMIT SET	10.11.19
DESIGNED BY:	
DRAWN BY:	
CHECKED BY:	

THE EXCHANGE AT HOMEPLACE
PRATTVILLE, AL
GMC PROJECT#AMGM180037



**Details & Notes -
Fire Protection**
FP2.1
sheet of

334.246.1369
info@PursuitEngineering.com
323 E Glenn Ave
Auburn, Alabama 36830
PursuitEngineering.com

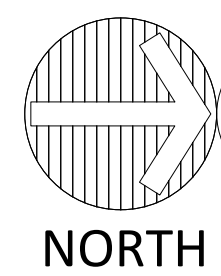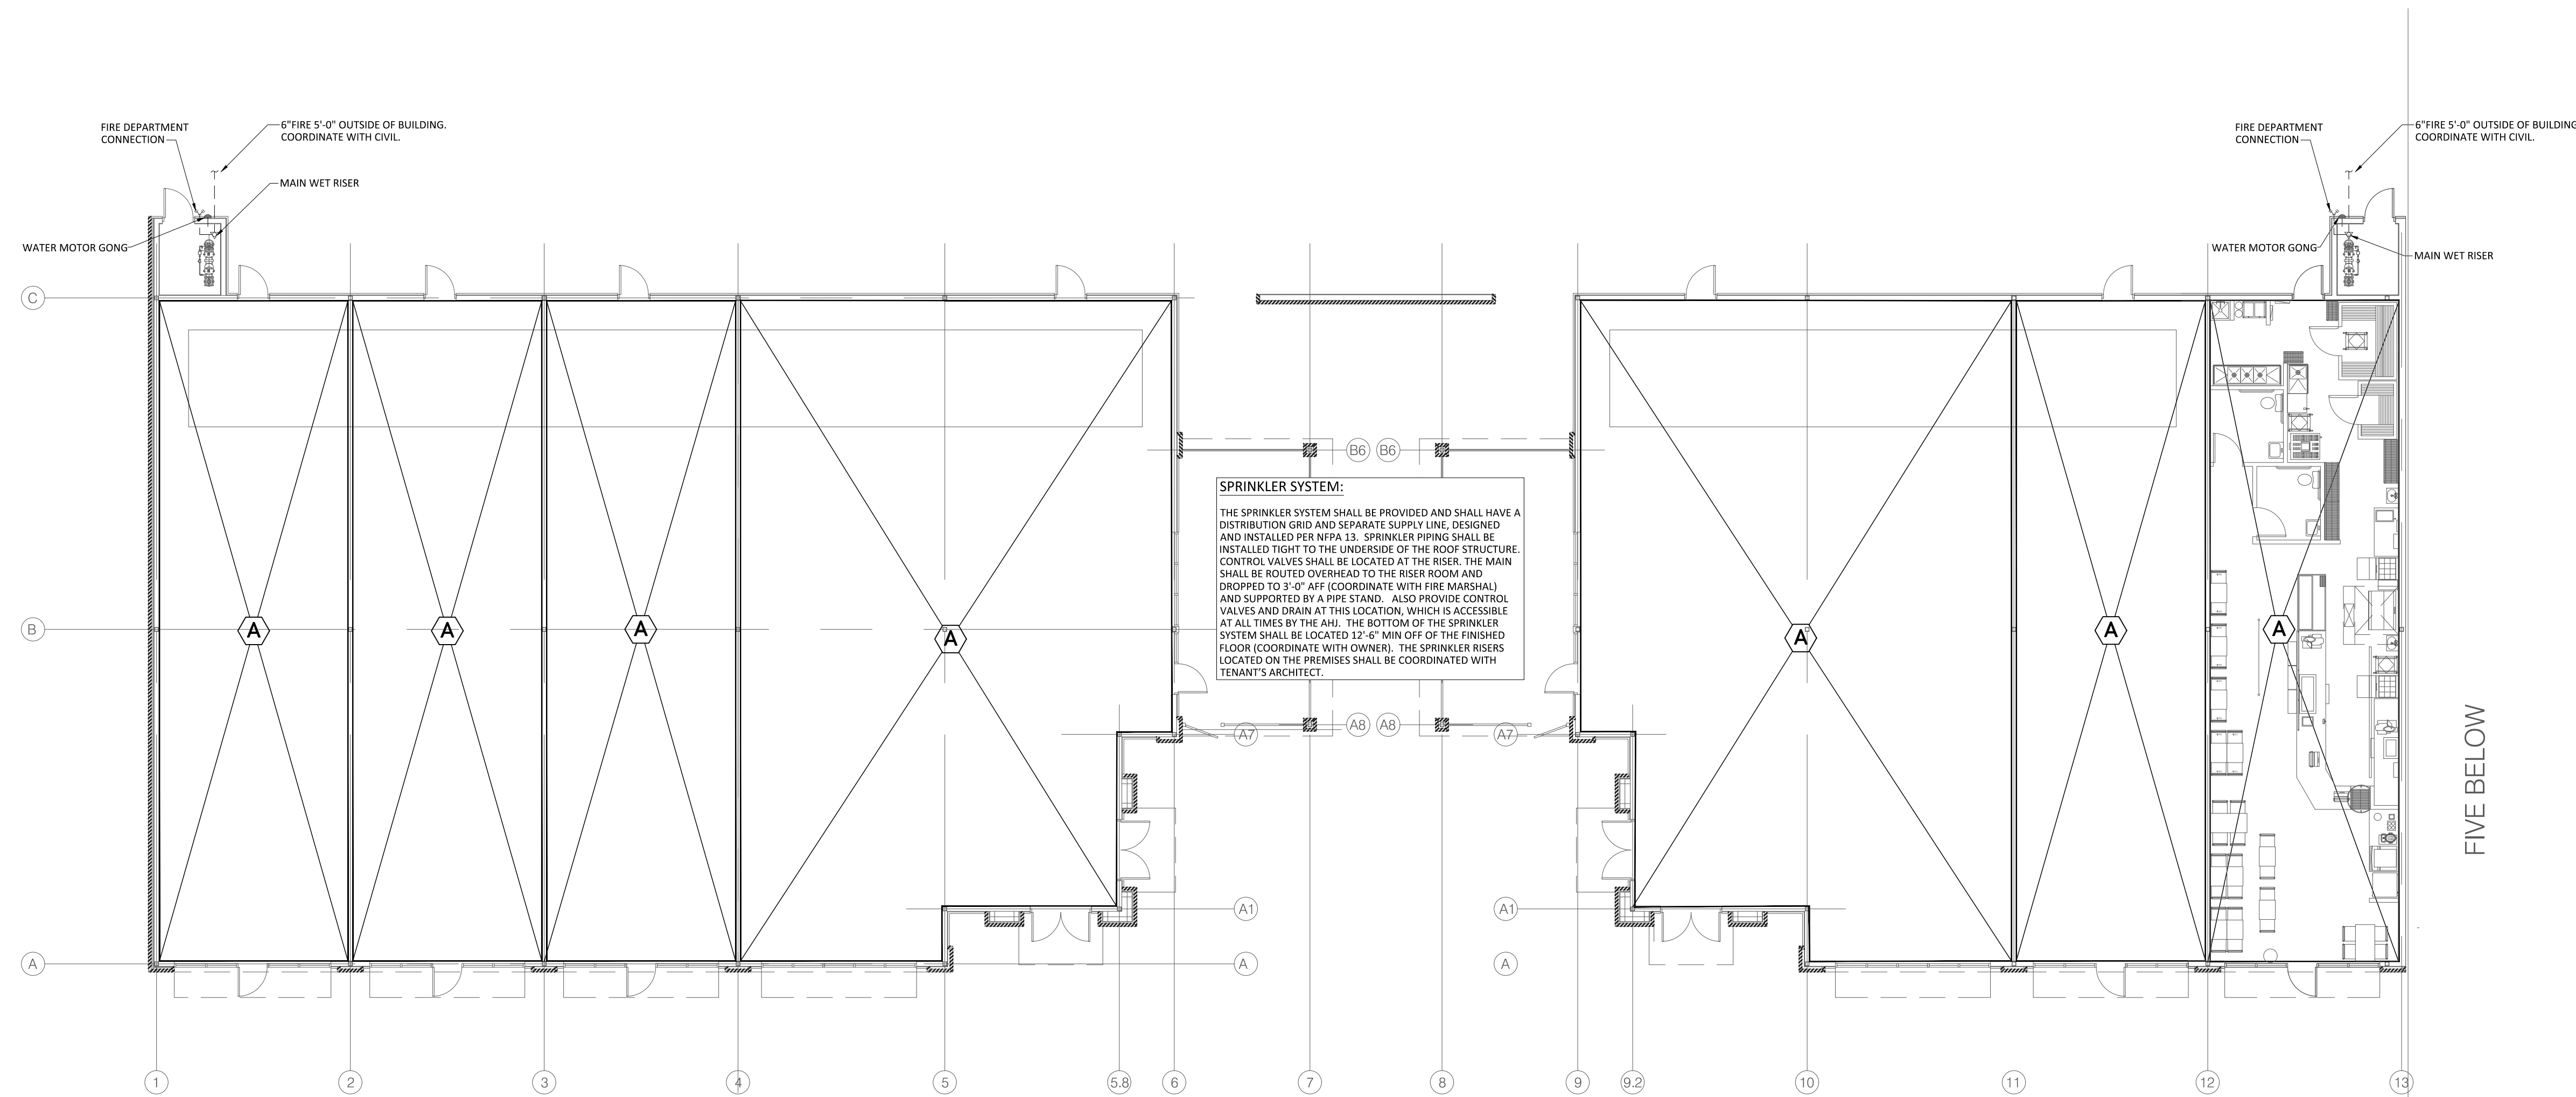

1

FLOOR PLAN - FIRE PROTECTION

3/32" = 1'-0"

FIVE BELOW

334.246.1369
 info@PursuitEngineering.com
 323 E Glenn Ave
 Auburn, Alabama 36830
 PursuitEngineering.com

Floor Plan - Fire Protection

FP2.2

sheet of



THE EXCHANGE AT HOMEPPLACE

PRATTVILLE, AL

GMC PROJECT#AMGM180037

ISSUE DATE

95% REVIEW	06.30.19
PERMIT SET	10.11.19
DESIGNED BY:	
DRAWN BY:	
CHECKED BY:	

AS BUILT

2660 East Chase Lane, Suite 200
 Montgomery, AL 36117

T 334-271-3200
 G M C N E T W O R K . C O M

GMC